


TO THE BEST OF OUR KNOWLEDGE CORWIN ENGINEERING, INC. HEREBY STATES THAT THIS PLAN IS AS-BUILT. THIS INFORMATION PROVIDED IS BASED ON SURVEYING AT THE SITE AND INFORMATION PROVIDED BY THE CONTRACTORS.

**AS-BUILT DECEMBER 2008**

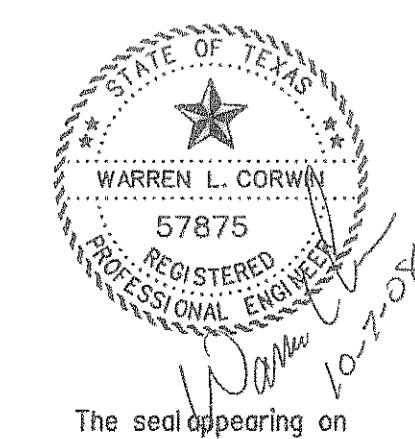

The seal appearing on this document was authorized by Warren L. Corwin, P.E. 57875, on August 13, 2008

**CORWIN ENGINEERING, INC.**  
200 W. BELMONT, SUITE E  
ALLEN, TEXAS 75013 (972) 396-1200

DEVELOPMENT PLANS FOR  
**STONE CREEK PHASE I**  
ROCKWALL, TEXAS

FEATHERSTONE DRIVE  
STA. 12+00.00 TO 24+00.00

NO.	REVISIONS	CMF BY	DATE
1.	REVISED PAVEMENT WIDTH	CMF	9-23-08

DRAWN BY	DESIGNED BY	CHECKED BY	SHEET NO.
08033	CEI	CEI	16 OF 62