



AS-BUILT DECEMBER 2008

TO THE BEST OF OUR KNOWLEDGE CORWIN ENGINEERING, INC., HEREBY STATES THAT THIS PLAN IS AS-BUILT, THIS INFORMATION PROVIDED IS BASED ON SURVEYING AT THE SITE AND INFORMATION PROVIDED BY THE CONTRACTORS.

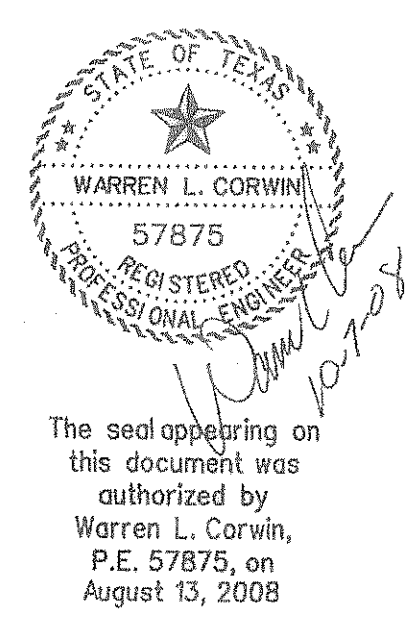

1.	REVISED PAVEMENT WIDTH	CMF	9-23-08
NO.	REVISIONS	BY	DATE
 CORWIN ENGINEERING, INC. 200 W. BELMONT, SUITE E ALLEN, TEXAS 75013 (972) 396-1200			
DEVELOPMENT PLANS FOR STONE CREEK PHASE I ROCKWALL, TEXAS			
FEATHERSTONE DRIVE SIDE ROADS #4 & #5			
DRAWN BY	DESIGNED BY	CHECKED BY	SHEET NO.
JOB NUMBER	DATE	SCALE: 1"=4' V 1"=40' H	19 OF 62
08033	JANUARY 2008		