


TO THE BEST OF OUR KNOWLEDGE CORWIN ENGINEERING, INC., HEREBY STATES THAT THIS PLAN IS AS-BUILT. THIS INFORMATION PROVIDED IS BASED ON SURVEYING AT THE SITE AND INFORMATION PROVIDED BY THE CONTRACTORS.

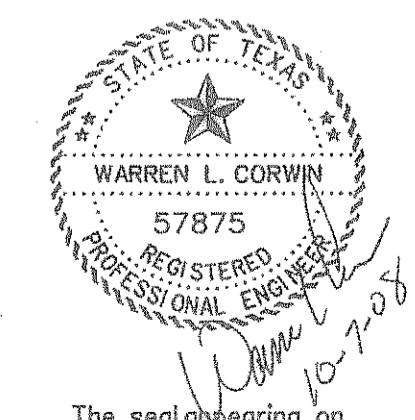

The seal appearing on this document was authorized by Warren L. Corwin, P.E. 57875, on August 13, 2008

AS-BUILT DECEMBER 2008

1.	REVISED PAVEMENT WIDTH	CMF	9-23-08
NO.	REVISIONS	BY	DATE
CORWIN ENGINEERING, INC. 200 W. BELMONT, SUITE E ALLEN, TEXAS 75013 (972) 396-1200			
DEVELOPMENT PLANS FOR STONE CREEK PHASE I ROCKWALL, TEXAS			
HANOVER DRIVE			
DRAWN BY	DESIGNED BY	CHECKED BY	SHEET NO.
08033	CEI	CEI	21 of 62
JOB NUMBER	DATE	SCALE: 1"=4' V 1"=40' H	
08033	JANUARY 2008		