

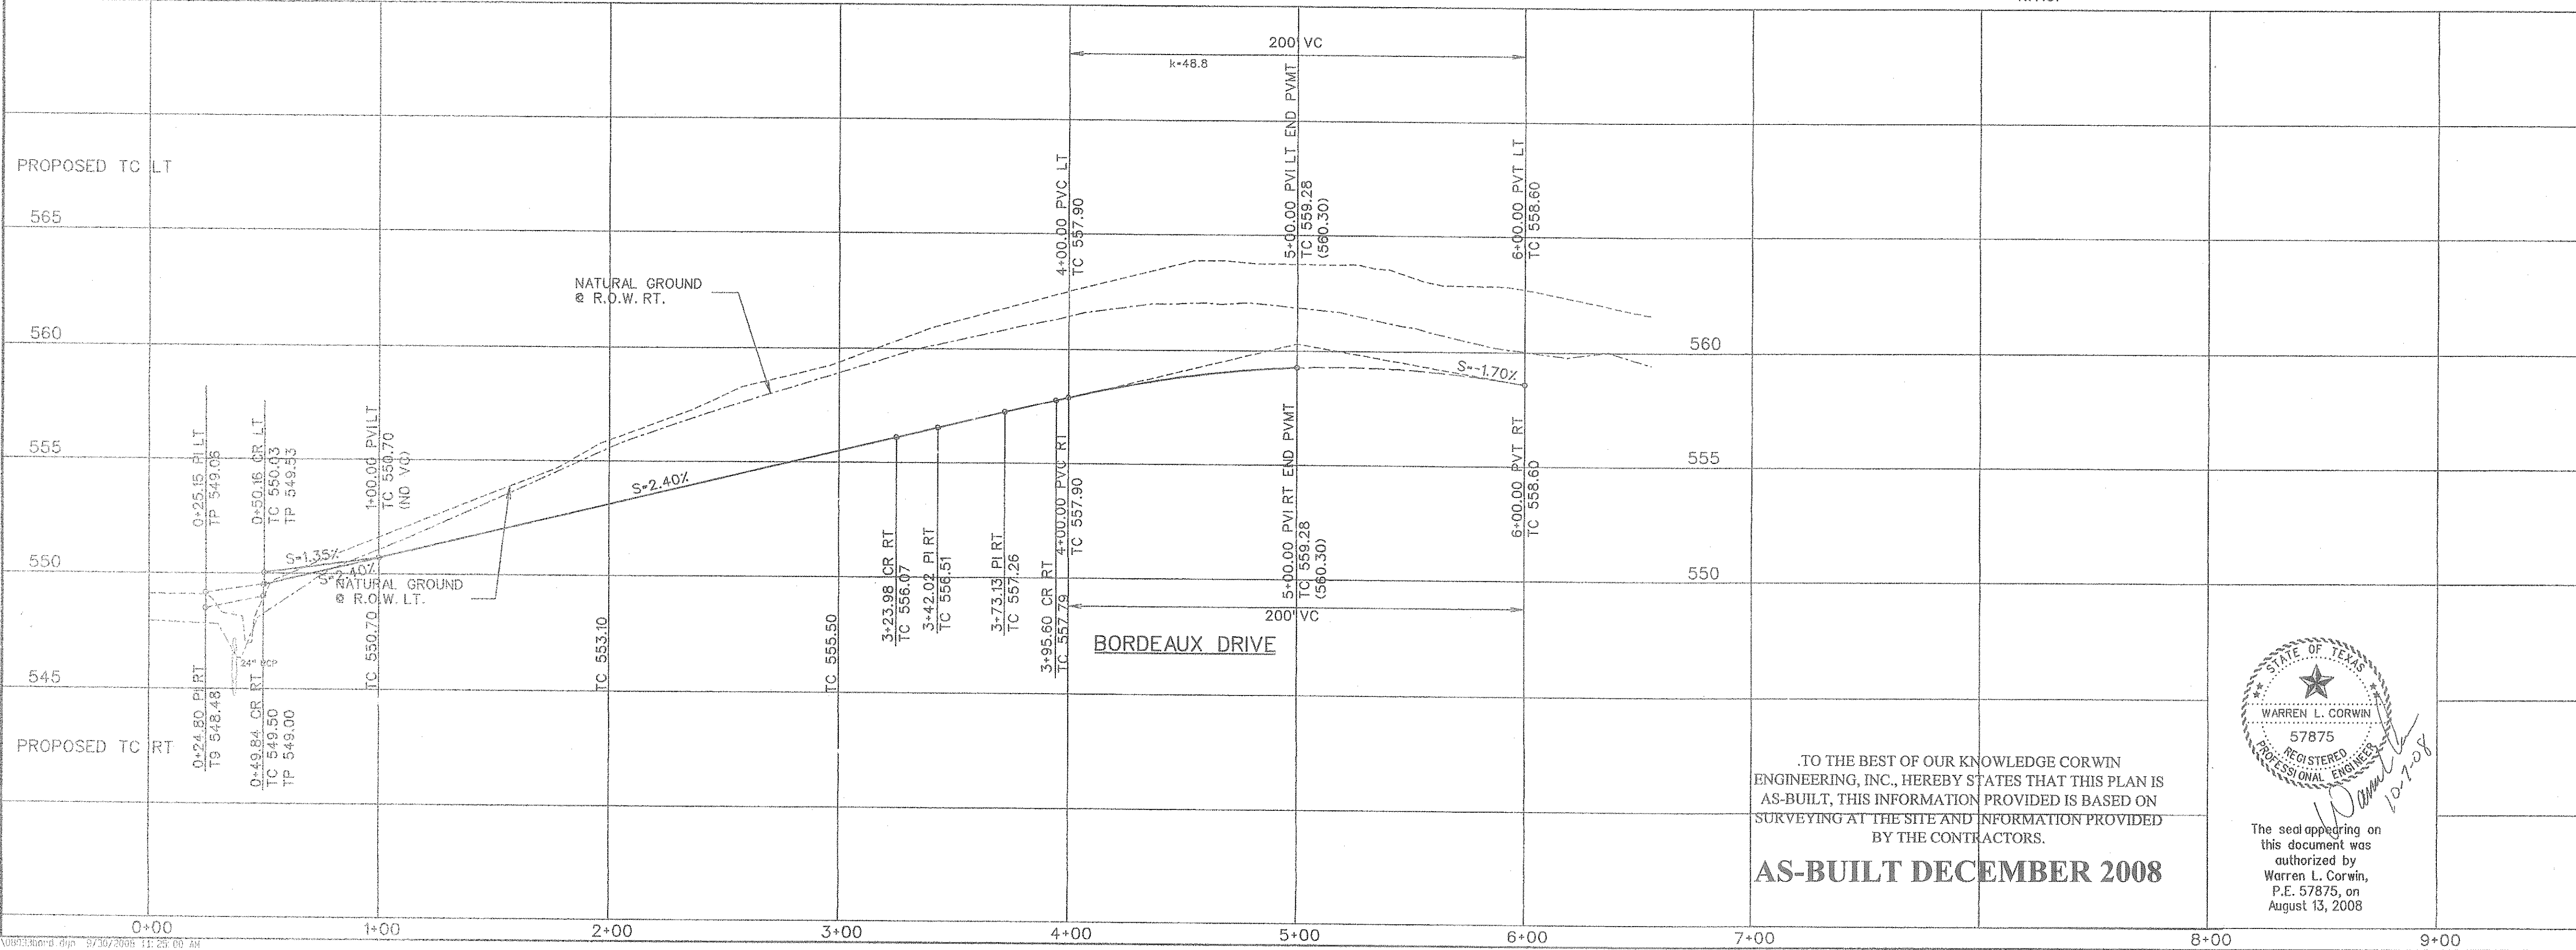


100' ROW TYPICAL PVMT.
N.T.S.

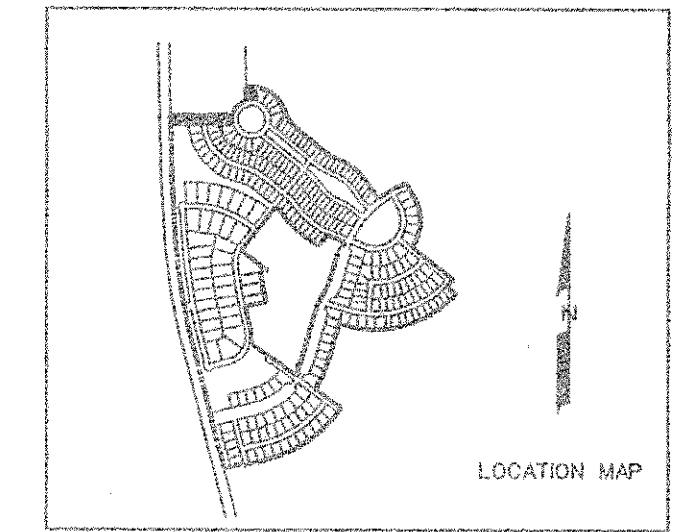

TO THE BEST OF OUR KNOWLEDGE CORWIN ENGINEERING, INC., HEREBY STATES THAT THIS PLAN IS AS-BUILT, THIS INFORMATION PROVIDED IS BASED ON SURVEYING AT THE SITE AND INFORMATION PROVIDED BY THE CONTRACTORS.

AS-BUILT DECEMBER 2008

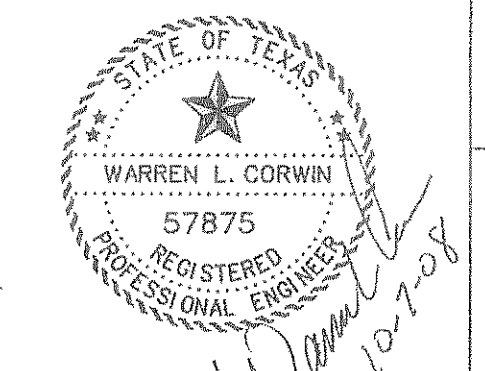

The seal appearing on this document was authorized by Warren L. Corwin, P.E. 57875, on August 13, 2008

1. REVISED CURB RETURN STATIONS @ MIRAMAR		CMF	9-23-08
NO.	REVISIONS	BY	DATE
 CORWIN ENGINEERING, INC. 200 W. BELMONT, SUITE E ALLEN, TEXAS 75013 (972) 396-1200			
DEVELOPMENT PLANS FOR STONE CREEK PHASE I ROCKWALL, TEXAS			
BORDEAUX DRIVE			
DRAWN BY	DESIGNED BY	CHECKED BY	SHEET NO.
08033	CEI	CEI	29 OF 62
JOB NUMBER	DATE	SCALE: 1"=4' V 1"=40' H	
08033	JANUARY 2008		