


MIRAMAR DRIVE

TO THE BEST OF OUR KNOWLEDGE CORWIN ENGINEERING, INC., HEREBY STATES THAT THIS PLAN IS AS-BUILT. THIS INFORMATION PROVIDED IS BASED ON SURVEYING AT THE SITE AND INFORMATION PROVIDED BY THE CONTRACTORS.

AS-BUILT DECEMBER 2008

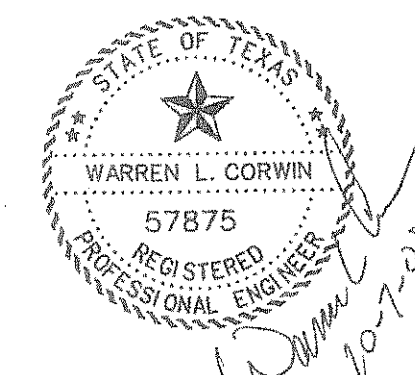

The seal appearing on this document was authorized by Warren L. Corwin, P.E. 57875, on August 13, 2008

CORWIN ENGINEERING, INC.
 200 W. BELMONT, SUITE F
 ALLEN, TEXAS 75015 (972) 396-1200

DEVELOPMENT PLANS FOR
STONE CREEK PHASE I
 ROCKWALL, TEXAS

MIRAMAR DRIVE
 STA. 0+00.00 TO 12+00.00

NO.	REVISIONS	BY	DATE
1.	REVISED PAVEMENT WIDTH	CMF	9-23-08

DRAWN BY	DESIGNED BY	CHECKED BY	SHEET NO.
08033	CEI	CEI	
JOB NUMBER	DATE	SCALE: 1"=4'-V 1"=40'-H	30 of 62
08033	JANUARY 2008		