


TO THE BEST OF OUR KNOWLEDGE CORWIN ENGINEERING, INC., HEREBY STATES THAT THIS PLAN IS AS-BUILT. THIS INFORMATION PROVIDED IS BASED ON SURVEYING AT THE SITE AND INFORMATION PROVIDED BY THE CONTRACTORS.

AS-BUILT DECEMBER 2008

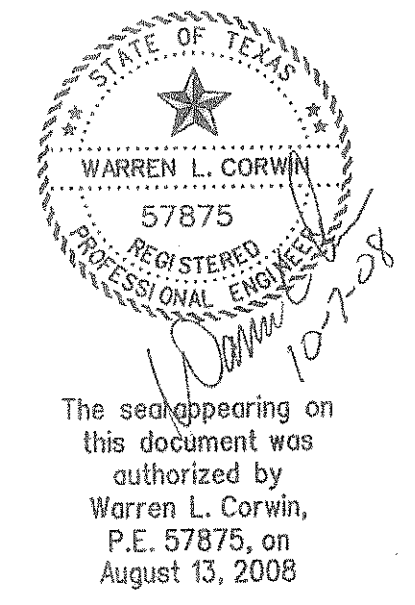

The seal appearing on this document was authorized by Warren L. Corwin, P.E. 57875, on August 13, 2008

CORWIN ENGINEERING, INC.
200 W. BELMONT, SUITE E
ALLEN, TEXAS 75013 (972) 396-1200

DEVELOPMENT PLANS FOR
STONE CREEK PHASE I
ROCKWALL, TEXAS

MIRAMAR DR. STA. 12+00.00 TO 23+56.51

NO.	REVISIONS	CMF BY	DATE
1.	REVISED PAVEMENT WIDTH	CMF	9-23-08

DRAWN BY	DESIGNED BY	CHECKED BY	SHEET NO.
08033	CEI	CEI	31 OF 62