


TO THE BEST OF OUR KNOWLEDGE CORWIN ENGINEERING, INC. HEREBY STATES THAT THIS PLAN IS AS-BUILT. THIS INFORMATION PROVIDED IS BASED ON SURVEYING AT THE SITE AND INFORMATION PROVIDED BY THE CONTRACTORS.

AS-BUILT DECEMBER 2008

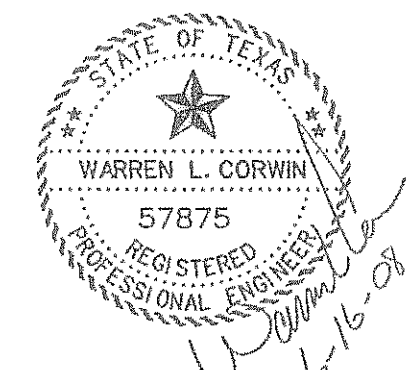

The seal appearing on this document was authorized by Warren L. Corwin, P.E. 57875, on JUNE 13, 2008

CORWIN ENGINEERING, INC.
 200 W. BELMONT, SUITE E
 ALLEN, TEXAS 75013 (972) 396-1200

DEVELOPMENT PLANS FOR
STONE CREEK PHASE I
 ROCKWALL, TEXAS

SANITARY SEWER PROFILES
 LINE 'S-3'

DRAWN BY 07038	DESIGNED BY CEI	CHECKED BY CEI	SHEET NO. 37 OF 62
JOB NUMBER	DATE JULY 2007	SCALE: 1"=4' V 1"=40' H	