
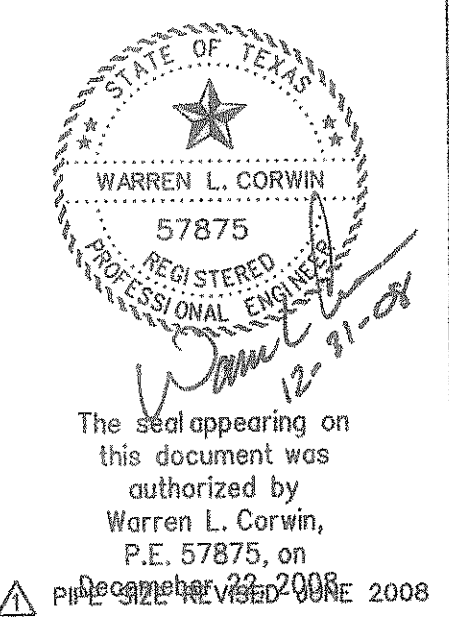


CURVE DATA		
CURVE NO.	①	②
Δ	22° 43' 01"	36° 45' 08"
R	465.00'	65.00'
T	93.41'	21.59'
L	184.37'	41.69'

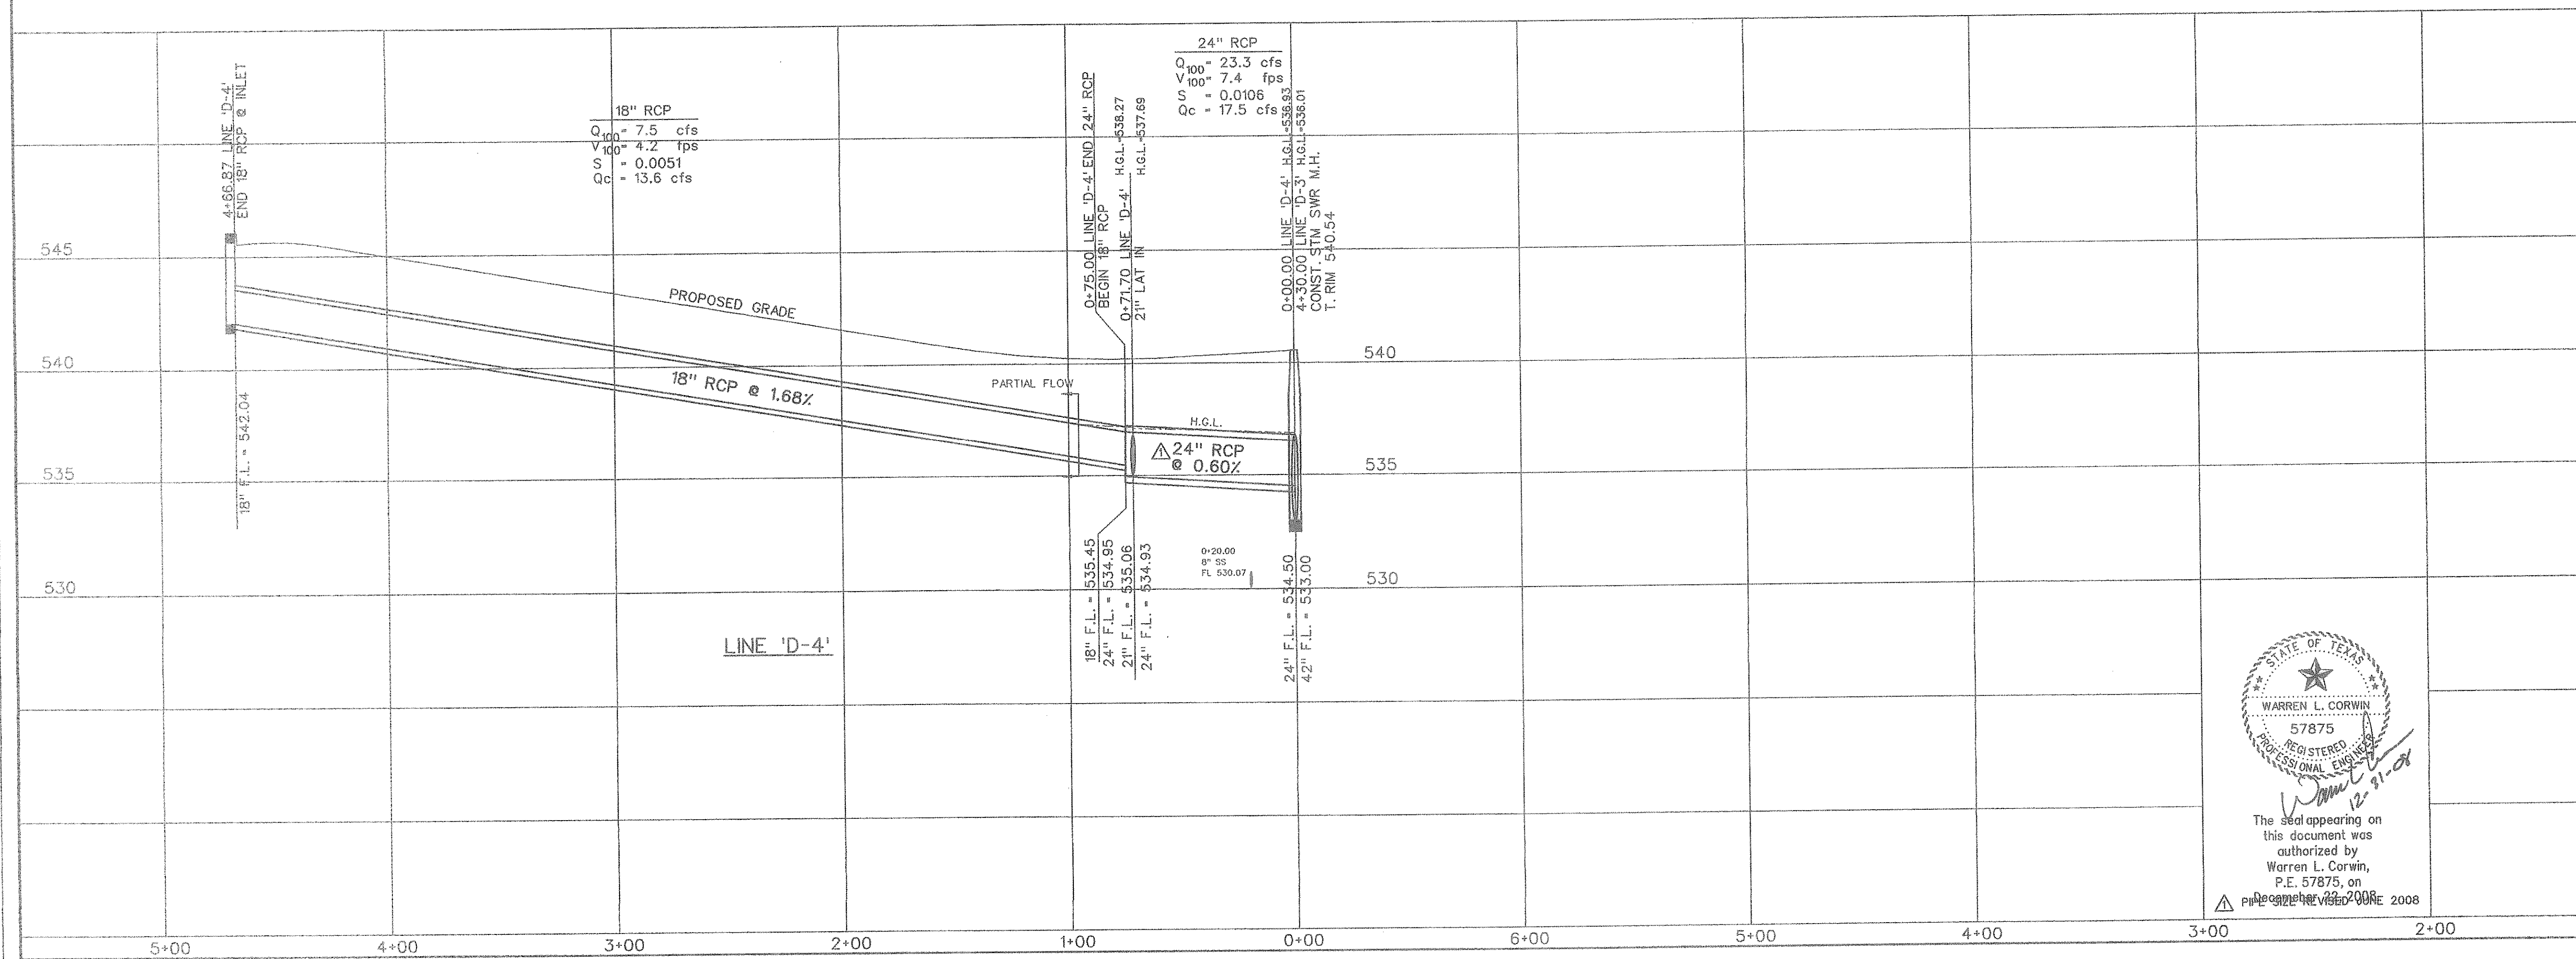

**CORWIN ENGINEERING, INC.**  
 200 W. BELMONT, SUITE E  
 ALLEN, TEXAS 75015 (972) 396-1200

DEVELOPMENT PLANS FOR  
**STONE CREEK PHASE I**  
 ROCKWALL, TEXAS

STORM SEWER PLAN AND PROFILE  
 LINE 'D-4'

DRAWN BY	DESIGNED BY	CHECKED BY	SHEET NO.
	CEI	CEI	
JOB NUMBER	DATE	SCALE:	
08033	JANUARY 2008	1"=4' V 1"=40' H	44 of 62