




NORTH TRIBUTARY
DETENTION POND
100-YEAR WSEL=501.18
NORMAL WSEL=497.00

SEE SHEET 54
FOR OUTFALL
DETAILS


ELEVATION-STORAGE TABLE

Elevation	Storage (CF)
497	0
498	85376
499	175353
500	272783
501	377824
502	490694

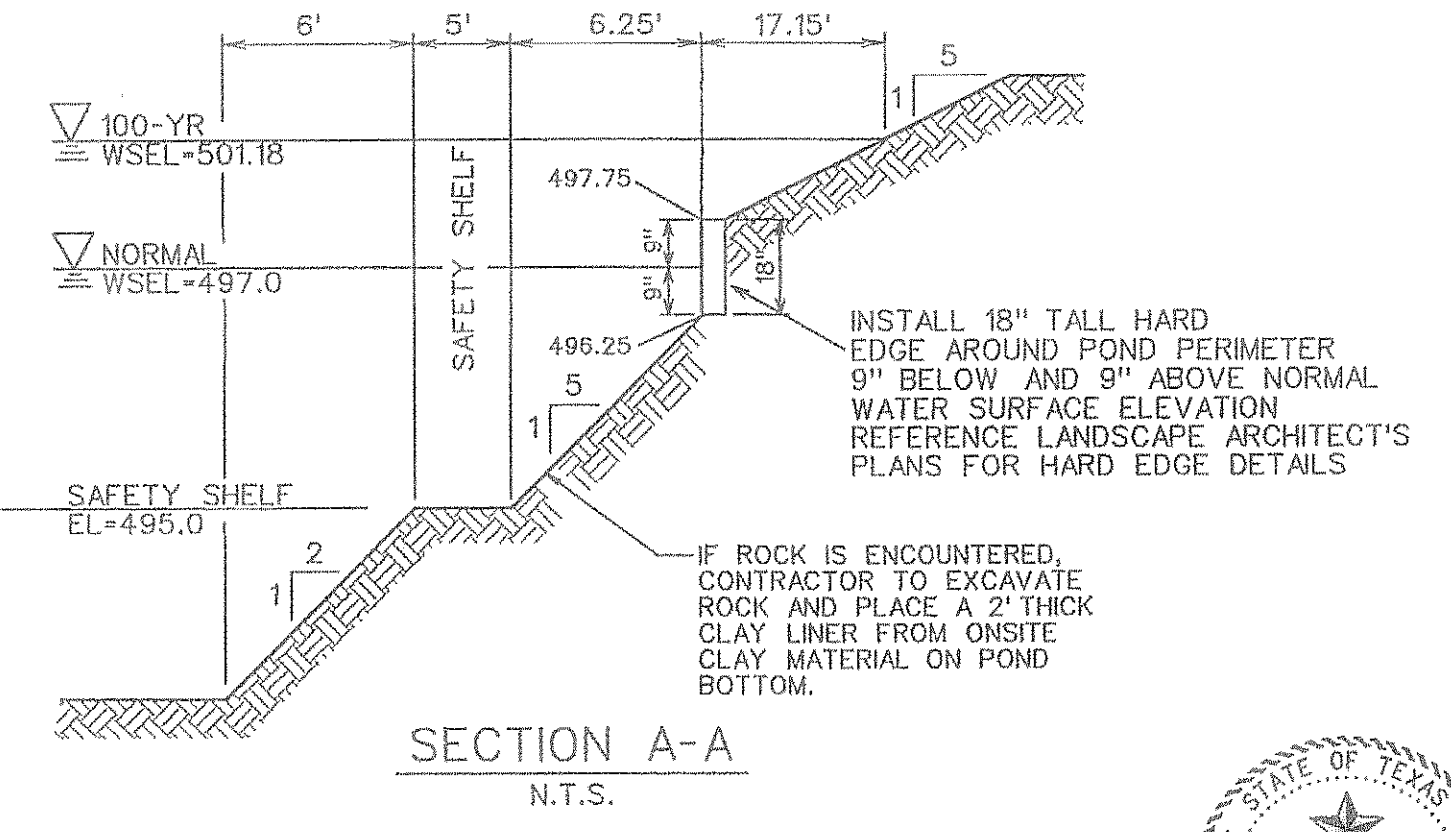

TO THE BEST OF OUR KNOWLEDGE CORWIN ENGINEERING, INC., HEREBY STATES THAT THIS PLAN IS AS-BUILT, THIS INFORMATION PROVIDED IS BASED ON SURVEYING AT THE SITE AND INFORMATION PROVIDED BY THE CONTRACTORS.

AS-BUILT DECEMBER 2008

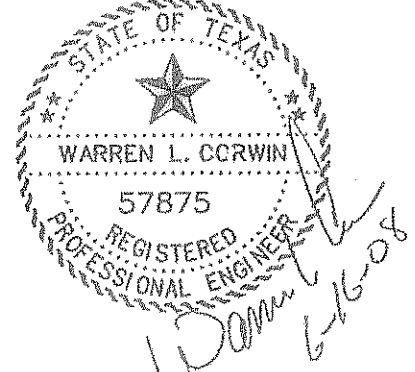

The seal appearing on this document was authorized by Warren L. Corwin, P.E. 57875, on JUNE 13, 2008

NO.	REVISIONS	BY	DATE
 CORWIN ENGINEERING, INC. 200 W. BELMONT, SUITE E ALLEN, TEXAS 75013 (972) 396-1200			
CONSTRUCTION PLANS FOR STONE CREEK PHASE I ROCKWALL, TEXAS			
DETENTION POND PLAN NORTH TRIBUTARY POND			
DRAWN BY BDD	DESIGNED BY BDD	CHECKED BY BDD	SHEET NO.
JOB NUMBER 08033	DATE JANUARY 2008	SCALE: 1"=40'	52 OF 62