





ELEVATION-STORAGE TABLE

Elevation	Storage (CF)
497	0
498	58214
499	120704
500	188378
501	261404
502	339954

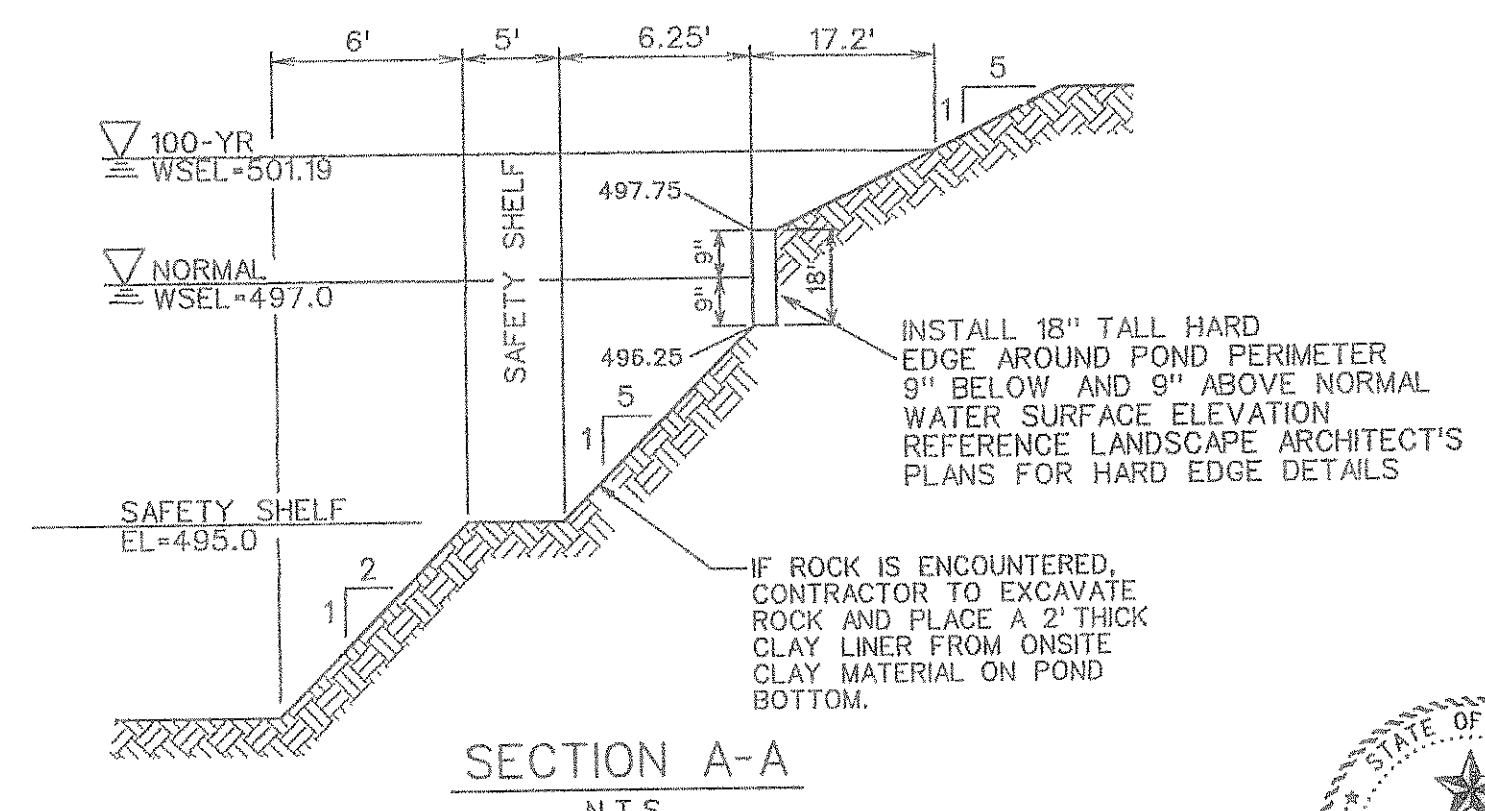

TO THE BEST OF OUR KNOWLEDGE CORWIN ENGINEERING, INC., HEREBY STATES THAT THIS PLAN IS AS-BUILT, THIS INFORMATION PROVIDED IS BASED ON SURVEYING AT THE SITE AND INFORMATION PROVIDED BY THE CONTRACTORS.

**AS-BUILT DECEMBER 2008**

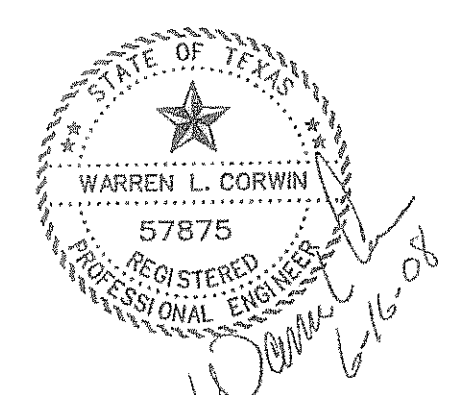

The seal appearing on this document was authorized by Warren L. Corwin, P.E. 57875, on JUNE 13, 2008

NO.	REVISIONS	BY	DATE
 CORWIN ENGINEERING, INC. 200 W. BELMONT, SUITE E ALLEN, TEXAS 75013 (972) 396-1200			
CONSTRUCTION PLANS FOR <b>STONE CREEK</b> PHASE I ROCKWALL, TEXAS			
DETENTION POND PLAN NORTH TRIBUTARY POND INTERIM CONDITIONS			
DRAWN BY BDD	DESIGNED BY BDD	CHECKED BY BDD	SHEET NO.
JOB NUMBER 08033	DATE JULY 2007	SCALE 1"=40'	53 of 62