



Elevation-Storage Table	
Elevation	Volume (cf)
513	0
514	19593
515	42805
516	69805
517	100811
518	138027

SOUTH TRIBUTARY UPSTREAM DETENTION POND
 100-YEAR WSEL=517.77
 NORMAL WSEL=513.00

SEE SHEET 58
 FOR OUTFALL
 DETAILS

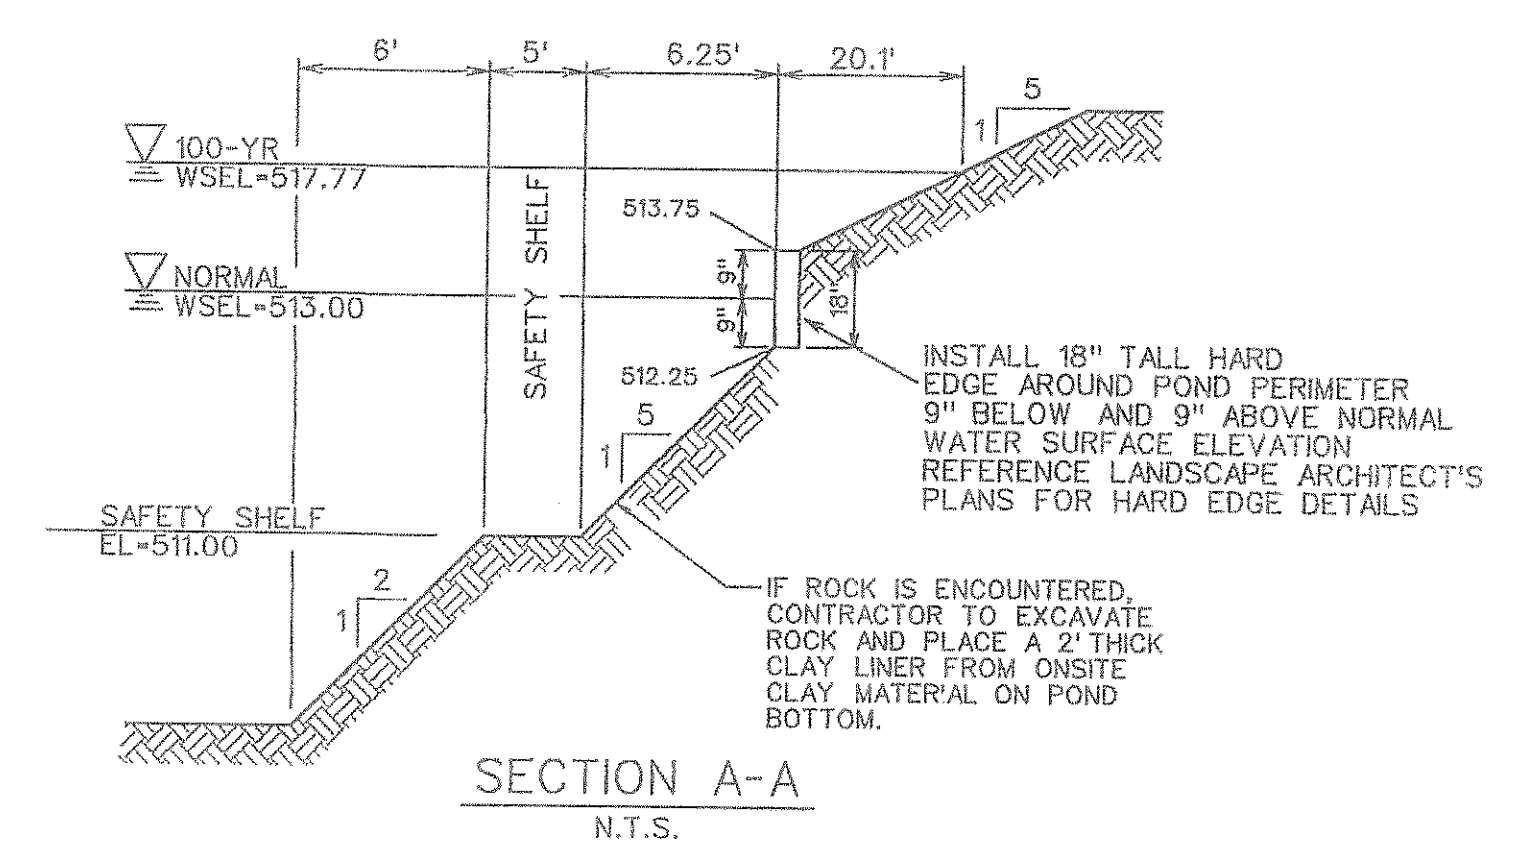

TO THE BEST OF OUR KNOWLEDGE CORWIN ENGINEERING, INC., HEREBY STATES THAT THIS PLAN IS AS-BUILT, THIS INFORMATION PROVIDED IS BASED ON SURVEYING AT THE SITE AND INFORMATION PROVIDED BY THE CONTRACTORS.
AS-BUILT DECEMBER 2008

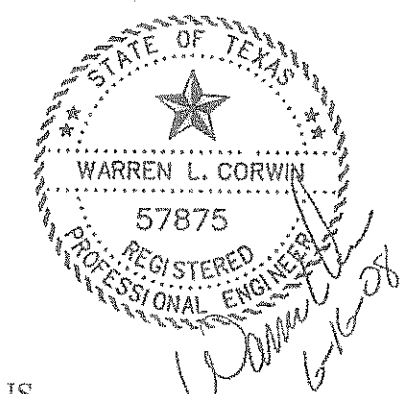

NO.	REVISIONS	BY	DATE
CORWIN ENGINEERING, INC. 200 W. BELMONT, SUITE E ALLEN, TEXAS 75013 (972) 396-1200			
CONSTRUCTION PLANS FOR STONE CREEK PHASE I ROCKWALL, TEXAS			
DETENTION POND PLAN SOUTH TRIBUTARY UPSTREAM POND			
DRAWN BY BDD	DESIGNED BY BDD	CHECKED BY BDD	SHEET NO.
JOB NUMBER 08033	DATE JANUARY 2008	SCALE: 1"=40'	56 of 62