

Wall Notes:


1. No part of the wall (footing, tie back etc. shall be const. offsite, in an easement or in the R.O.W. Walls must be on one property.
2. All walls 4' or taller shall require a signed/sealed set of engineered drawings. Wall engineer shall submit signed/sealed letter prior to acceptance stating that the walls were constructed per drawings.
3. All fill to be compacted to 95% std. density using a sheep's foot roller.

NOTES:


1. Finish Floor Elevation to be 0.70 Feet above Finished Pad.(FP)
2. Additional Erosion Control to be installed in Parkways as determined by the City Inspector.
3. Finished Pad Elevations are within ± 0.3 Feet.

- RETAINING WALL
- EXIST. TREE
- 516.41 100-YEAR WATER SURFACE ELEVATION

AS-BUILT DECEMBER 2008
 TO THE BEST OF OUR KNOWLEDGE CORWIN ENGINEERING, INC. HEREBY STATES THAT THIS PLAN IS AS-BUILT, THIS INFORMATION PROVIDED IS BASED ON SURVEYING AT THE SITE AND INFORMATION PROVIDED BY THE CONTRACTORS.

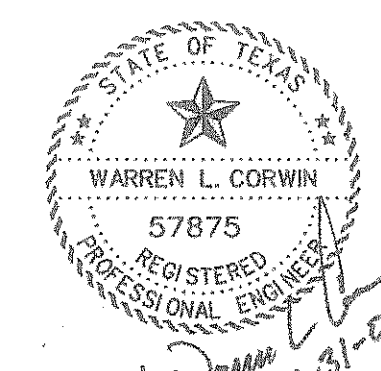

The seal appearing on this document was authorized by Warren L. Corwin, P.E. 57875, on December 22, 2008

1.	REVISED BERM ALONG BARLASS	BD	12-17-08
NO.	REVISIONS	BY	DATE
 CORWIN ENGINEERING, INC. 200 W. BELMONT, SUITE E ALLEN, TEXAS 75013 (972) 396-1200			
DEVELOPMENT PLANS FOR STONE CREEK PHASE I ROCKWALL, TEXAS			
GRADING PLAN			
DRAWN BY	DESIGNED BY	CHECKED BY	SHEET NO.
JOB NUMBER	DATE	SCALE	
08033	JANUARY 2008	1"=50'	57 OF 62