


DEVELOPMENT PLANS
FOR
STONE CREEK
PHASE IIA
CITY OF ROCKWALL, TEXAS

INDEX

1	TITLE
2	PLAT
3	DRAINAGE AREA MAP
4	DETENTION CALCULATIONS
5	CRESTFIELD DRIVE
6	CHATFIELD DRIVE & IRIS DRIVE
7	WATER AND SANITARY SEWER PLAN
8	SANITARY SEWER PROFILES
9	STORM SEWER PLAN
10	GRADING PLAN
11	POLLUTION PREVENTION PLAN

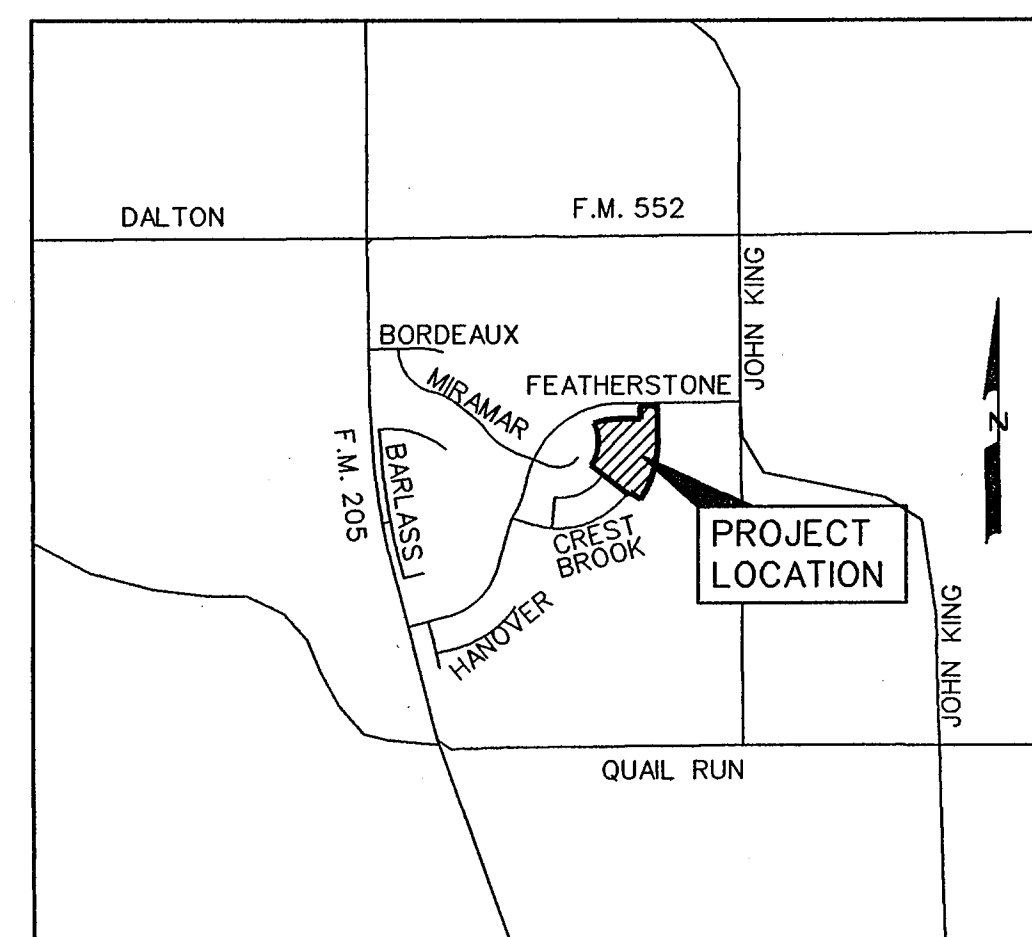

VICINITY MAP
NOT TO SCALE

PREPARED FOR
STONE CREEK 60'S POD, LTD.
8214 WESTCHESTER DRIVE, SUITE 710
DALLAS, TEXAS 75225
214-522-4945

CORWIN ENGINEERING, INC. — CONSULTING ENGINEERS


200 W. BELMONT, SUITE E

TBPE FIRM# 5951

ALLEN, TEXAS 75013

NOTE:
CITY OF ROCKWALL STANDARDS
AND NCTCOG 3rd ADDITION STANDARDS
SHALL BE USED FOR REFERENCE.

NO.	PER CITY COMMENTS	BY	DATE
1	PER CITY COMMENTS	DS	6-1-11
	REVISIONS		

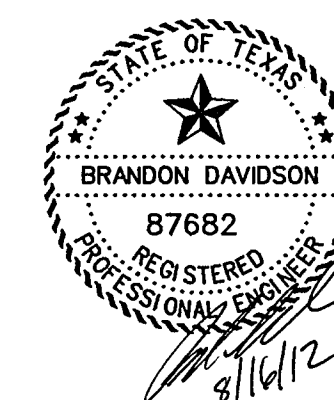

The seal appearing on
this document was
authorized by
Brandon Davidson
P.E. 87682, on
August 16, 2012

AS-BUILT AUGUST 2012
BASED ON SURVEYING AT THE SITE AND
INFORMATION PROVIDED BY CONTRACTORS