


DEVELOPMENT PLANS
FOR
STONE CREEK
PHASE IIA
CITY OF ROCKWALL, TEXAS

INDEX

1	TITLE
2	PLAT
3	DRAINAGE AREA MAP
4	DETENTION CALCULATIONS
5	CRESTFIELD DRIVE
6	CHATFIELD DRIVE & IRIS DRIVE
7	WATER AND SANITARY SEWER PLAN
8	SANITARY SEWER PROFILES
9	STORM SEWER PLAN
10	GRADING PLAN
11	POLLUTION PREVENTION PLAN

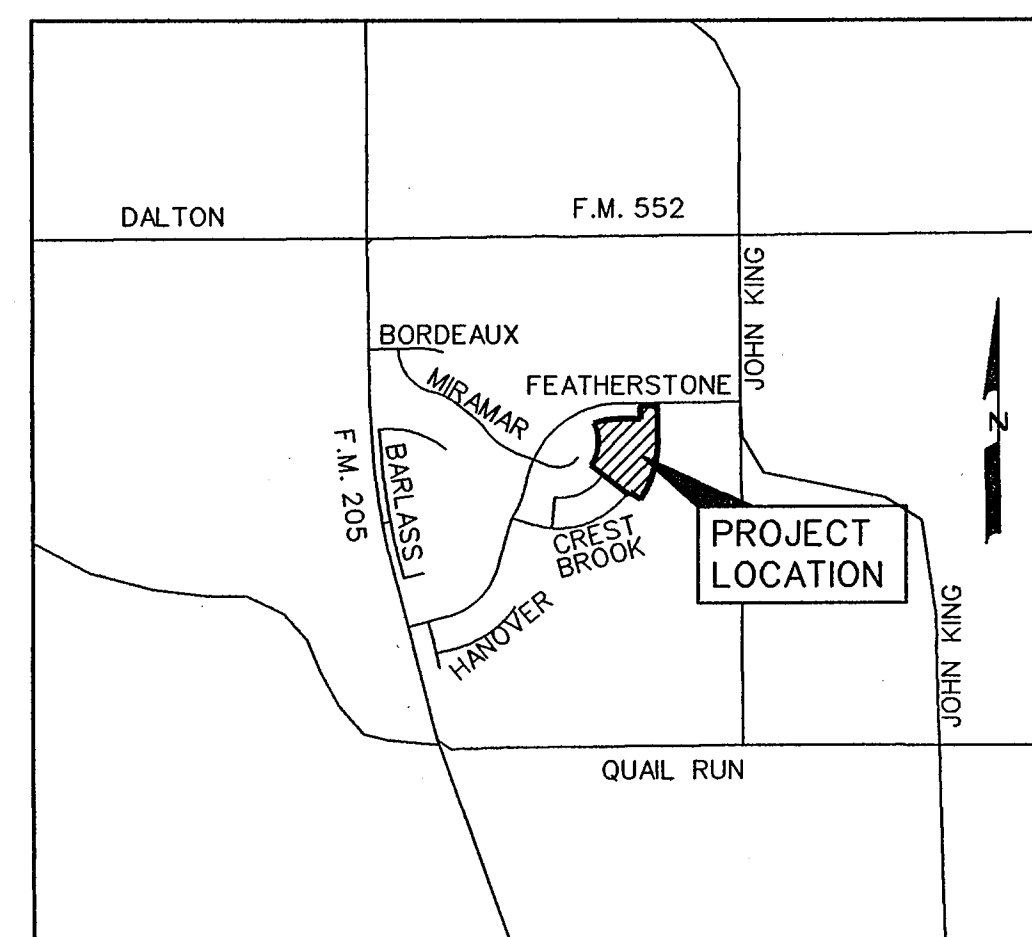

VICINITY MAP
NOT TO SCALE

PREPARED FOR
STONE CREEK 60'S POD, LTD.
8214 WESTCHESTER DRIVE, SUITE 710
DALLAS, TEXAS 75225
214-522-4945

CORWIN ENGINEERING, INC. — CONSULTING ENGINEERS

200 W. BELMONT, SUITE E


TBPE FIRM# 5951

ALLEN, TEXAS 75013

NOTE:



CITY OF ROCKWALL STANDARDS
AND NCTCOG 3rd ADDITION STANDARDS
SHALL BE USED FOR REFERENCE.

NO.	PER CITY COMMENTS	BY	DATE
1	PER CITY COMMENTS	DS	6-1-11
	REVISIONS		

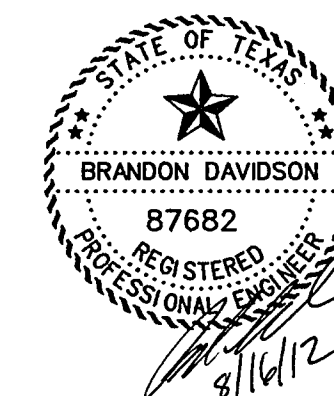

The seal appearing on
this document was
authorized by
Brandon Davidson
P.E. 87682, on
August 16, 2012

AS-BUILT AUGUST 2012
BASED ON SURVEYING AT THE SITE AND
INFORMATION PROVIDED BY CONTRACTORS

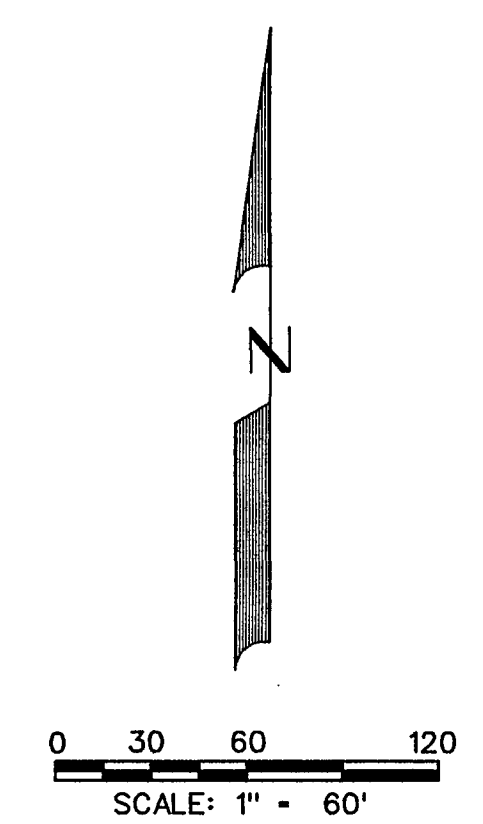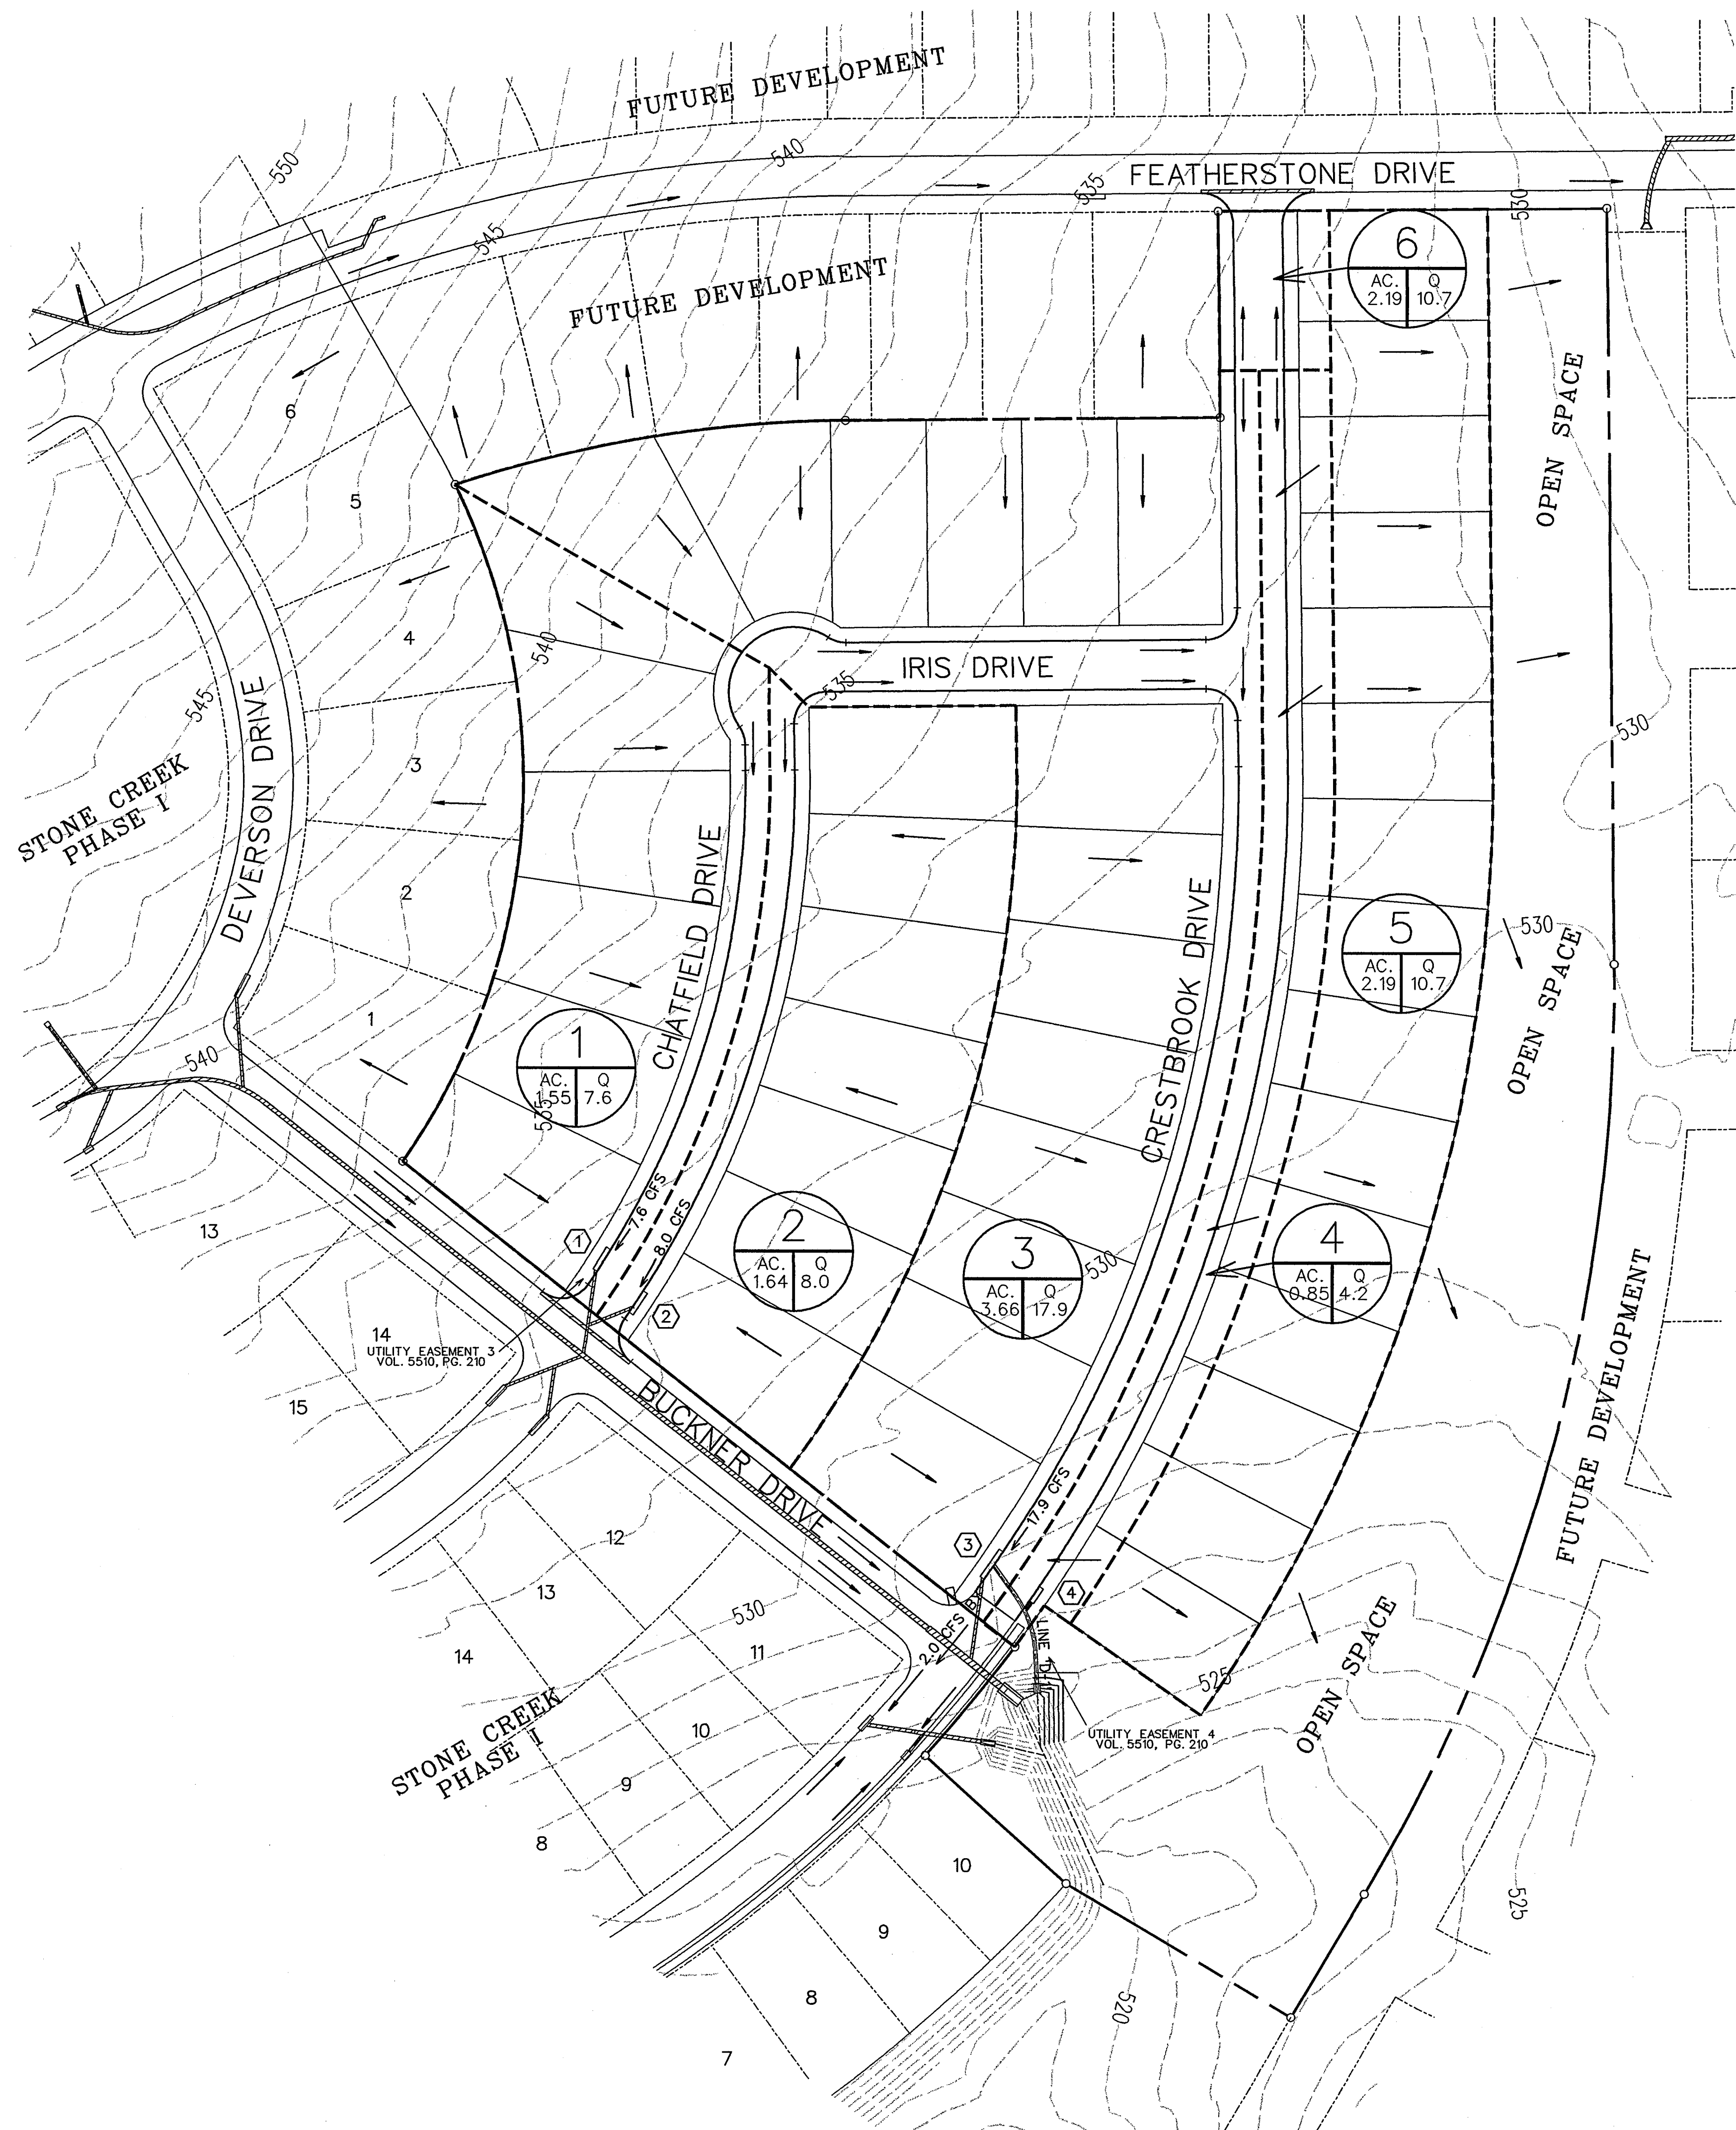

RUNOFF COMPUTATIONS

#	Area (sf)	Area (acres)	Coefficient	Runoff (in/hr)	Tc (min)	I(100) (in/hr)	Q(100) (cfs)
1	6752	1.55	0.50	10	10	9.8	7.6
2	7126	1.64	0.50	10	10	9.8	8.0
3	15935	3.66	0.50	10	10	9.8	17.9
4	37178	8.55	0.50	10	10	9.8	4.2
5	9501	2.19	0.50	10	10	9.8	10.7
6	7041	0.16	0.50	10	10	9.8	0.8


INLET CALCULATIONS

Inlet #	Location	Station	Design Storm Frequency (yrs.)	Time of Conc. (min.)	Intensity (in/hr)	Runoff (in/hr)	Area (acres)	Q (cfs)	Upstream Flow (cfs)	Carry-Over from Gutter (cfs)	Total Gutter Flow (cfs)	Gutter Capacity (cfs)	Gutter Slope (ft/ft)	Crown Type	Length (ft)	Selected Inlet Type	Carry-Over to Down-stream Inlet (cfs)
1	Chatfield	6+16.99	100	10	9.8	0.50	1.55	7.6	0.0	7.6	13.0	0.50%	6" pbi	15	STD.	0.0	
2	Chatfield	6+06.74	100	10	9.8	0.50	1.64	8.0	0.0	8.0	13.0	0.50%	6" pbi	15	STD.	0.0	
3	Crestbrook	13+44.85	100	10	9.8	0.50	3.66	17.9	0.0	17.9	18.0	0.94%	6" pbi	20	STD.	2.0	
4	Crestbrook	13+44.85	100	10	9.8	0.50	0.65	4.2	0.0	4.2	18.0	0.94%	6" pbi	10	STD.	0.0	

LEGEND

- PROP. STORM SEWER
- PROP. CURB INLETS
- PROP. CONC. HEADWALL
- EXIST. STORM SEWER
- DRAINAGE AREA DIVIDE
- FLOW ARROW
- DRAINAGE AREA NO.

1	ADDED LINE 'D-4', INLET # 4	DS	6-1-11
NO.	REVISIONS	BY	DATE

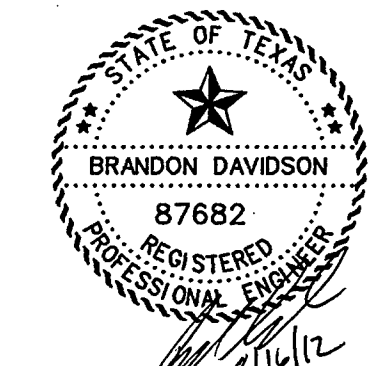

The seal appearing on this document was authorized by Brandon Davidson P.E. 87682, on August 16, 2012

AS-BUILT AUGUST 2012
 BASED ON SURVEYING AT THE SITE AND INFORMATION PROVIDED BY CONTRACTORS

CORWIN ENGINEERING, INC.
 200 W. BELMONT, SUITE E
 ALLEN, TEXAS 75013 (972) 396-1200
 TBPE FIRM #5951

**DEVELOPMENT PLANS FOR
 STONE CREEK PHASE IIA
 ROCKWALL, TEXAS**

DRAWN BY	DESIGNED BY	CHECKED BY	SHEET NO.
	CEI	CEI	
JOB NUMBER	DATE	SCALE:	
11009	MARCH 2011	1"=60'	3 OF 11

DETENTION CALCULATIONS - SOUTH TRIBUTARY UPSTREAM POND - INTERIM DESIGN

ALL CALCULATIONS ARE BASED ON THE POND BUILT IN STONE CREEK PHASE I. NO MODIFICATIONS TO THE EXISTING POND OR OUTFALL ARE NECESSARY BASED ON THESE CALCULATIONS.

ALLOWABLE RELEASE RATE CALCULATIONS

South Tributary Upstream Pond

2-Year Storm

Area #	Area (sf)	Area (acres)	Existing Runoff Coefficient	Tc - Existing (min)	Rainfall Intensity (in/hr)	Q - Undeveloped (cfs)
3	2951648	67.76	0.35	20	3.9	92.5
						67.76
						92.5

Post-Development Runoff Calculations

Area #	Area (sf)	Area (acres)	Existing Runoff Coefficient	Tc - Existing (min)	Rainfall Intensity (in/hr)	Q - Post Development (cfs)	Difference between Pre and Post Development Conditions
7	3017581	69.3	0.41	10	5.3	149.4	56.9
						69.27	149.4

10-Year Storm

Area #	Area (sf)	Area (acres)	Existing Runoff Coefficient	Tc - Existing (min)	Rainfall Intensity (in/hr)	Q - Undeveloped (cfs)
3	2951648	67.76	0.35	20	5.9	139.9
						139.9

Post-Development Runoff Calculations

Area #	Area (sf)	Area (acres)	Existing Runoff Coefficient	Tc - Existing (min)	Rainfall Intensity (in/hr)	Q - Post Development (cfs)	Difference between Pre and Post Development Conditions
7	3017581	69.3	0.41	10	7.1	200.1	60.2
						200.1	

25-Year Storm

Area #	Area (sf)	Area (acres)	Existing Runoff Coefficient	Tc - Existing (min)	Rainfall Intensity (in/hr)	Q - Undeveloped (cfs)
3	2951648	67.76	0.35	20	6.6	156.5
						156.5

Post-Development Runoff Calculations

Area #	Area (sf)	Area (acres)	Existing Runoff Coefficient	Tc - Existing (min)	Rainfall Intensity (in/hr)	Q - Post Development (cfs)	Difference between Pre and Post Development Conditions
7	3017581	69.3	0.41	10	8.3	281.2	124.7
						281.2	

50-Year Storm

Area #	Area (sf)	Area (acres)	Existing Runoff Coefficient	Tc - Existing (min)	Rainfall Intensity (in/hr)	Q - Undeveloped (cfs)
3	2951648	67.76	0.35	20	7.5	177.9
						177.9

Post-Development Runoff Calculations

Area #	Area (sf)	Area (acres)	Existing Runoff Coefficient	Tc - Existing (min)	Rainfall Intensity (in/hr)	Q - Post Development (cfs)	Difference between Pre and Post Development Conditions
7	3017581	69.3	0.41	10	9	253.6	75.8
						253.6	

100-Year Storm

Area #	Area (sf)	Area (acres)	Existing Runoff Coefficient	Tc - Existing (min)	Rainfall Intensity (in/hr)	Q - Undeveloped (cfs)
3	2951648	67.76	0.35	20	8.3	196.8
						196.8

Post-Development Runoff Calculations

Area #	Area (sf)	Area (acres)	Existing Runoff Coefficient	Tc - Existing (min)	Rainfall Intensity (in/hr)	Q - Post Development (cfs)	Difference between Pre and Post Development Conditions
7	3017581	69.3	0.41	10	9.8	276.2	79.3
						276.2	

DETENTION STORAGE REQUIREMENTS

DETENTION CALCULATIONS - 2 Year

Storm Duration	Inflow Duration	Area (AC.)	Future "C"	Future "KP"	Future "CA"	Rainfall Intensity	Inflow (cfs)	Volume (cubic ft.)	Volume (cubic ft.)	Volume (cubic ft.)	Volume (acre-ft.)	Outflow (cfs)
10	20	69.27	0.41	1.00	28.18	5.30	149.4	89614	53843	35771	0.82	89.7
20	30	69.27	0.41	1.00	28.18	3.90	109.9	131885	80785	51121	1.17	89.7
30	40	69.27	0.41	1.00	28.18	3.30	93.0	167393	107686	69707	1.37	89.7
40	50	69.27	0.41	1.00	28.18	2.60	73.3	175847	134608	41239	0.95	89.7
50	60	69.27	0.41	1.00	28.18	2.30	64.3	194448	151530	32917	0.76	89.7
60	70	69.27	0.41	1.00	28.18	1.90	53.5	182756	188451	4304	0.10	89.7
70	80	69.27	0.41	1.00	28.18	1.80	50.7	213046	215373	-2327	-0.05	89.7
80	90	69.27	0.41	1.00	28.18	1.70	47.9	229954	242294	-12340	-0.28	89.7
90	100	69.27	0.41	1.00	28.18	1.60	45.1	243481	269216	-25735	-0.59	89.7

DETENTION CALCULATIONS - 10 Year

Storm Duration	Inflow Duration	Area (AC.)	Future "C"	Future "KP"	Future "CA"	Rainfall Intensity	Inflow (cfs)	Volume (cubic ft.)	Volume (cubic ft.)	Volume (cubic ft.)	Volume (acre-ft.)	Outflow (cfs)
10	20	69.27	0.41	1.00	28.18	7.10	200.1	120050	59899	61061	1.40	98.3
20	30	69.27	0.41	1.00	28.18	5.90	166.3	199519	8483	111036	2.55	98.3
30	40	69.27	0.41	1.00	28.18	4.80	135.3	243481	117978	123503	2.88	98.3
40	50	69.27	0.41	1.00	28.18	4.00	112.7	270534	147472	123062	2.83	98.3
50	60	69.27	0.41	1.00	28.18	3.50	98.6	295897	176966	118930	2.73	98.3
60	70	69.27	0.41	1.00	28.18	3.00	84.5	304351	206461	97890	2.25	98.3
70	80	69.27	0.41	1.00	28.18	2.80	78.9	331404	235955	95449	2.19	98.3
80	90	69.27	0.41	1.00	28.18	2.60	73.3	351694	265450	86245	1.98	98.3
90	100	69.27	0.41	1.00	28.18	2.50	70.5	380439	294944	85495	1.96	98.3
100	110	69.27	0.41	1.00	28.18	2.30	64.8	388893	324439	64454	1.48	98.3

DETENTION CALCULATIONS - 25 Year

Storm Duration	Inflow Duration	Area (AC.)	Future "C"	Future "KP"	Future "CA"	Rainfall Intensity	Inflow (cfs)	Volume (cubic ft.)	Volume (cubic ft.)	Volume (cubic ft.)	Volume (acre-ft.)	Outflow (cfs)
10	20	69.27	0.41	1.00	28.18	8.30	233.9	140340	93698	46642	1.07	156.2
20	30	69.27	0.41	1.00	28.18	6.60	186.0	223191	140547	82644	1.90	156.2
30	40	69.27	0.41	1.00	28.18	5.50	155.0	278988	187395	91593	2.10	156.2
40	50	69.27	0.41	1.00	28.18	4.60	129.6	311114	234244	76870	1.76	156.2
50	60	69.27	0.41	1.00	28.18	4.00	112.7	338168	281093	57075	1.31	156.2
60	70	69.27	0.41	1.00	28.18	3.50	98.6	355076	327942	27134	0.62	156.2
70	80	69.27	0.41	1.00	28.18	3.30	93.0	390584	374791	15793	0.36	156.2
80	90	69.27	0.41	1.00	28.18	3.10	87.4	419328	421640	-2312	-0.05	156.2
90	100	69.27	0.41	1.00	28.18	2.90	81.7	441309	468489	-27180	-0.62	156.2
100	110	69.27	0.41	1.00	28.18	2.70	76.1	456526	515337	-58811	-1.35	156.2

DETENTION CALCULATIONS - 50 Year

Storm Duration	Inflow Duration	Area (AC.)	Future "C"	Future "KP"	Future "CA"	Rainfall Intensity	Inflow (cfs)	Volume (cubic ft.)	Volume (cubic ft.)	Volume (cubic ft.)	Volume (acre-ft.)	Outflow (cfs)
10	20	69.27	0.41	1.00	28.18	9.00	253.6	152175	103425	48750	1.12	172.4
20	30	69.27	0.41	1.00	28.18	7.50	211.4	253626	155138	98488	2.26	172.4
30	40	69.27	0.41	1.00	28.18	6.10	171.9	309423	206851	102572	2.35	172.4
40	50	69.27	0.41	1.00	28.18	5.20	146.5	351694	258564	93131	2.14	172.4
50	60	69.27	0.41	1.00	28.18	4.50	126.8	380439	310276	70162	1.61	172.4
60	70	69.27	0.41	1.00	28.18	3.90	109.9	395656	361989	33667	0.77	172.4
70	80	69.27	0.41	1.00	28.18	3.70	104.3	437927	413702	24225	0.56	172.4
80	90	69.27	0.41	1.00	28.18	3.50	98.6	473435	465415	8020	0.18	172.4
90	100	69.27	0.41	1.00	28.18	3.30	93.0	502179	517127	-14948	-0.34	172.4
100	110	69.27	0.41	1.00	28.18	3.00	84.5	507252	568840	-61589	-1.41	172.4

DETENTION CALCULATIONS - 100 Year

Storm Duration	Inflow Duration	Area (AC.)	Future "C"	Future "KP"	Future "CA"	Rainfall Intensity	Inflow (cfs)	Volume (cubic ft.)	Volume (cubic ft.)	Volume (cubic ft.)	Volume (acre-ft.)	Outflow (cfs)
10	20	69.27	0.41	1.00	28.18	9.80	276.2	165702	117887	47836	1.10	196.4
20	30	69.27	0.41	1.00	28.18	8.30	233.9	280679	176800	103879	2.38	196.4
30	40	69.27	0.41	1.00	28.18	6.90	194.4	350004	235733	114270	2.62	196.4
40	50	69.27	0.41	1.00	28.18	5.80	163.4	382275	294688	97608	2.24	196.4
50	60	69.27	0.41	1.00	28.18	5.00	140.9	422710	353600	69110	1.59	196.4
60	70	69.27	0.41	1.00	28.18	4.50	126.8	456526	412533	43994	1.01	196.4
70	80	69.27	0.41	1.00	28.18	4.00	112.7	473435	471468	1869	0.05	196.4
80	90	69.27	0.41	1.00	28.18	3.70	104.3	500488	530399	-29911	-0.69	196.4
90	100	69.27	0.41	1.00	28.18	3.50	98.6	532614	589333	-56719	-1.30	196.4

DETENTION POND RELEASE RATE CALCULATIONS


Elevation Calculations Based on Actual Release Rate

Event	Maximum Actual Release Rate	Storage Requirement	Occurs at Elevation
2-year	89.7	59707	515.63
10-year	98.3	125503	517.80
25-year	156.2	91593	516.81
50-year	172.4	102572	517.06
100-year	196.4	114270	517.43

Release Rate Calculations Based on Above Table - 9' Weir



Stage	H	Weir Length	Discharge	Allowable Discharge	Above (Below)
513.00	0.00	8.00	0.0		
514.00	1.00	8.00	21.0		
515.00	2.00	8.00	58.5		
515.63	2.63	8.00	89.7	92.5	(2.75)
515.80	2.79	8.00	98.3	139.9	(41.61)
516.00	3.00	8.00	109.3		
516.81	3.80	8.00	156.2	156.5	(0.36)
517.06	4.06	8.00	172.4	177.9	(5.50)
517.43	4.43	8.00	196.4	196.8	(0.40)
518.00	5.00	8.00	235.2		
519.00	6.00	8.00	309.2		

← MAXIMUM STORAGE REQUIRED

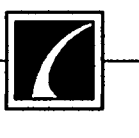NO.	REVISIONS	BY	DATE
 CORWIN ENGINEERING, INC. 200 W. BELMONT, SUITE E ALLEN, TEXAS 75013 (972) 396-1200			
CONSTRUCTION PLANS FOR STONE CREEK PHASE IIA ROCKWALL, TEXAS			
DETENTION CALCULATIONS			
DRAWN BY	DESIGNED BY	CHECKED BY	SHEET NO.
BDD	BDD	BDD	4 OF 11
JOB NUMBER	DATE	SCALE:	
11009	APRIL 2011	NTS	





The seal appearing on this document was authorized by Brandon Davidson P.E. 87682, on August 16, 2012

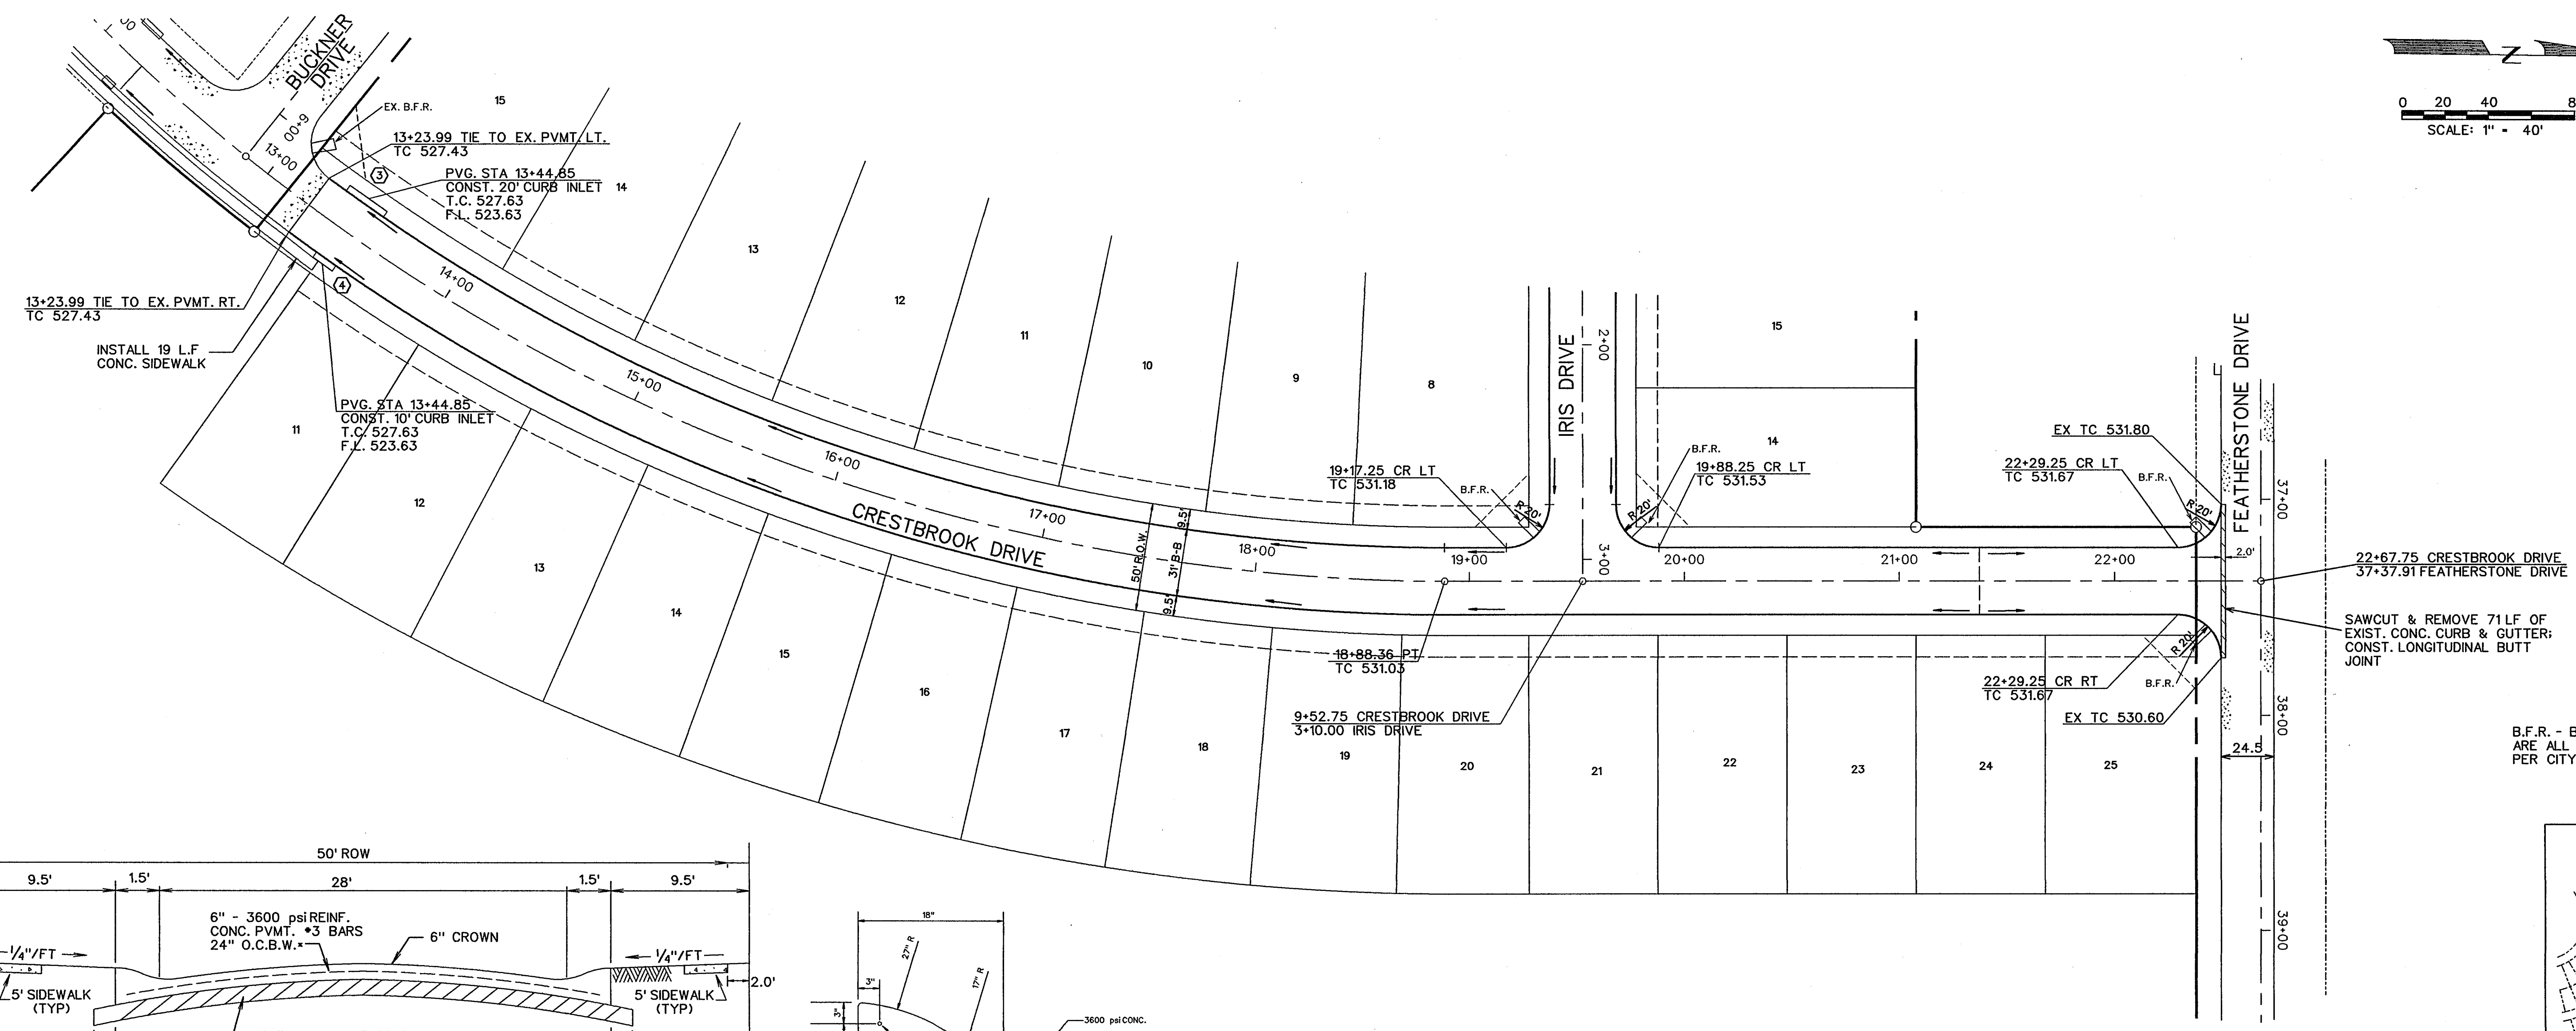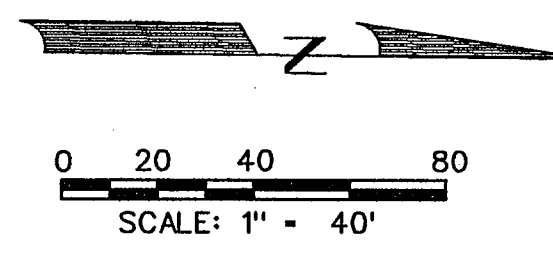

22+67.75 CRESTBROOK DRIVE
37+37.91 FEATHERSTONE DRIVE


SAWCUT & REMOVE 71 LF OF
EXIST. CONC. CURB & GUTTER;
CONST. LONGITUDINAL BUTT
JOINT

B.F.R. - BARRIER FREE PLATES
ARE ALL TRUNCATED DOME PLATES
PER CITY SPECIFICATIONS.

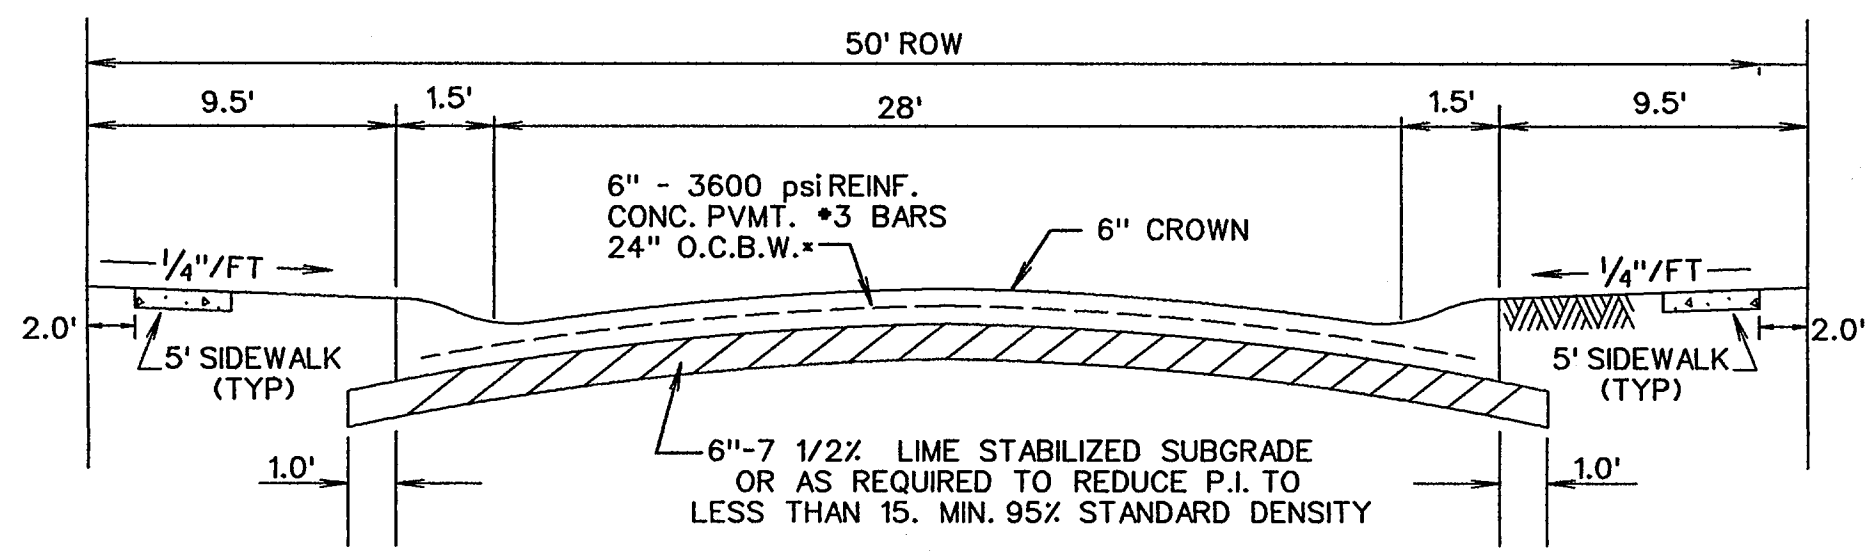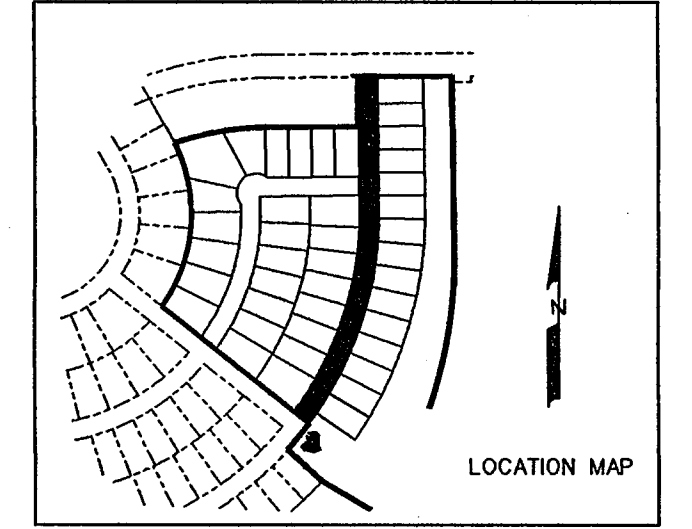


TYPICAL PAVEMENT SECTION - LAYDOWN CURB

N.T.S.
*MIN. 6 1/2 SACK MIX IF HAND PLACED

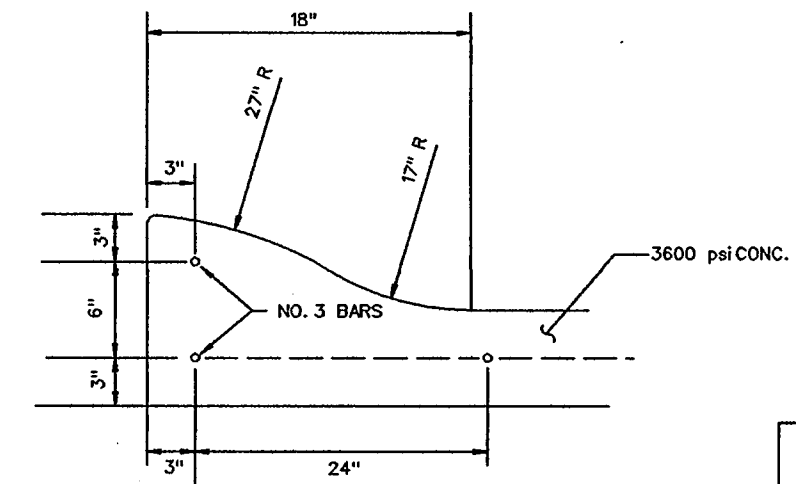

MONOLITHIC CURB

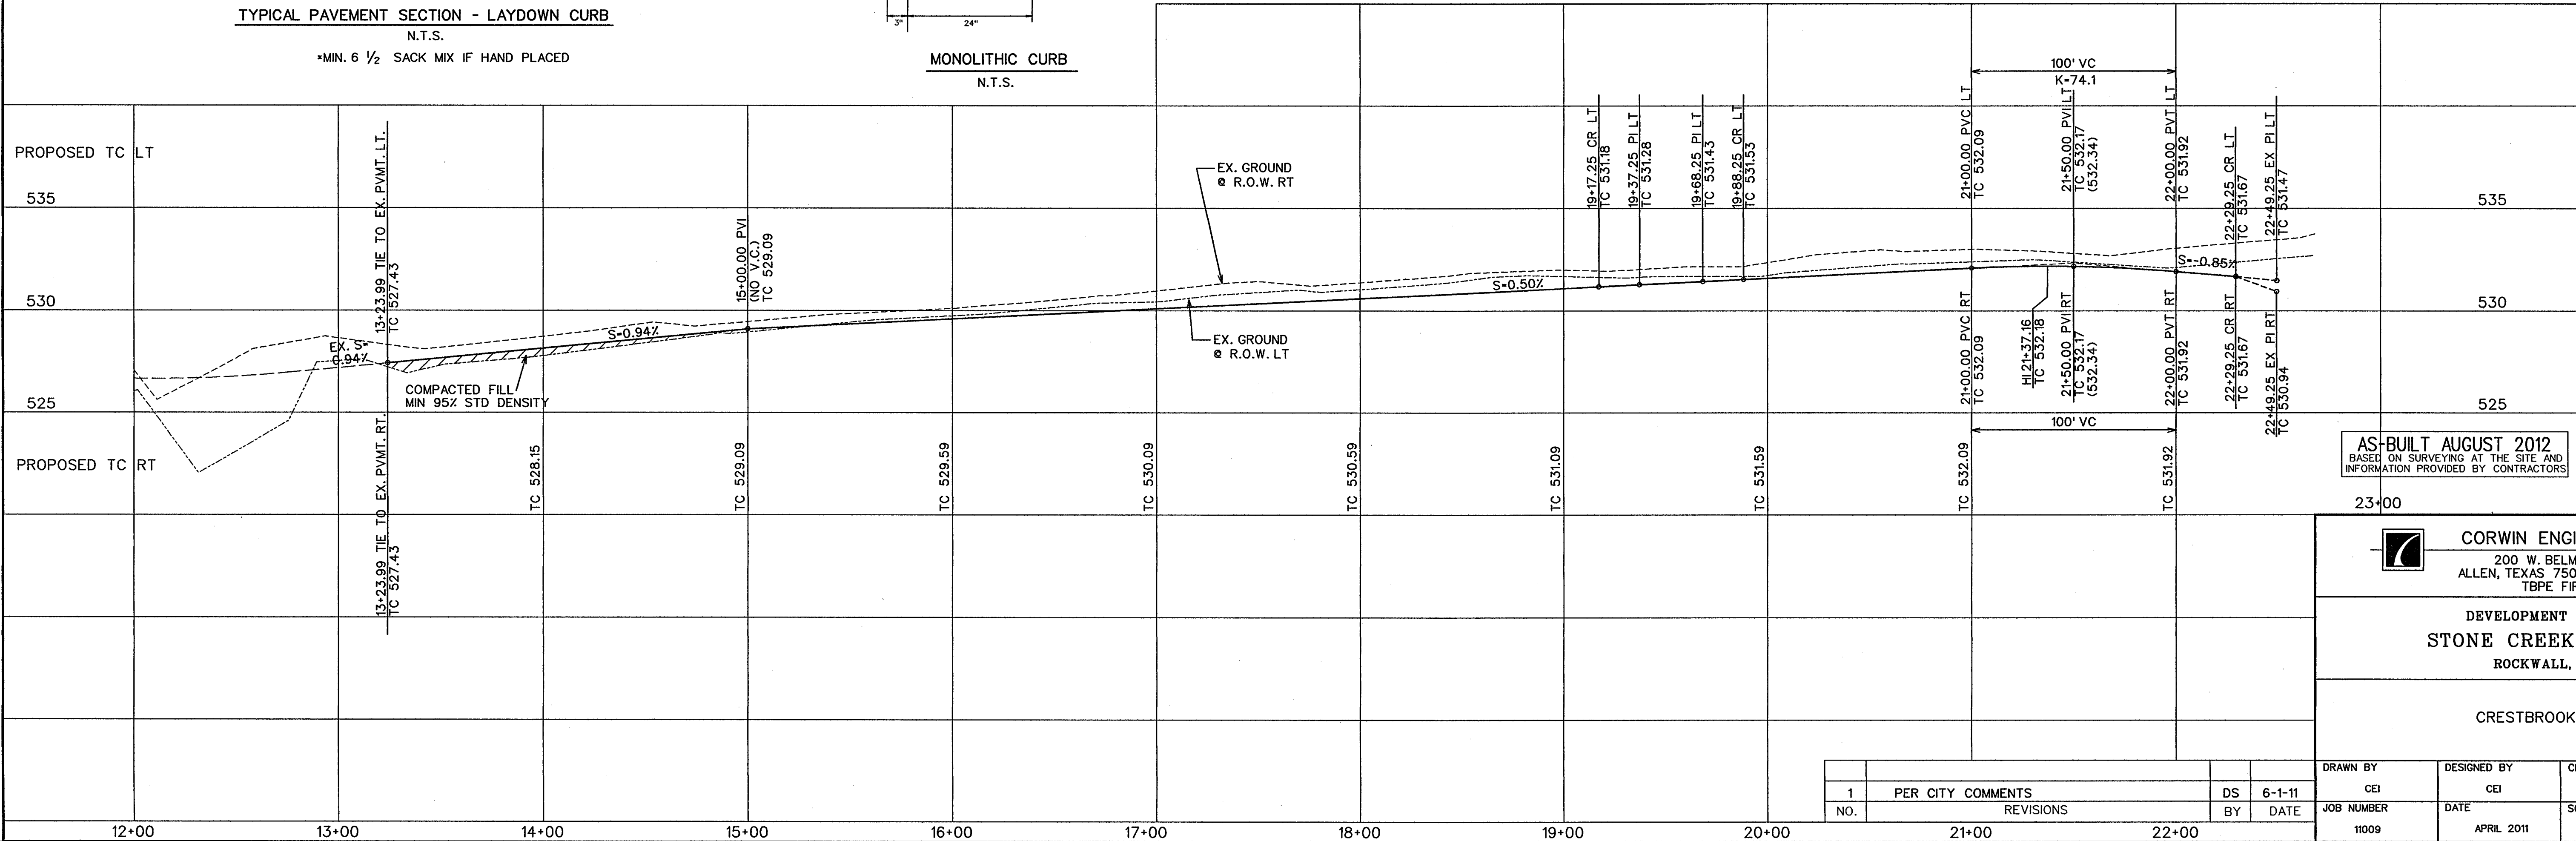


AS-BUILT AUGUST 2012
BASED ON SURVEYING AT THE SITE AND
INFORMATION PROVIDED BY CONTRACTORS

CORWIN ENGINEERING, INC.
200 W. BELMONT, SUITE E
ALLEN, TEXAS 75013 (972) 396-1200
TBPE FIRM #5951

DEVELOPMENT PLANS FOR
STONE CREEK PHASE IIA
ROCKWALL, TEXAS

CRESTBROOK DRIVE


1	PER CITY COMMENTS	DS	6-1-11	DRAWN BY CEI	DESIGNED BY CEI	CHECKED BY CEI	SHEET NO. 5 OF 11
NO.	REVISIONS	BY	DATE				
11009			APRIL 2011				

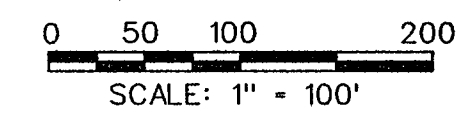

NOTE:
 ALL WATER LINES TO BE CLASS 200 PIPE SDR 14.
 ALL SANITARY SEWER PIPE TO BE SDR 35 FOR 5'-10' DEEP AND SDR 26 FOR 10' AND GREATER.
 INSTALL BLUE "EMS" DISK ON WATER LINE AT EVERY CHANGE IN DIRECTION, VALVE, AND SERVICE.
 INSTALL GREEN "EMS" DISK ON SANITARY SEWER LINE AT EVERY CHANGE IN DIRECTION, MANHOLE, CLEANOUT, AND SERVICE.
 ALL MANHOLES TO BE RAVEN EPOXY LINED AND SEALED IF LOCATED IN STREET PAVEMENT.

LEGEND


- PROP. WATER LINE
- PROP. FIRE HYDRANT AND VALVE
- PROP. GATE VALVE
- PROP. FLUSH VALVE
- EXIST. WATER LINE
- EXIST. FIRE HYDRANT AND VALVE
- PROP. SANITARY SEWER
- PROP. MANHOLE
- PROP. CLEANOUT
- EXIST. SANITARY SEWER
- EXIST. MANHOLE
- PROP. STORM SEWER
- PROP. CURB INLETS
- PROP. CONC. HEADWALL

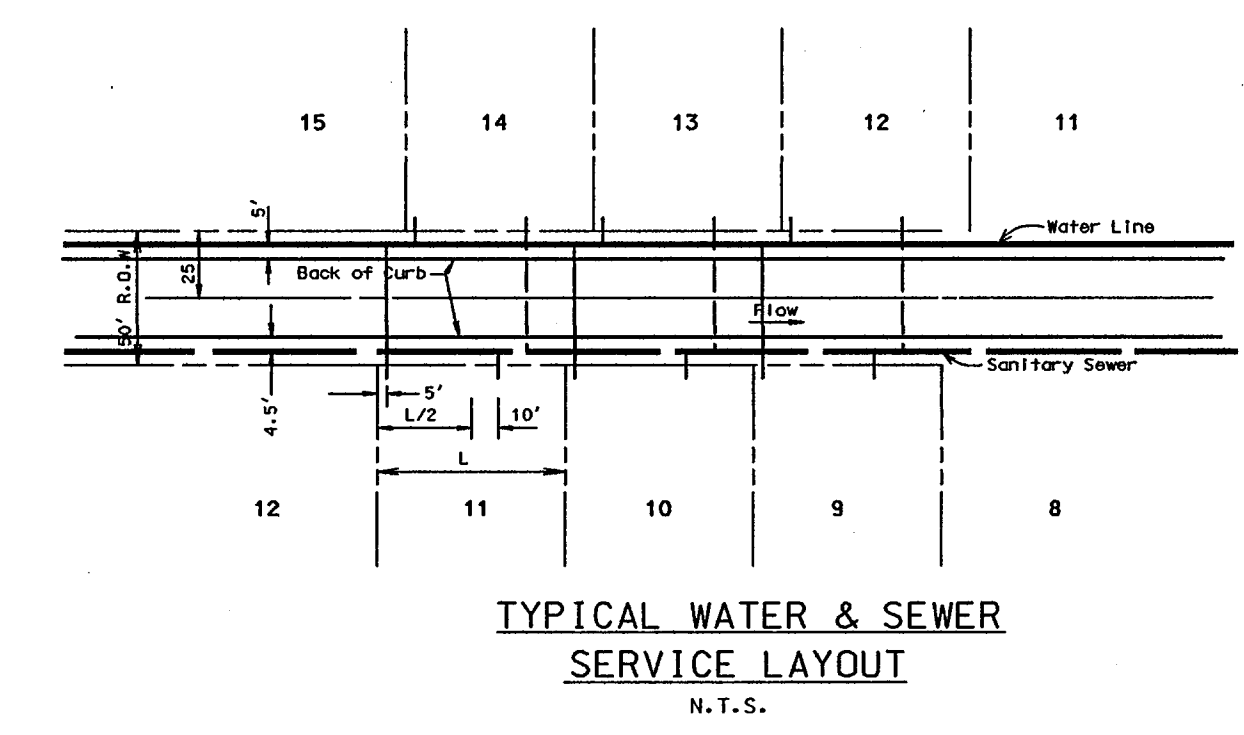


SANITARY SEWER CURVE DATA			
CURVE NO.	①	②	③
Δ	21° 20' 33"	14° 52' 32"	36° 30' 54"
R	905.00'	905.00'	595.00'
T	170.53'	118.14'	196.29'
L	337.11'	234.96'	338.03'

SERVICE SCHEDULE		
TYPE	SIZE	NO.
SANITARY	4"	41
WATER	1"	41

AS-BUILT AUGUST 2012
 BASED ON SURVEYING AT THE SITE AND
 INFORMATION PROVIDED BY CONTRACTORS

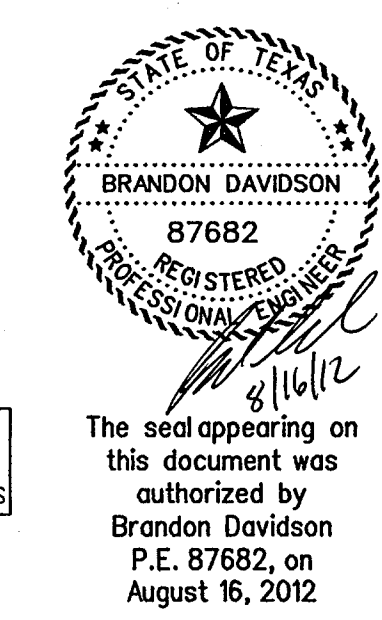

1	REVISED LINE 'S'-1, ADDED LINE 'S'-4'	DS	6-1-11
NO.	REVISIONS	BY	DATE
CORWIN ENGINEERING, INC. 200 W. BELMONT, SUITE E ALLEN, TEXAS 75013 (972) 396-1200 TBPE FIRM #5951			
CONSTRUCTION PLANS FOR STONE CREEK PHASE IIA ROCKWALL, TEXAS			
WATER AND SANITARY SEWER PLAN			
DRAWN BY CMF	DESIGNED BY WLC	CHECKED BY WLC	SHEET NO.
JOB NUMBER 11009	DATE APRIL 2011	SCALE: 1"=100'	7 OF 11

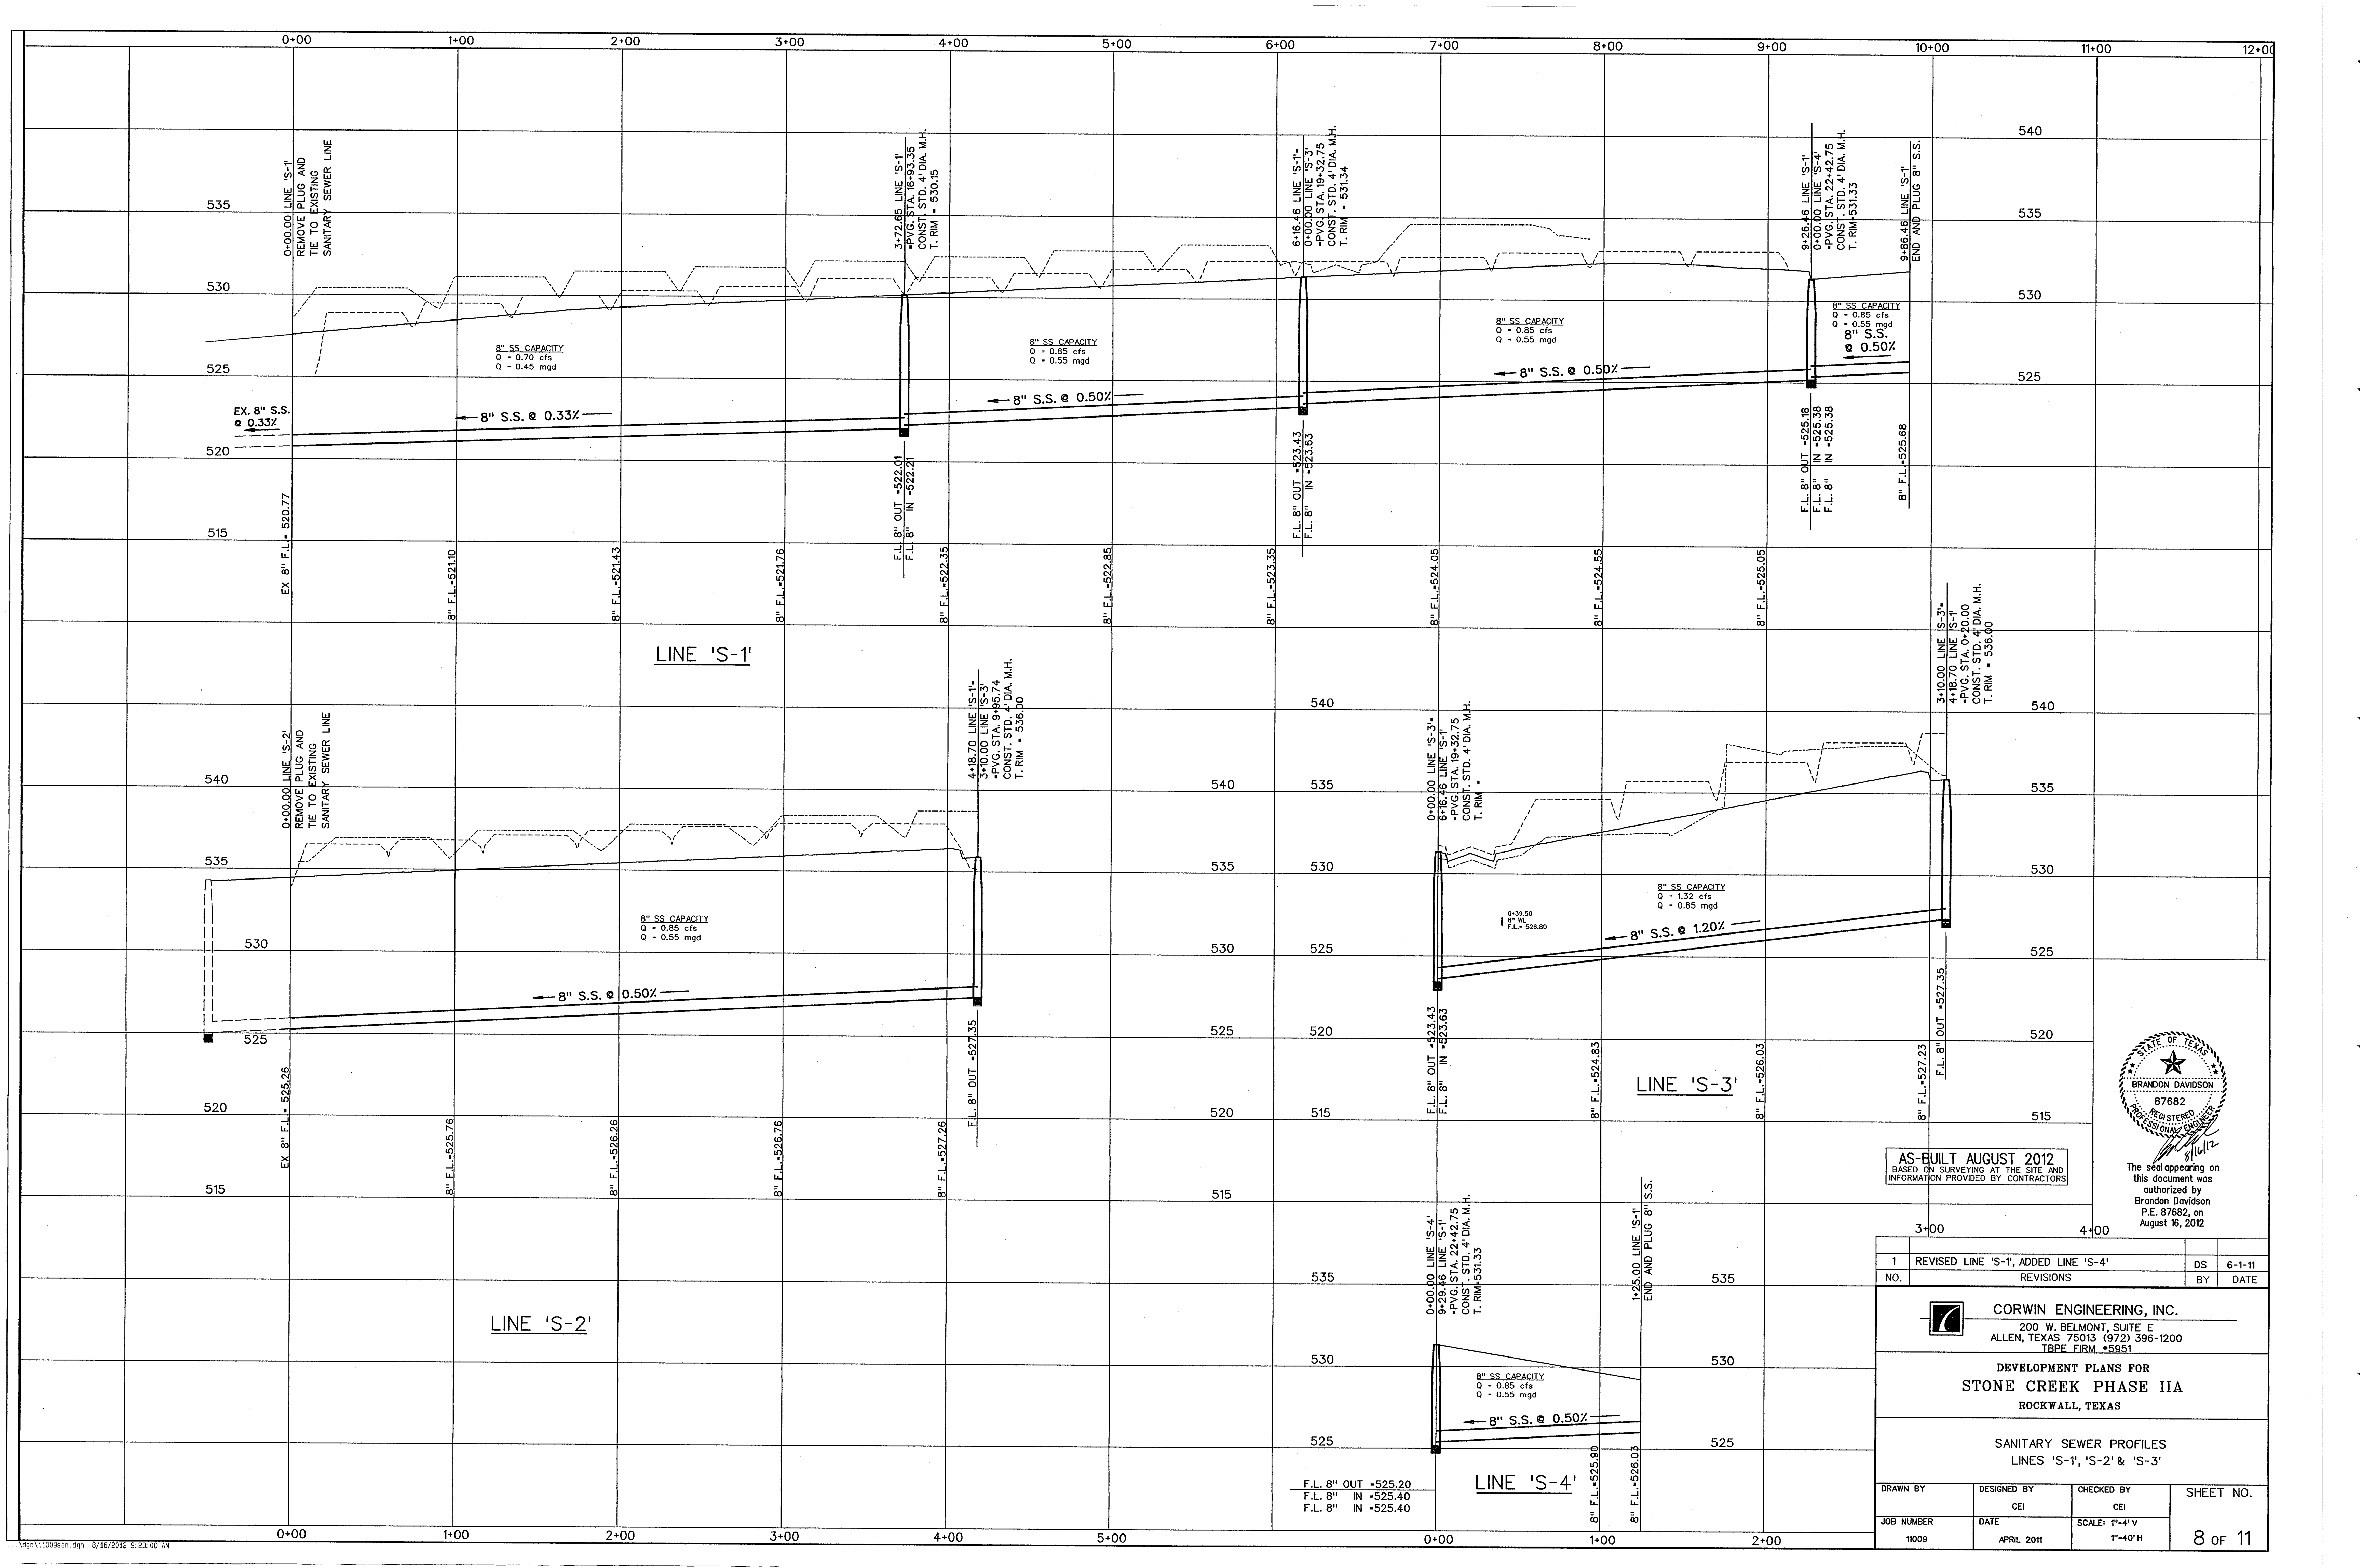

AS-BUILT AUGUST 2012
BASED ON SURVEYING AT THE SITE AND
INFORMATION PROVIDED BY CONTRACTORS

The seal appearing on
this document was
authorized by
Brandon Davidson
P.E. 87682, on
August 16, 2012



NO.	REVISIONS	DS	DATE
1	REVISED LINE 'S-1', ADDED LINE 'S-4'	DS	6-1-11

CORWIN ENGINEERING, INC.
200 W. BELMONT, SUITE E
ALLEN, TEXAS 75013 (972) 396-1200
TBP# FIRM #5951

DEVELOPMENT PLANS FOR
STONE CREEK PHASE IIA
ROCKWALL, TEXAS

SANITARY SEWER PROFILES
LINES 'S-1', 'S-2' & 'S-3'

DRAWN BY	DESIGNED BY	CHECKED BY	SHEET NO.
	CEI	CEI	8 OF 11
JOB NUMBER	DATE	SCALE: 1"=4' V 1"=40' H	
11009	APRIL 2011		

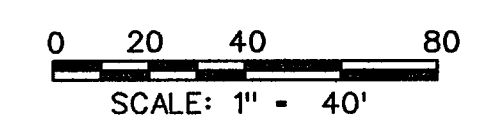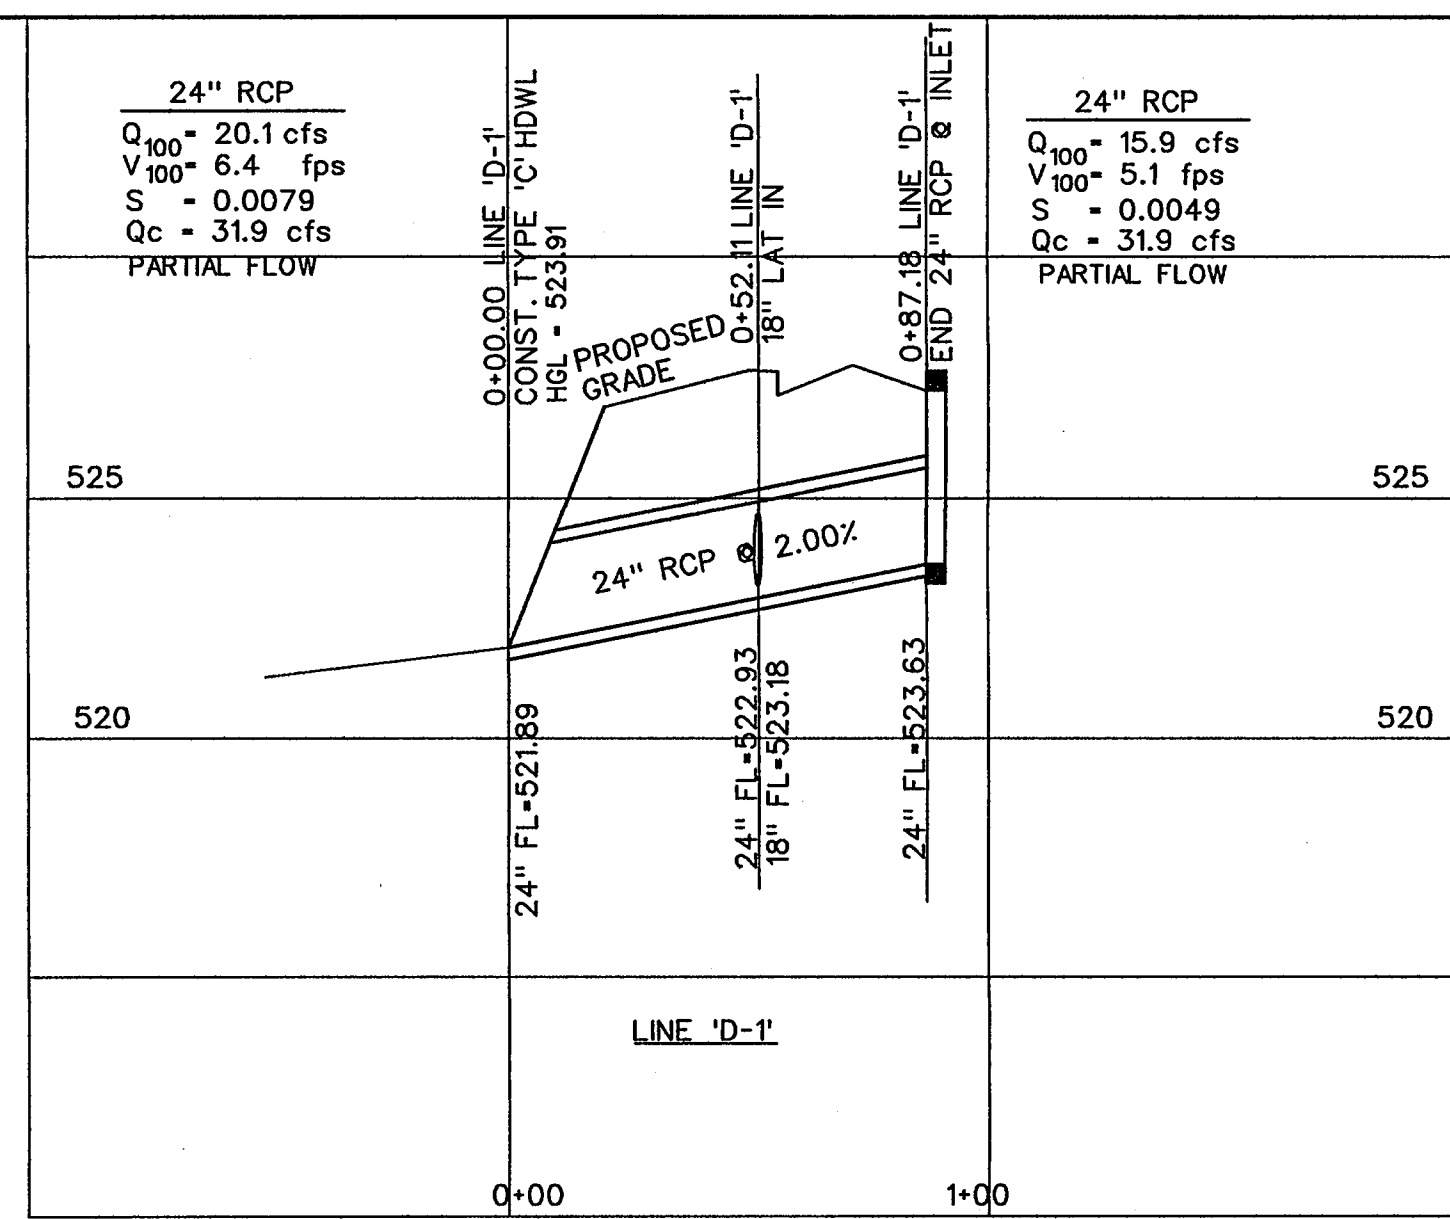

STORM SEWER CURVE DATA			
CURVE NO.	①	②	③
Δ	32° 26' 28"	• "	• "
R	65.00'	'	'
T	18.91'	'	'
L	36.80'	'	'

LEGEND

- Ⓟ - BLOCK LABEL
- Ⓢ - INLET NUMBER
- - SANITARY SEWER
- ⊕ - WATER
- ▨ - EXISTING STORM SEWER

1	ADDED LINE 'D-1', ADDED HGL	DS	6-1-11
NO.	REVISIONS	BY	DATE



The seal appearing on this document was authorized by Brandon Davidson P.E. 87682, on August 16, 2012

AS-BUILT AUGUST 2012
BASED ON SURVEYING AT THE SITE AND INFORMATION PROVIDED BY CONTRACTORS

CORWIN ENGINEERING, INC.
 200 W. BELMONT, SUITE E
 ALLEN, TEXAS 75013 (972) 396-1200
 TBPE FIRM #5951


**DEVELOPMENT PLANS FOR
 STONE CREEK PHASE IIA
 ROCKWALL, TEXAS**

STORM SEWER PLAN


DRAWN BY	DESIGNED BY	CHECKED BY	SHEET NO.
	CEI	CEI	9 of 11
JOB NUMBER	DATE	SCALE: 1"=4'-V 1"=40'-H	
11009	APRIL 2011		



0 50 100 200
SCALE: 1" = 100'


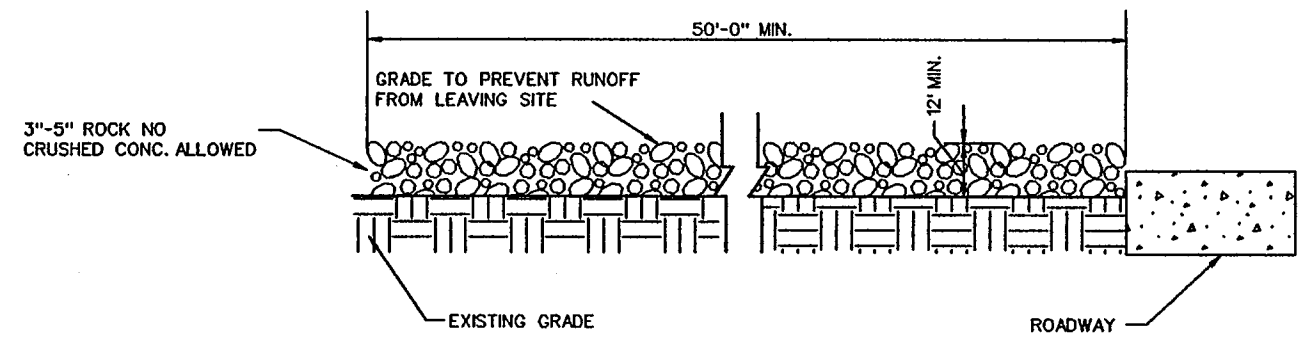


PROFILE

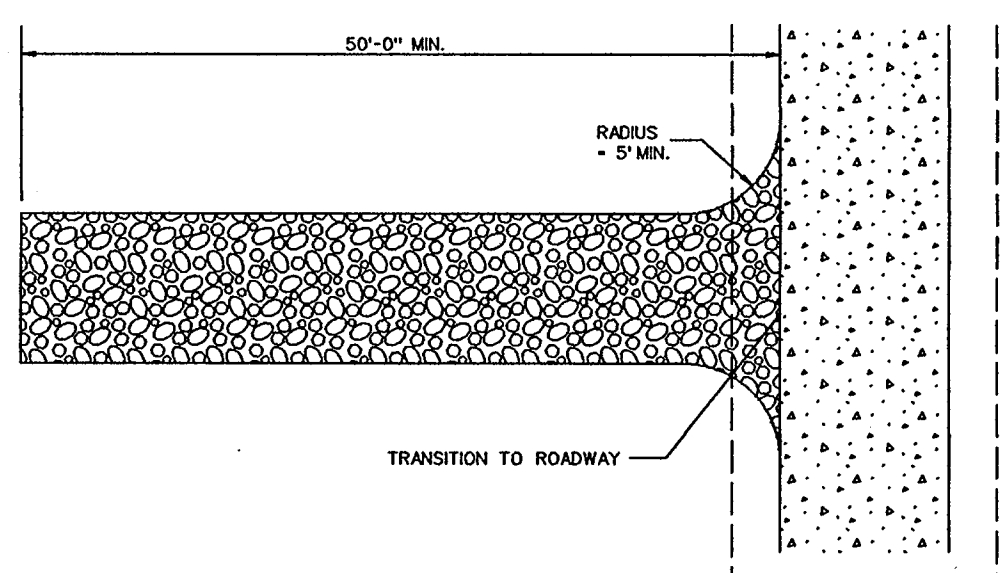


PLAN VIEW

STABILIZED ENTRANCE DETAIL

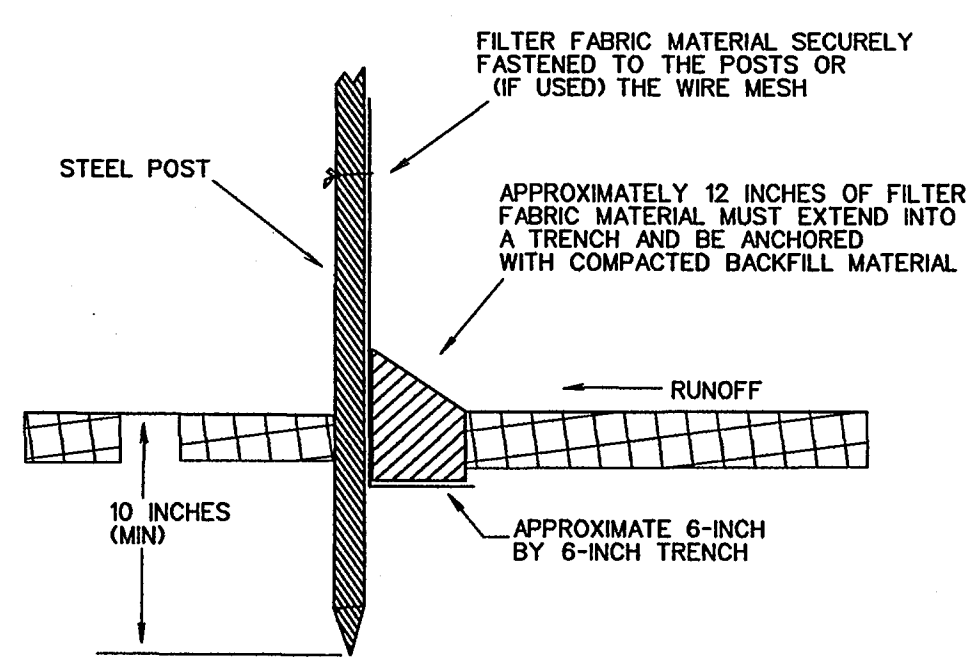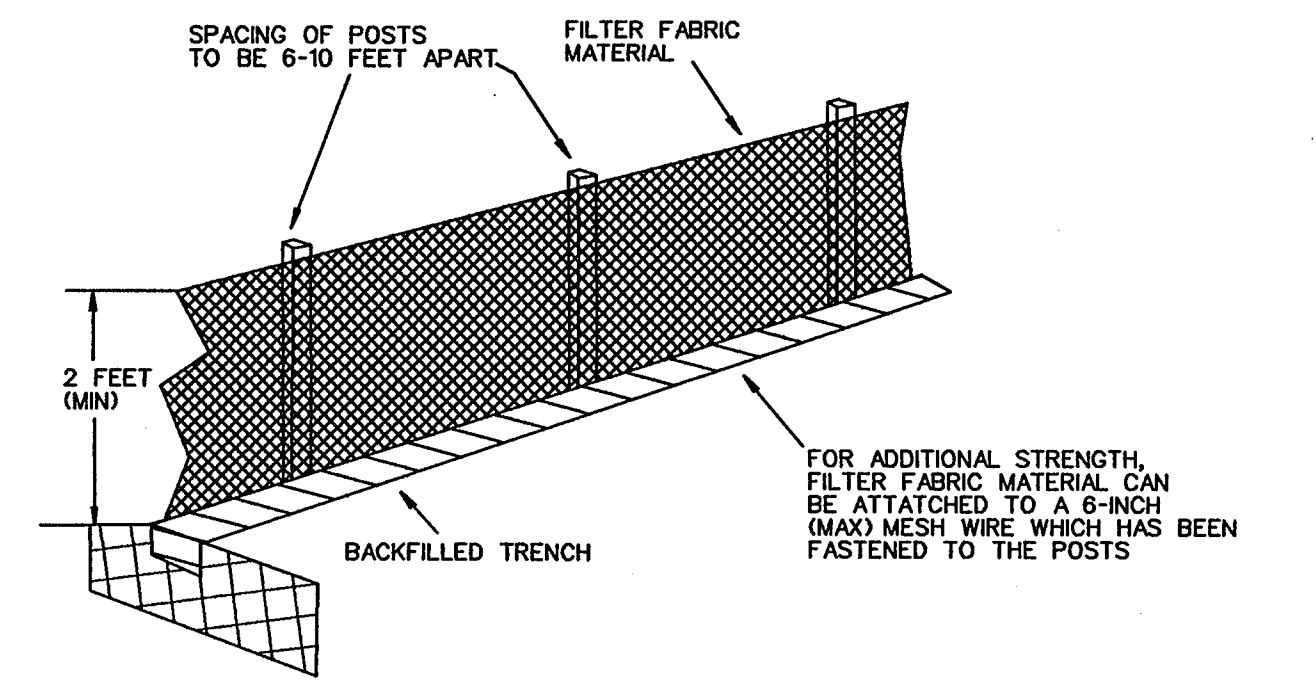


FILTER FABRIC FENCE DETAIL

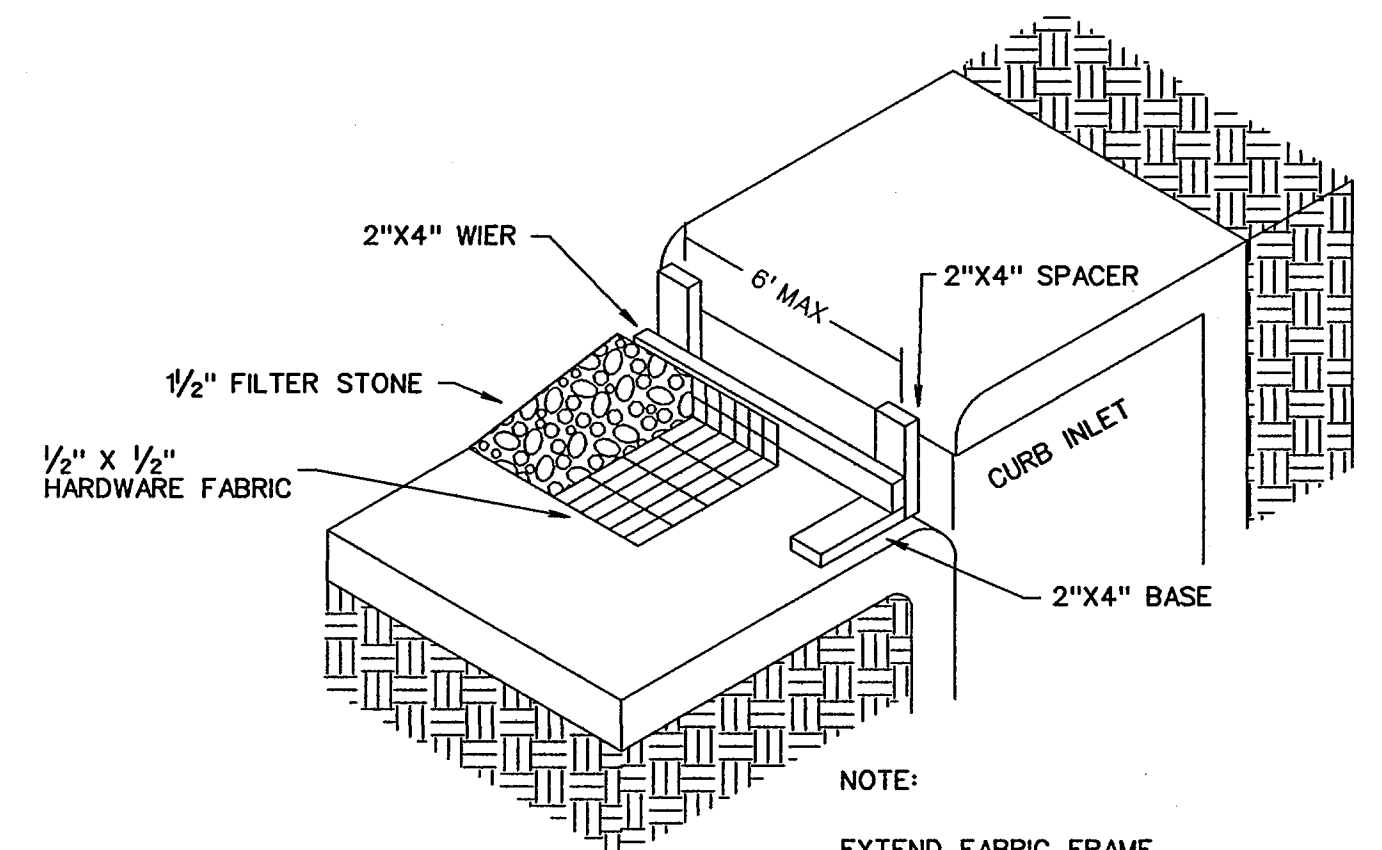

TYPE B CURB INLET PROTECTION

NOTE:
EXTEND FABRIC, FRAME AND FILTER STONE 12' BEYOND END OF INLET ON BOTH ENDS.

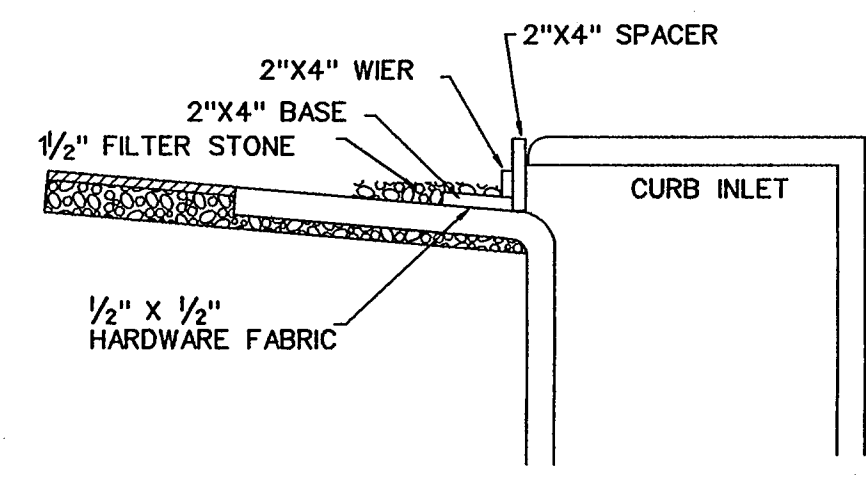

INLET SECTION

CONSTRUCTION SEQUENCE

1. GRADING CONTRACTOR TO INSTALL TEMPORARY STABILIZED ENTRANCE.
2. INSTALL SILT FENCE AS SHOWN, (TS-600 POLY FELT) PER C.O.G. SPECIFICATIONS.
3. PERFORM GRADING AND UTILITY CONSTRUCTION.
4. AFTER THE INLET BOTTOMS ARE CONSTRUCTED, THE INLETS SHALL BE FILLED WITH STONE AND COVERED WITH A FILTER FABRIC (TS-600 POLY FELT OR EQUIVALENT) BY UTILITY CONTRACTOR.
5. PRIOR TO CITY RELEASING PAVING, SOD OR SEEDED CURLEX SHALL BE INSTALLED ON SIDES AND BOTTOM OF ALL DETENTION PONDS.
6. AFTER PAVING AND COMPLETION OF INLETS, INLET FILTERS SHALL BE INSTALLED IN ALL INLETS AND MAINTAINED UNTIL RE-VEGETATION HAS BEEN COMPLETED BY PAVING CONTRACTOR.
7. SILT FENCE SHALL REMAIN IN PLACE UNTIL RE-VEGETATION HAS BEEN COMPLETED.
8. PAVING CONTRACTOR SHALL REMOVE TEMPORARY STABILIZED ENTRANCE.
9. PRIOR TO CITY ACCEPTANCE THE PAVING CONTRACTOR SHALL BE RESPONSIBLE FOR REMOVING ANY MUD OR SILT WHICH COLLECTS ON THE EXISTING AND NEW PAVEMENT.

LEGEND

- SILT FENCE (BEFORE CONSTRUCTION)
- INLET PROTECTION

NO.	REVISIONS	BY	DATE
CORWIN ENGINEERING, INC. 200 W. BELMONT, SUITE E ALLEN, TEXAS 75013 (972) 396-1200 TBPE FIRM #5951			
CONSTRUCTION PLANS FOR STONE CREEK PHASE IIA ROCKWALL, TEXAS			
POLLUTION PREVENTION PLAN			
DRAWN BY CMF	DESIGNED BY CEI	CHECKED BY CEI	SHEET NO.
JOB NUMBER 11009	DATE APRIL 2011	SCALE: 1"=100'	11 OF 11

AS-BUILT AUGUST 2012
BASED ON SURVEYING AT THE SITE AND
INFORMATION PROVIDED BY CONTRACTORS