


DEVELOPMENT PLANS FOR STONE CREEK PHASE IIB CITY OF ROCKWALL, TEXAS

INDEX

1	TITLE
2	PLAT
3	DRAINAGE AREA MAP
4	BORDEAUX DRIVE
5	STONE CREEK DRIVE
6	DEVORSON DRIVE STA. 0+00 - 12+00
7	DEVORSON DRIVE STA. 12+00 - END & GREENWAY DRIVE
8	WATER AND SANITARY SEWER PLAN
9	SANITARY SEWER PROFILES
10	STORM SEWER PLAN AND PROFILE LINE 'D-1' AND LATERALS
11	GRADING PLAN
12	GRADING PLAN
13	POLLUTION PREVENTION PLAN

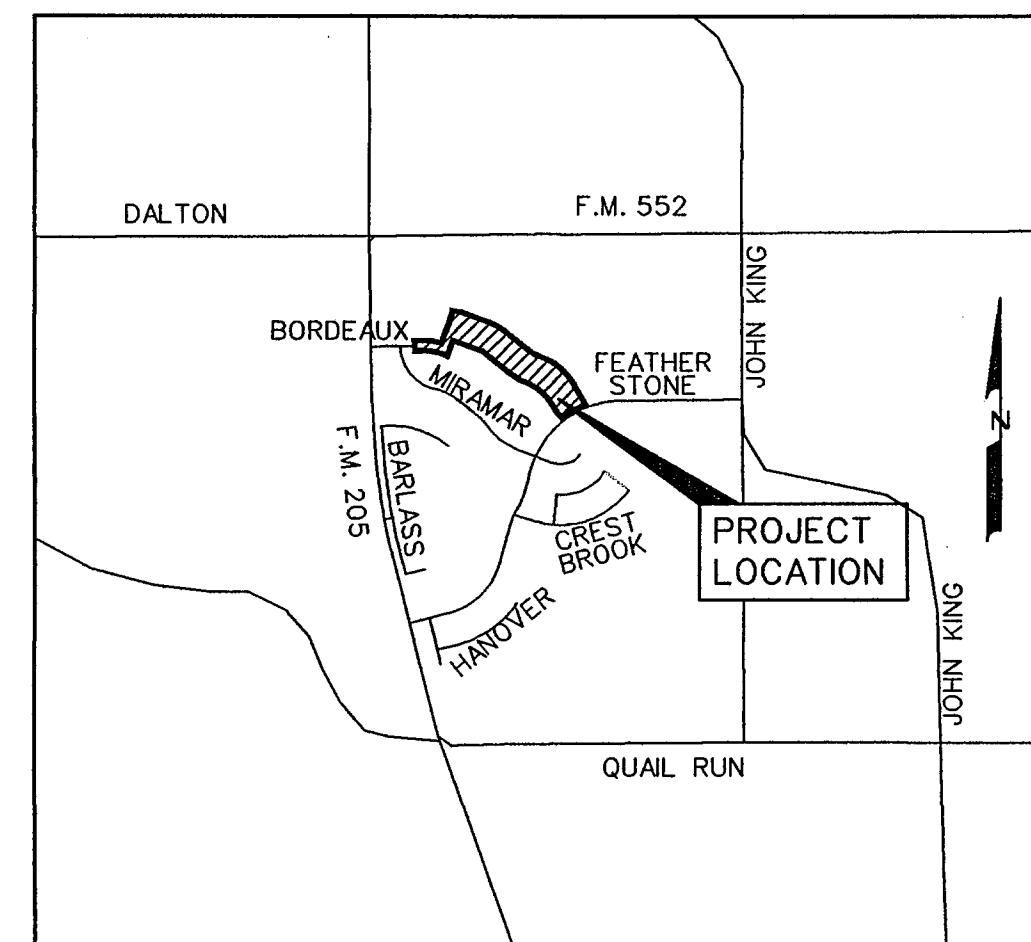

VICINITY MAP
NOT TO SCALE

PREPARED FOR
STONE CREEK 50'S POD, LTD.

8214 WESTCHESTER DRIVE, SUITE 710
DALLAS, TEXAS 75225
214-522-4945

CORWIN ENGINEERING, INC. — CONSULTING ENGINEERS

200 W. BELMONT, SUITE E

TBPE FIRM# 5951


ALLEN, TEXAS 75013

NOTE:

CITY OF ROCKWALL STANDARDS
AND NCTCOG 3rd ADDITION STANDARDS
SHALL BE USED FOR REFERENCE.

NO.	REVISIONS	BY	DATE
1	PER CITY COMMENTS	DS	6-3-11

AS-BUILT AUGUST 2012
BASED ON SURVEYING AT THE SITE AND
INFORMATION PROVIDED BY CONTRACTORS

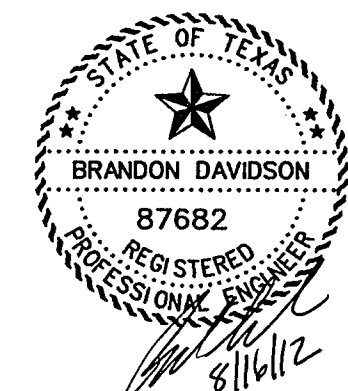

The seal appearing on
this document was
authorized by
Brandon Davidson
P.E. 87682, on
August 16, 2012