


NO.	PER CITY COMMENTS	REVISIONS	DS	6-1-11
1			BY	DATE

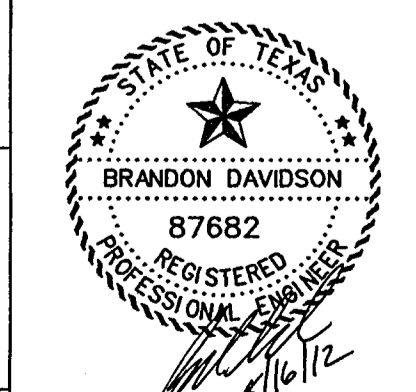

The seal appearing on this document was authorized by Brandon Davidson P.E. 87682, on August 16, 2012.

AS-BUILT AUGUST 2012
 BASED ON SURVEYING AT THE SITE AND INFORMATION PROVIDED BY CONTRACTORS

CORWIN ENGINEERING, INC.
 200 W. BELMONT, SUITE E
 ALLEN, TEXAS 75013 (972)396-1200
 TBPE FIRM #5951

DEVELOPMENT PLANS FOR
STONE CREEK PHASE IIB
 ROCKWALL, TEXAS

DEVERSON DRIVE STA. 0+00 - 12+00

DRAWN BY BDD	DESIGNED BY BDD	CHECKED BY BDD	SHEET NO. 6 OF 13
JOB NUMBER 11010	DATE APRIL 2011	SCALE: HOR: 1"=40' VER: 1"=4'	