



B.F.R. - BARRIER FREE RAMPS ARE ALL TRUNCATED DOME PLATES PER CITY SPECIFICATIONS

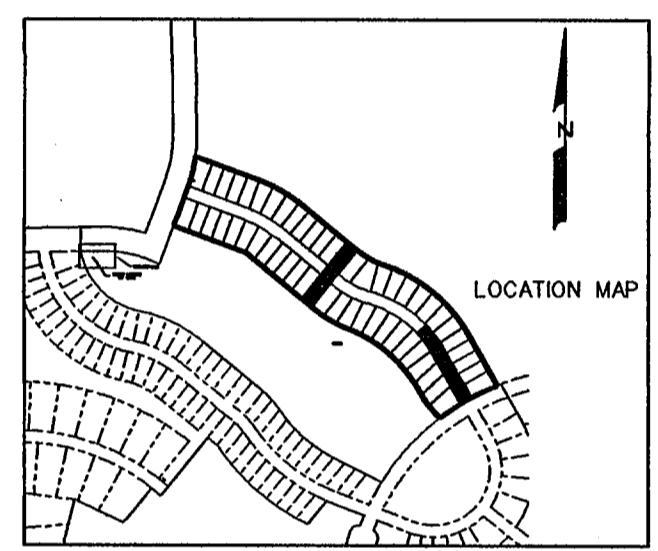

NO.	PER CITY COMMENTS	DS	DATE
1	PER CITY COMMENTS	DS	6-2-11

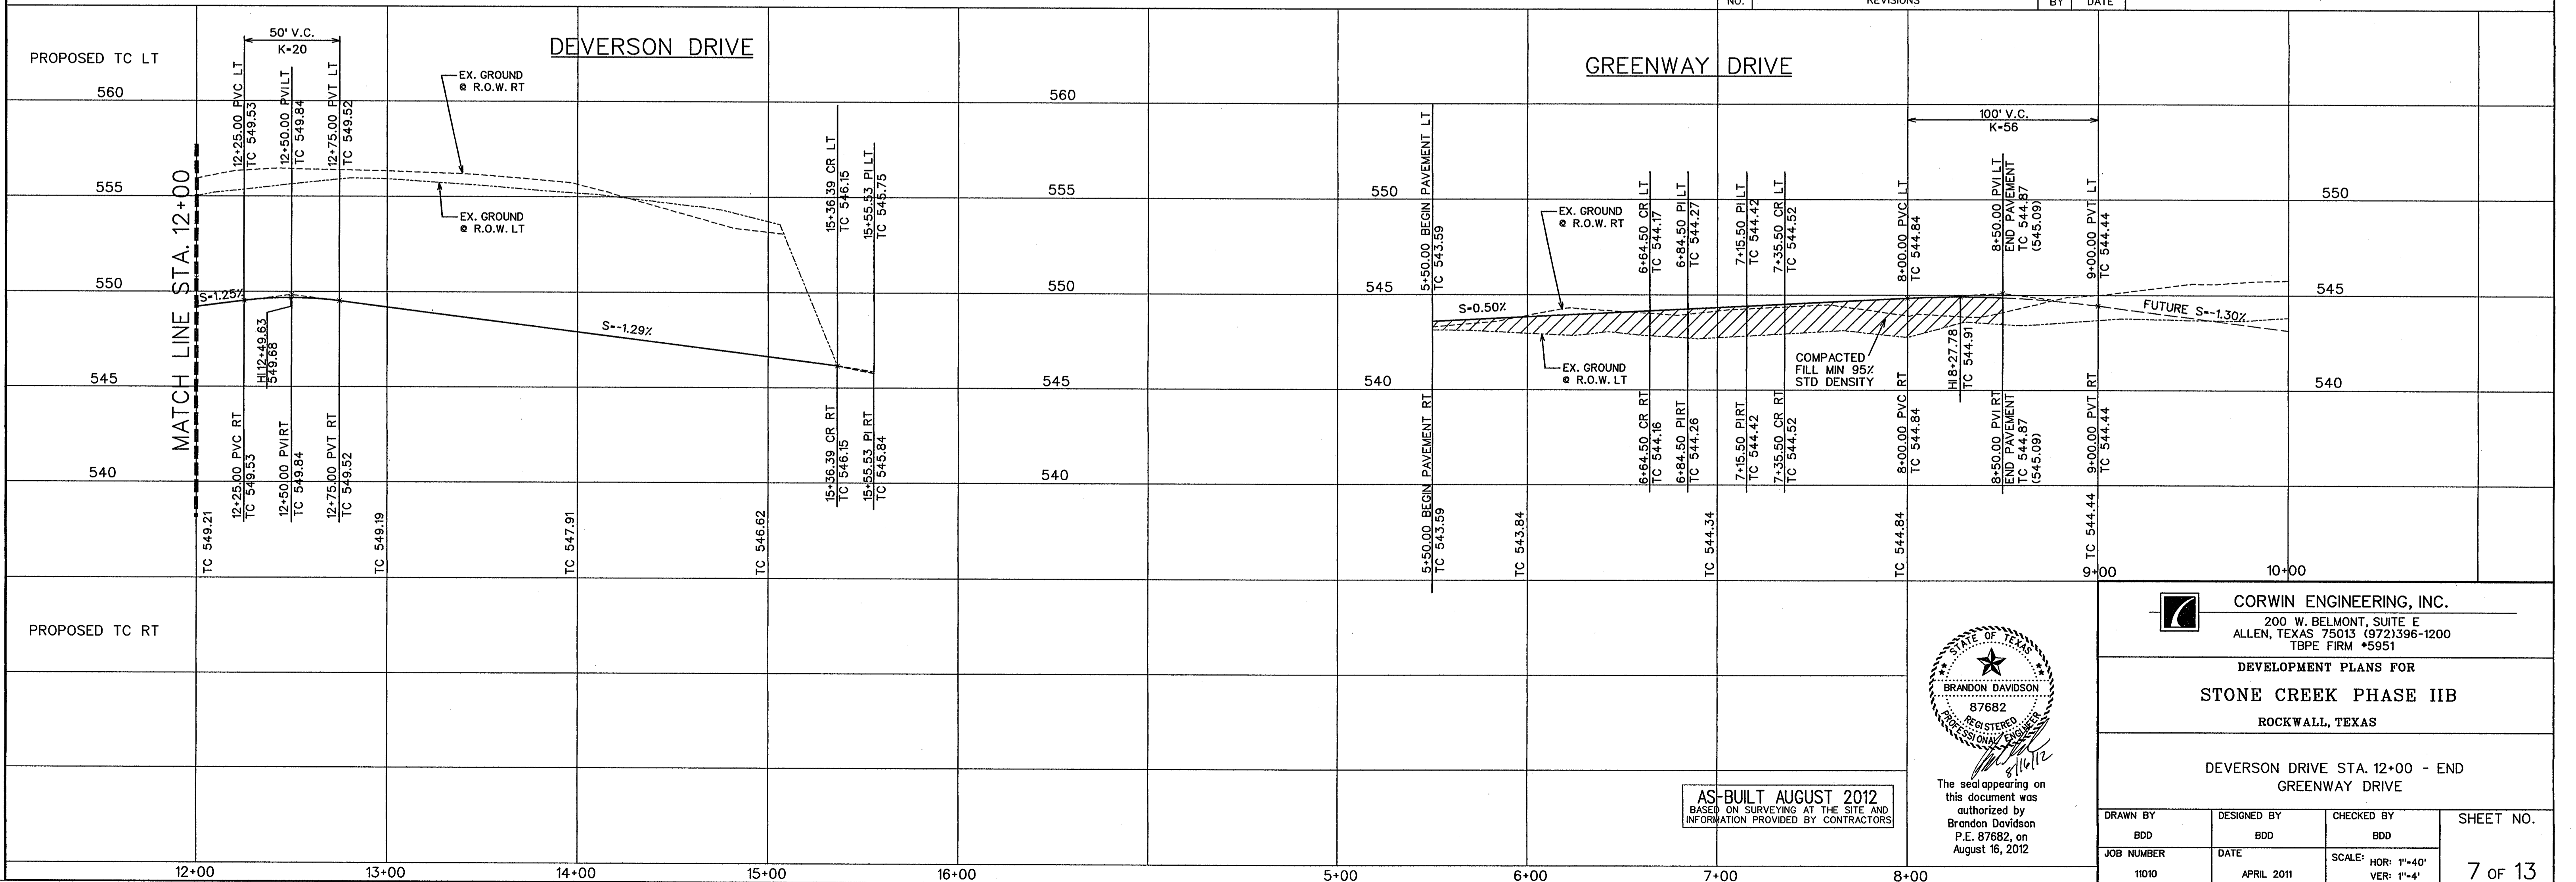

The seal appearing on this document was authorized by Brandon Davidson P.E. 87682, on August 16, 2012

**CORWIN ENGINEERING, INC.**  
200 W. BELMONT, SUITE E  
ALLEN, TEXAS 75013 (972)396-1200  
TBPE FIRM #5951

DEVELOPMENT PLANS FOR  
**STONE CREEK PHASE IIB**  
ROCKWALL, TEXAS

DEVERSON DRIVE STA. 12+00 - END  
GREENWAY DRIVE

DRAWN BY BDD	DESIGNED BY BDD	CHECKED BY BDD	SHEET NO. 7 OF 13
JOB NUMBER 11010	DATE APRIL 2011	SCALE: HOR: 1"=40' VER: 1"=4'	