


AS-BUILT AUGUST 2012
 BASED ON SURVEYING AT THE SITE AND
 INFORMATION PROVIDED BY CONTRACTORS

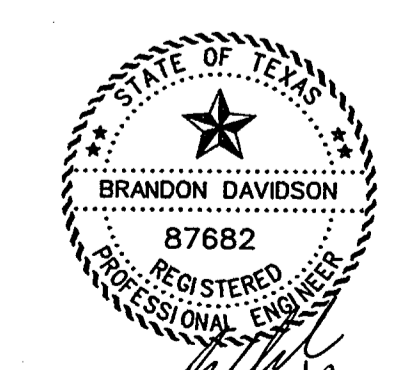

The seal appearing on
 this document was
 authorized by
 Brandon Davidson
 P.E. 87682, on
 August 16, 2012

NO.	REVISIONS	BY	DATE
2	REVISED LINE 'S-4'. ADDED DROP CONNECTION	DS	6-15-11
1	REVISED LINE 'S-4'. ADDED CROSSINGS	DS	6-3-11

CORWIN ENGINEERING, INC.
 200 W. BELMONT, SUITE E
 ALLEN, TEXAS 75013 (972) 396-1200
 TBPE FIRM #5951

DEVELOPMENT PLANS FOR
STONE CREEK PHASE IIB
 ROCKWALL, TEXAS

SANITARY SEWER PROFILES
 LINES 'S-1', 'S-2' & 'S-3'

DRAWN BY	DESIGNED BY	CHECKED BY	SHEET NO.
	CEI	CEI	
JOB NUMBER	DATE	SCALE: 1"=4' V 1"=40' H	9 OF 13
11010	MARCH 2011		