


DEVELOPMENT PLANS FOR STONE CREEK PHASE V CITY OF ROCKWALL, TEXAS

INDEX

| | |
|----|--|
| 1 | TITLE |
| 2 | PLAT |
| 3 | DRAINAGE AREA MAP |
| 4 | BORDEAUX DRIVE |
| 5 | BORDEAUX DRIVE |
| 6 | GREENWAY DRIVE |
| 7 | WATER AND SANITARY SEWER PLAN |
| 8 | SANITARY SEWER PROFILES |
| 9 | STORM SEWER PLAN AND PROFILE LINES 'D-1' & 'D-2' |
| 10 | STORM SEWER PLAN AND PROFILE LINE 'D-3' |
| 11 | GRADING PLAN |
| 12 | EROSION CONTROL PLAN |

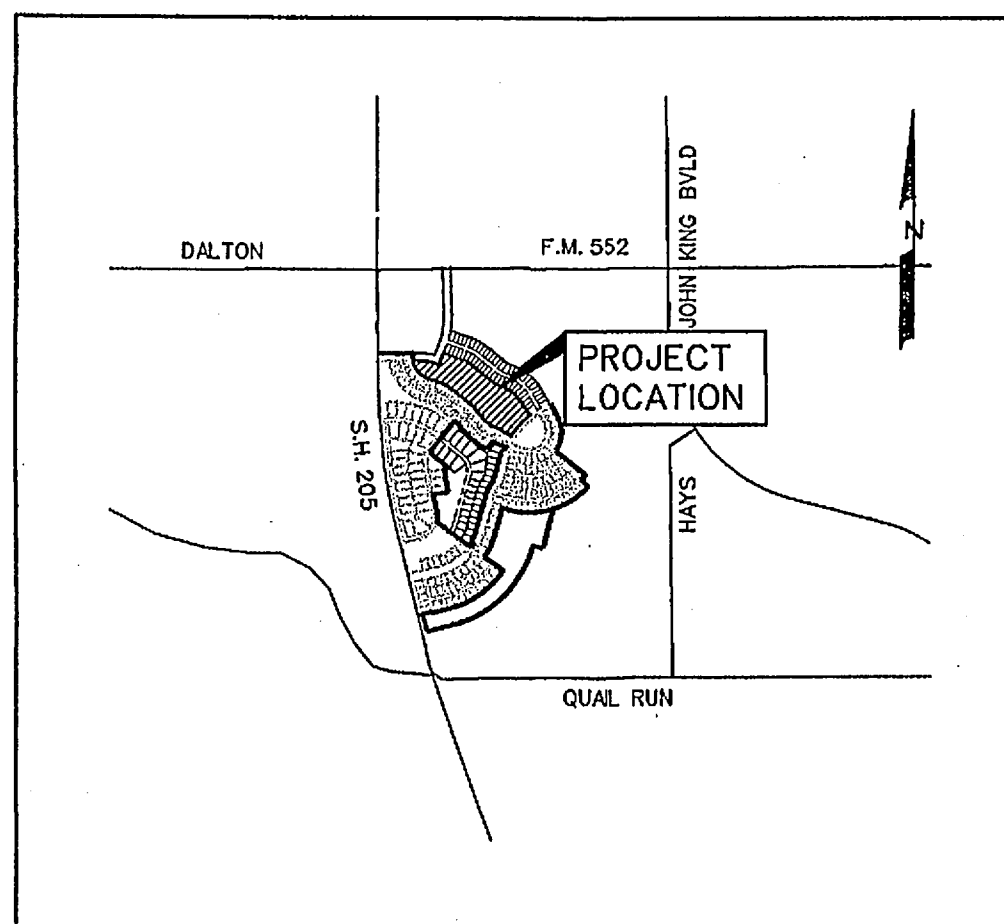

VICINITY MAP
NOT TO SCALE

PREPARED FOR
STONE CREEK 50's POD, LTD.

8214 WESTCHESTER DRIVE, SUITE 710 DALLAS, TEXAS 75225

CORWIN ENGINEERING, INC. — CONSULTING ENGINEERS


200 W. BELMONT, SUITE E

TBPE FIRM #5951

ALLEN, TEXAS 75013

RELEASED FOR CONSTRUCTION
ALL RESPONSIBILITY FOR ADEQUACY OF DESIGN
REMAINS WITH THE DESIGN ENGINEER. THE CITY
OF ROCKWALL, IN REVIEWING AND RELEASING
PLANS FOR CONSTRUCTION, ASSUMES NO
RESPONSIBILITY FOR ADEQUACY OR ACCURACY
OF DESIGN.

CITY Rockwall DATE 10-3-13

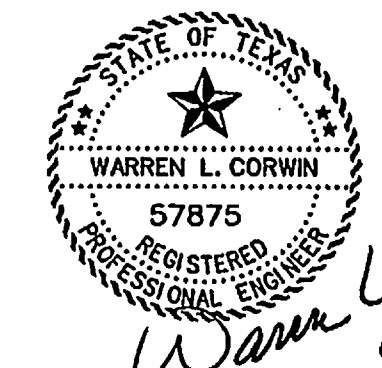

The seal appearing on
this document was
authorized by
Warren L. Corwin,
P.E. 57875, on
September 30, 2013

NOTE:
CITY OF ROCKWALL STANDARDS
AND NCTCOG 3rd ADDITION STANDARDS
SHALL BE USED FOR REFERENCE.

AS-BUILT JUNE 2014
INFORMATION PROVIDED BY CONTRACTORS
(NOT FIELD VERIFIED)

| NO. | PER CITY COMMENTS | DATE |
|-----|-------------------|-----------|
| 1 | PER CITY COMMENTS | 7/30/2013 |
| | REVISIONS | DATE |