

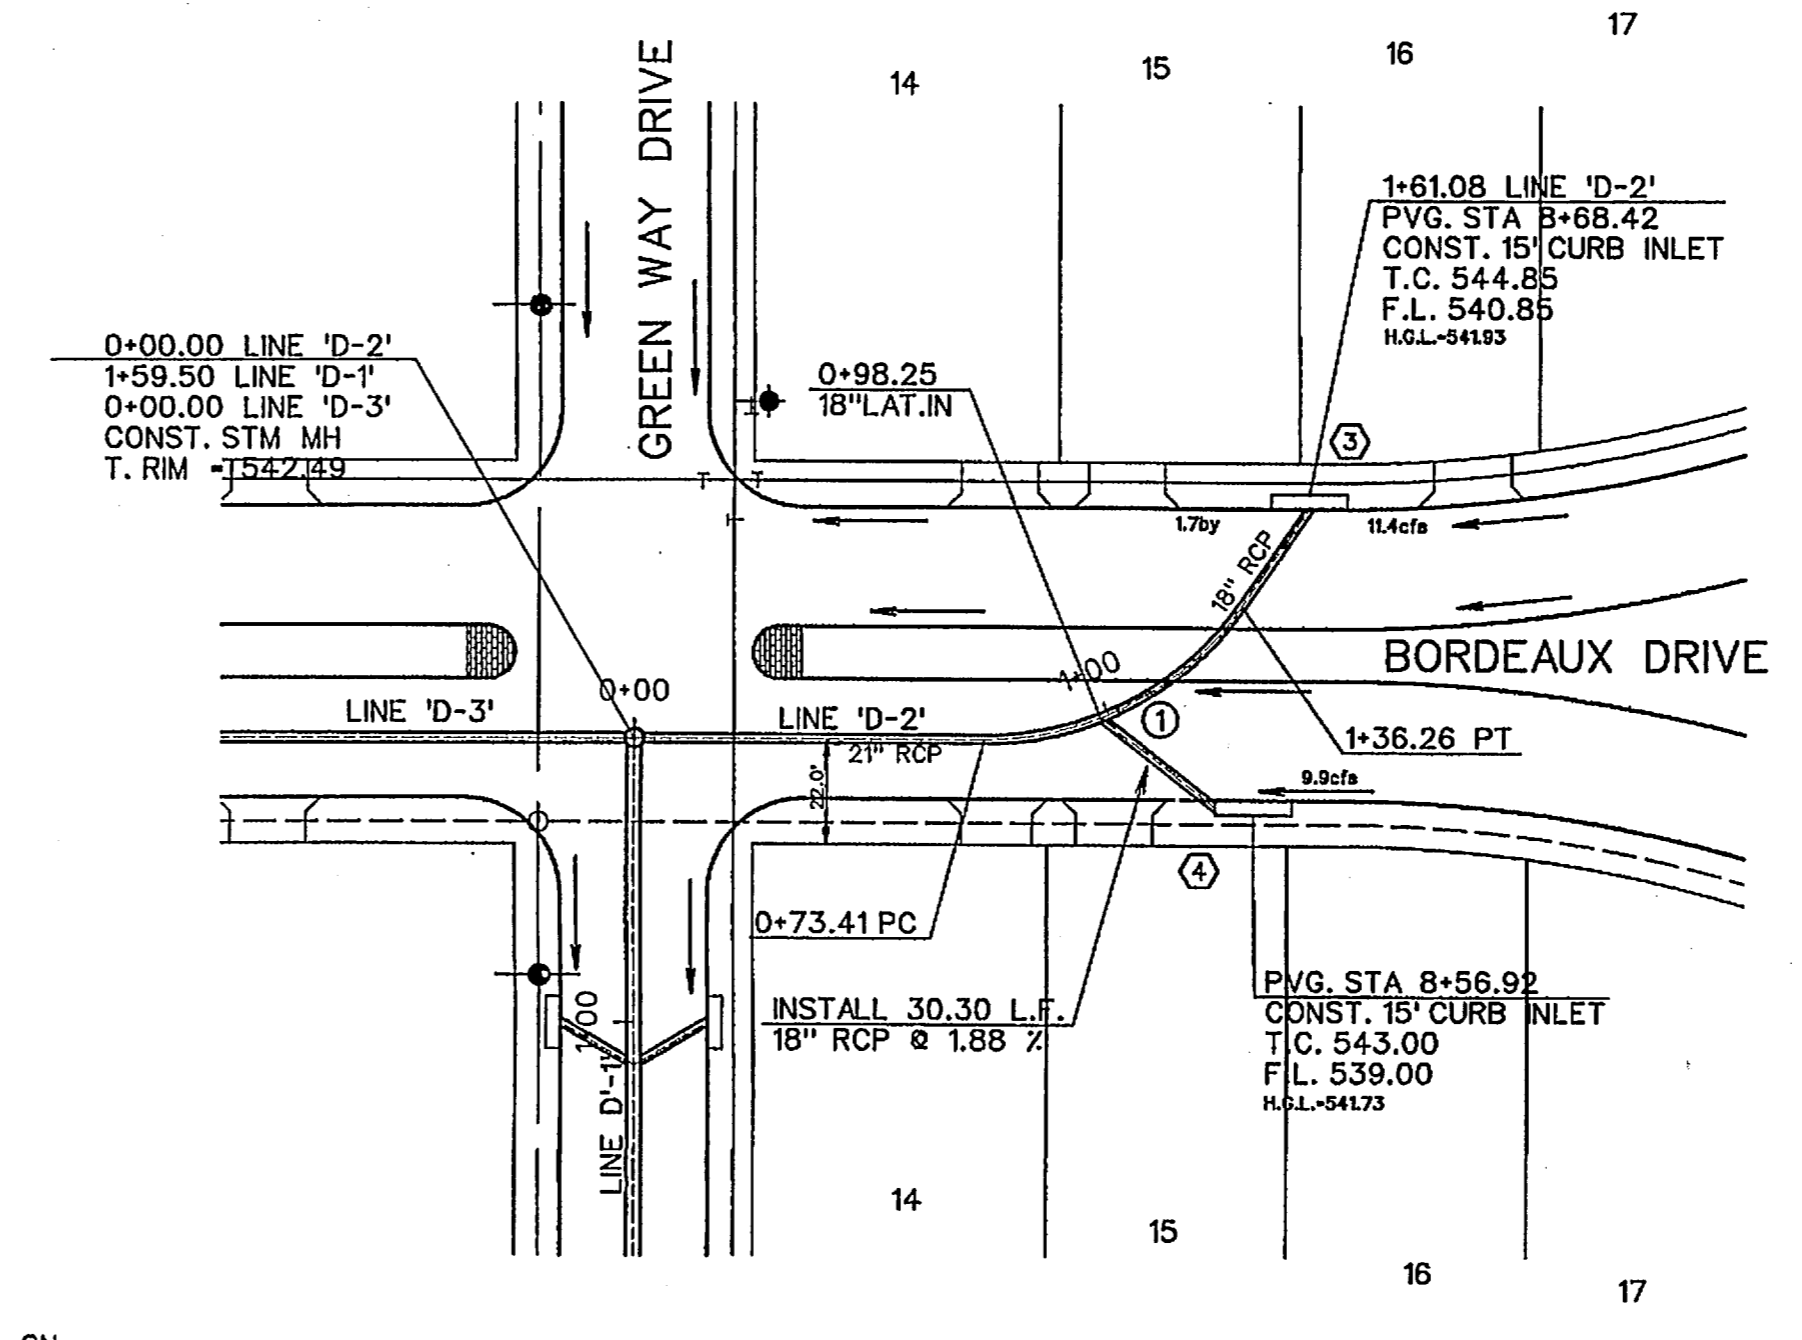


SCALE: 1" = 40'

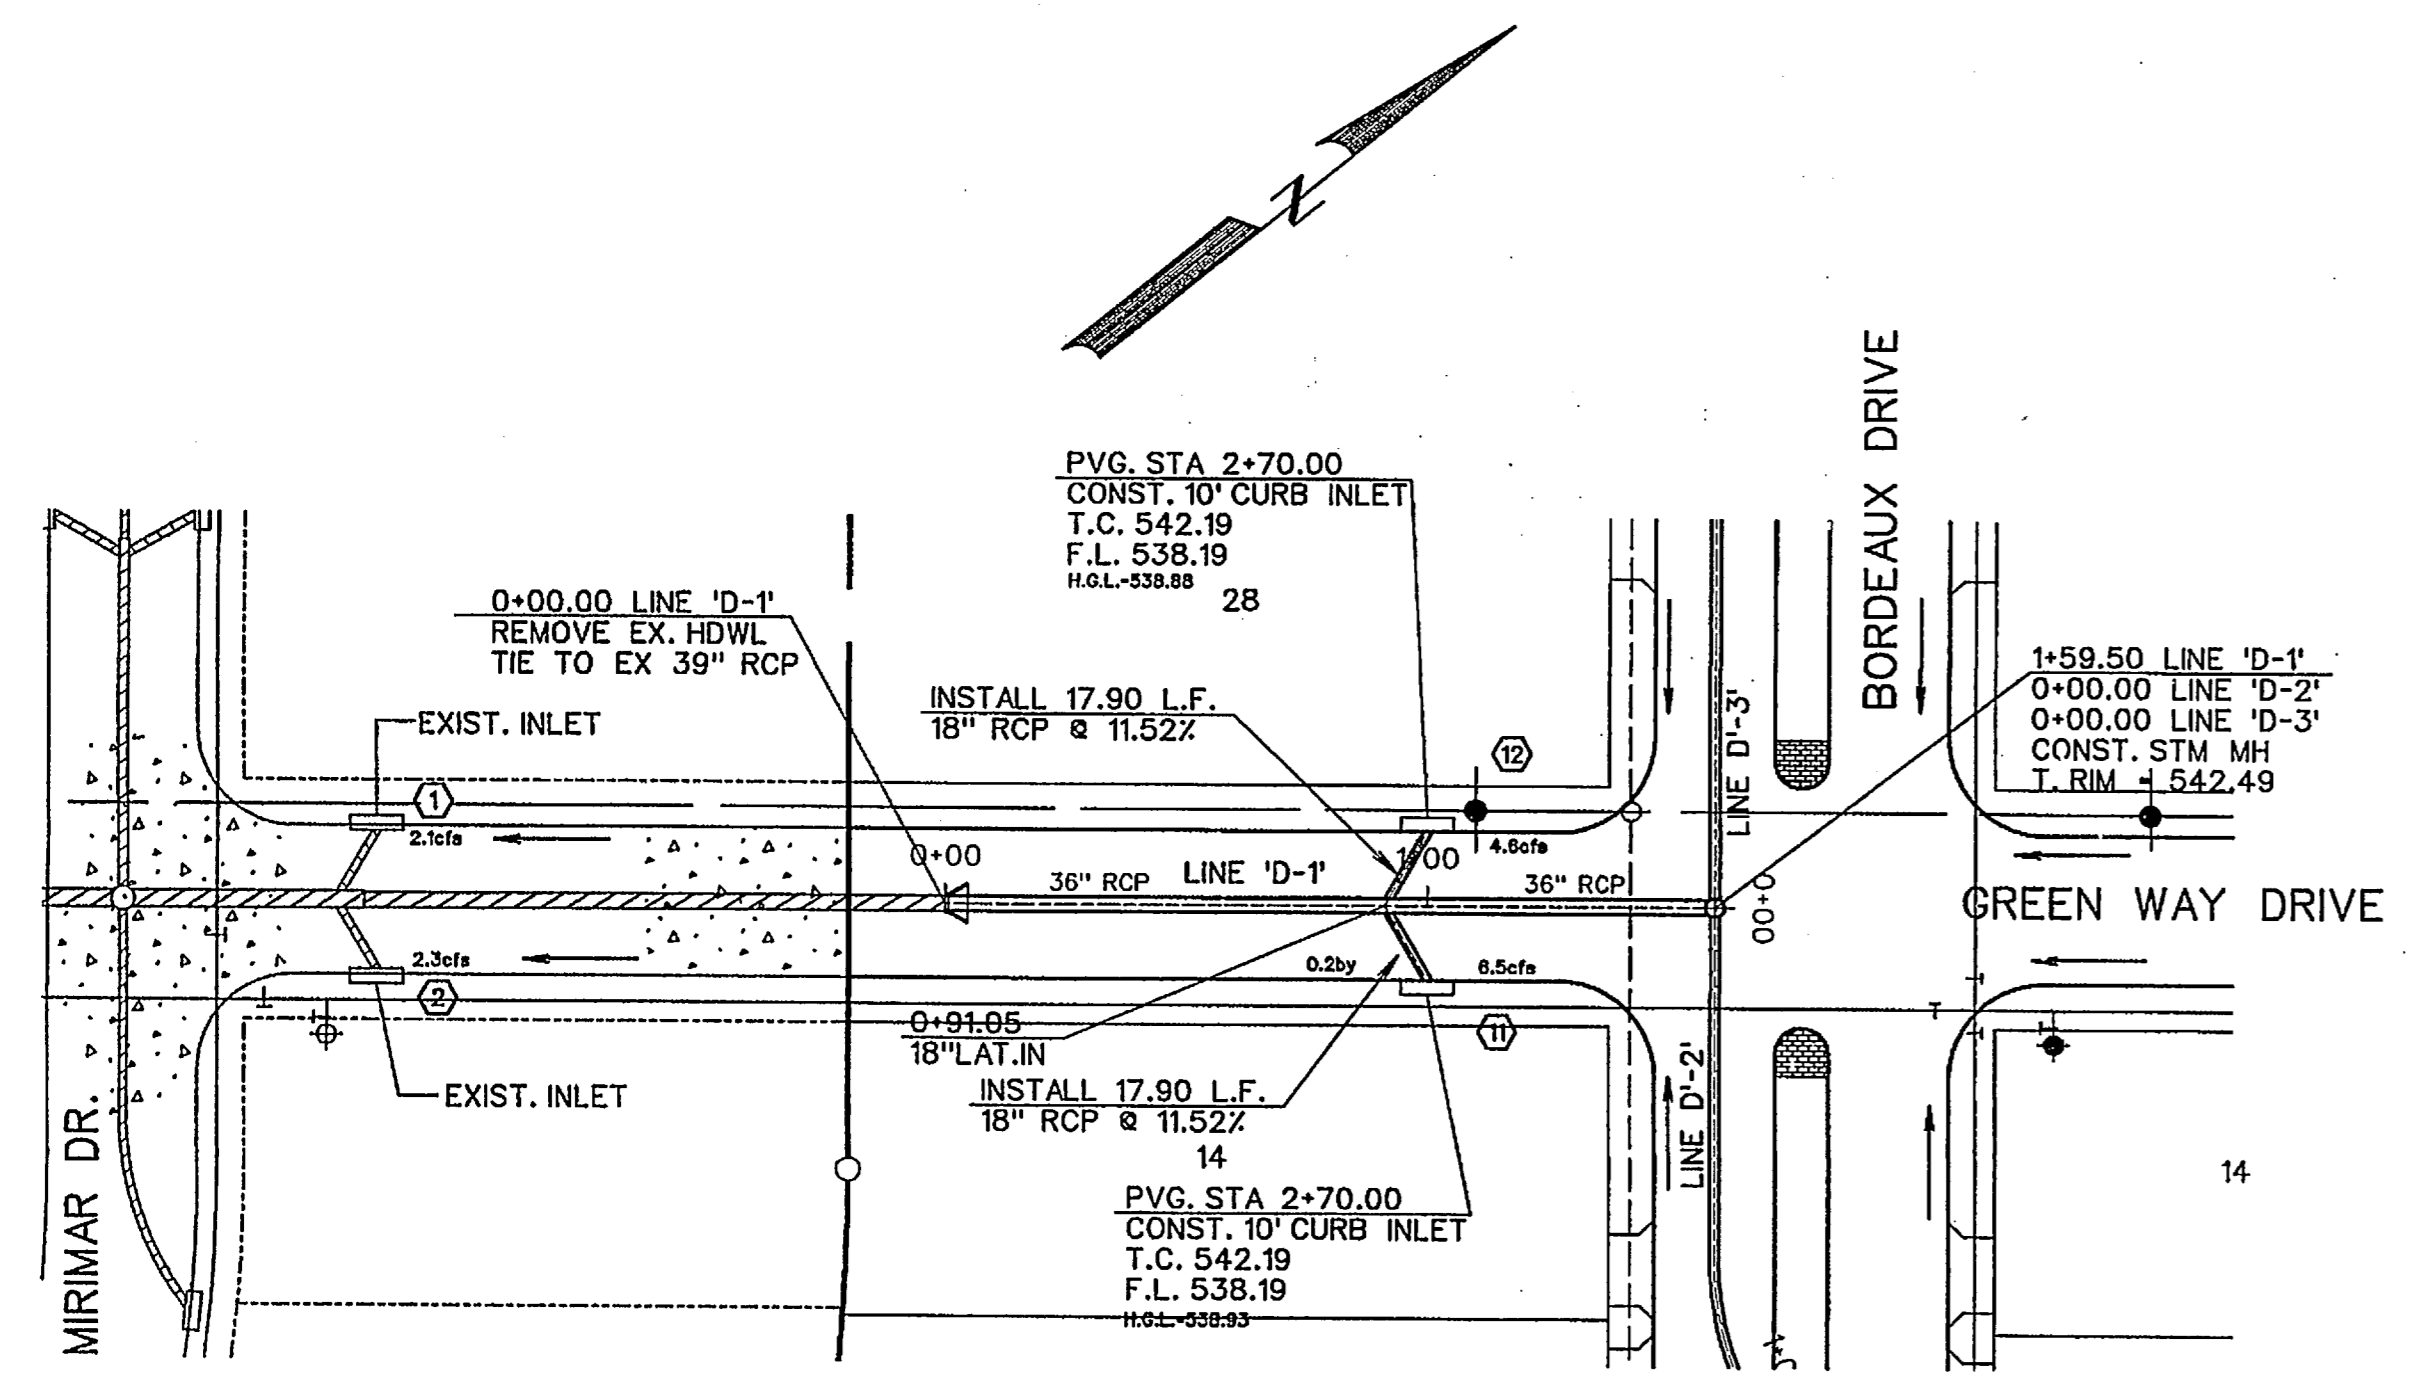


CURVE DATA			
CURVE NO.	①	②	③
Δ	55° 23' 51"	° ' "	° ' "
R	65.00'	'	'
T	34.12'	'	'
L	62.85'	'	'

NOTE:
CONTRACTOR SHALL VERIFY ALL EXISTING UTILITIES PRIOR TO CONSTRUCTION. EXISTING UTILITY LOCATION AND ELEVATION ARE BASED ON AS-BUILT DRAWINGS AND MAY DIFFER IN ACTUAL LOCATION AND ELEVATION.

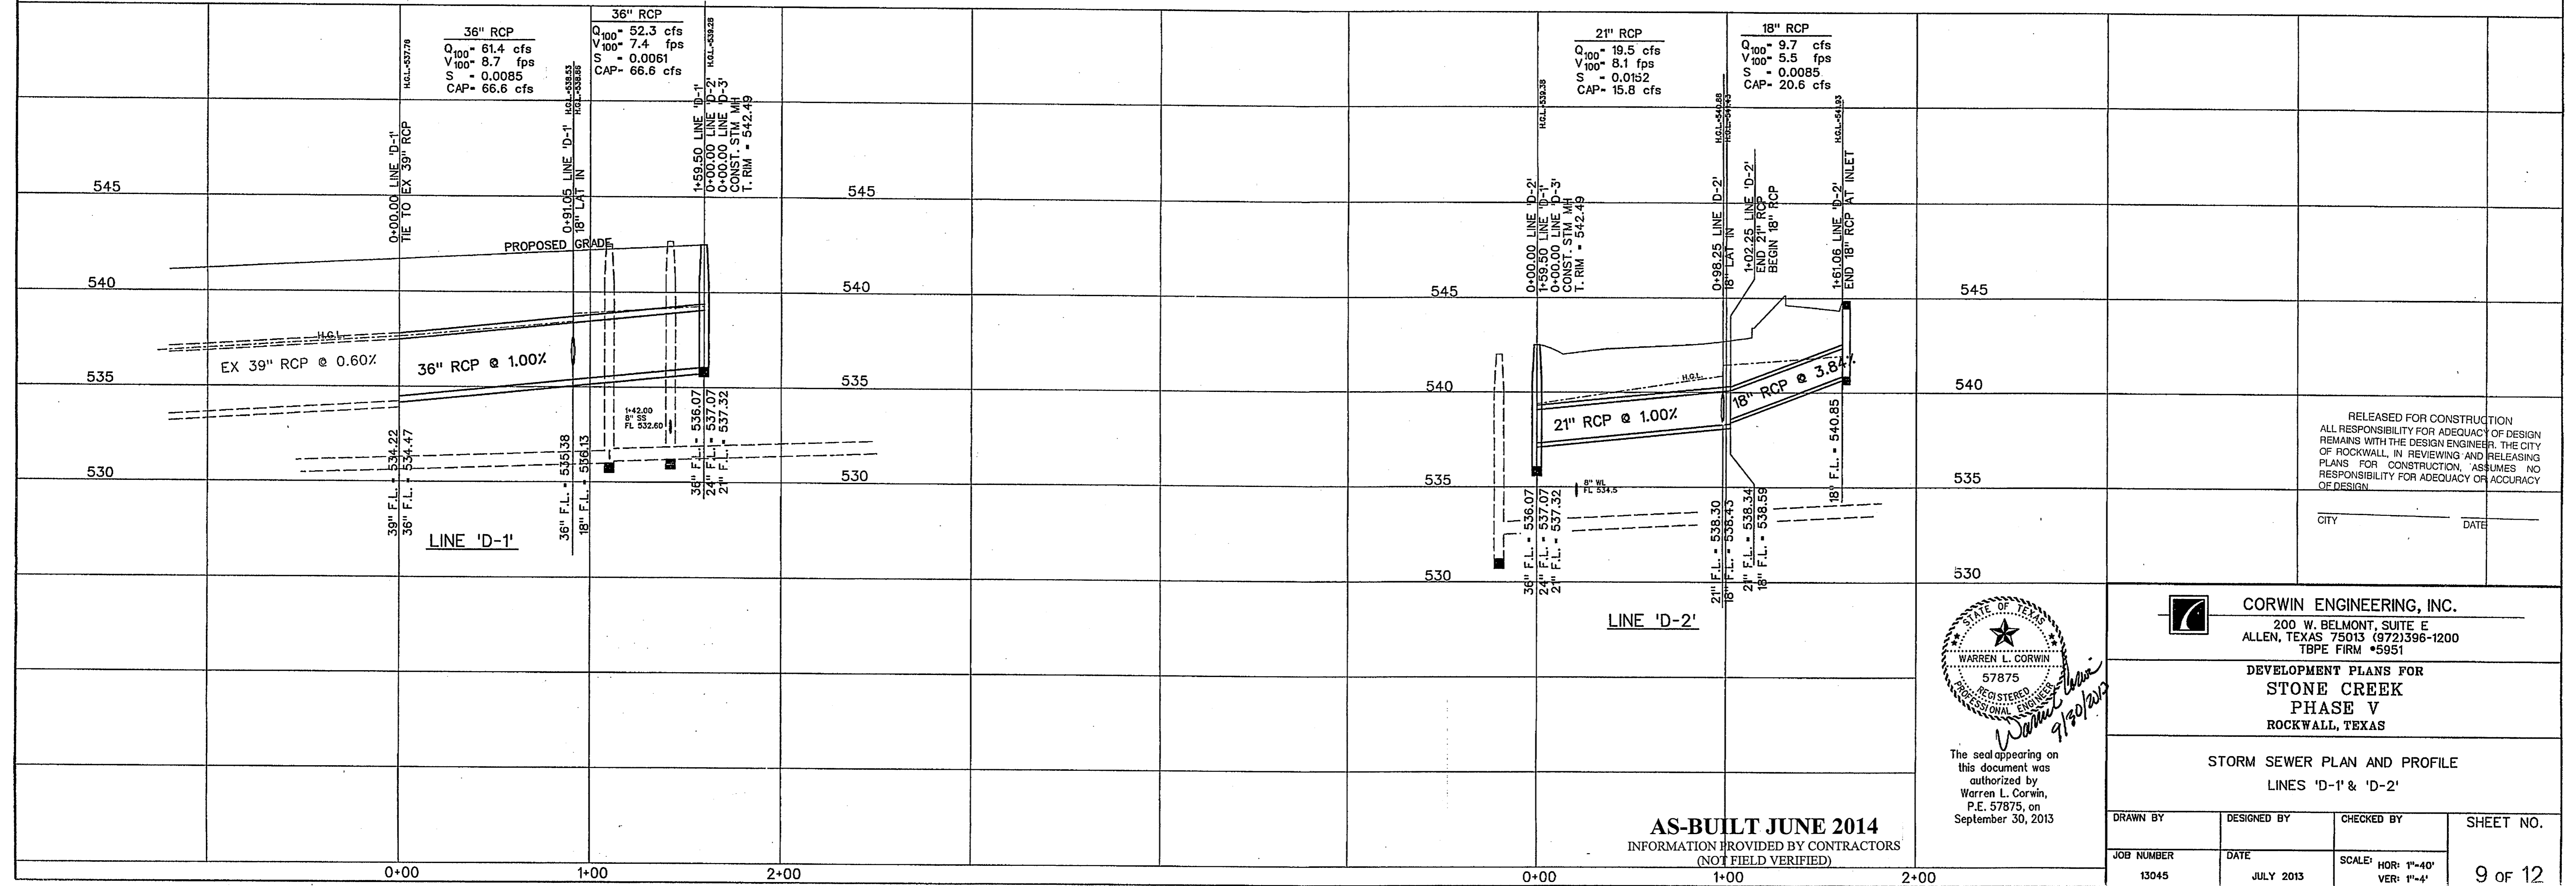

RELEASED FOR CONSTRUCTION
ALL RESPONSIBILITY FOR ADEQUACY OF DESIGN REMAINS WITH THE DESIGN ENGINEER. THE CITY OF ROCKWALL, IN REVIEWING AND RELEASING PLANS FOR CONSTRUCTION, ASSUMES NO RESPONSIBILITY FOR ADEQUACY OR ACCURACY OF DESIGN.

CITY _____ DATE _____

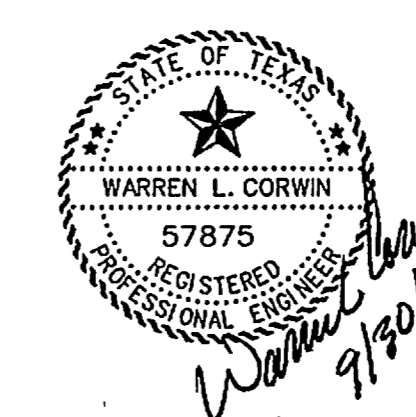

The seal appearing on this document was authorized by Warren L. Corwin, P.E. 57875, on September 30, 2013

CORWIN ENGINEERING, INC.
200 W. BELMONT, SUITE E
ALLEN, TEXAS 75013 (972)396-1200
TBPE FIRM #5951

DEVELOPMENT PLANS FOR
STONE CREEK
PHASE V
ROCKWALL, TEXAS

STORM SEWER PLAN AND PROFILE
LINES 'D-1' & 'D-2'

AS-BUILT JUNE 2014
INFORMATION PROVIDED BY CONTRACTORS
(NOT FIELD VERIFIED)

DRAWN BY	DESIGNED BY	CHECKED BY	SHEET NO. 9 OF 12
JOB NUMBER 13045	DATE JULY 2013	SCALE HOR: 1"=40' VER: 1"=4'	