
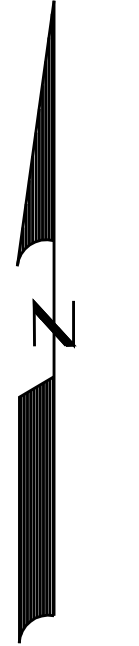


SCALE: 1" = 100'

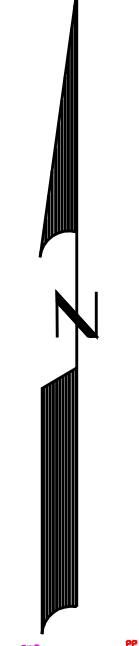

NOTE:  
THIS PLAN IS NOT FOR  
FORCE MAIN CONSTRUCTION.

AS-BUILT SEPTEMBER 2015  
INFORMATION PROVIDED  
BY CONTRACTORS  
(NOT FIELD VERIFIED)

**CORWIN ENGINEERING, INC.**  
200 W. BELMONT, SUITE E  
ALLEN, TEXAS 75013 (972)396-1200  
TBPE FIRM •5951

**DEVELOPMENT PLANS FOR  
BREEZY HILL FORCE MAIN  
ROCKWALL, TEXAS**

**SLEEVE PLAN**

DRAWN BY	DESIGNED BY	CHECKED BY	SHEET NO.  1 OF 1
JOB NUMBER	DATE	SCALE: 1"=100'	