


BENCHMARK:
CITY OF ROCKWALL SURVEY MONUMENT ON AN INLET
AT THE NORTHWEST CORNER OF FEATHERSTONE DR. AND
HARVARD DR.
ELEV. = 525.31

CORWIN ENGINEERING, INC.
200 W. BELMONT, SUITE E
ALLEN, TEXAS 75013 (972)396-1200
TBPE FIRM #5951

DEVELOPMENT PLANS FOR
**STONE CREEK
PHASE VI**
ROCKWALL, TEXAS

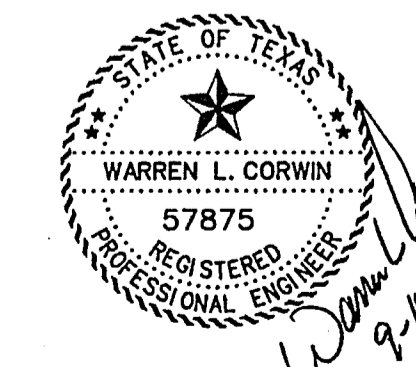

The seal appearing on
this document was
authorized by
Warren L. Corwin,
P.E. 57875, on
September 10, 2014

DRAWN BY	DESIGNED BY	CHECKED BY	SHEET NO. 17 of 26
JOB NUMBER 13088	DATE MAY 2014	SCALE: HOR: 1"=40' VER: 1"=4'	