


SCALE: 1" = 100'


NOTE:
DETENTION POND SHALL BE INSTALLED PER PLAN (INCLUDING OUTFALL) WITH BOTTOM AND SIDES STABILIZED WITH ANCHORED CURLEX OR SOD PRIOR TO ANY PAVING.

LEGEND

- SILT FENCE (BEFORE CONSTRUCTION)
- INLET PROTECTION
- ANCHORED CURLEX MATTING

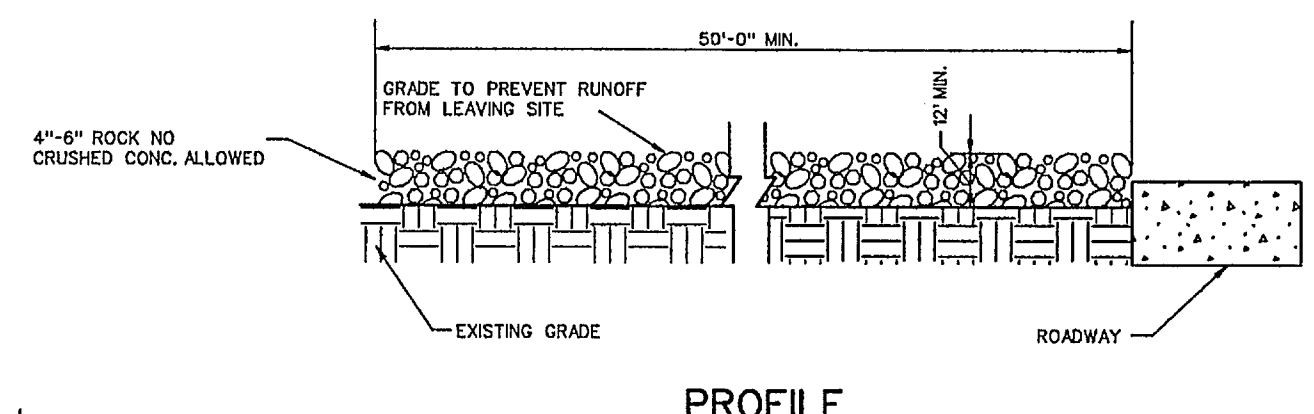

PROFILE

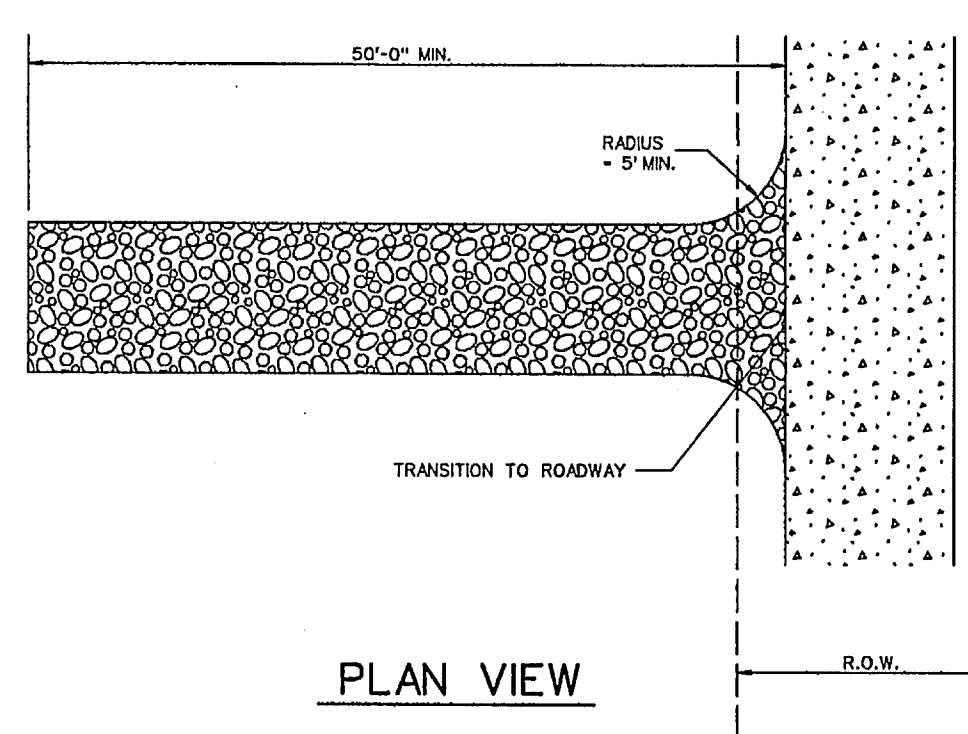


PLAN VIEW


STABILIZED ENTRANCE DETAIL

CONSTRUCTION SEQUENCE

1. GRADING CONTRACTOR TO INSTALL TEMPORARY STABILIZED ENTRANCE.
2. INSTALL SILT FENCE AS SHOWN, (TS-600 POLY FELT) PER C.O.G. SPECIFICATIONS.
3. PERFORM GRADING AND UTILITY CONSTRUCTION.
4. AFTER THE INLET BOTTOMS ARE CONSTRUCTED, THE INLETS SHALL BE FILLED WITH STONE AND COVERED WITH A FILTER FABRIC (TS-600 POLY FELT OR EQUIVALENT) BY UTILITY CONTRACTOR.
5. PRIOR TO CITY RELEASING PAVING, SOD OR SEEDED CURLEX SHALL BE INSTALLED ON SIDES AND BOTTOM OF ALL DETENTION PONDS.
6. AFTER PAVING AND COMPLETION OF INLETS, INLET FILTERS SHALL BE INSTALLED IN ALL INLETS AND MAINTAINED UNTIL RE-VEGETATION HAS BEEN COMPLETED BY PAVING CONTRACTOR.
7. SILT FENCE SHALL REMAIN IN PLACE UNTIL RE-VEGETATION HAS BEEN COMPLETED.
8. PAVING CONTRACTOR SHALL REMOVE TEMPORARY STABILIZED ENTRANCE.
9. PRIOR TO CITY ACCEPTANCE THE PAVING CONTRACTOR SHALL BE RESPONSIBLE FOR REMOVING ANY MUD OR SILT WHICH COLLECTS ON THE EXISTING AND NEW PAVEMENT.
10. PRIOR TO CITY ACCEPTANCE 75-80% OF ALL DISTURBED AREA SHALL HAVE A MIN. 1" TALL GRASS ESTABLISHED
11. 75-80% OF ALL DISTURBED AREA TO HAVE 1" HIGH GRASS ESTABLISHED PRIOR TO ENGINEERING ACCEPTANCE.
12. ALL BAR DITCHES TO BE ANCHORED, SEEDED & CURLEXED PRIOR TO ACCEPTANCE OF GRASS ISN'T ESTABLISHED.

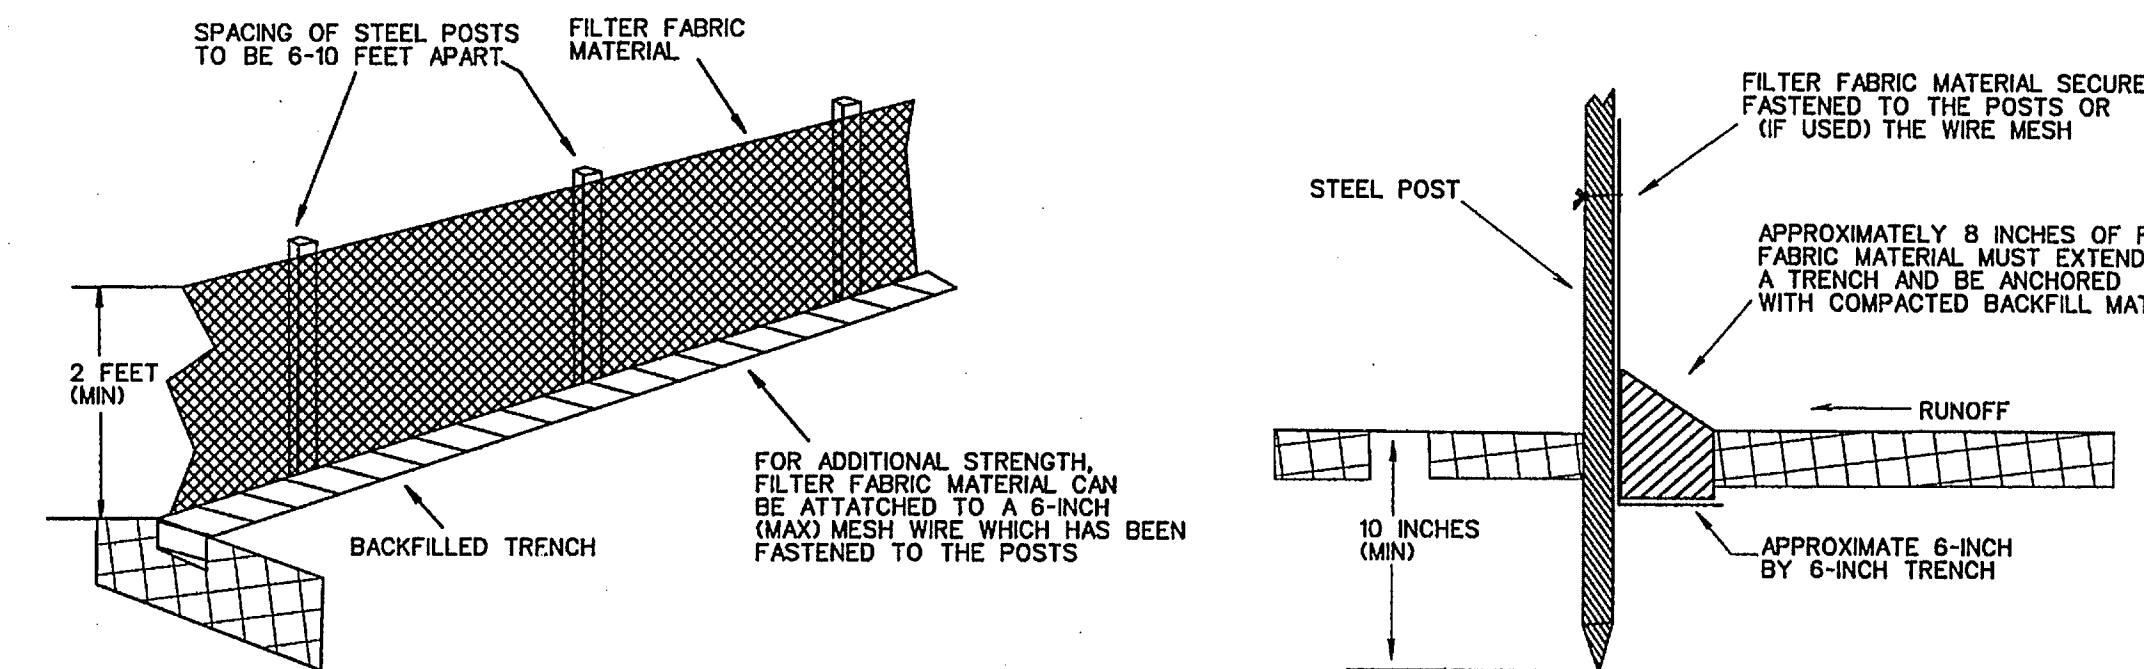


FILTER FABRIC FENCE DETAIL

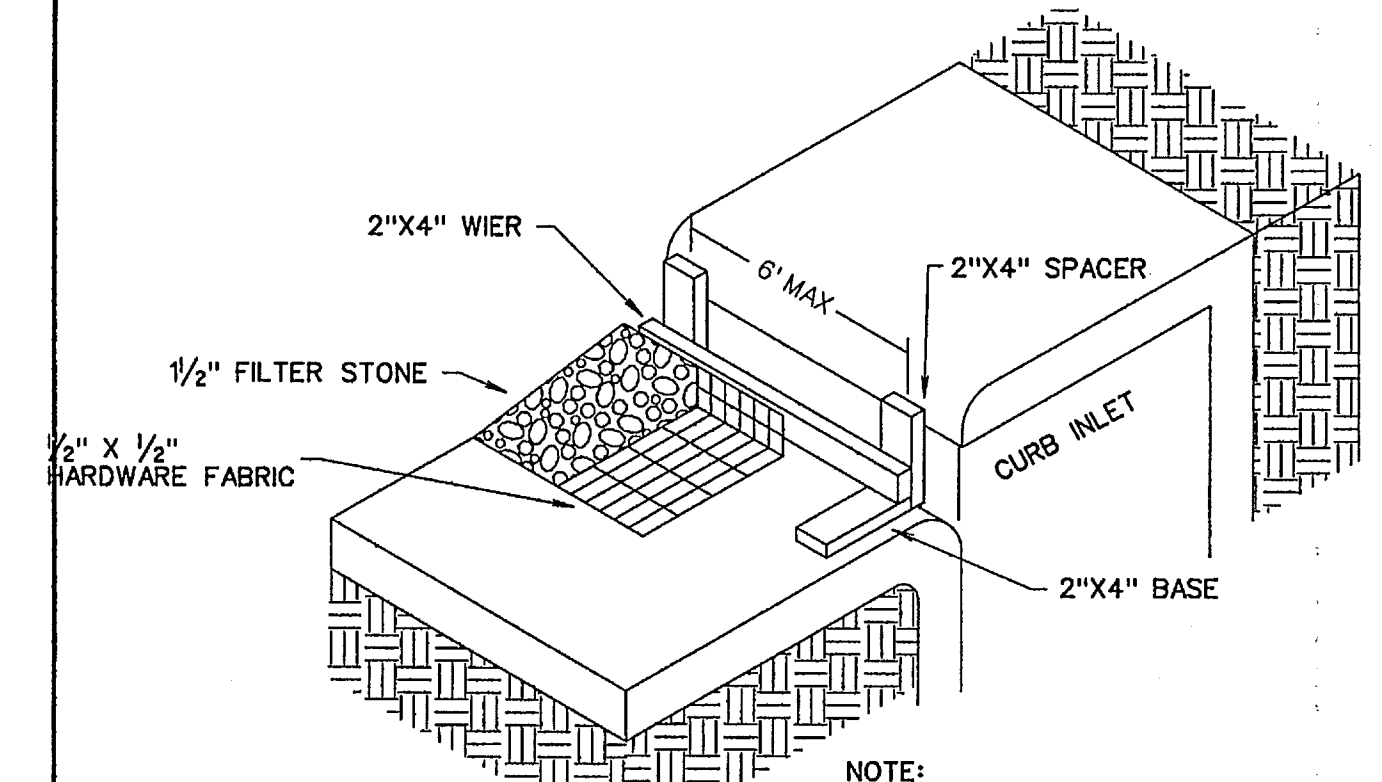

NOTE:
EXTEND FABRIC, FRAME AND FILTER STONE 12' BEYOND END OF INLET ON BOTH ENDS.

TYPE B CURB INLET PROTECTION

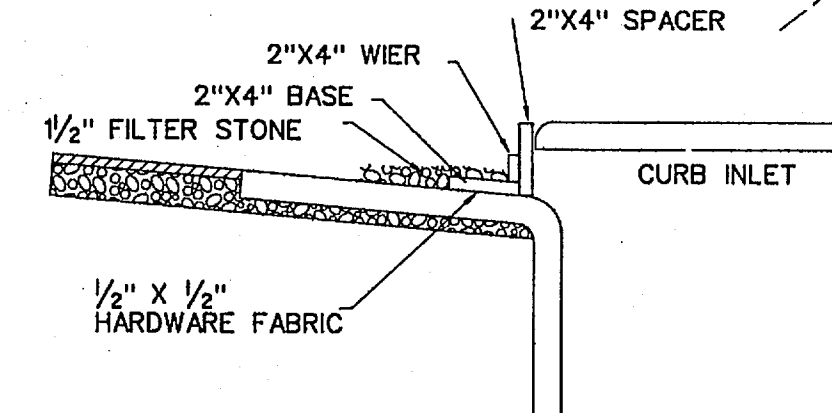

INLET SECTION

<p>CORWIN ENGINEERING, INC. 200 W. BELMONT, SUITE E ALLEN, TEXAS 75013 (972)396-1200 TBE FIRM #5951</p>			
<p>DEVELOPMENT PLANS FOR STONE CREEK PHASE VI ROCKWALL, TEXAS</p>			
<p>EROSION CONTROL PLAN</p>			
DRAWN BY	DESIGNED BY	CHECKED BY	SHEET NO.
JOB NUMBER	DATE	SCALE:	
13088	MAY 2014	1"=100'	25 OF 26