

$\Delta = 08^\circ 44' 20''$
 $R = 650.00'$
 $T = 49.67'$
 $L = 93.14'$
 $C = 93.04'$
 $B = N03^\circ 31' 35'' E$

CITY	PLAT	Y
ROCKWALL	16	ADDITION
2503842.7	703467.08	
ELEV = 552.0		

NOTES

- Bearing are referenced to Stone Creek Phase I (Cab. G, Side 389-385).
- All lot lines are radial or perpendicular to the street unless otherwise noted by bearing.
- 1/2" iron rods with "CORWIN ENGR. INC." caps set at all boundary corners, block corners, points of curvature, and other points in public right-of-way unless otherwise noted.
- B.L. - Building Line.
U.E. - Utility Easements.
C.M. - Controlling Monument.
V.A.M.S. - Visibility, Maintenance & Sidewalk Easement
- Street Name Change

OWNER'S CERTIFICATE

NOW, THEREFORE, KNOW ALL MEN BY THESE PRESENTS: STATE OF TEXAS, COUNTY OF ROCKWALL. We, the undersigned owners of the land shown on this plat, and designated herein as the STONE CREEK BALANCE, LTD., do hereby certify that the plat shown hereon accurately represents the results of an on-the-ground survey made under my direction and supervision and all corners are as shown thereon and thereunto, hereby dedicate to the use of the public forever all streets, alleys, paths, water courses, drains, easements and public places thereon shown on the plat and consideration therein. STONE CREEK BALANCE, LTD., a Texas limited partnership, is the owner of the land shown on this plat and I, the undersigned, as its general partner, do hereby reserve the easement strips shown on this plat for the purposes and accommodations of all utilities desiring to use or using same. We also understand the following:

- No buildings shall be constructed or placed upon, over, or across the utility easements so designated herein.
- Any public utility shall have the right to remove and keep removed all or part of any buildings, structures, or other improvements on the easement strips shown on this plat, and the developer and/or owner shall be responsible for the cost of such removal and replacement of such improvements.
- The developer shall be responsible for the necessary facilities to provide drainage patterns and drainage controls such that properties within the drainage area are not adversely affected by storm drainage from the development.
- The developer shall be responsible for the necessary facilities to provide drainage patterns and drainage controls such that properties within the drainage area are not adversely affected by storm drainage from the development.
- No house dwelling unit, or other structure shall be constructed on any lot in this addition by the City of Rockwall, or other person under the authority of the City of Rockwall, until the developer and/or owner has complied with the requirements of the City of Rockwall for the entire block on the street or streets on which property abuts, including the actual installation of streets with the required base and paving, curb and gutter, water and sewer, drainage structures, structures, storm sewers, and dials, all according to the specifications of the City of Rockwall.

Until an escrow deposit, sufficient to pay for the cost of such improvements, as determined by the City of Rockwall, is deposited with the City of Rockwall, the City of Rockwall shall not be bound to make with the city secretary, accompanied by an agreement signed by the developer and/or owner, authorizing the city to make such improvements at prevailing private commercial rates, or have the same made for a contractor and pay for the same out of the escrow deposit, should the developer written agreement, but in no case shall the City be obligated to make such improvements itself. Such deposit may be used by the owner and/or developer as progress payments as the work progresses and the City shall not be bound to make such improvements until the City secretary, supported by evidence of work done or

until the developer and/or owner files a corporate surety bond with the city secretary in a sum equal to the time stated in the bond, which time shall be fixed by the city council of the City of Rockwall. We, the undersigned, do hereby certify that the plat shown hereon accurately represents the results of an on-the-ground survey made under my direction and supervision and all corners are as shown thereon and thereunto, hereby dedicate to the use of the public forever all streets, alleys, paths, water courses, drains, easements and public places thereon shown on the plat and consideration therein. STONE CREEK BALANCE, LTD., a Texas limited partnership, is the owner of the land shown on this plat and I, the undersigned, as its general partner, do hereby reserve the easement strips shown on this plat for the purposes and accommodations of all utilities desiring to use or using same. We also understand the following:

- No buildings shall be constructed or placed upon, over, or across the utility easements so designated herein.
- Any public utility shall have the right to remove and keep removed all or part of any buildings, structures, or other improvements on the easement strips shown on this plat, and the developer and/or owner shall be responsible for the cost of such removal and replacement of such improvements.
- The developer shall be responsible for the necessary facilities to provide drainage patterns and drainage controls such that properties within the drainage area are not adversely affected by storm drainage from the development.
- The developer shall be responsible for the necessary facilities to provide drainage patterns and drainage controls such that properties within the drainage area are not adversely affected by storm drainage from the development.
- No house dwelling unit, or other structure shall be constructed on any lot in this addition by the City of Rockwall, or other person under the authority of the City of Rockwall, until the developer and/or owner has complied with the requirements of the City of Rockwall for the entire block on the street or streets on which property abuts, including the actual installation of streets with the required base and paving, curb and gutter, water and sewer, drainage structures, structures, storm sewers, and dials, all according to the specifications of the City of Rockwall.

Until an escrow deposit, sufficient to pay for the cost of such improvements, as determined by the City of Rockwall, is deposited with the City of Rockwall, the City of Rockwall shall not be bound to make with the city secretary, accompanied by an agreement signed by the developer and/or owner, authorizing the city to make such improvements at prevailing private commercial rates, or have the same made for a contractor and pay for the same out of the escrow deposit, should the developer written agreement, but in no case shall the City be obligated to make such improvements itself. Such deposit may be used by the owner and/or developer as progress payments as the work progresses and the City shall not be bound to make such improvements until the City secretary, supported by evidence of work done or

until the developer and/or owner files a corporate surety bond with the city secretary in a sum equal to the time stated in the bond, which time shall be fixed by the city council of the City of Rockwall. We, the undersigned, do hereby certify that the plat shown hereon accurately represents the results of an on-the-ground survey made under my direction and supervision and all corners are as shown thereon and thereunto, hereby dedicate to the use of the public forever all streets, alleys, paths, water courses, drains, easements and public places thereon shown on the plat and consideration therein. STONE CREEK BALANCE, LTD., a Texas limited partnership, is the owner of the land shown on this plat and I, the undersigned, as its general partner, do hereby reserve the easement strips shown on this plat for the purposes and accommodations of all utilities desiring to use or using same. We also understand the following:

OWNER'S CERTIFICATE

NOW, THEREFORE, KNOW ALL MEN BY THESE PRESENTS: STATE OF TEXAS, COUNTY OF DALLAS. We, the undersigned owners of the land shown on this plat, and designated herein as the STONE CREEK BALANCE, LTD., do hereby certify that the plat shown hereon accurately represents the results of an on-the-ground survey made under my direction and supervision and all corners are as shown thereon and thereunto, hereby dedicate to the use of the public forever all streets, alleys, paths, water courses, drains, easements and public places thereon shown on the plat and consideration therein. STONE CREEK BALANCE, LTD., a Texas limited partnership, is the owner of the land shown on this plat and I, the undersigned, as its general partner, do hereby reserve the easement strips shown on this plat for the purposes and accommodations of all utilities desiring to use or using same. We also understand the following:

- No buildings shall be constructed or placed upon, over, or across the utility easements so designated herein.
- Any public utility shall have the right to remove and keep removed all or part of any buildings, structures, or other improvements on the easement strips shown on this plat, and the developer and/or owner shall be responsible for the cost of such removal and replacement of such improvements.
- The developer shall be responsible for the necessary facilities to provide drainage patterns and drainage controls such that properties within the drainage area are not adversely affected by storm drainage from the development.
- The developer shall be responsible for the necessary facilities to provide drainage patterns and drainage controls such that properties within the drainage area are not adversely affected by storm drainage from the development.
- No house dwelling unit, or other structure shall be constructed on any lot in this addition by the City of Rockwall, or other person under the authority of the City of Rockwall, until the developer and/or owner has complied with the requirements of the City of Rockwall for the entire block on the street or streets on which property abuts, including the actual installation of streets with the required base and paving, curb and gutter, water and sewer, drainage structures, structures, storm sewers, and dials, all according to the specifications of the City of Rockwall.

Until an escrow deposit, sufficient to pay for the cost of such improvements, as determined by the City of Rockwall, is deposited with the City of Rockwall, the City of Rockwall shall not be bound to make with the city secretary, accompanied by an agreement signed by the developer and/or owner, authorizing the city to make such improvements at prevailing private commercial rates, or have the same made for a contractor and pay for the same out of the escrow deposit, should the developer written agreement, but in no case shall the City be obligated to make such improvements itself. Such deposit may be used by the owner and/or developer as progress payments as the work progresses and the City shall not be bound to make such improvements until the City secretary, supported by evidence of work done or

until the developer and/or owner files a corporate surety bond with the city secretary in a sum equal to the time stated in the bond, which time shall be fixed by the city council of the City of Rockwall. We, the undersigned, do hereby certify that the plat shown hereon accurately represents the results of an on-the-ground survey made under my direction and supervision and all corners are as shown thereon and thereunto, hereby dedicate to the use of the public forever all streets, alleys, paths, water courses, drains, easements and public places thereon shown on the plat and consideration therein. STONE CREEK BALANCE, LTD., a Texas limited partnership, is the owner of the land shown on this plat and I, the undersigned, as its general partner, do hereby reserve the easement strips shown on this plat for the purposes and accommodations of all utilities desiring to use or using same. We also understand the following:

- No buildings shall be constructed or placed upon, over, or across the utility easements so designated herein.
- Any public utility shall have the right to remove and keep removed all or part of any buildings, structures, or other improvements on the easement strips shown on this plat, and the developer and/or owner shall be responsible for the cost of such removal and replacement of such improvements.
- The developer shall be responsible for the necessary facilities to provide drainage patterns and drainage controls such that properties within the drainage area are not adversely affected by storm drainage from the development.
- The developer shall be responsible for the necessary facilities to provide drainage patterns and drainage controls such that properties within the drainage area are not adversely affected by storm drainage from the development.
- No house dwelling unit, or other structure shall be constructed on any lot in this addition by the City of Rockwall, or other person under the authority of the City of Rockwall, until the developer and/or owner has complied with the requirements of the City of Rockwall for the entire block on the street or streets on which property abuts, including the actual installation of streets with the required base and paving, curb and gutter, water and sewer, drainage structures, structures, storm sewers, and dials, all according to the specifications of the City of Rockwall.



Until an escrow deposit, sufficient to pay for the cost of such improvements, as determined by the City of Rockwall, is deposited with the City of Rockwall, the City of Rockwall shall not be bound to make with the city secretary, accompanied by an agreement signed by the developer and/or owner, authorizing the city to make such improvements at prevailing private commercial rates, or have the same made for a contractor and pay for the same out of the escrow deposit, should the developer written agreement, but in no case shall the City be obligated to make such improvements itself. Such deposit may be used by the owner and/or developer as progress payments as the work progresses and the City shall not be bound to make such improvements until the City secretary, supported by evidence of work done or

until the developer and/or owner files a corporate surety bond with the city secretary in a sum equal to the time stated in the bond, which time shall be fixed by the city council of the City of Rockwall. We, the undersigned, do hereby certify that the plat shown hereon accurately represents the results of an on-the-ground survey made under my direction and supervision and all corners are as shown thereon and thereunto, hereby dedicate to the use of the public forever all streets, alleys, paths, water courses, drains, easements and public places thereon shown on the plat and consideration therein. STONE CREEK BALANCE, LTD., a Texas limited partnership, is the owner of the land shown on this plat and I, the undersigned, as its general partner, do hereby reserve the easement strips shown on this plat for the purposes and accommodations of all utilities desiring to use or using same. We also understand the following:

TOTAL LOTS 76
 TOTAL ACRES 37.882

AUGUST 2014 SCALE 1" = 100'
 CASE NO. P2014-018 SHEET 1 OF 4

FINAL PLAT OF
STONE CREEK PHASE VI
 OUT OF THE
 S. KING SURVEY, ABSTRACT NO. 131
 IN THE
 CITY OF ROCKWALL
 ROCKWALL COUNTY, TEXAS
 OWNERS
STONE CREEK SF, LTD. & STONE CREEK BALANCE, LTD.
 8214 WESTCHESTER DRIVE, SUITE 710
 DALLAS, TEXAS 75219
 214-522-4945
 PREPARED BY
CORWIN ENGINEERING, INC.
 200 W. BELMONT, SUITE E
 ALLEN, TEXAS 75013
 972-396-1200

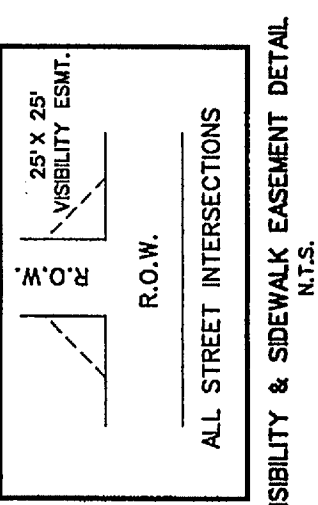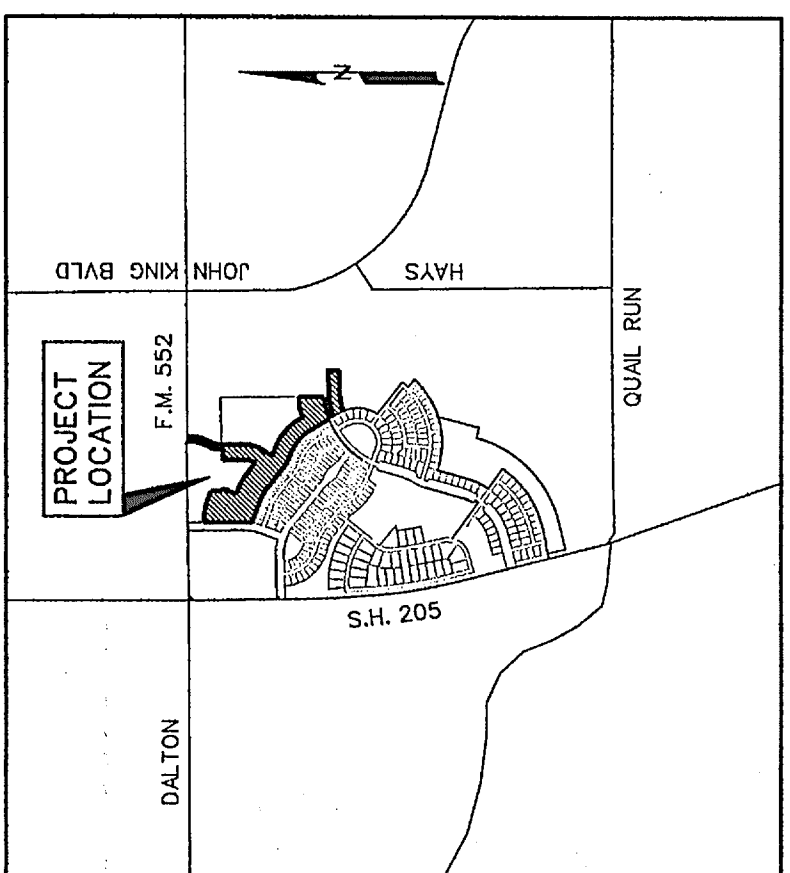

ROCKWALL MIDDLE SCHOOL
 ADDITION BLOCK 1
 LOTS 1 & 2, BLOCK 1
 CAB. H, SLIDE 67

STONE CREEK BALANCE, LTD.
 CLERKS FILE NO. 2007-0037539-A

POINT OF BEGINNING TRACT A
 DISTANCE ESMT.

POINT OF COMMENCING TRACT A

FINAL PLAT OF
STONE CREEK PHASE VI
 OUT OF THE
 S. KING SURVEY, ABSTRACT NO. 131
 IN THE
 CITY OF ROCKWALL
 ROCKWALL COUNTY, TEXAS
 OWNERS
STONE CREEK SF, LTD. & STONE CREEK BALANCE, LTD.
 8214 WESTCHESTER DRIVE, SUITE 710
 DALLAS, TEXAS 75219
 214-522-4945



PREPARED BY
CORWIN ENGINEERING, INC.
 200 W. BELMONT, SUITE E
 ALLEN, TEXAS 75013
 972-396-1200

Notary Public in and for the State of Texas My Commission Expires: _____
 Richard M. Skorburg
 President
 Mortgage or Lien Interest

Notary Public in and for the State of Texas My Commission Expires: _____
 Richard M. Skorburg
 President
 Mortgage or Lien Interest

Notary Public in and for the State of Texas My Commission Expires: _____
 Richard M. Skorburg
 President
 Mortgage or Lien Interest

Notary Public in and for the State of Texas My Commission Expires: _____
 Richard M. Skorburg
 President
 Mortgage or Lien Interest

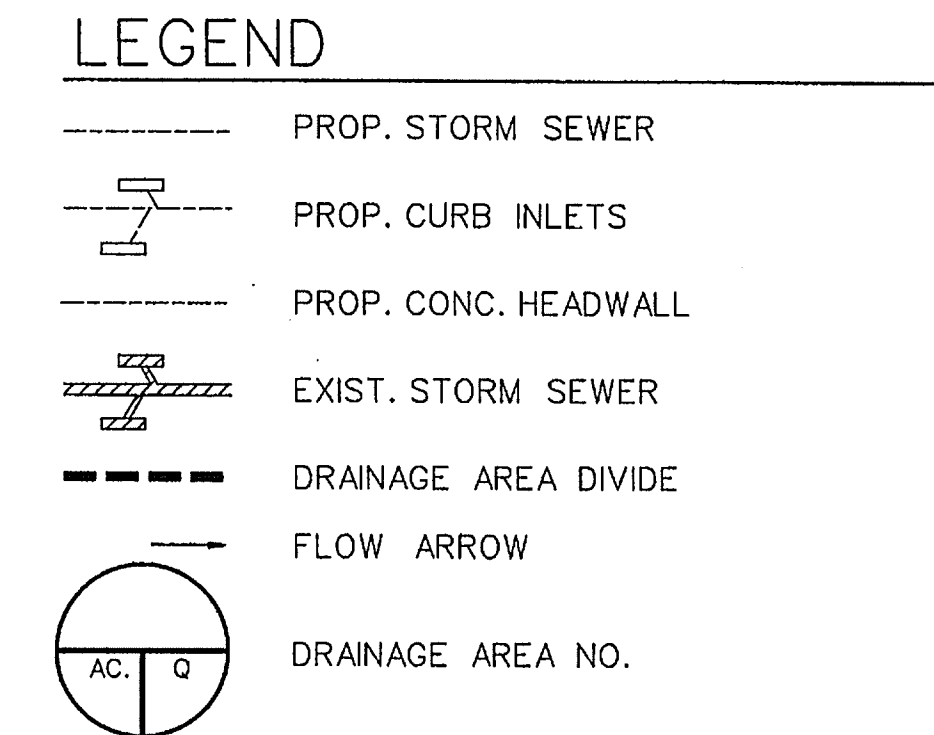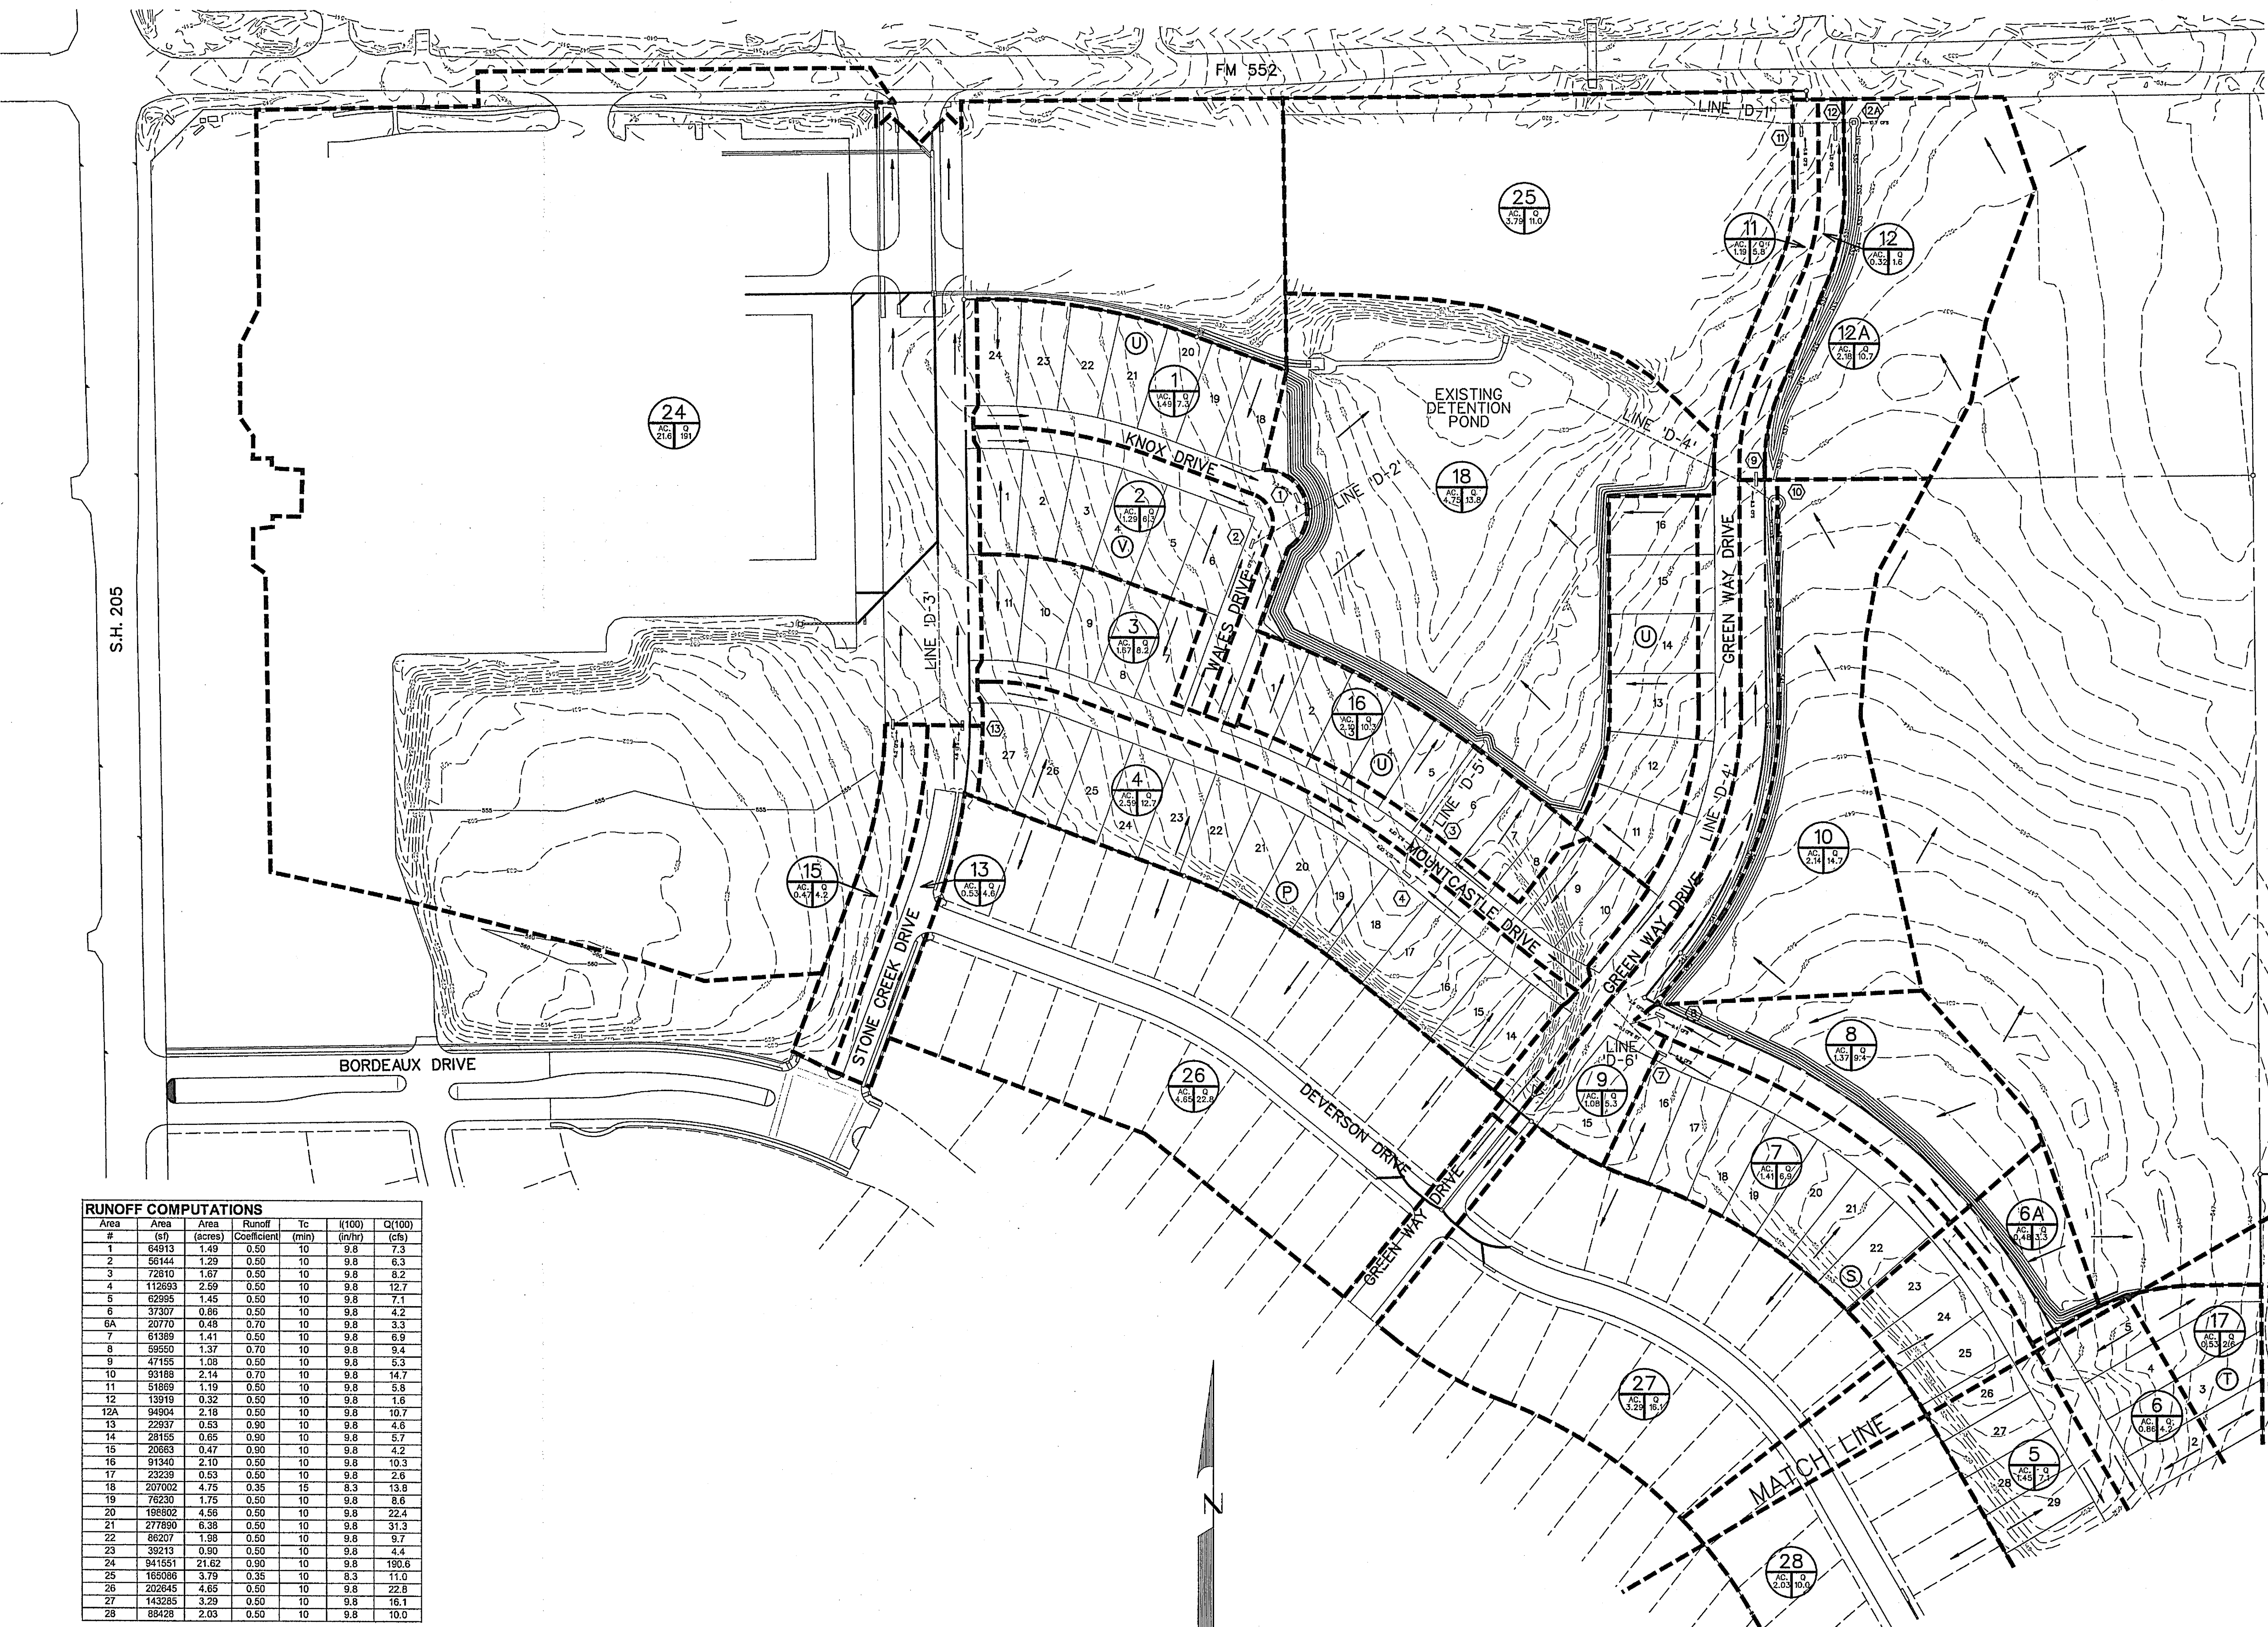


RUNOFF COMPUTATIONS

#	Area (sf)	Area (acres)	Runoff Coefficient	Tc (min)	Q(100) (cfs)	Q(100) (cfs)
1	64913	1.49	0.50	10	9.8	7.3
2	56144	1.29	0.50	10	9.8	6.3
3	72810	1.67	0.50	10	9.8	6.2
4	112593	2.59	0.50	10	9.8	12.7
5	62955	1.45	0.50	10	9.8	7.1
6	37307	0.86	0.50	10	9.8	4.2
6A	20770	0.48	0.70	10	9.8	3.3
7	61389	1.41	0.50	10	9.8	6.9
8	59550	1.37	0.70	10	9.8	9.4
9	47155	1.08	0.50	10	9.8	5.3
10	93188	2.14	0.70	10	9.8	14.7
11	51869	1.19	0.50	10	9.8	5.8
12	13919	0.32	0.50	10	9.8	1.6
12A	94904	2.16	0.50	10	9.8	10.7
13	22937	0.53	0.90	10	9.8	4.6
14	28155	0.65	0.90	10	9.8	5.7
15	23663	0.47	0.90	10	9.8	4.2
16	91340	2.10	0.50	10	9.8	10.3
17	23239	0.53	0.50	10	9.8	2.6
18	207002	4.75	0.35	15	8.3	13.8
19	76230	1.75	0.50	10	9.8	8.6
20	168662	3.85	0.50	10	9.8	22.4
21	277690	6.36	0.50	10	9.8	31.3
22	86207	1.98	0.50	10	9.8	9.7
23	39213	0.90	0.50	10	9.8	4.4
24	941551	21.62	0.90	10	9.8	190.6
25	165986	3.78	0.35	10	8.3	11.0
26	202645	4.66	0.50	10	9.8	22.0
27	143285	3.29	0.50	10	9.8	16.1
28	88428	2.03	0.50	10	9.8	10.0

INLET CALCULATIONS

Inlet #	Location	Station	Design Storm Frequency	Time of Conc. (min)	Intensity (in/hr)	Runoff Coeff	Area (acres)	Q (cfs)	Gutter			Selected Inlet	Carry-Over to Downstream Inlet (cfs)	Inlet Capacity (cfs)			
									Flow	Capacity	Slope						
1	Wales/Knox	100	10	9.8	0.50	1.49	7.3	0.0	7.3	10.6	5' pbl	10	STD.	21.0			
2	Wales	2+44.50	100	10	9.8	0.50	1.29	6.3	0.0	6.3	12.3	Low Pt	5' pbl	10	STD.	21.0	
3	Mountcastle	6+24.10	100	10	9.8	0.50	1.67	8.2	0.0	8.2	17.7	Low Pt	5' pbl	10	STD.	21.0	
4	Mountcastle	6+24.10	100	10	9.8	0.50	2.59	12.7	0.0	12.7	17.7	Low Pt	5' pbl	10	STD.	21.0	
5	Mountcastle	18+21.45	100	10	9.8	0.50	1.45	7.1	0.0	7.1	16.6	5' pbl	15	STD.	0.0	11.5	
6	Mountcastle	18+36.80	100	10	9.8	0.57	1.33	7.5	0.0	7.5	21.7	2.36%	5' pbl	15	STD.	0.0	10.5
7	Mountcastle	9+91.44	100	10	9.8	0.50	1.41	6.9	0.0	6.9	19.3	1.20%	5' pbl	10	STD.	0.1	6.8
8	Mountcastle	9+89.02	100	10	9.8	0.70	1.37	9.4	0.0	9.4	21.7	2.07%	5' pbl	10	STD.	2.9	6.6
9	Greenway	16+75.00	100	10	9.8	0.50	1.08	5.3	3.0	8.3	21.1	1.96%	5' pbl	15	STD.	0.0	10.0
10	Greenway	16+47.73	100	10	9.8	0.70	2.14	14.7	0.0	14.7	N/A	Low Pt	4	WYE	0.0	20.5	
11	Greenway	21+00.00	100	10	9.8	0.50	1.19	5.8	0.0	5.8	10.6	1.83%	5' pbl	10	STD.	0.0	6.3
12	Greenway	20+97.60	100	10	9.8	0.50	0.32	1.6	0.0	1.8	10.6	0.88%	5' pbl	10	STD.	0.0	6.3
12A	Greenway	21+10.00	100	10	9.8	0.50	2.18	10.7	0.0	10.7	N/A	Low Pt	4	WYE	0.0	20.5	
13	Stone Creek	4+82.65	100	10	9.8	0.90	0.53	4.6	0.0	4.6	27.0	1.69%	1/4"R	10	STD.	0.0	5.6
14	Featherstone	36+47.97	100	10	9.8	0.90	0.65	5.7	0.0	5.7	21.9	2.10%	5' pbl	10	STD.	0.0	6.2
15	Stone Creek	4+82.65	100	10	9.8	0.90	0.47	4.2	0.0	4.2	27.0	1.69%	1/4"R	10	STD.	0.0	5.6

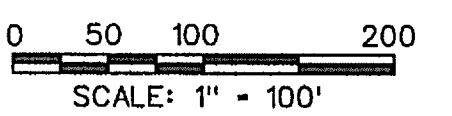

AS-BUILT SEPTEMBER 2015
 INFORMATION PROVIDED BY CONTRACTORS (NOT FIELD VERIFIED)



The seal appearing on this document was authorized by Brandon Davidson P.E. 87682, on September 10, 2014.


BENCHMARK:
 CITY OF ROCKWALL SURVEY MONUMENT ON AN INLET AT THE NORTHWEST CORNER OF FEATHERSTONE DR. AND HARVARD DR.
 ELEV.- 525.31

CORWIN ENGINEERING, INC.
 200 W. BELMONT, SUITE E
 ALLEN, TEXAS 75013 (972)396-1200
 TBPE FIRM #5951

**DEVELOPMENT PLANS FOR
 STONE CREEK
 PHASE VI
 ROCKWALL, TEXAS**

DRAINAGE AREA MAP
 SHEET 1 OF 2

DRAWN BY	DESIGNED BY	CHECKED BY	SHEET NO. 4 OF 26
JOB NUMBER 13068	DATE MAY 2014	SCALE: 1"=100'	

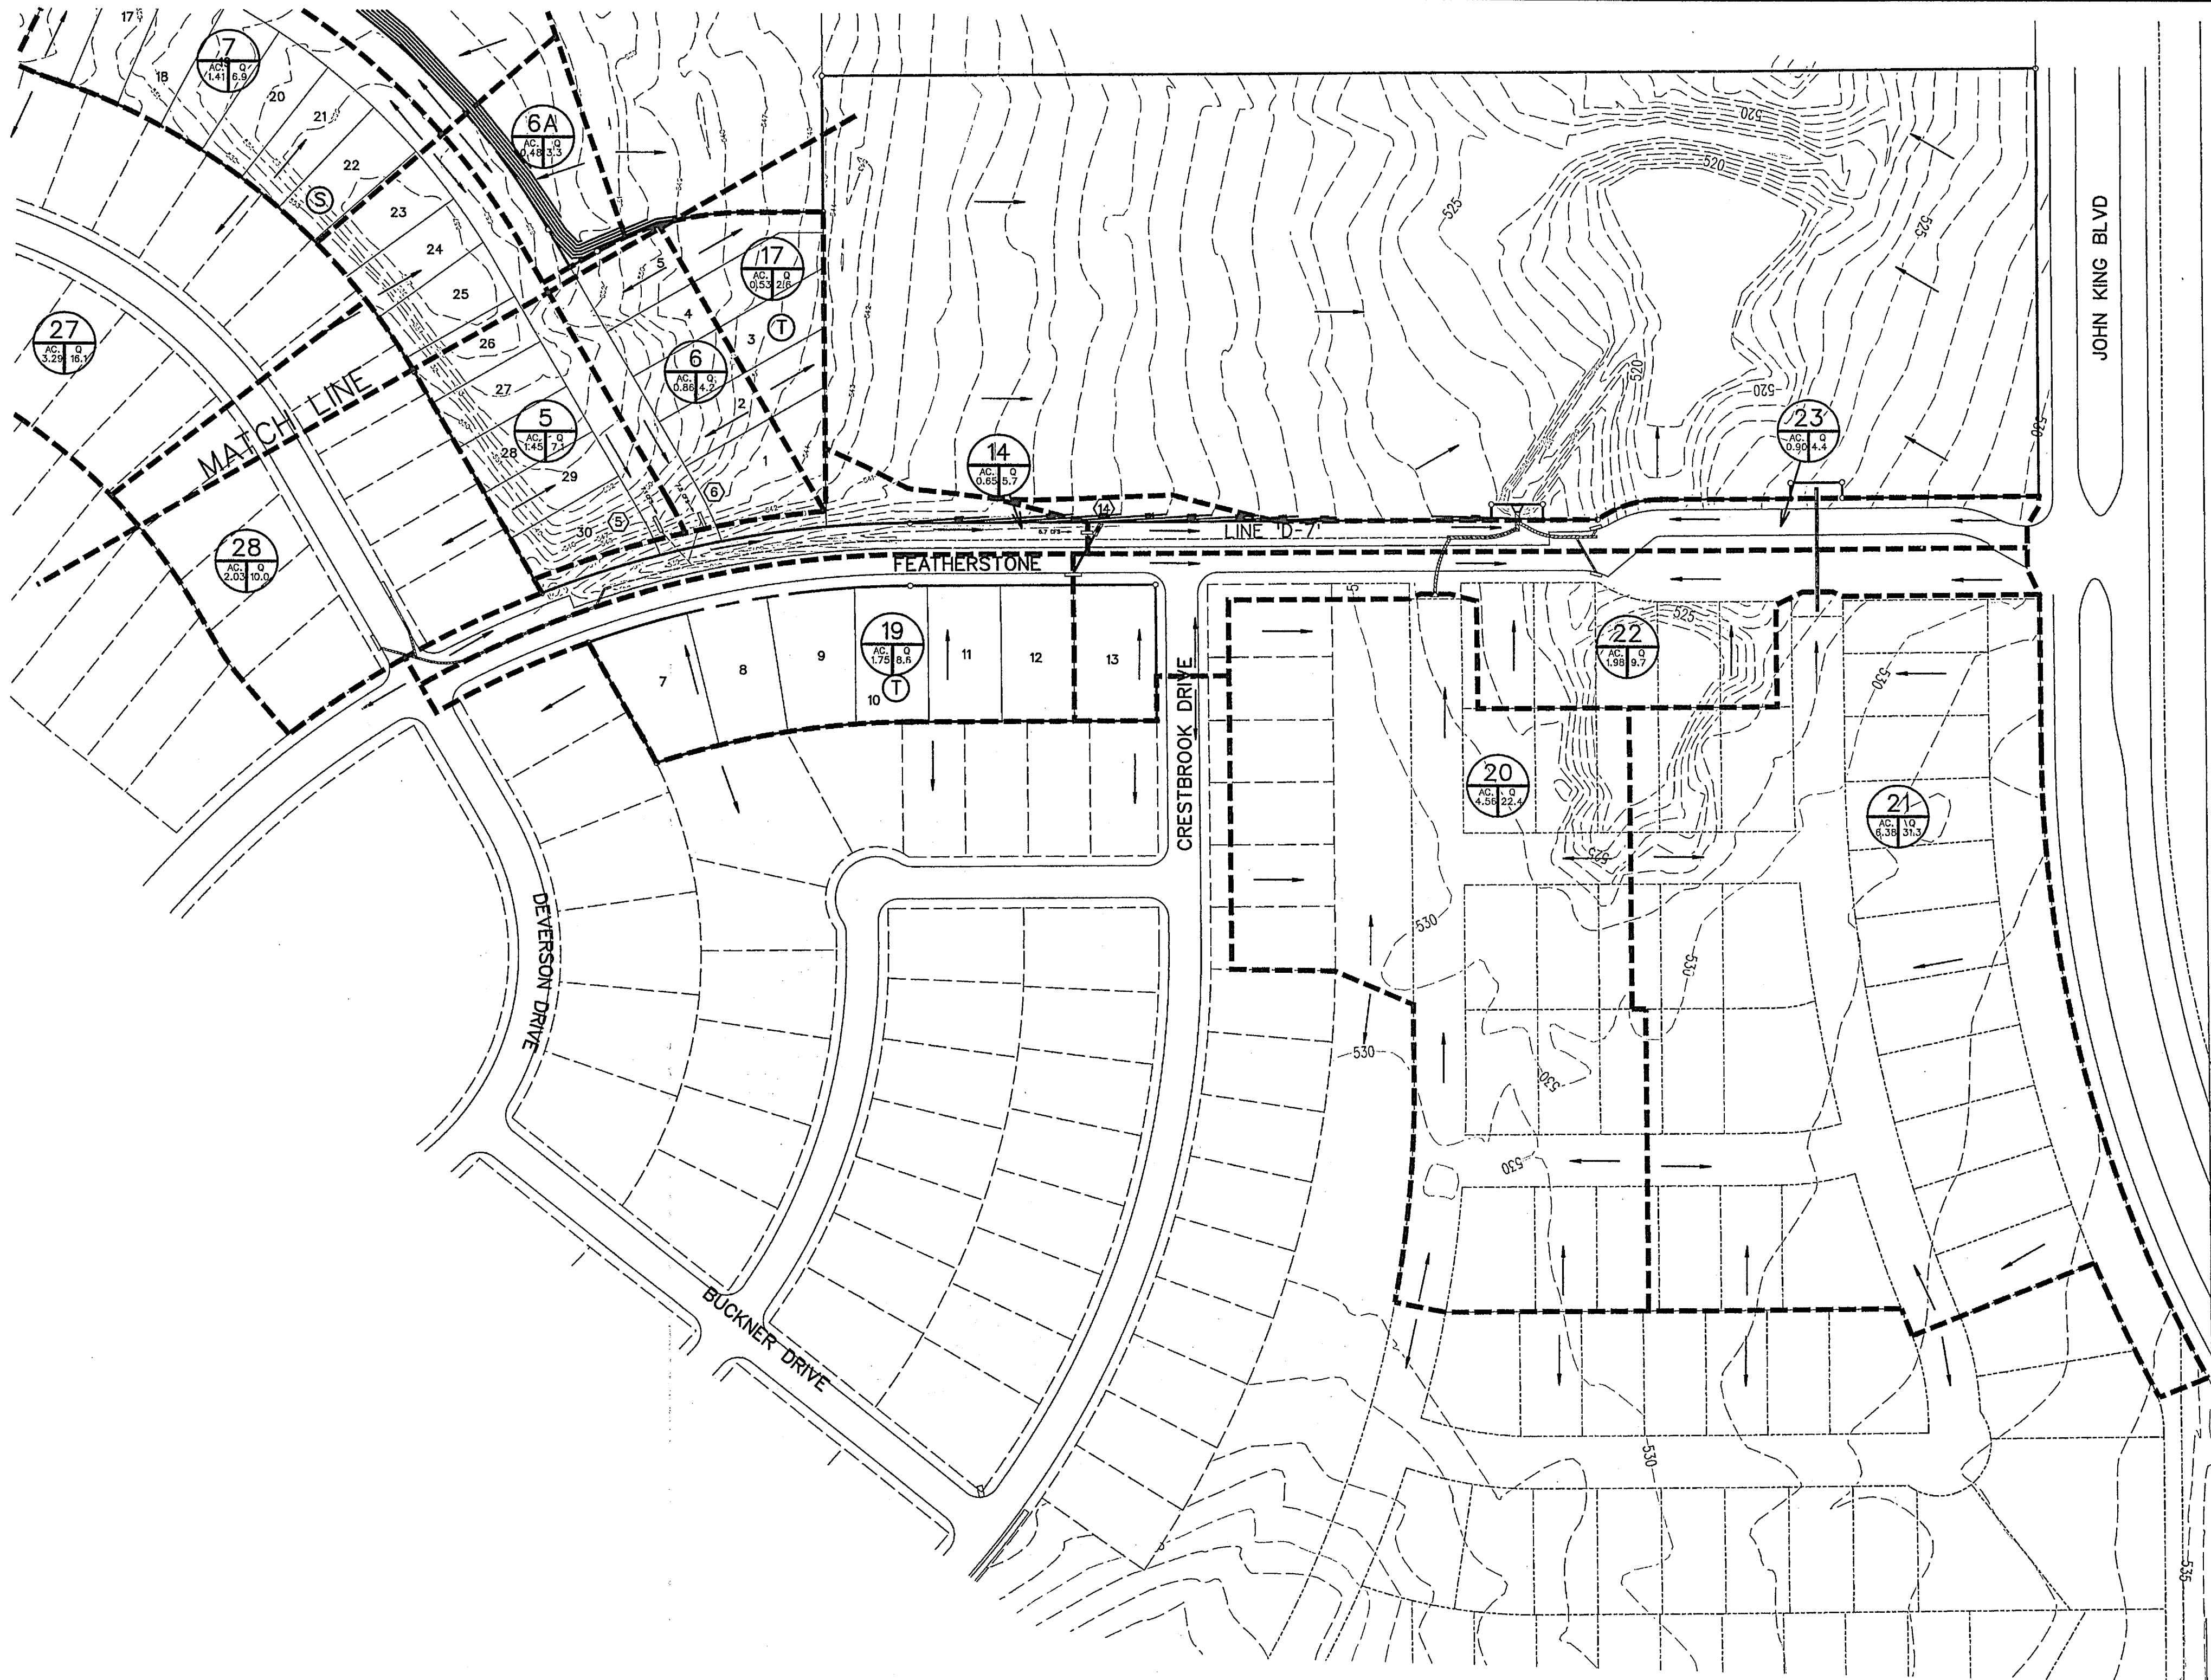


INLET CALCULATIONS

Inlet #	Location	Design Storm Frequency	Time of Conc. (min.)	Intensity (in/hr)	Runoff Coeff.	Area (acres)	Q (cfs)	Carry-Over from Upstream (cfs)	Gutter Flow (cfs)	Gutter Capacity (cfs)	Gutter Slope (ft/ft)	Crown Length (ft)	Type	Selected Inlet Type	Carry-Over to Downstream (cfs)	Inlet Capacity (cfs)	
1	Woods/Knox	100	10	9.8	0.50	1.49	7.3	0.0	7.3	10.6	Low Pt	6" pbl	10	STD.	0.0	21.0	
2	Waits	2+44.50	100	10	9.8	0.50	1.29	6.3	0.0	6.3	12.3	6" pbl	10	STD.	0.0	21.0	
3	Mountcastle	6+24.10	100	10	9.8	0.50	1.67	8.2	0.0	8.2	17.7	Low Pt	6" pbl	10	STD.	0.0	21.0
4	Mountcastle	6+24.10	100	10	9.8	0.50	2.59	12.7	0.0	12.7	17.7	Low Pt	6" pbl	10	STD.	0.0	21.0
5	Mountcastle	18+21.45	100	10	9.8	0.50	1.45	7.1	0.0	7.1	16.5	1.65%	6" pbl	15	STD.	0.0	11.5
6	Mountcastle	19+36.00	100	10	9.8	0.57	1.33	7.5	0.0	7.5	21.7	2.36%	6" pbl	15	STD.	0.0	10.5
7	Mountcastle	9+91.44	100	10	9.8	0.50	1.41	6.9	0.0	6.9	19.3	1.20%	6" pbl	10	STD.	0.1	6.8
8	Mountcastle	9+69.02	100	10	9.8	0.70	1.37	9.4	0.0	9.4	21.7	2.07%	6" pbl	10	STD.	2.9	6.5
9	Greenway	16+75.00	100	10	9.8	0.50	1.08	5.3	3.0	8.3	21.1	1.96%	6" pbl	15	STD.	0.0	10.0
10	Greenway	16+47.73	100	10	9.8	0.70	2.14	14.7	0.0	14.7	N/A	Low Pt	-	4	WYE	0.0	20.5
11	Greenway	21+00.00	100	10	9.8	0.50	1.19	5.8	0.0	5.8	10.6	1.63%	6" pbl	10	STD.	0.0	6.3
12	Greenway	20+97.50	100	10	9.8	0.60	0.32	1.6	0.0	1.6	10.6	0.88%	6" pbl	10	STD.	0.0	6.3
12A	Greenway	21+10.00	100	10	9.8	0.50	2.18	10.7	0.0	10.7	N/A	Low Pt	-	4	WYE	0.0	20.5
13	Stone Creek	4+82.55	100	10	9.8	0.90	0.53	4.6	0.0	4.6	27.0	1.69%	1/4" x 1/4"	10	STD.	0.0	5.6
14	Featherstone	36+47.97	100	10	9.8	0.90	0.65	5.7	0.0	5.7	21.9	2.10%	6" pbl	10	STD.	0.0	6.2
15	Stone Creek	4+82.55	100	10	9.8	0.90	0.47	4.2	0.0	4.2	27.0	1.69%	1/4" x 1/4"	10	STD.	0.0	5.6

RUNOFF COMPUTATIONS


#	Area (sq ft)	Area (acres)	Runoff Coefficient	Tc (min)	I (in/hr)	Q (100)	Q (cfs)
1	54913	1.49	0.50	10	9.8	7.3	7.3
2	56144	1.29	0.50	10	9.8	6.3	6.3
3	72810	1.67	0.50	10	9.8	8.2	8.2
4	112693	2.59	0.50	10	9.8	12.7	12.7
5	62985	1.45	0.50	10	9.8	7.1	7.1
6	97307	0.65	0.50	10	9.8	5.8	5.8
6A	20770	0.48	0.70	10	9.8	3.3	3.3
7	61389	1.41	0.50	10	9.8	6.9	6.9
8	55550	1.37	0.70	10	9.8	9.4	9.4
9	47155	1.08	0.50	10	9.8	5.3	5.3
10	53188	2.14	0.70	10	9.8	14.7	14.7
11	51869	1.19	0.50	10	9.8	5.8	5.8
12	13919	0.32	0.50	10	9.8	1.6	1.6
12A	94904	2.18	0.50	10	9.8	10.7	10.7
13	22937	0.53	0.50	10	9.8	4.6	4.6
14	28155	0.65	0.50	10	9.8	5.7	5.7
15	20563	0.47	0.90	10	9.8	4.2	4.2
16	91340	2.10	0.50	10	9.8	10.3	10.3
17	23239	0.53	0.50	10	9.8	2.6	2.6
18	207622	4.75	0.35	15	6.3	13.8	13.8
19	76230	1.75	0.50	10	9.8	8.6	8.6
20	198802	4.56	0.50	10	9.8	22.4	22.4
21	277890	6.38	0.50	10	9.8	31.3	31.3
22	86207	1.88	0.50	10	9.8	9.7	9.7
23	39213	0.90	0.50	10	9.8	4.4	4.4
24	541551	21.82	0.90	10	9.8	100.3	100.3
25	165086	3.79	0.35	10	6.3	11.0	11.0
26	202645	4.65	0.50	10	9.8	22.8	22.8
27	143285	3.29	0.50	10	9.8	16.1	16.1
28	65428	2.03	0.50	10	9.8	10.0	10.0

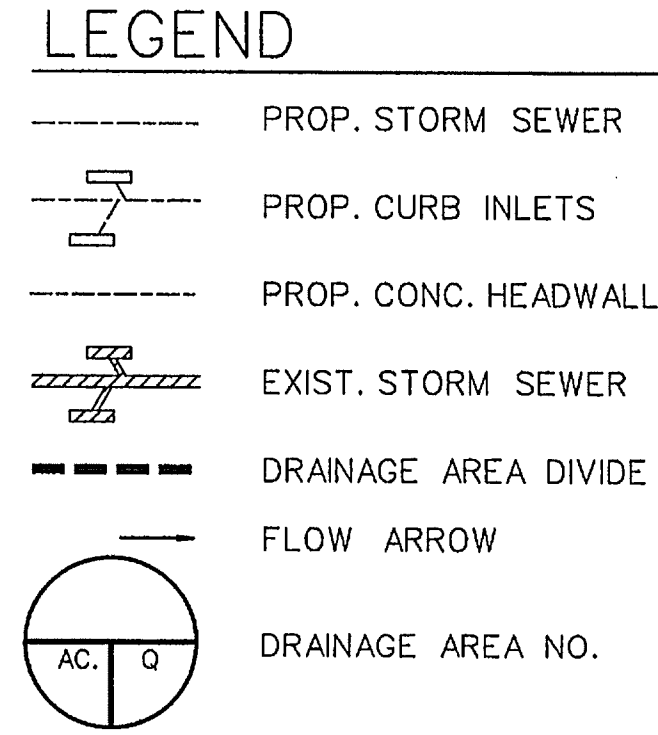

STORM SEWER CALCULATIONS

Upstream Station	Downstream Station	Distance (ft)	AREA NO.	Total Area (Acres)	Picked Up (Acres)	C	CA	Accounted CA	Tc (Min)	Design Storm (Years)	I (in/hr)	Q (CFS)	S (ft/ft)	Pipe Size (in)	Velocity (ft/s)	Head Loss (ft)	Flow Time (Min)	Time at DS (Min)	Δ Velocity Head (ft)	Hydraulic Grade Upstream	Hydraulic Grade Downstream	Proposed Grade
Line D1																						
2+36.27	2+13.67	22.60	12A	2.18	2.18	0.50	1.09	1.09	10.00	100	9.80	10.7	0.0022	24	3.4	0.18	0.11	10.11	0.18	528.21	528.21	528.00
2+13.67	1+73.67	40.00	12	0.32	0.32	0.50	0.16	1.25	10.00	100	9.80	12.2	0.0029	24	3.9	0.24	0.17	10.17	0.06	528.16	528.11	528.08
1+73.67	1+56.50	17.17	11	1.19	1.19	0.50	0.60	1.84	10.00	100	9.80	18.1	0.0064	24	5.8	0.51	0.05	10.05	0.28	527.99	527.71	528.48
Line D2																						
1+56.50	0+58.72	81.19	2	1.29	1.29	0.50	0.64	0.64	10.00	100	9.80	6.3	0.0008	24	2.0	0.06	0.67	10.67	0.06	523.43	523.37	541.63
0+58.72	0+00.00	58.72	1	1.49	1.49	0.50	0.75	1.39	10.00	100	9.80	13.6	0.0036	24	4.3	0.29	0.23	10.23	0.23	523.30	523.07	540.53
Line D3																						
2+10.43	1+76.19	34.24	13	0.53	0.53	0.90	0.47	0.47	10.00	100	9.80	4.6	0.0004	24	1.5	0.03	0.39	10.39	0.03	547.89	547.86	520.99
1+76.19	1+66.52	9.67	Bread	0.00	0.00	0.90	0.00	0.47	10.00	100	9.80	4.6	0.0004	24	1.5	0.03	0.11	10.11	0.03	547.85	547.85	520.60
1+66.52	0+00.00	166.52	15	0.47	0.47	0.90	0.43	0.90	10.00	100	9.80	8.8	0.0015	24	2.8	0.12	0.99	10.99	0.09	547.84	547.75	520.99
Line D4																						
10+23.08	8+81.68	141.40	2627	7.94	7.94	0.50	3.97	3.97	10.00	100	9.80	38.9	0.0034	36	5.5	0.47	0.43	10.43	0.47	528.25	527.77	544.76
8+81.68	2+23.12	658.56	D6	2.78	2.72	0.50	1.36	5.33	10.00	100	9.80	52.2	0.0061	36	7.4	0.85	1.49	11.49	0.38	527.29	526.92	542.33
2+23.12	1+34.81	88.31	9,10	3.22	3.71	0.63	2.35	7.68	10.00	100	9.80	75.2	0.0056	42	7.8	0.95	1.19	10.19	0.10	522.88	522.77	526.61
Line D5																						
1+34.81	1+57.64	41.92	4	2.59	2.59	0.50	1.29	1.29	10.00	100	9.80	12.7	0.0031	24	4.0	0.25	0.17	10.17	0.25	521.12	521.12	540.69
1+57.64	0+04.00	153.64	3	1.67	1.67	0.50	0.83	2.13	10.00	100	9.80	20.8	0.0085	24	6.6	0.68	0.39	10.39	0.43	521.74	521.30	540.69
Line D6																						
0+04.00	0+36.55	46.50	7	1.41	1.39	0.50	0.70	0.70	10.00	100	9.80	6.8	0.0042	18	3.9	0.23	0.20	10.20	0.23	528.09	527.86	544.06
0+36.55	0+00.00	36.55	8	1.37	1.33	0.50	0.67	1.36	10.00	100	9.80	13.3	0.0035	24	4.2	0.28	0.14	10.14	0.14	527.66	527.61	543.52
Line D7																						
87+79.17	7+97.99	81.18	28	2.03	2.03	0.50	1.02	1.02	10.00	100	9.80	10.0	0.0090	18	5.6	0.49	0.24	10.24	0.49	525.12	524.62	542.25
7+97.99	4+12.32	385.67	5,6,6A	2.78	2.78	0.53	1.49	2.50	10.00	100	9.80	24.6	0.0118	24	7.8	0.95	0.82	10.82	0.46	523.89	523.43	541.15
4+12.32	0+66.24	346.08	14,19	2.40	2.40	0.61	1.46	3.96	10.00	100	9.80	38.9	0.0099	30	7.9	0.97	0.73	10.73	0.62	528.86	528.84	523.54
0+66.24	0+00.00	66.24	Future	4.56	4.56	0.50	2.28	6.24	10.00	100	9.80	61.3	0.0037	42	6.4	0.63	0.17	10.17	-0.17	525.73	525.25	528.16
0+00.00																						

BENCHMARK:
CITY OF ROCKWALL SURVEY MONUMENT ON AN INLET AT THE NORTHWEST CORNER OF FEATHERSTONE DR. AND HARVARD DR.
ELEV. = 525.31

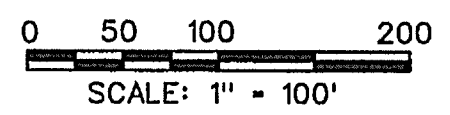

AS-BUILT SEPTEMBER 2015
INFORMATION PROVIDED BY CONTRACTORS (NOT FIELD VERIFIED)





The seal appearing on this document was authorized by Brandon Davidson, P.E. 87682, on September 10, 2014

CORWIN ENGINEERING, INC.
200 W. BELMONT, SUITE E
ALLEN, TEXAS 75013 (972)396-1200
TBP# FIRM #5951

DEVELOPMENT PLANS FOR
STONE CREEK
PHASE VI
ROCKWALL, TEXAS

DRAINAGE AREA MAP
SHEET 2 OF 2


DRAWN BY	DESIGNED BY	CHECKED BY	SHEET NO.
13068	MAY 2014	1"=100'	5 of 26

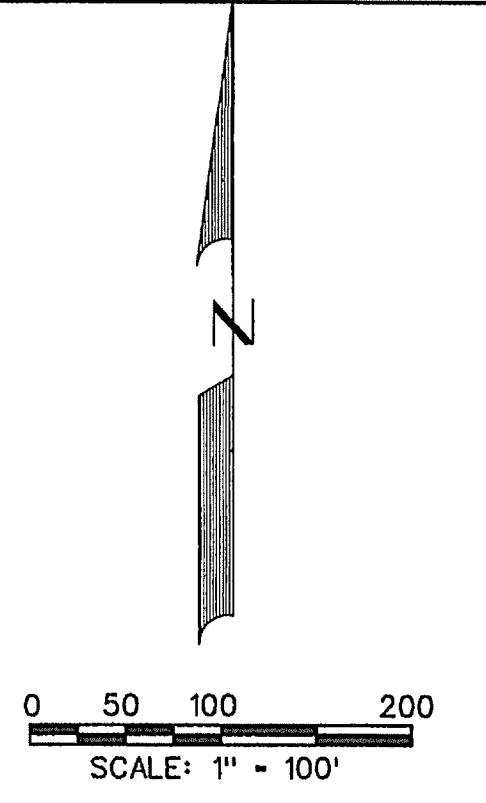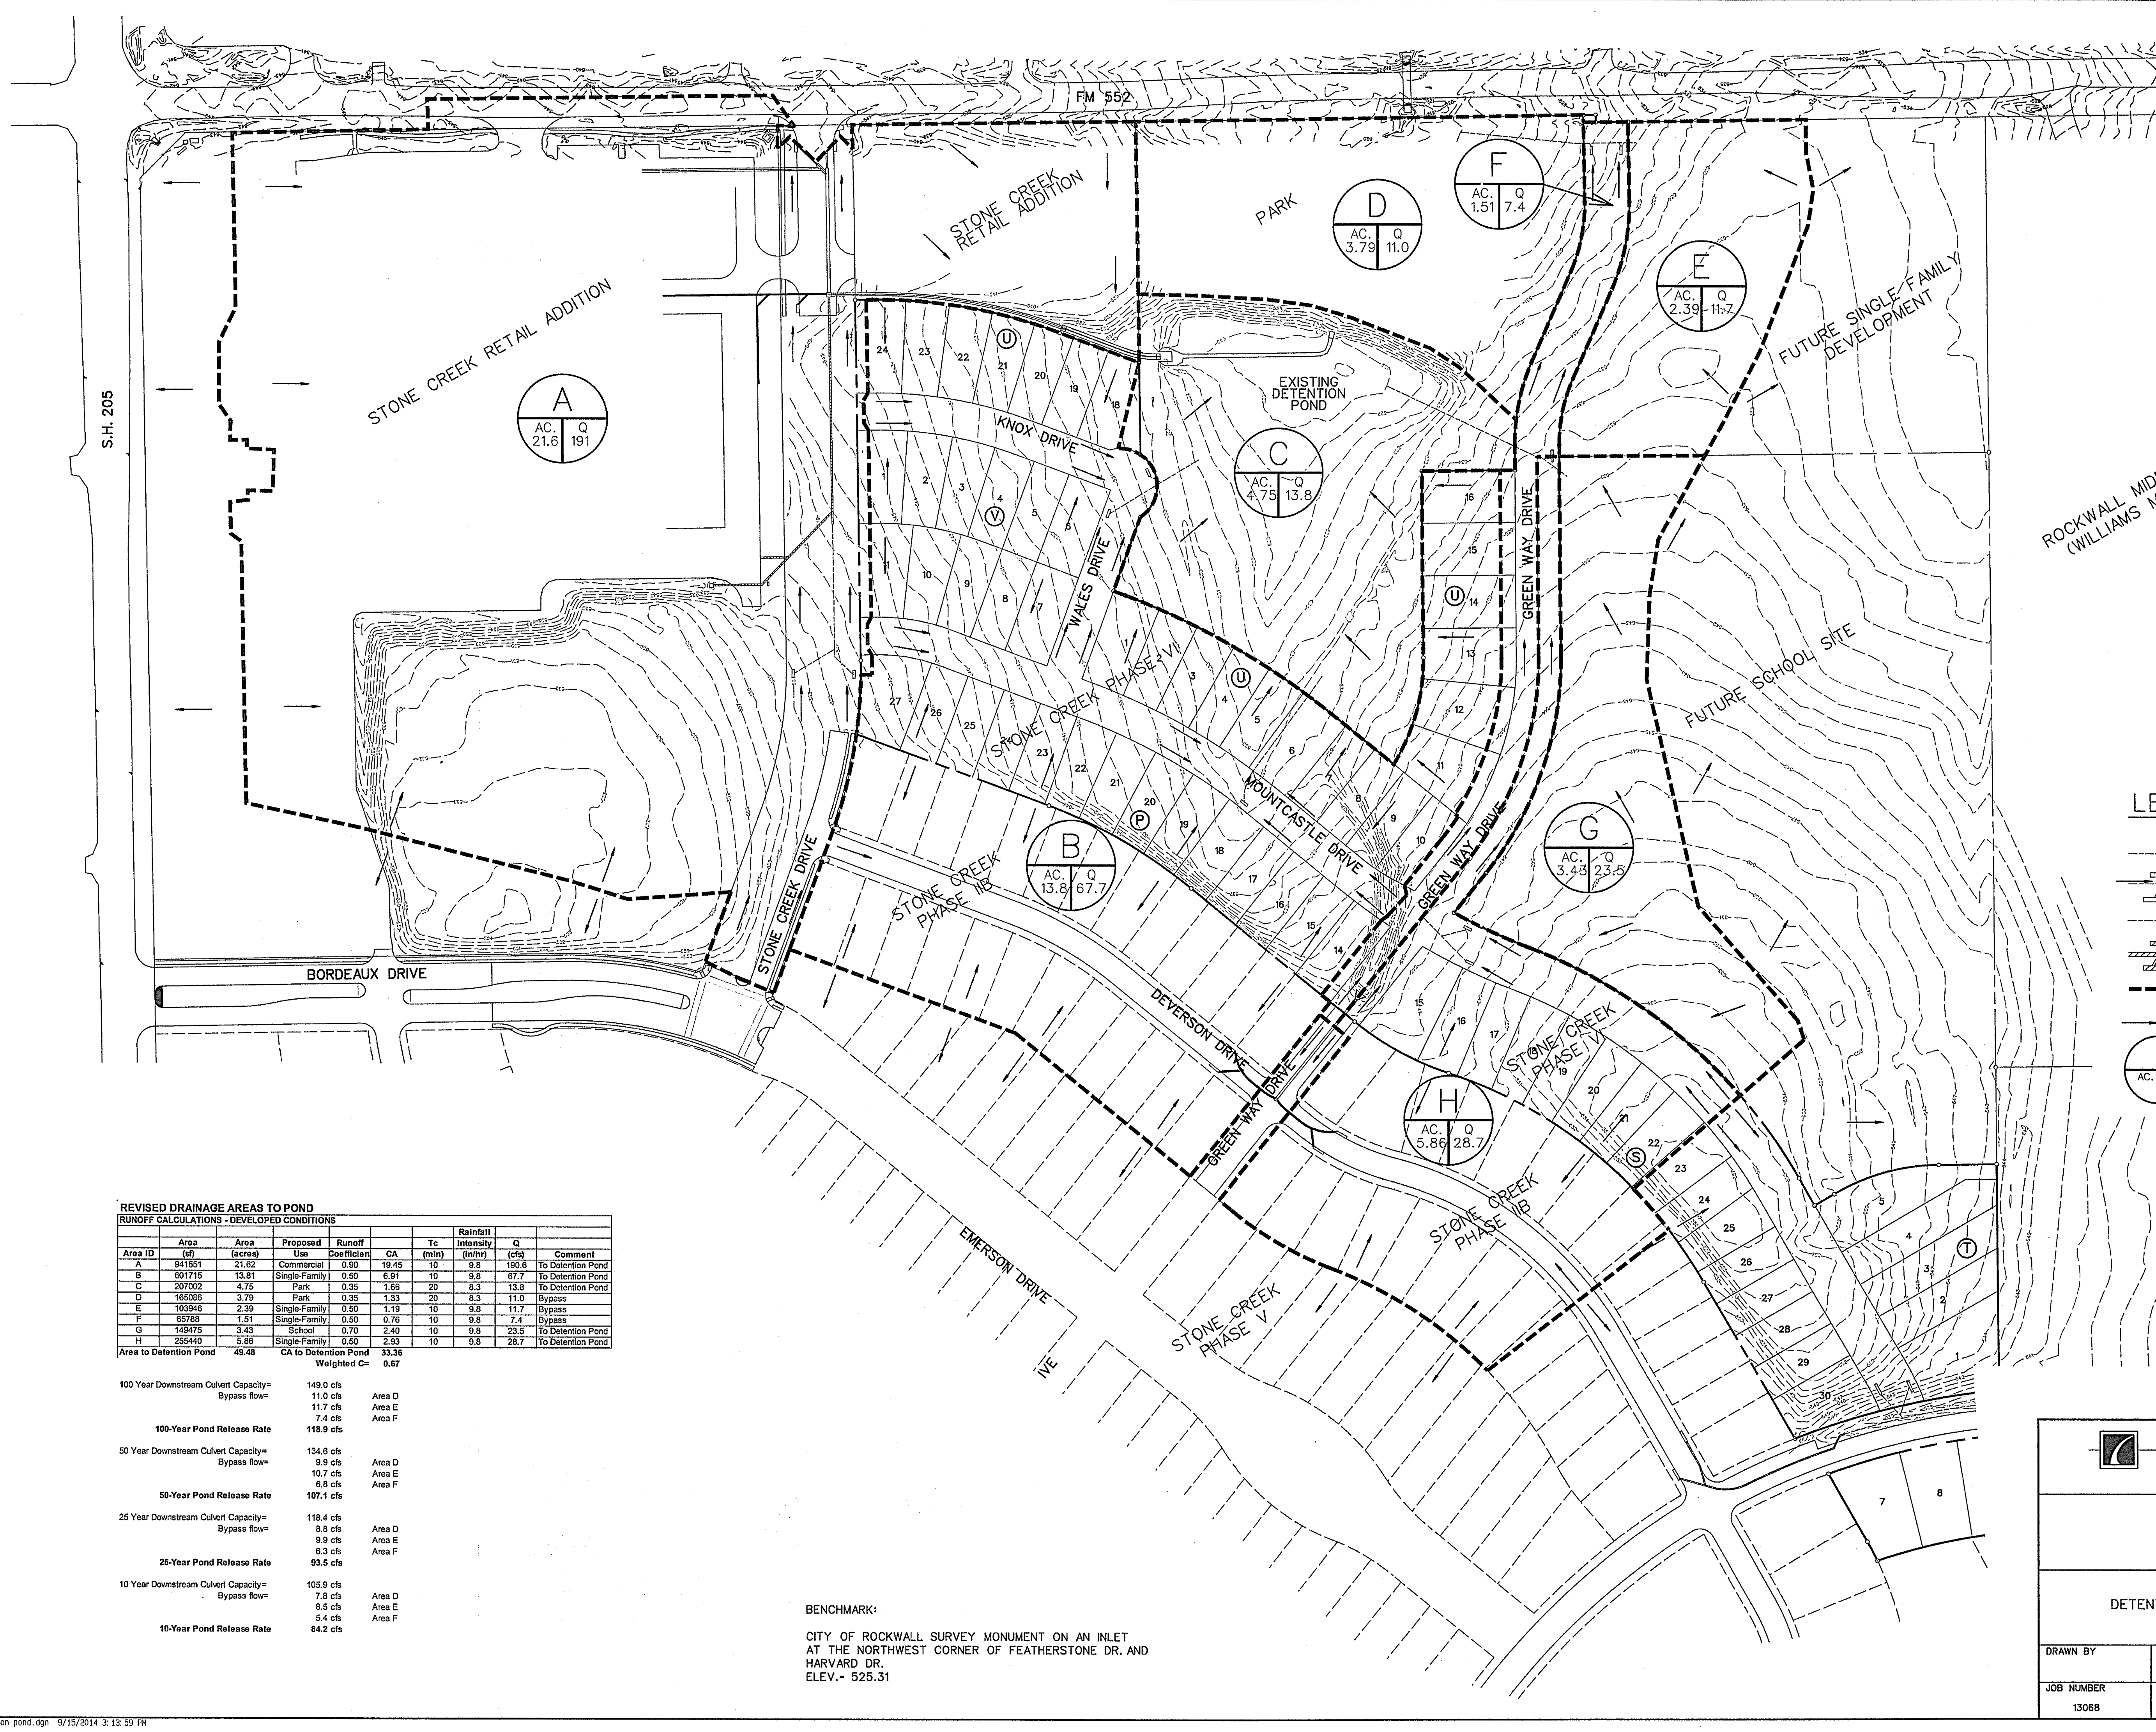

LEGEND

- PROP. STORM SEWER
- PROP. CURB INLETS
- PROP. CONC. HEADWALL
- EXIST. STORM SEWER
- DRAINAGE AREA DIVIDE
- FLOW ARROW
- DRAINAGE AREA NO.

AS-BUILT SEPTEMBER 2015
 INFORMATION PROVIDED
 BY CONTRACTORS
 (NOT FIELD VERIFIED)

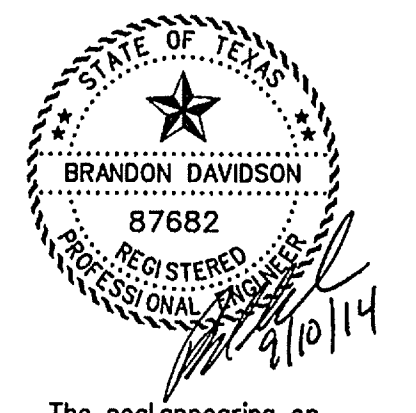

The seal appearing on
 this document was
 authorized by
 Brandon Davidson
 P.E. 87682, on
 September 10, 2014

REVISED DRAINAGE AREAS TO POND
 RUNOFF CALCULATIONS - DEVELOPED CONDITIONS

Area ID	Area (sq)	Area (acres)	Proposed Use	Runoff Coefficient	CA	Tc (min)	Rainfall Intensity (in/hr)	Q (cfs)	Comment
A	941951	21.82	Commercial	0.90	19.45	10	9.8	190.6	To Detention Pond
B	601715	13.81	Single-Family	0.50	6.91	10	9.8	67.7	To Detention Pond
C	207002	4.75	Park	0.35	1.88	20	8.3	13.8	To Detention Pond
D	165026	3.79	Park	0.35	1.33	20	8.3	11.0	Bypass
E	103946	2.39	Single-Family	0.50	1.19	10	9.8	11.7	Bypass
F	65768	1.51	Single-Family	0.50	0.76	10	9.8	7.4	Bypass
G	149475	3.43	School	0.70	2.40	10	9.8	23.5	To Detention Pond
H	255440	5.86	Single-Family	0.50	2.93	10	9.8	28.7	To Detention Pond
Area to Detention Pond				49.48	CA to Detention Pond		33.36		
				Weighted C=		0.67			

100 Year Downstream Culvert Capacity=	149.0 cfs	
Bypass flow=	11.0 cfs	Area D
	11.7 cfs	Area E
	7.4 cfs	Area F
100-Year Pond Release Rate	118.9 cfs	
50 Year Downstream Culvert Capacity=	134.6 cfs	
Bypass flow=	9.9 cfs	Area D
	10.7 cfs	Area E
	6.8 cfs	Area F
50-Year Pond Release Rate	107.1 cfs	
25 Year Downstream Culvert Capacity=	118.4 cfs	
Bypass flow=	8.8 cfs	Area D
	9.9 cfs	Area E
	6.3 cfs	Area F
25-Year Pond Release Rate	93.5 cfs	
10 Year Downstream Culvert Capacity=	105.9 cfs	
Bypass flow=	7.8 cfs	Area D
	6.5 cfs	Area E
	6.4 cfs	Area F
10-Year Pond Release Rate	84.2 cfs	





BENCHMARK:
 CITY OF ROCKWALL SURVEY MONUMENT ON AN INLET
 AT THE NORTHWEST CORNER OF FEATHERSTONE DR. AND
 HARVARD DR.
 ELEV. = 525.31

CORWIN ENGINEERING, INC.
 200 W. BELMONT, SUITE E
 ALLEN, TEXAS 75013 (972)396-1200
 TBPE FIRM #5951

**DEVELOPMENT PLANS FOR
 STONE CREEK
 PHASE VI
 ROCKWALL, TEXAS**


DETENTION POND DRAINAGE AREA MAP

DRAWN BY	DESIGNED BY	CHECKED BY	SHEET NO.
JOB NUMBER	DATE	SCALE	
13068	MAY 2014	HOR: 1"=100'	6 OF 26

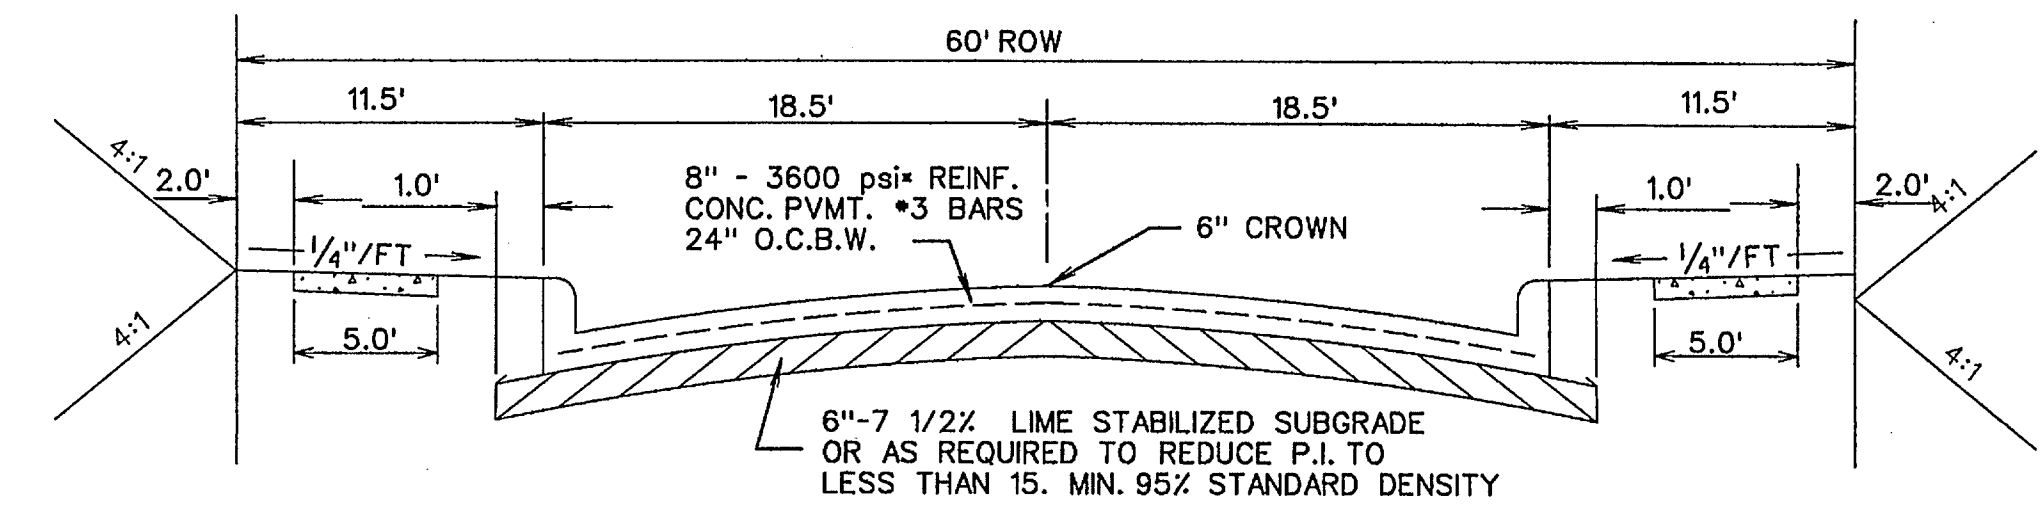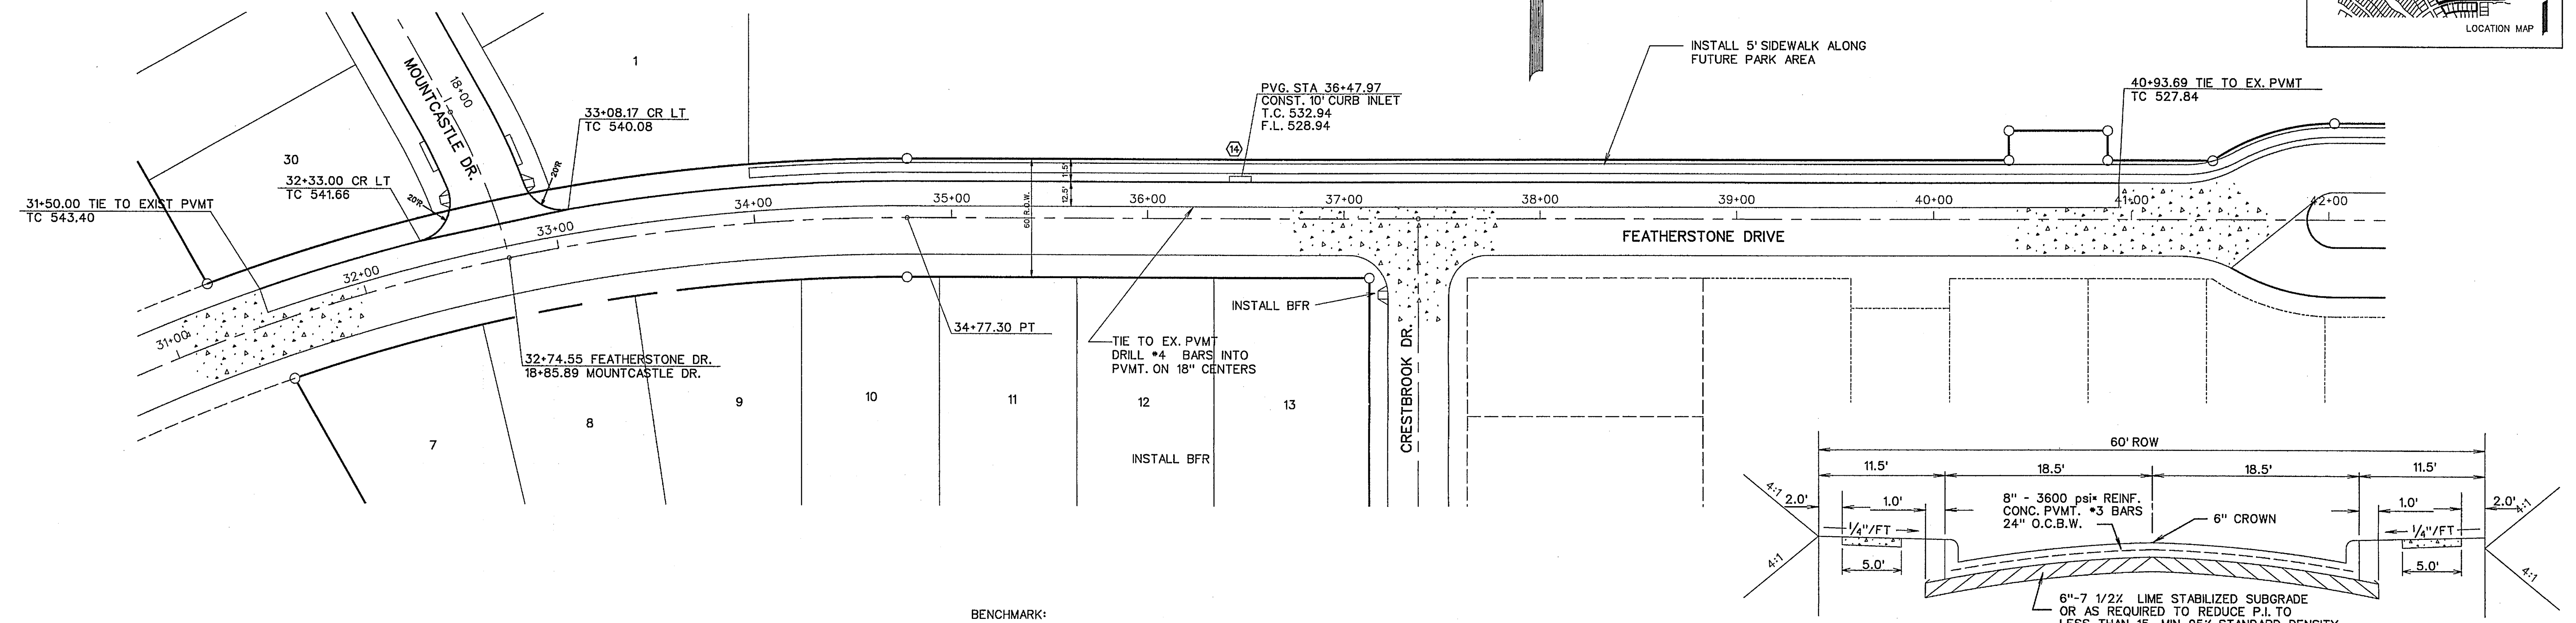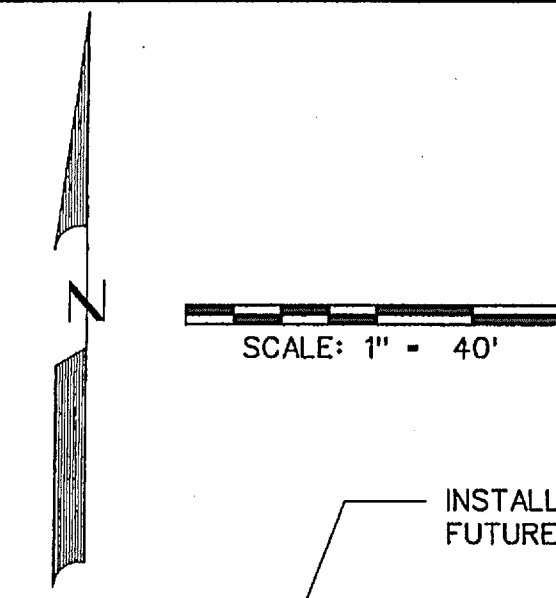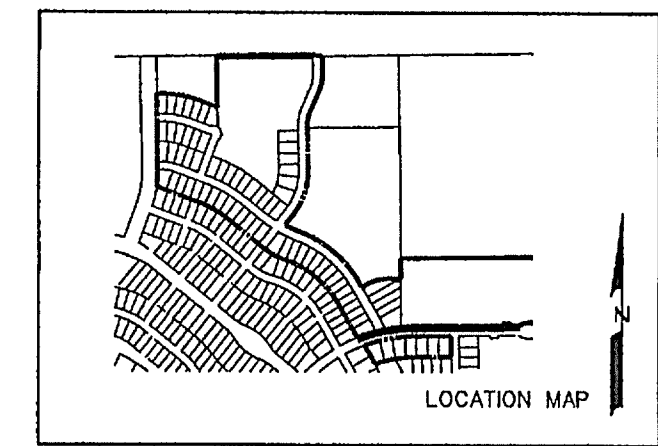


BENCHMARK:
CITY OF ROCKWALL SURVEY MONUMENT ON AN INLET
AT THE NORTHWEST CORNER OF FEATHERSTONE DR. AND
HARVARD DR.
ELEV.- 525.31

ULTIMATE PAVEMENT SECTION - 37' B-B
N.T.S.
*CONCRETE SHALL BE A 6 SACK MIX IF MACHINE
POURED OR 6 1/2 SACK MIX IF HAND POURED

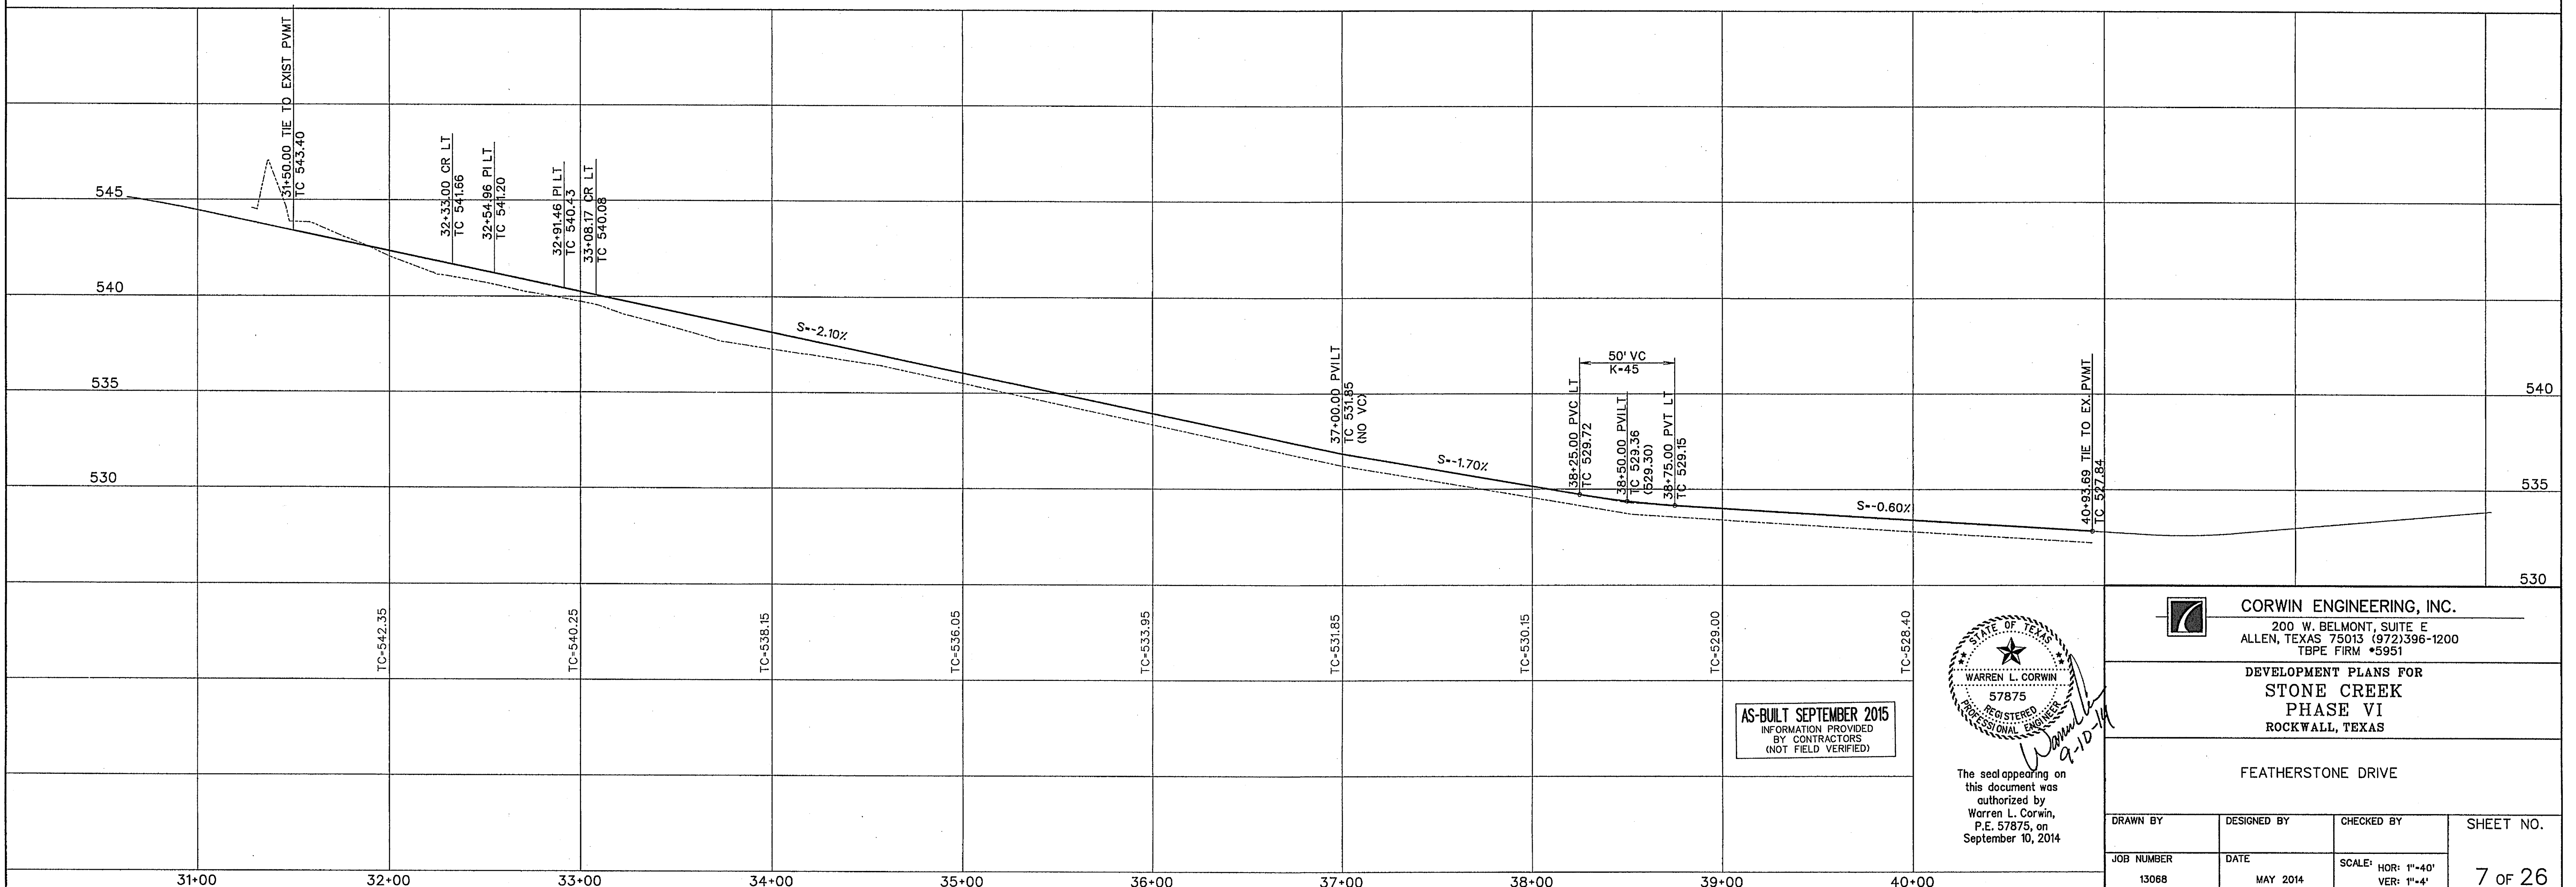

AS-BUILT SEPTEMBER 2015
INFORMATION PROVIDED
BY CONTRACTORS
(NOT FIELD VERIFIED)

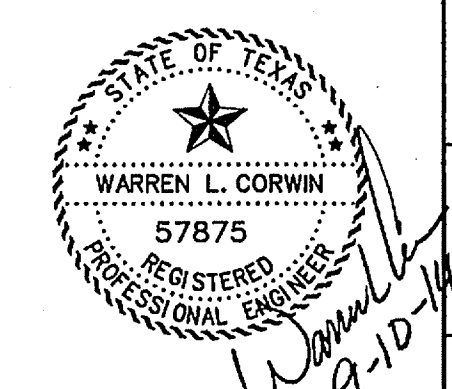

The seal appearing on
this document was
authorized by
Warren L. Corwin,
P.E. 57875, on
September 10, 2014

CORWIN ENGINEERING, INC.
200 W. BELMONT, SUITE E
ALLEN, TEXAS 75013 (972)396-1200
TBP E FIRM #5951




DEVELOPMENT PLANS FOR
STONE CREEK
PHASE VI
ROCKWALL, TEXAS

FEATHERSTONE DRIVE

DRAWN BY	DESIGNED BY	CHECKED BY	SHEET NO.
JOB NUMBER	DATE	SCALE: HOR: 1"=40' VER: 1"=4'	7 OF 26
13068	MAY 2014		




SCALE: 1" = 40'

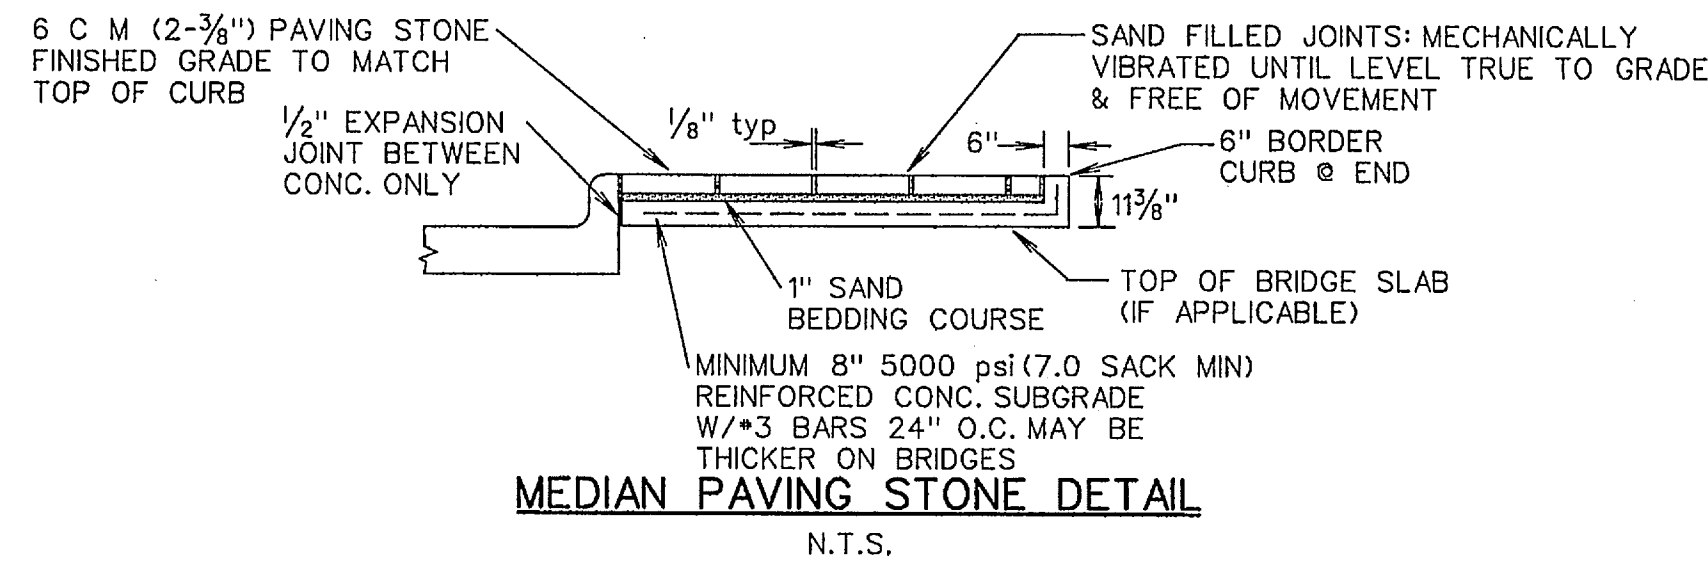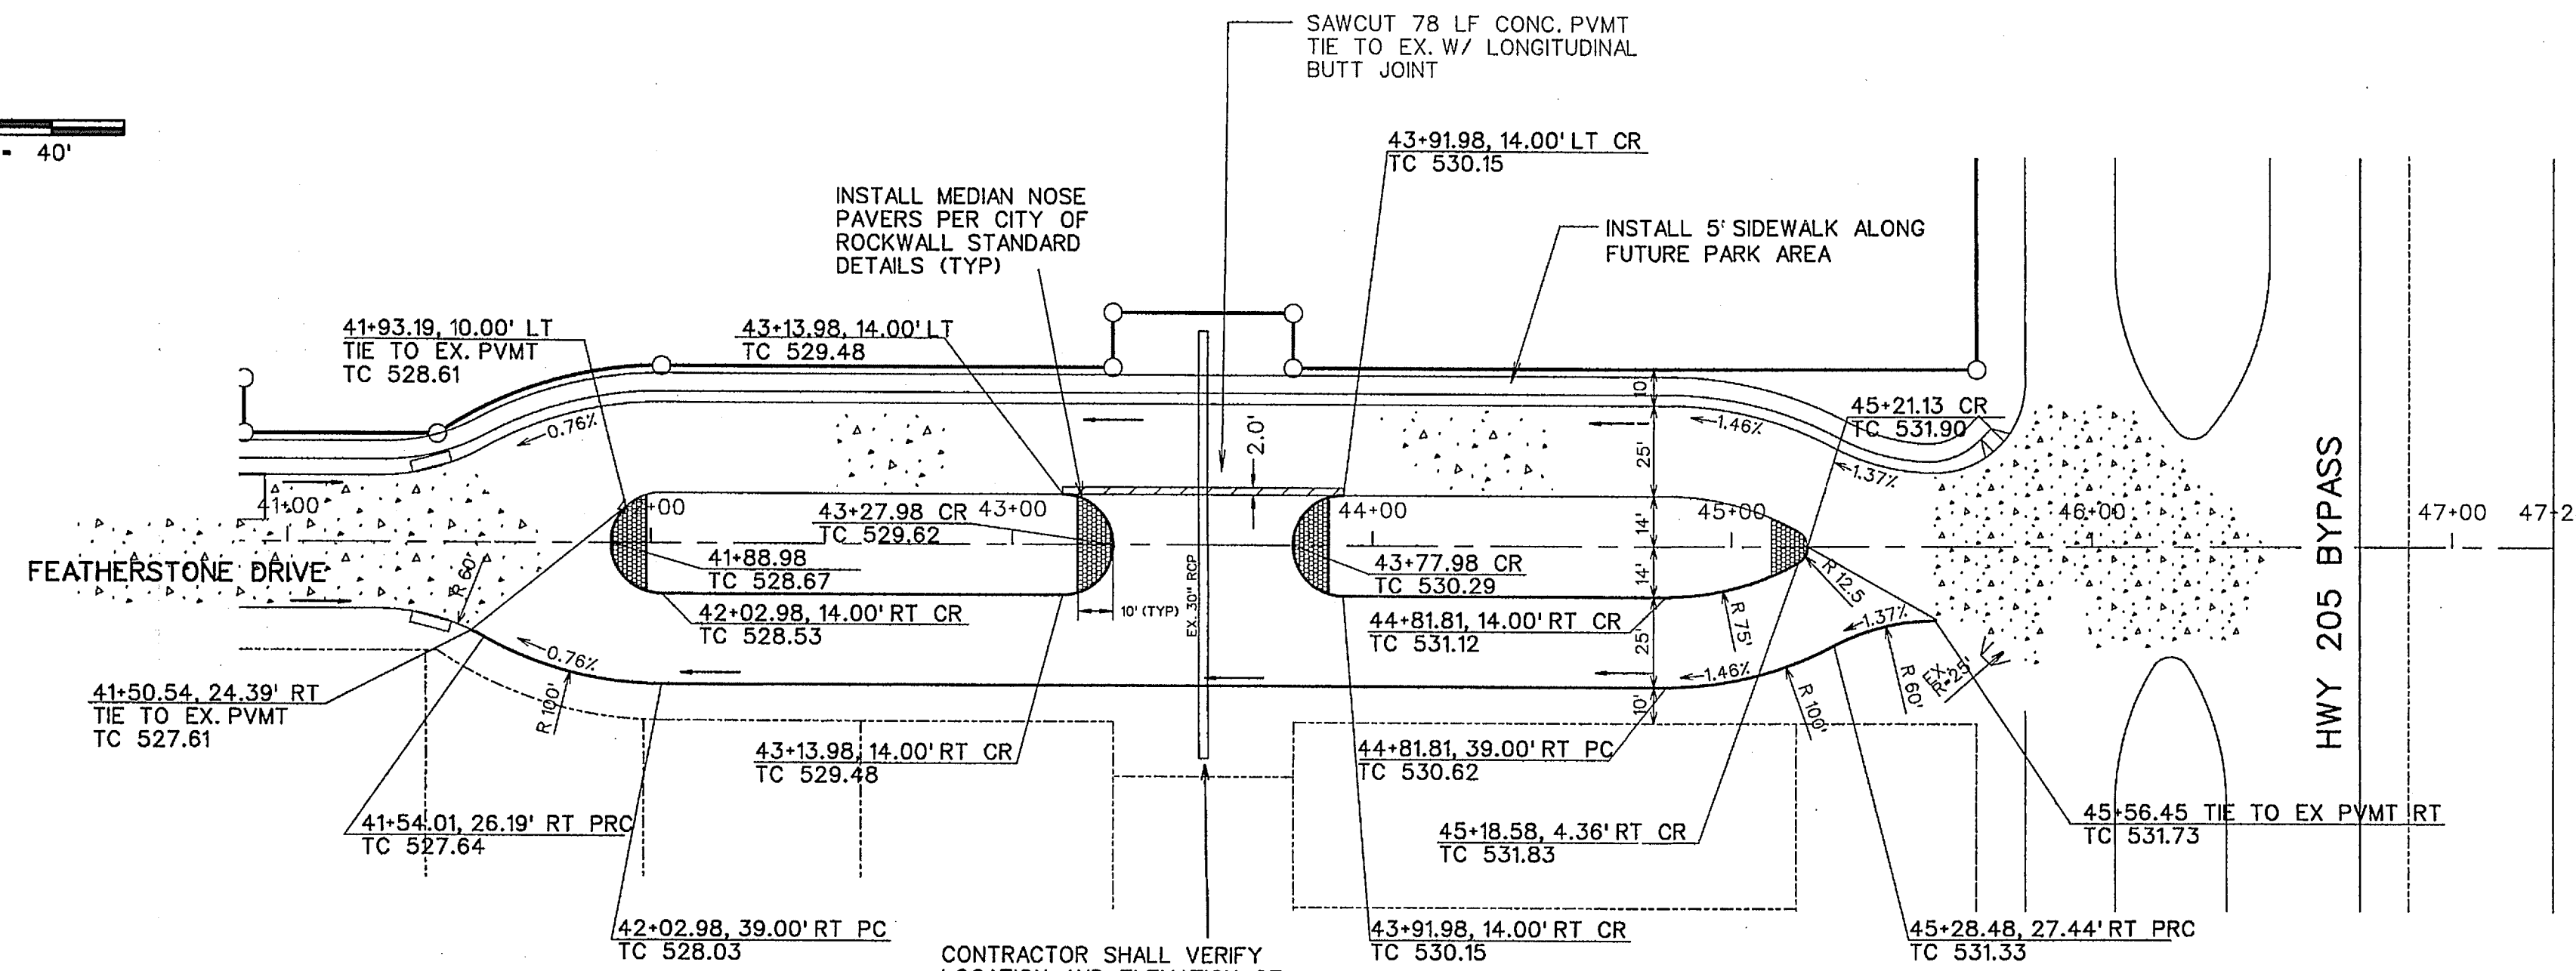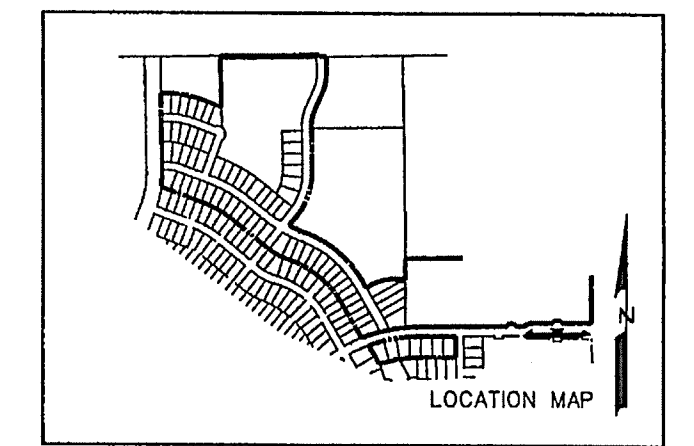


CONTRACTOR SHALL VERIFY LOCATION AND ELEVATION OF EXISTING STORM SEWER PIPE AT BOTH ENDS AT START OF CONSTRUCTION


BENCHMARK: CITY OF ROCKWALL SURVEY MONUMENT ON AN INLET AT THE NORTHWEST CORNER OF FEATHERSTONE DR. AND HARVARD DR. ELEV. = 525.31

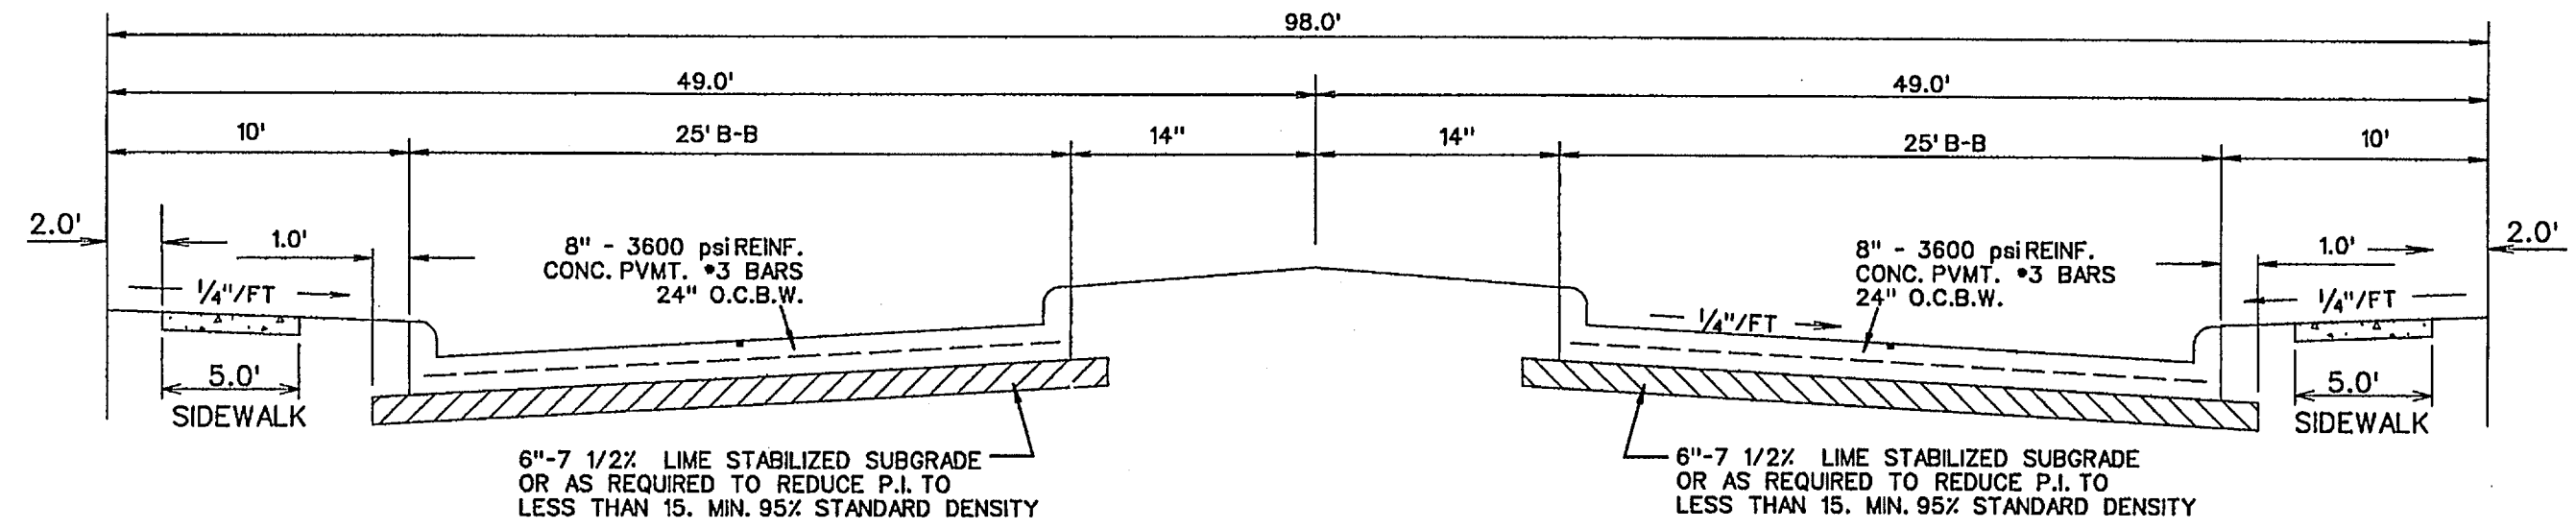

TYPICAL SECTION - FEATHERSTONE N.T.S.

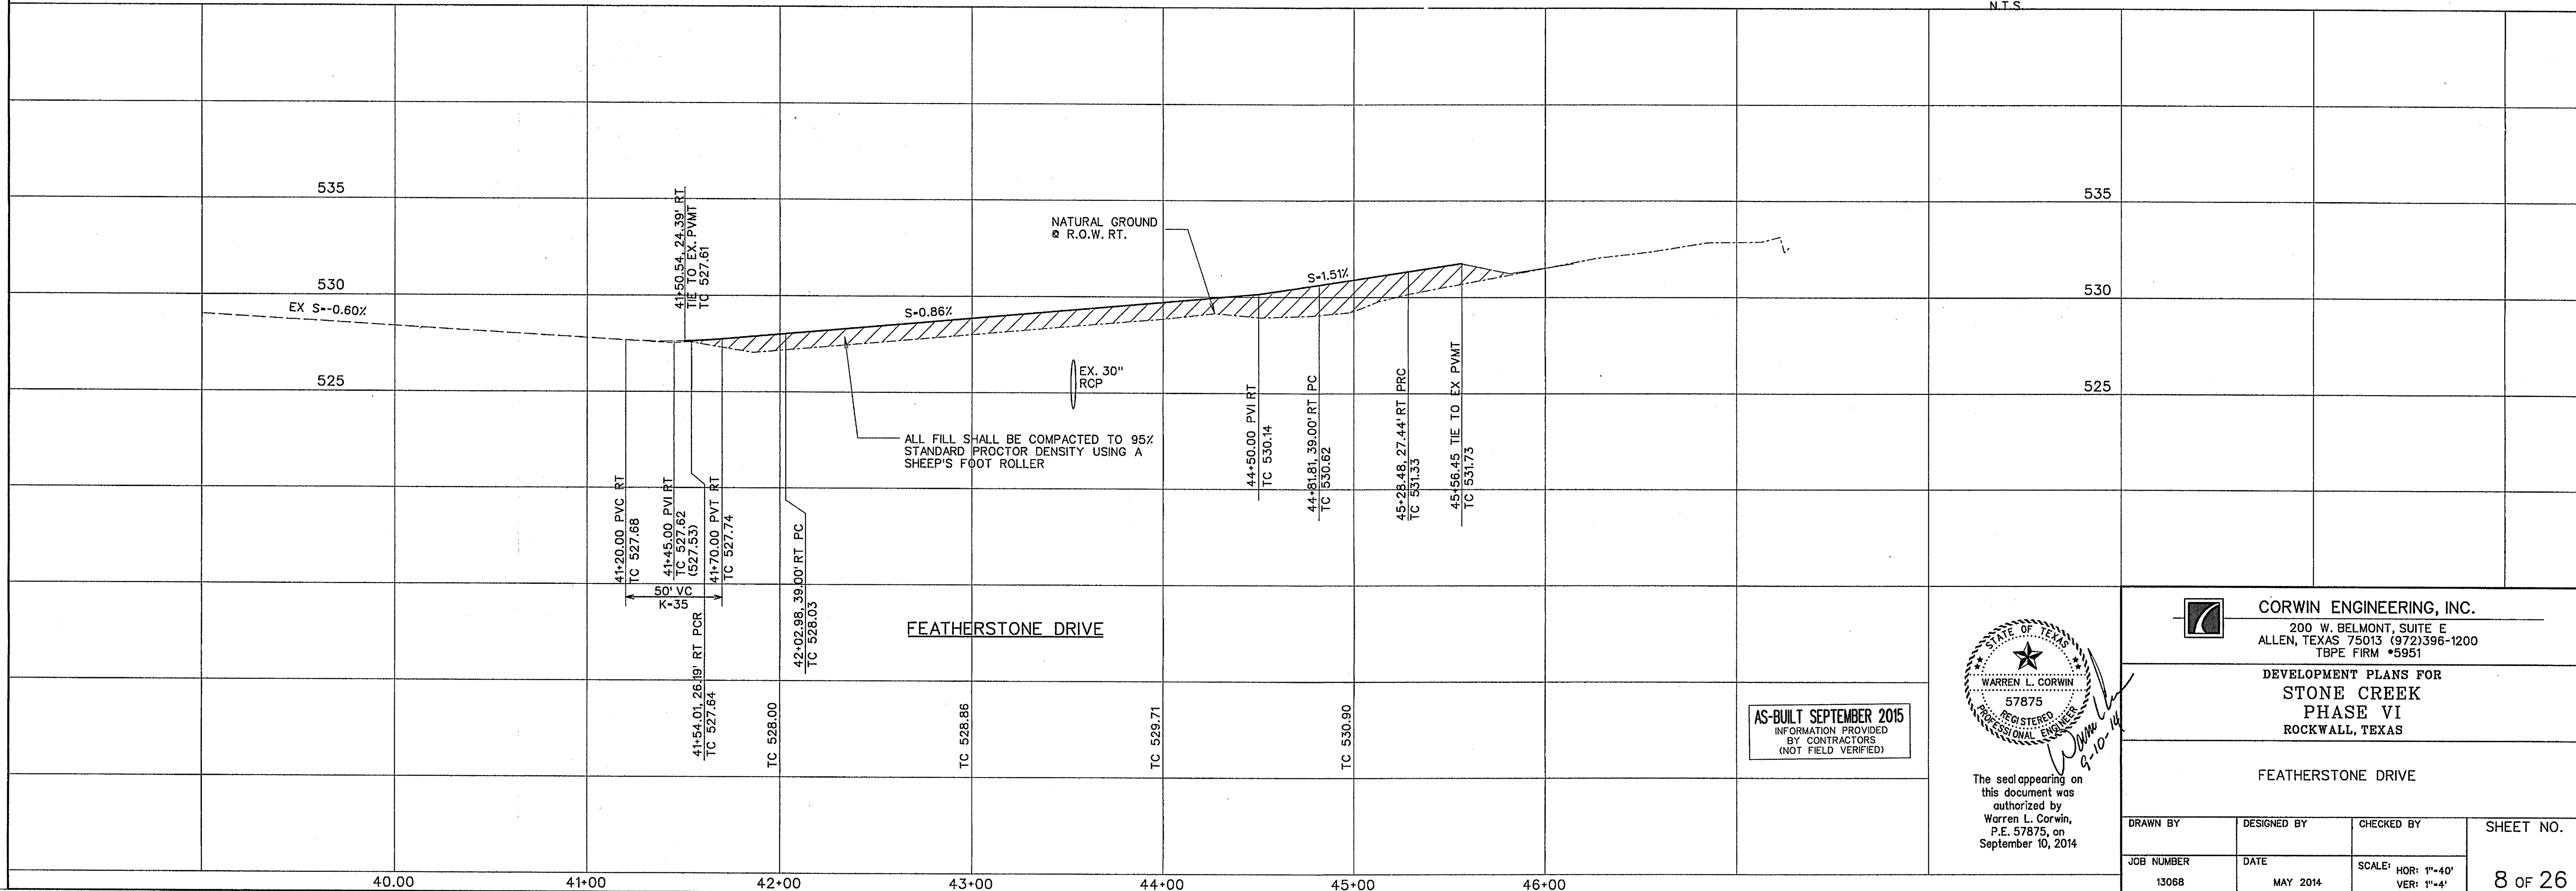

AS-BUILT SEPTEMBER 2015 INFORMATION PROVIDED BY CONTRACTORS (NOT FIELD VERIFIED)

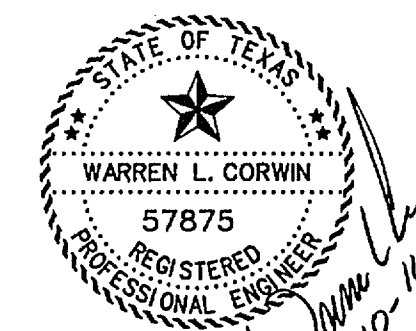



The seal appearing on this document was authorized by Warren L. Corwin, P.E. 57875, on September 10, 2014

CORWIN ENGINEERING, INC. 200 W. BELMONT, SUITE E ALLEN, TEXAS 75013 (972)396-1200 TBPE FIRM #5951


DEVELOPMENT PLANS FOR STONE CREEK PHASE VI ROCKWALL, TEXAS

FEATHERSTONE DRIVE



DRAWN BY	DESIGNED BY	CHECKED BY	SHEET NO.
JOB NUMBER	DATE	SCALE: HOR: 1"=40'	8 OF 26
13068	MAY 2014	VER: 1"=4'	

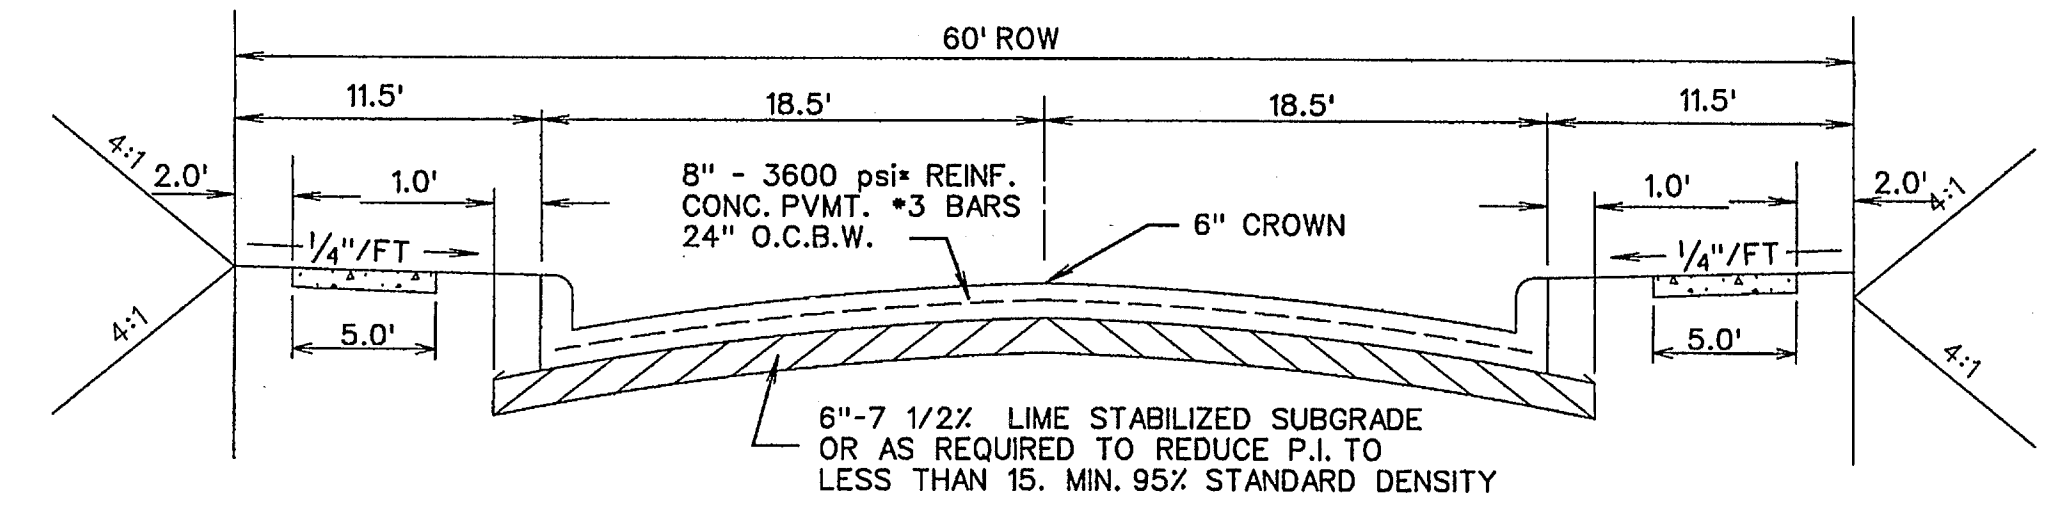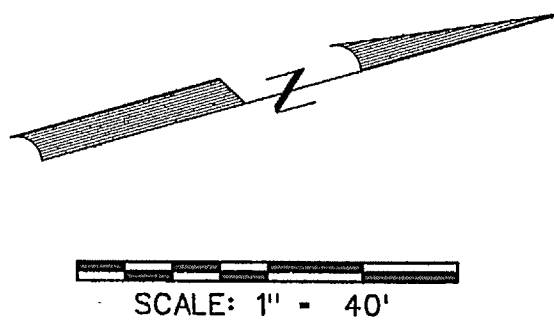


PAVEMENT SECTION - 37' B-B
N.T.S.
*CONCRETE SHALL BE A 6 SACK MIX IF MACHINE POURED OR 6 1/2 SACK MIX IF HAND POURED

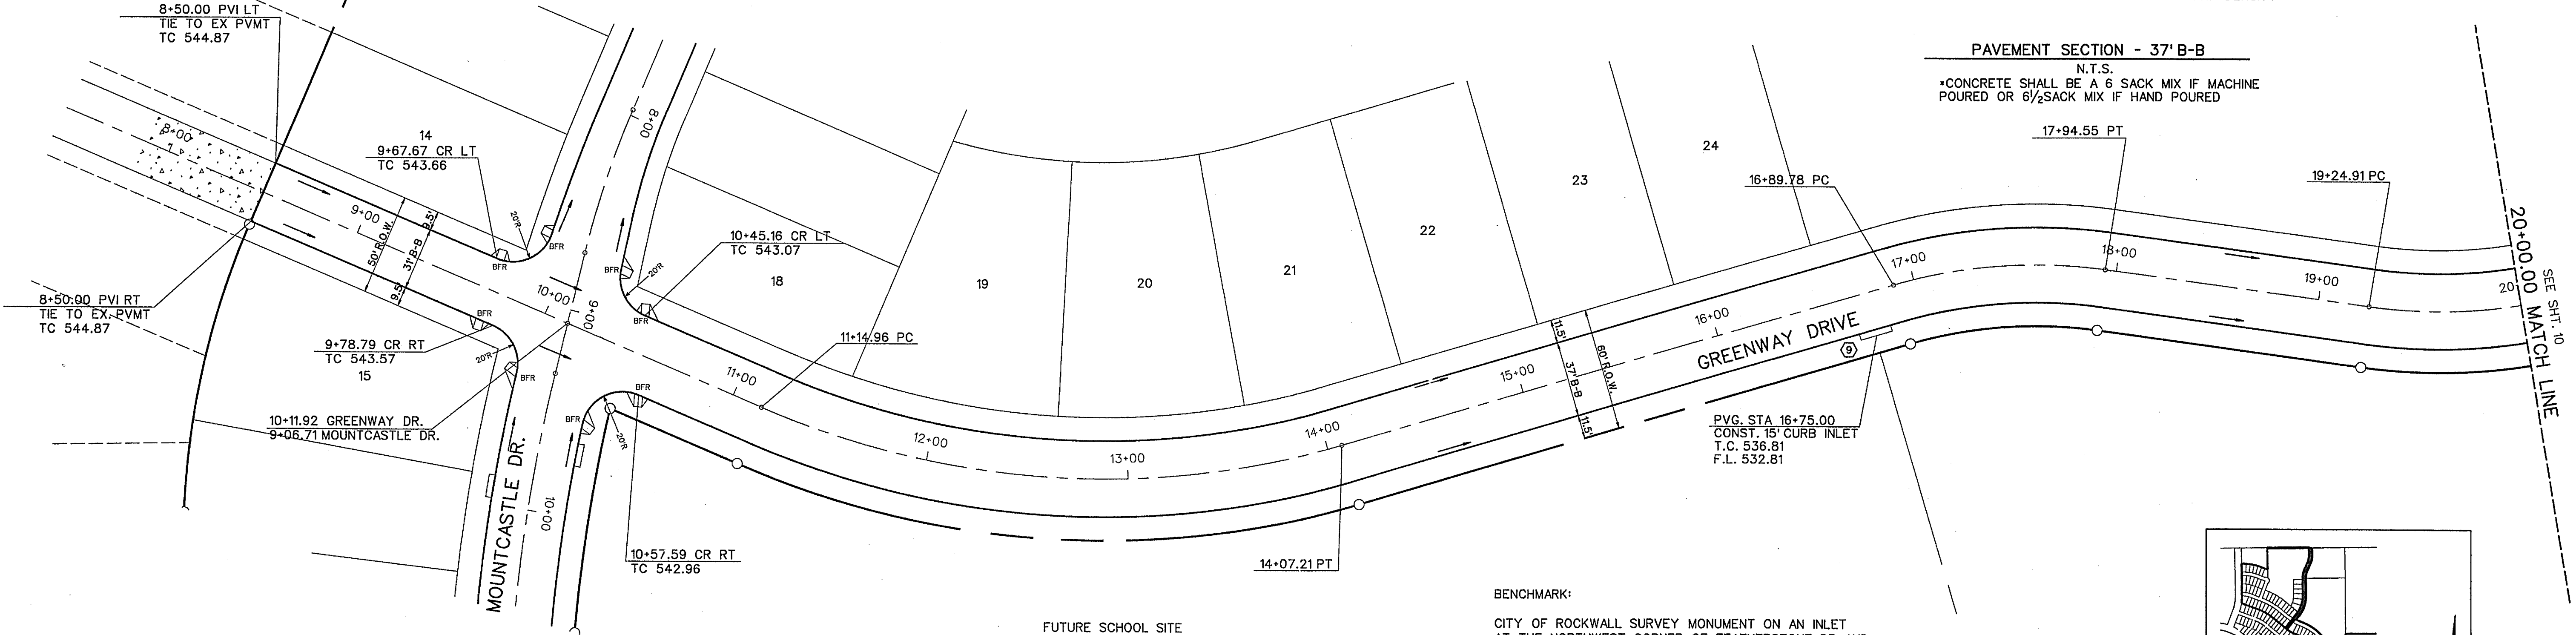

BENCHMARK:
CITY OF ROCKWALL SURVEY MONUMENT ON AN INLET AT THE NORTHWEST CORNER OF FEATHERSTONE DR. AND HARVARD DR. ELEV. - 525.31

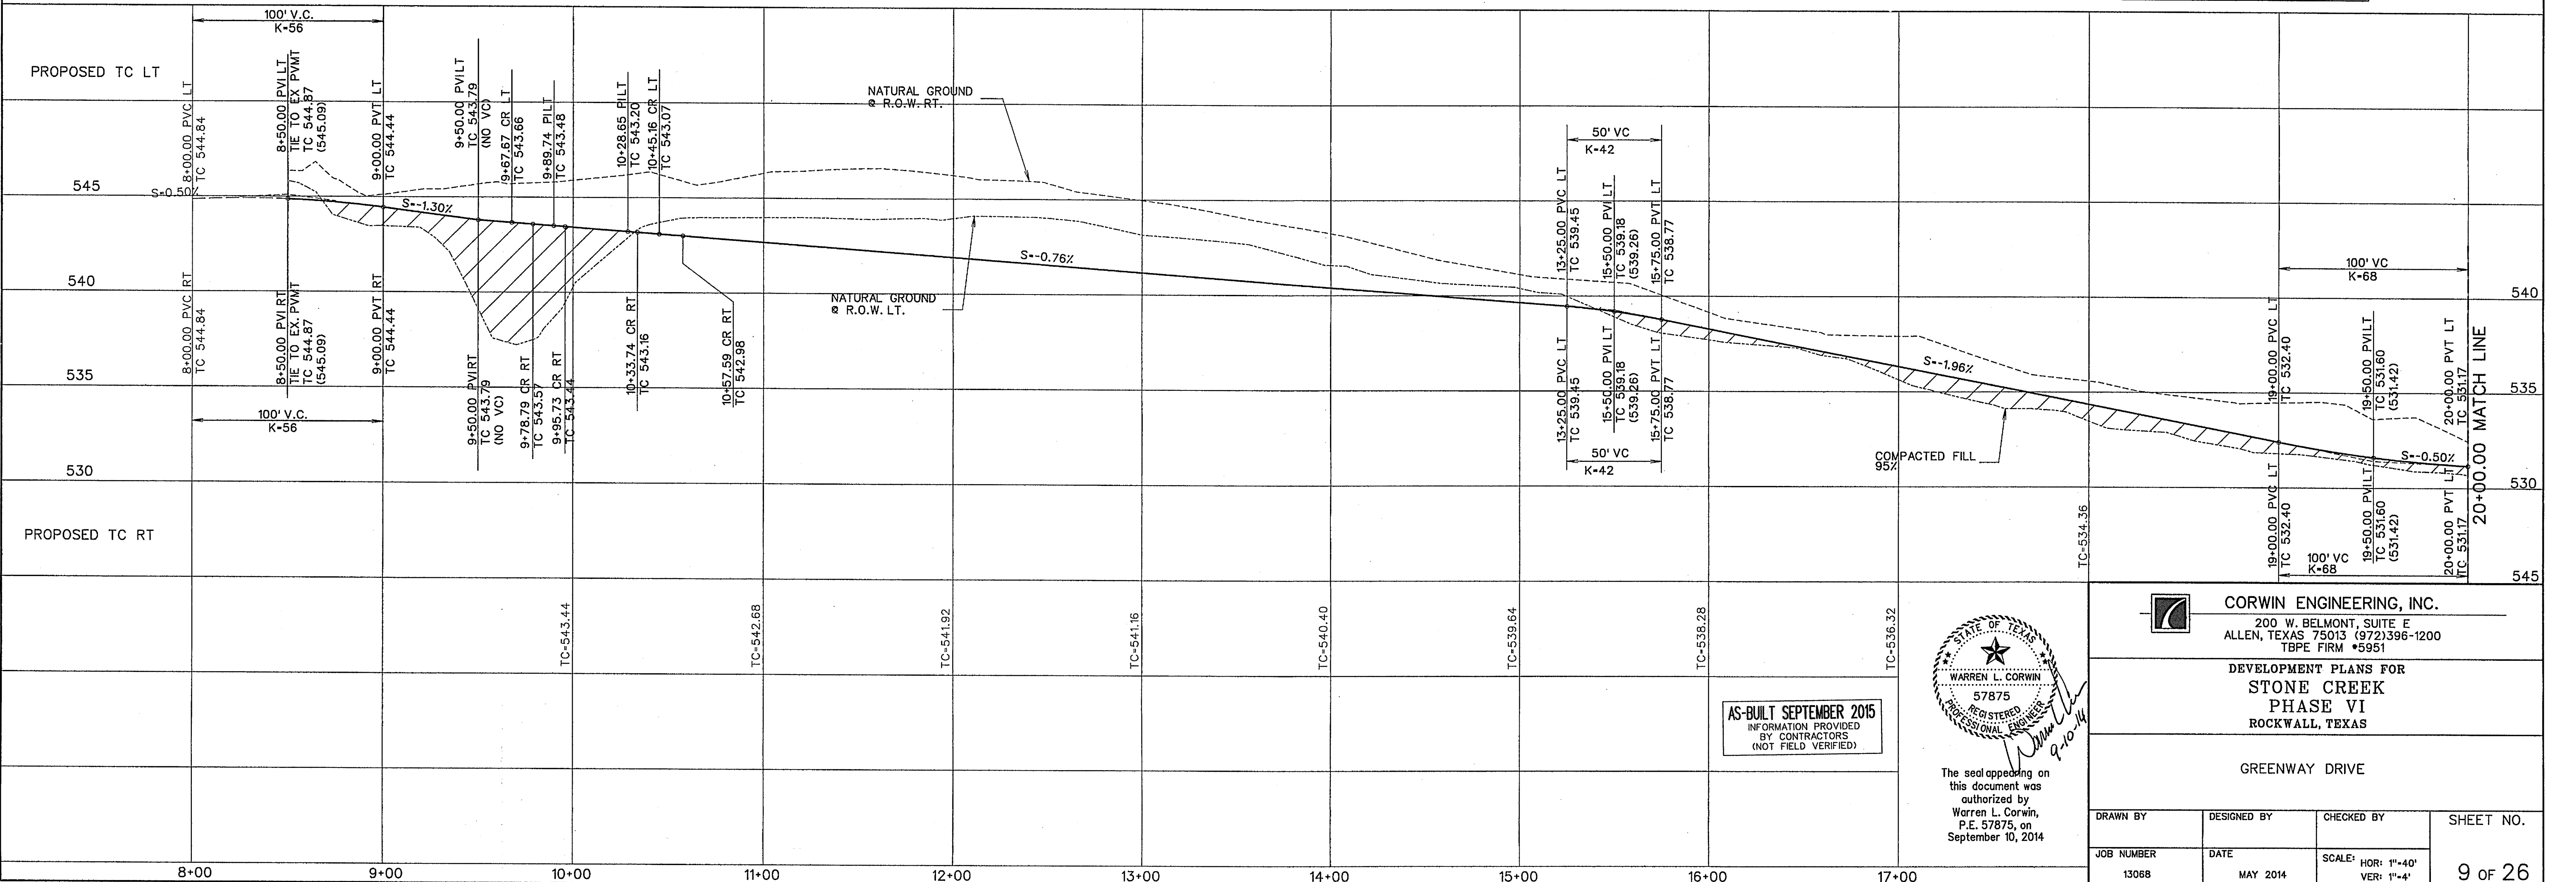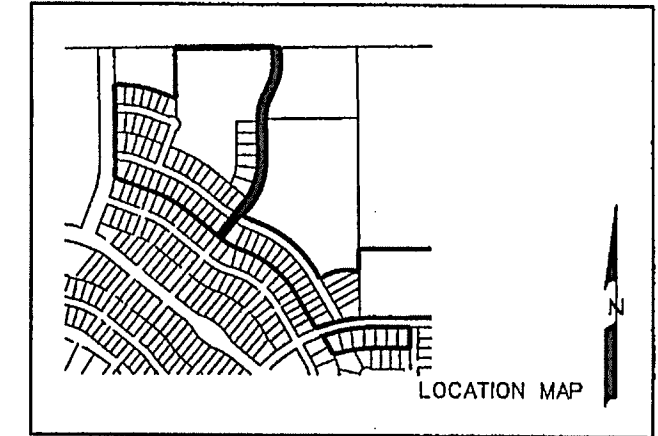

AS-BUILT SEPTEMBER 2015
INFORMATION PROVIDED BY CONTRACTORS (NOT FIELD VERIFIED)

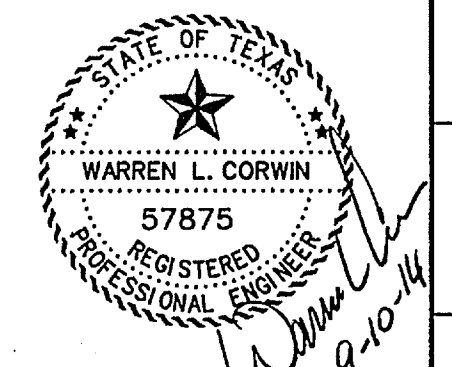

The seal appearing on this document was authorized by Warren L. Corwin, P.E. 57875, on September 10, 2014


CORWIN ENGINEERING, INC.
200 W. BELMONT, SUITE E
ALLEN, TEXAS 75013 (972) 396-1200
TBPE FIRM #5951

DEVELOPMENT PLANS FOR
STONE CREEK
PHASE VI
ROCKWALL, TEXAS



GREENWAY DRIVE

DRAWN BY	DESIGNED BY	CHECKED BY	SHEET NO.
JOB NUMBER	DATE	SCALE: HOR: 1"=40' VER: 1"=4'	9 OF 26
13068	MAY 2014		


SCALE: 1" = 40'

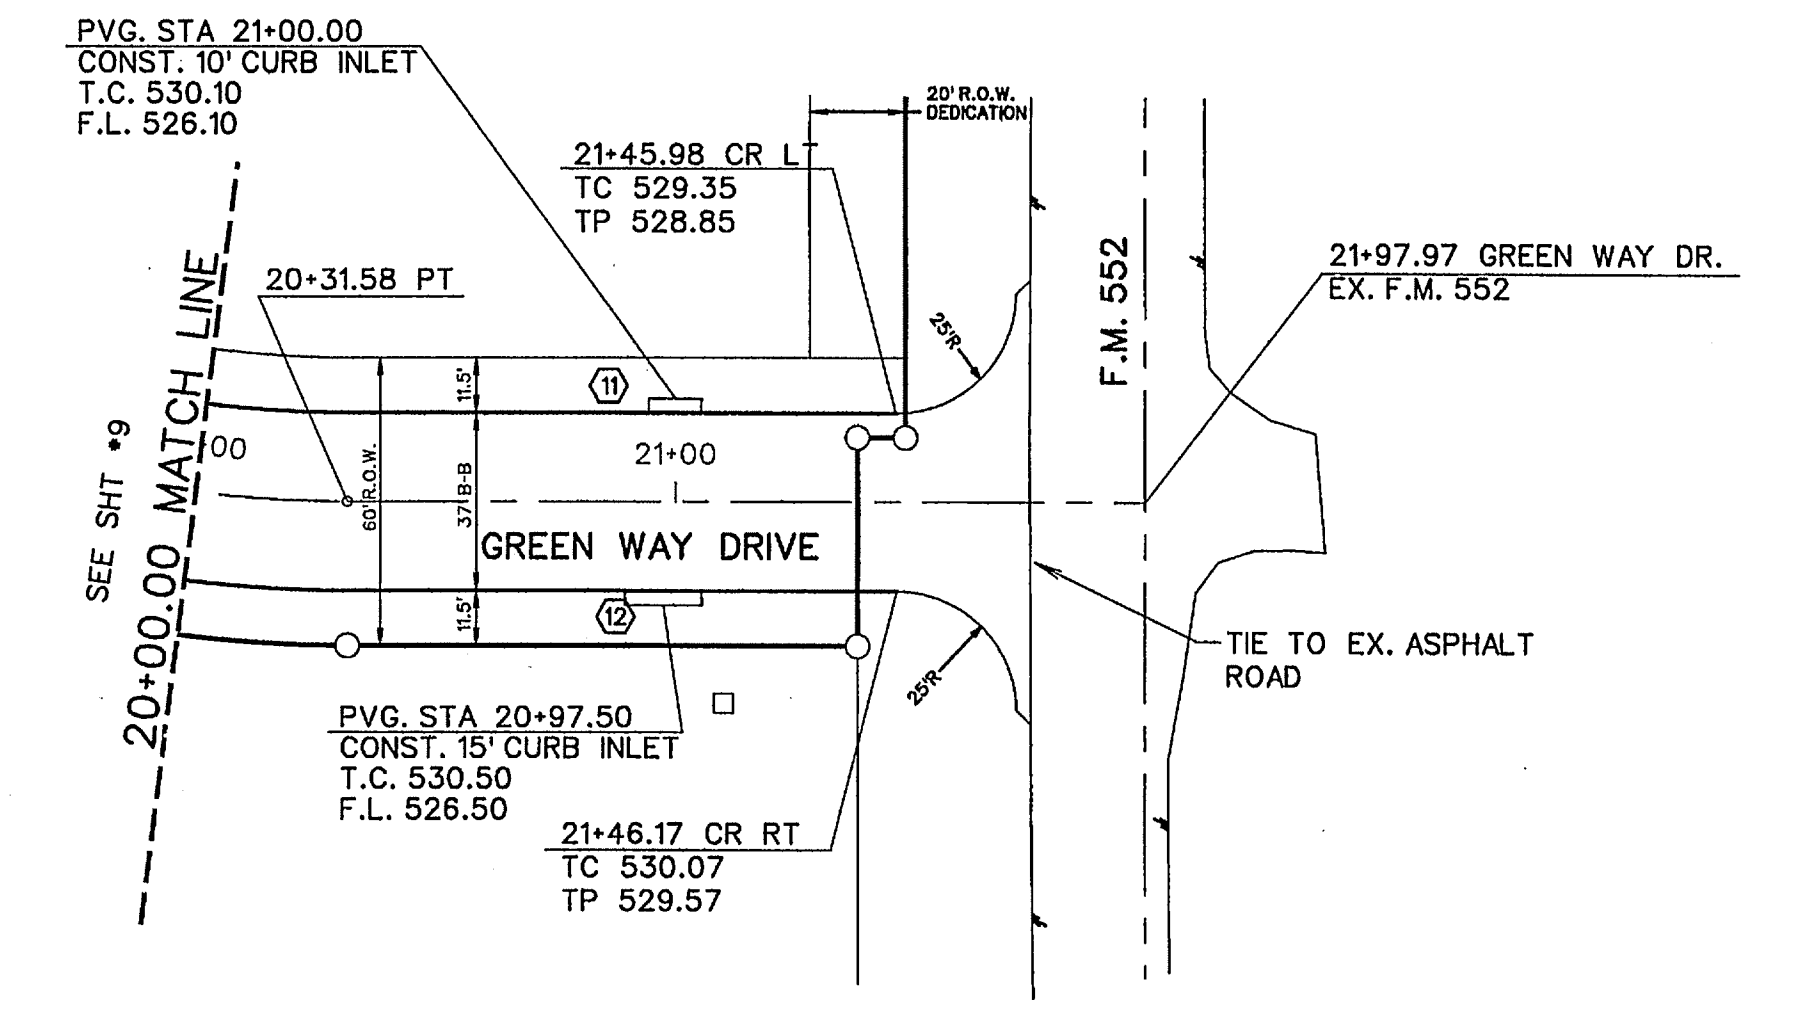

BENCHMARK:
 CITY OF ROCKWALL SURVEY MONUMENT ON AN INLET
 AT THE NORTHWEST CORNER OF FEATHERSTONE DR. AND
 HARVARD DR.
 ELEV. - 525.31

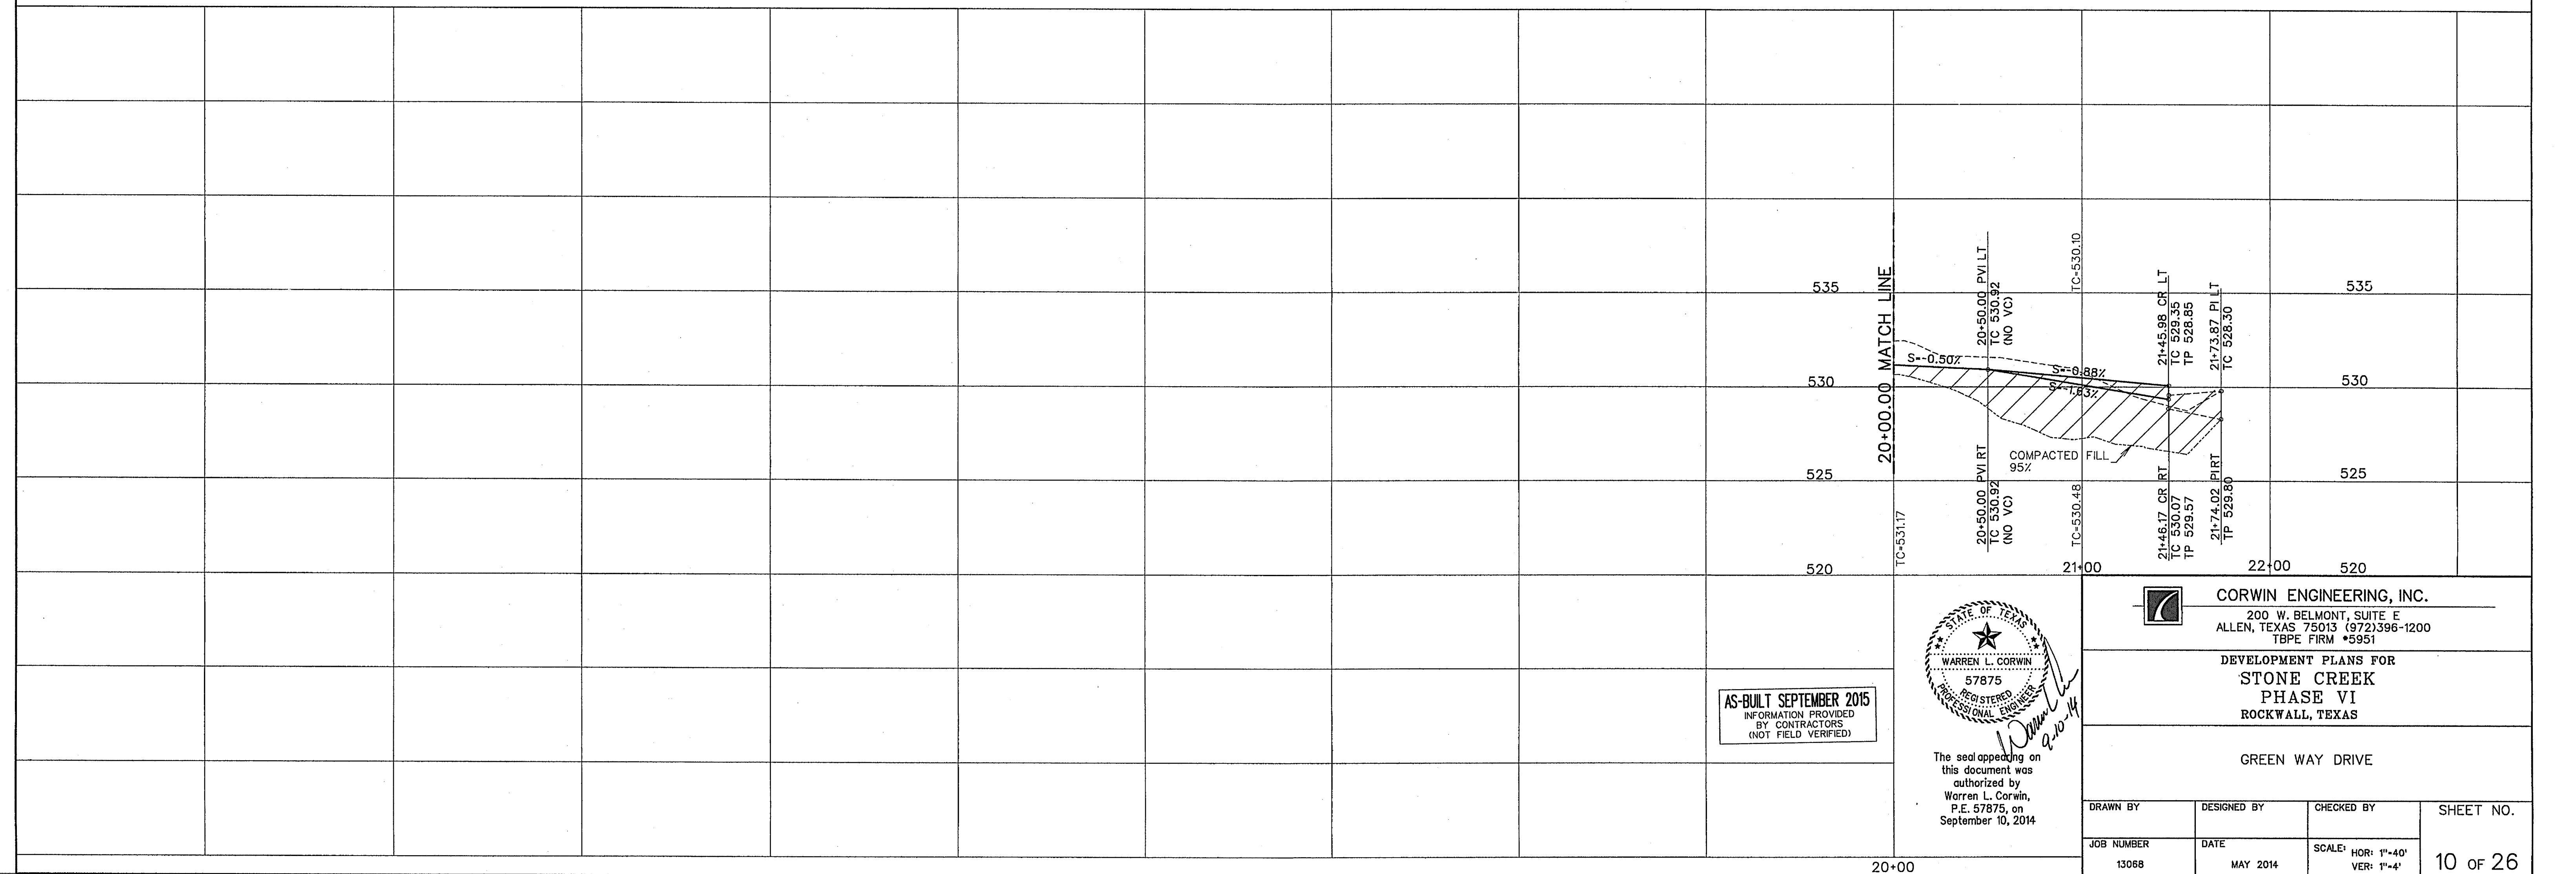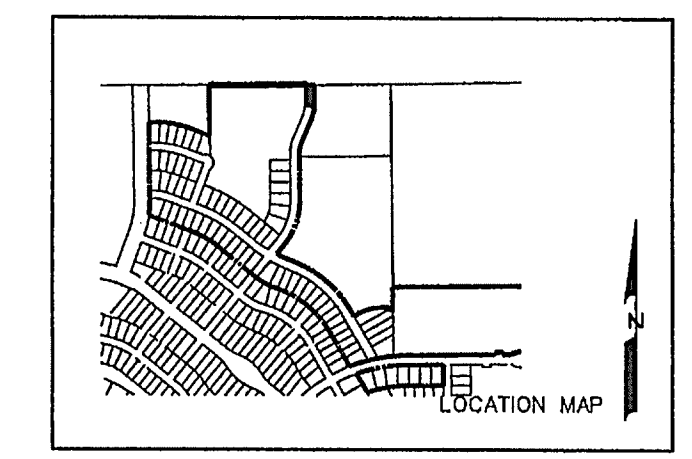

AS-BUILT SEPTEMBER 2015
 INFORMATION PROVIDED
 BY CONTRACTORS
 (NOT FIELD VERIFIED)

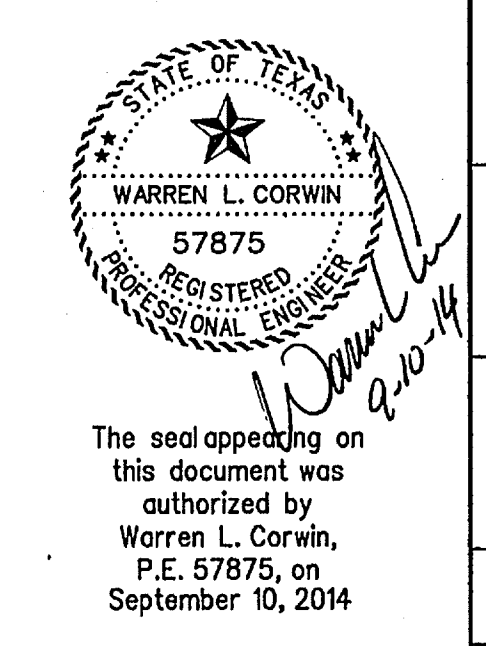



CORWIN ENGINEERING, INC.
 200 W. BELMONT, SUITE E
 ALLEN, TEXAS 75013 (972)396-1200
 TBPE FIRM #5951

DEVELOPMENT PLANS FOR
STONE CREEK
 PHASE VI
 ROCKWALL, TEXAS






GREEN WAY DRIVE

DRAWN BY	DESIGNED BY	CHECKED BY	SHEET NO.
JOB NUMBER	DATE	SCALE: HOR: 1"=40' VER: 1"=4'	10 of 26
13068	MAY 2014		

20+00

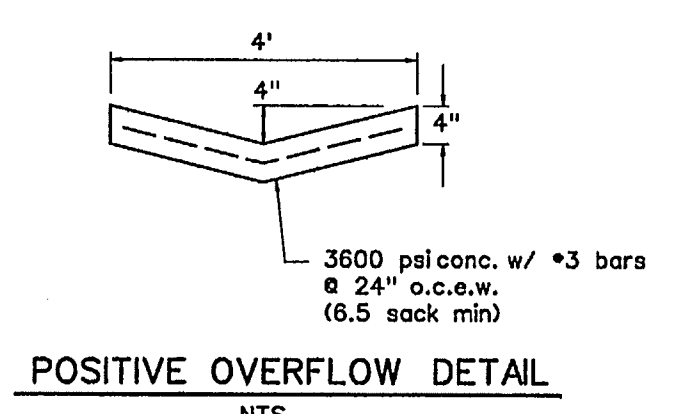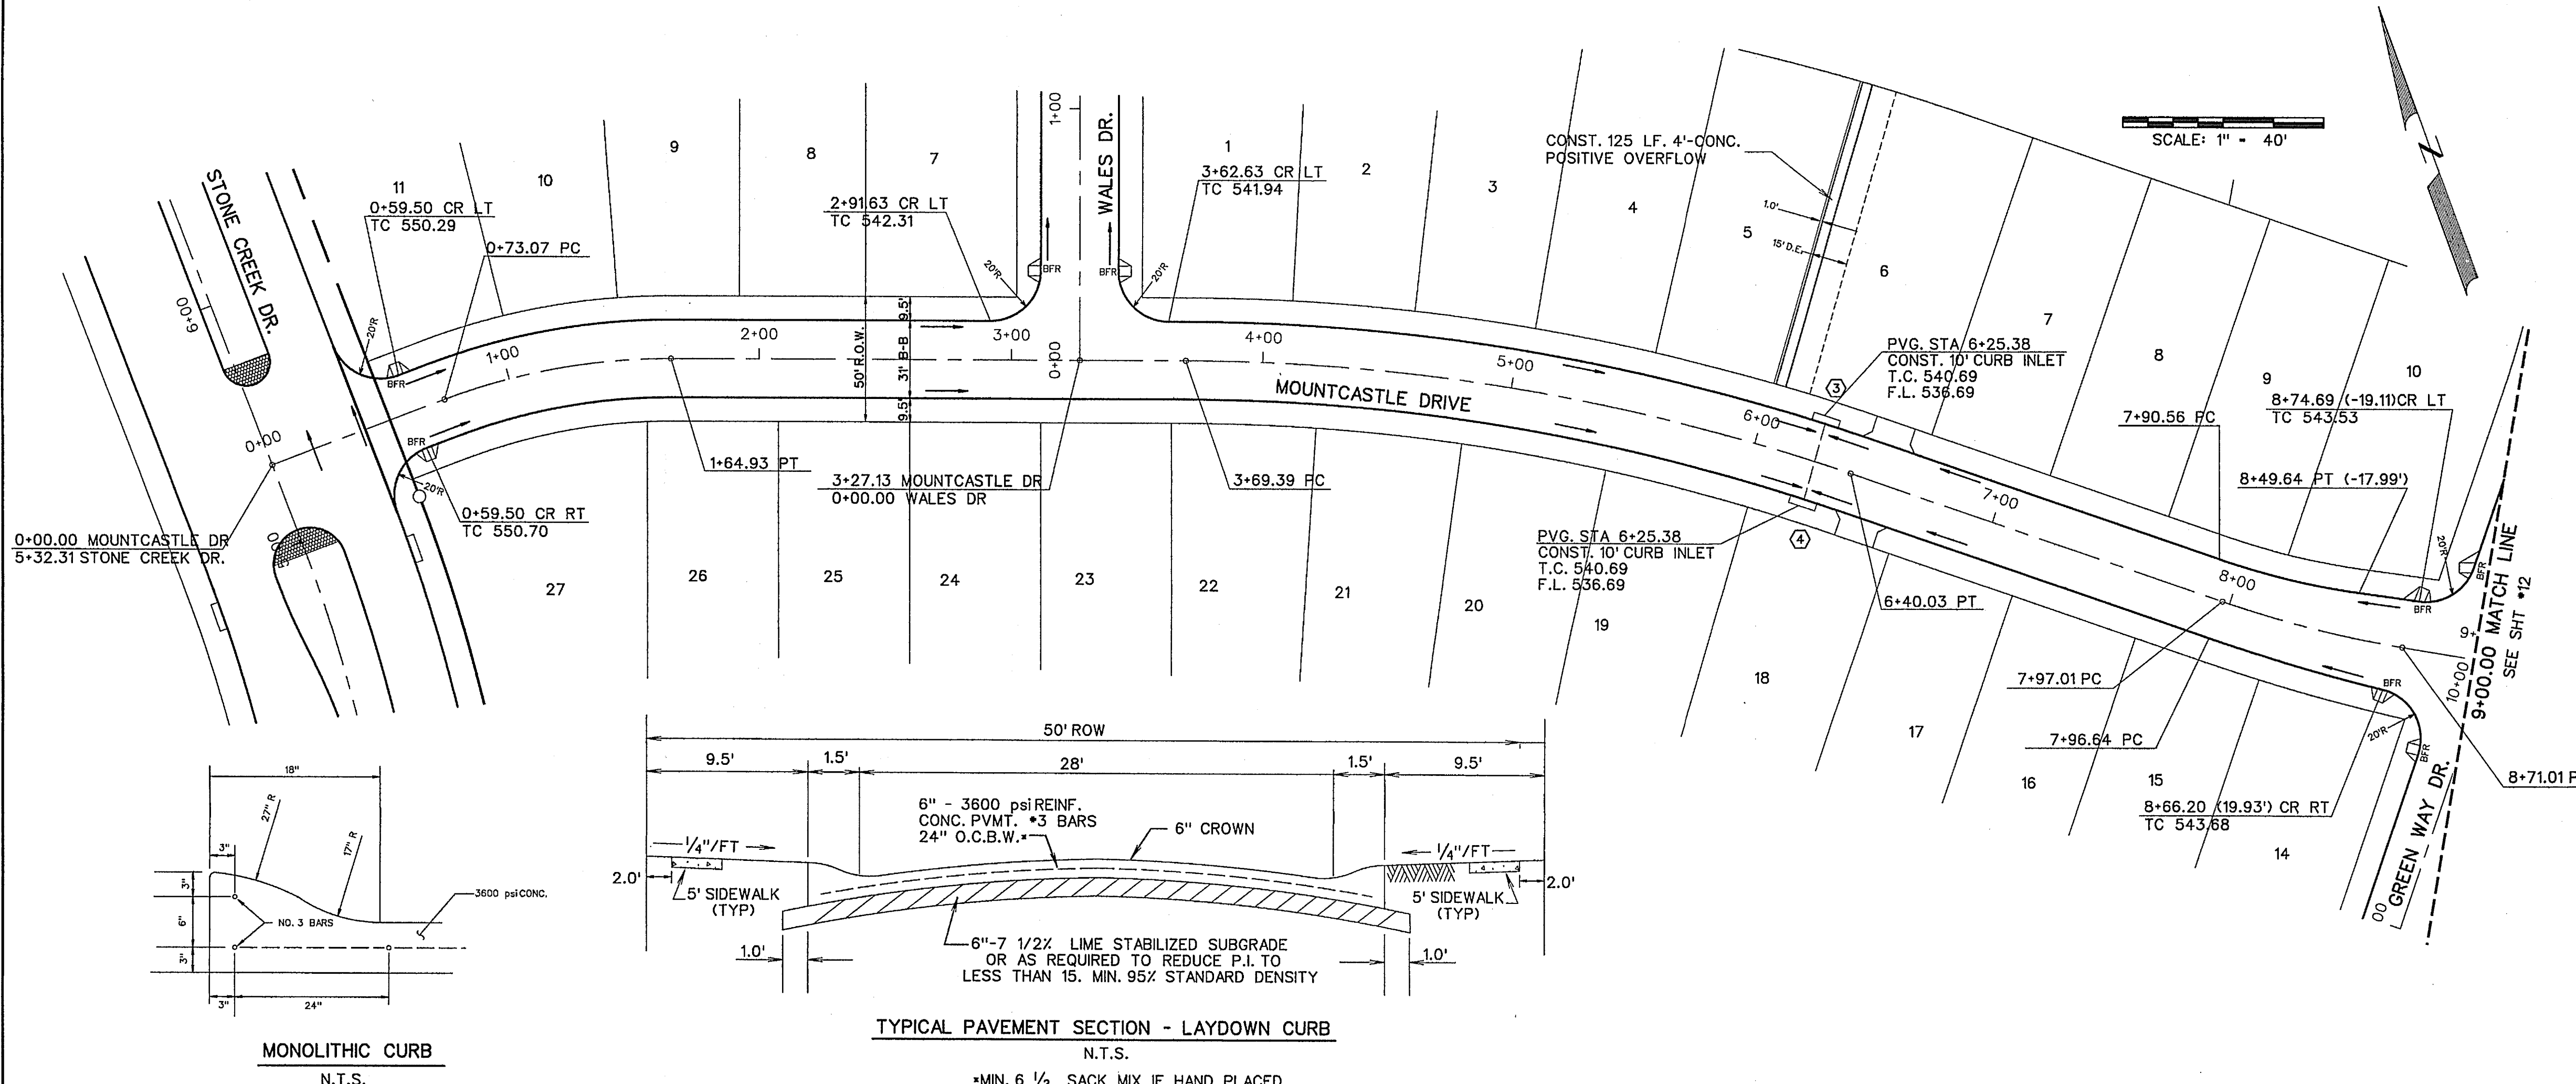

BENCHMARK:
CITY OF ROCKWALL SURVEY MONUMENT ON AN INLET
AT THE NORTHWEST CORNER OF FEATHERSTONE DR. AND
HARVARD DR.
ELEV. = 525.31

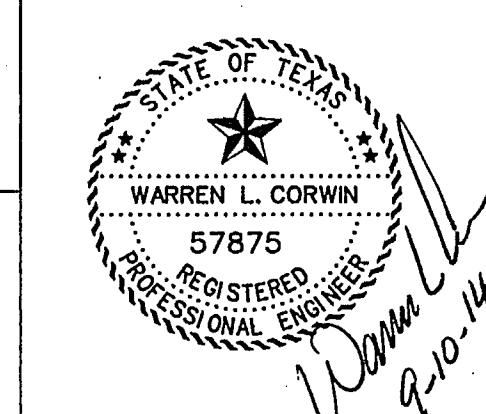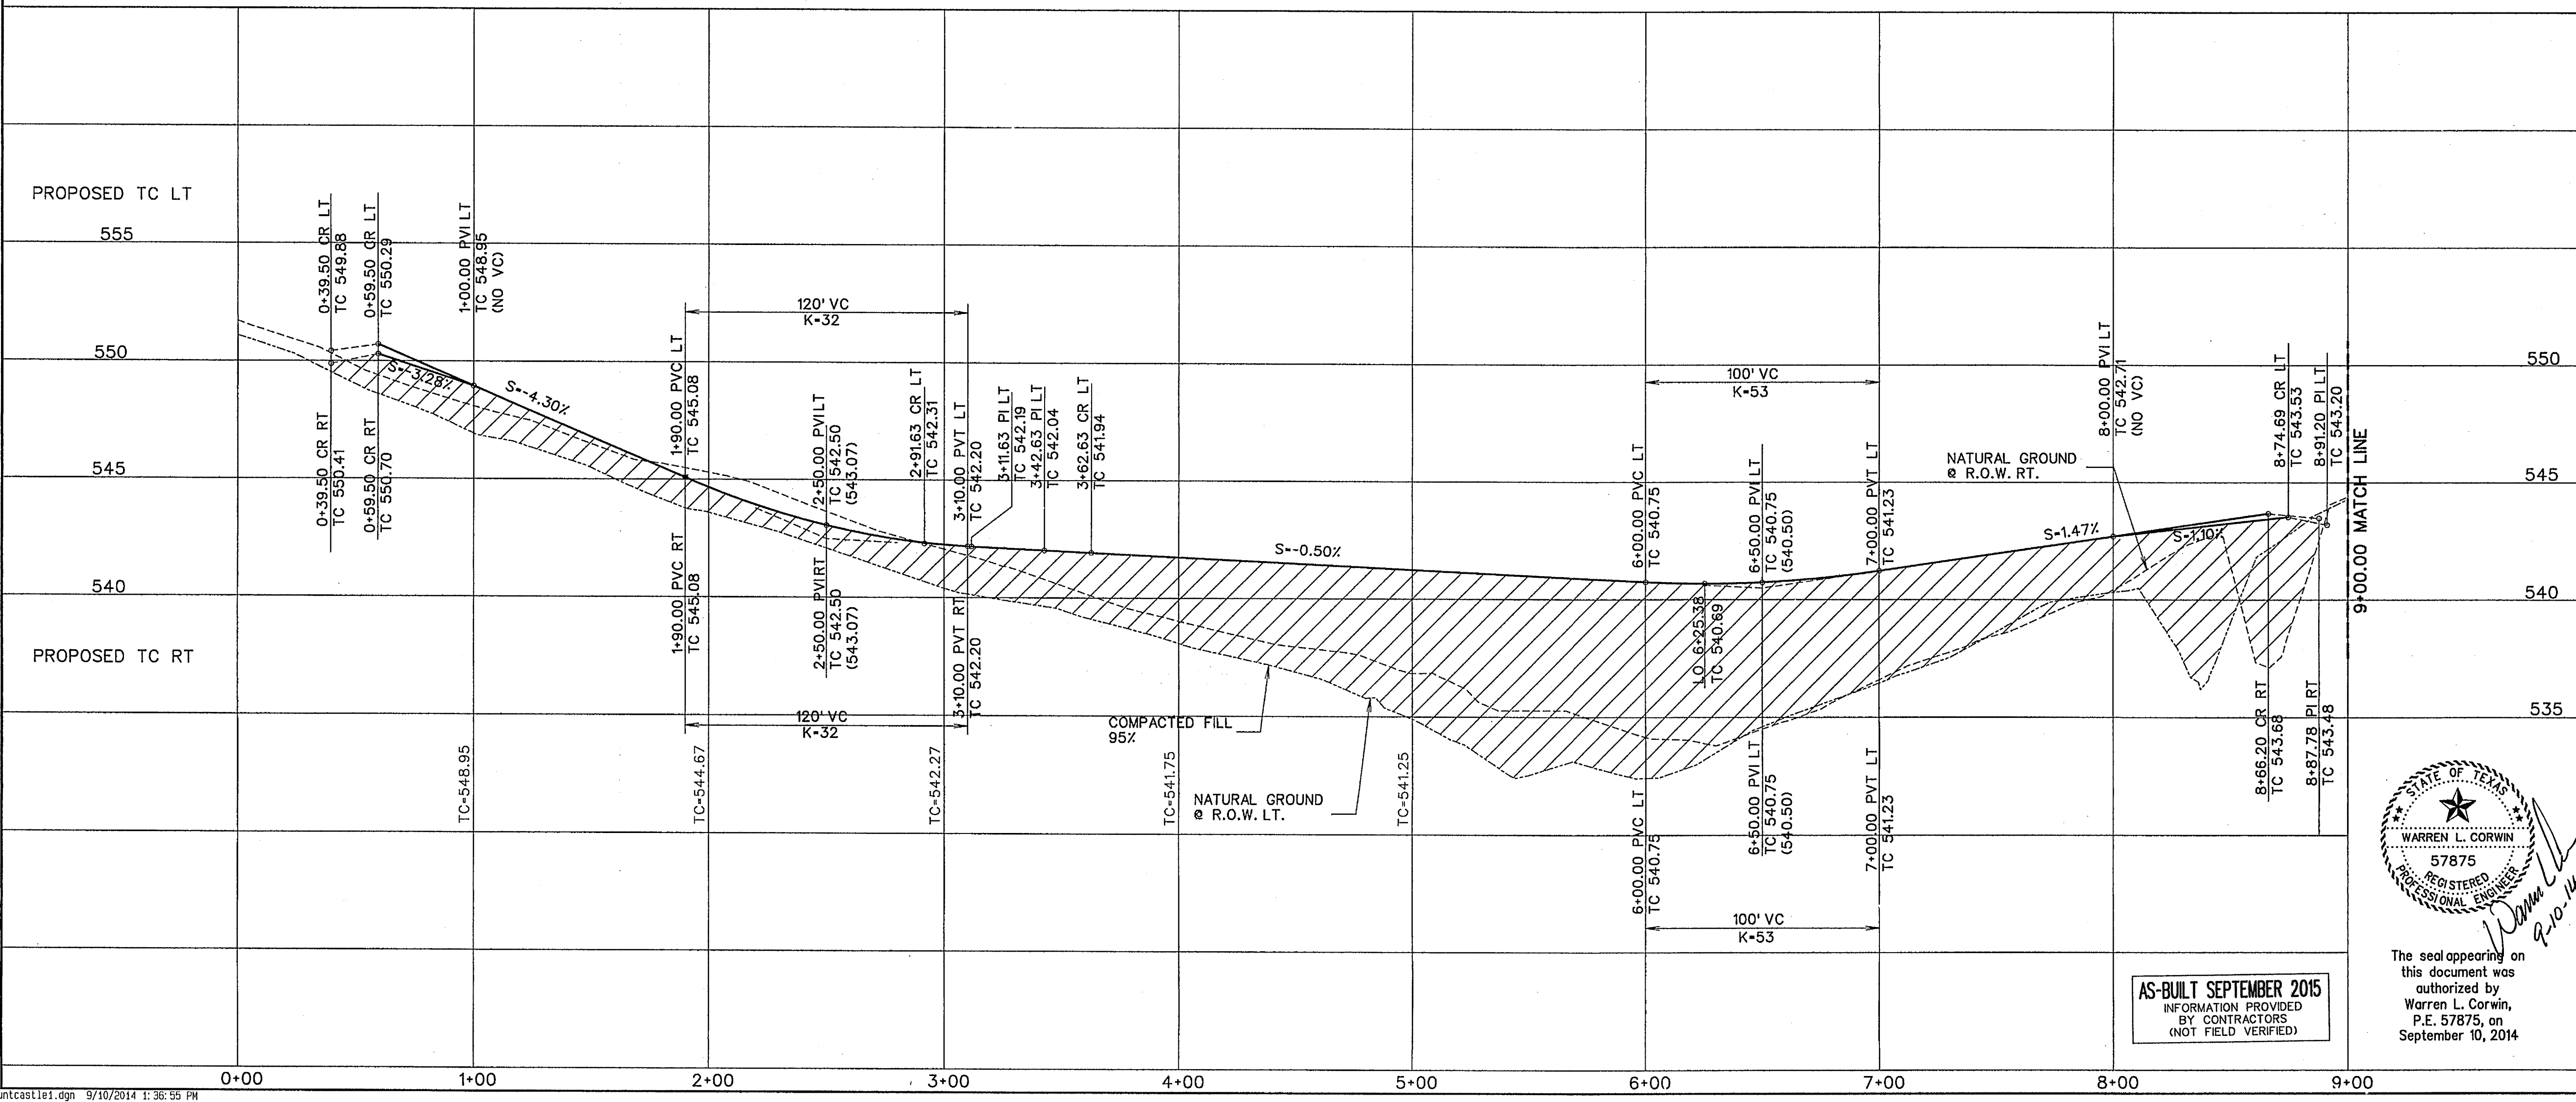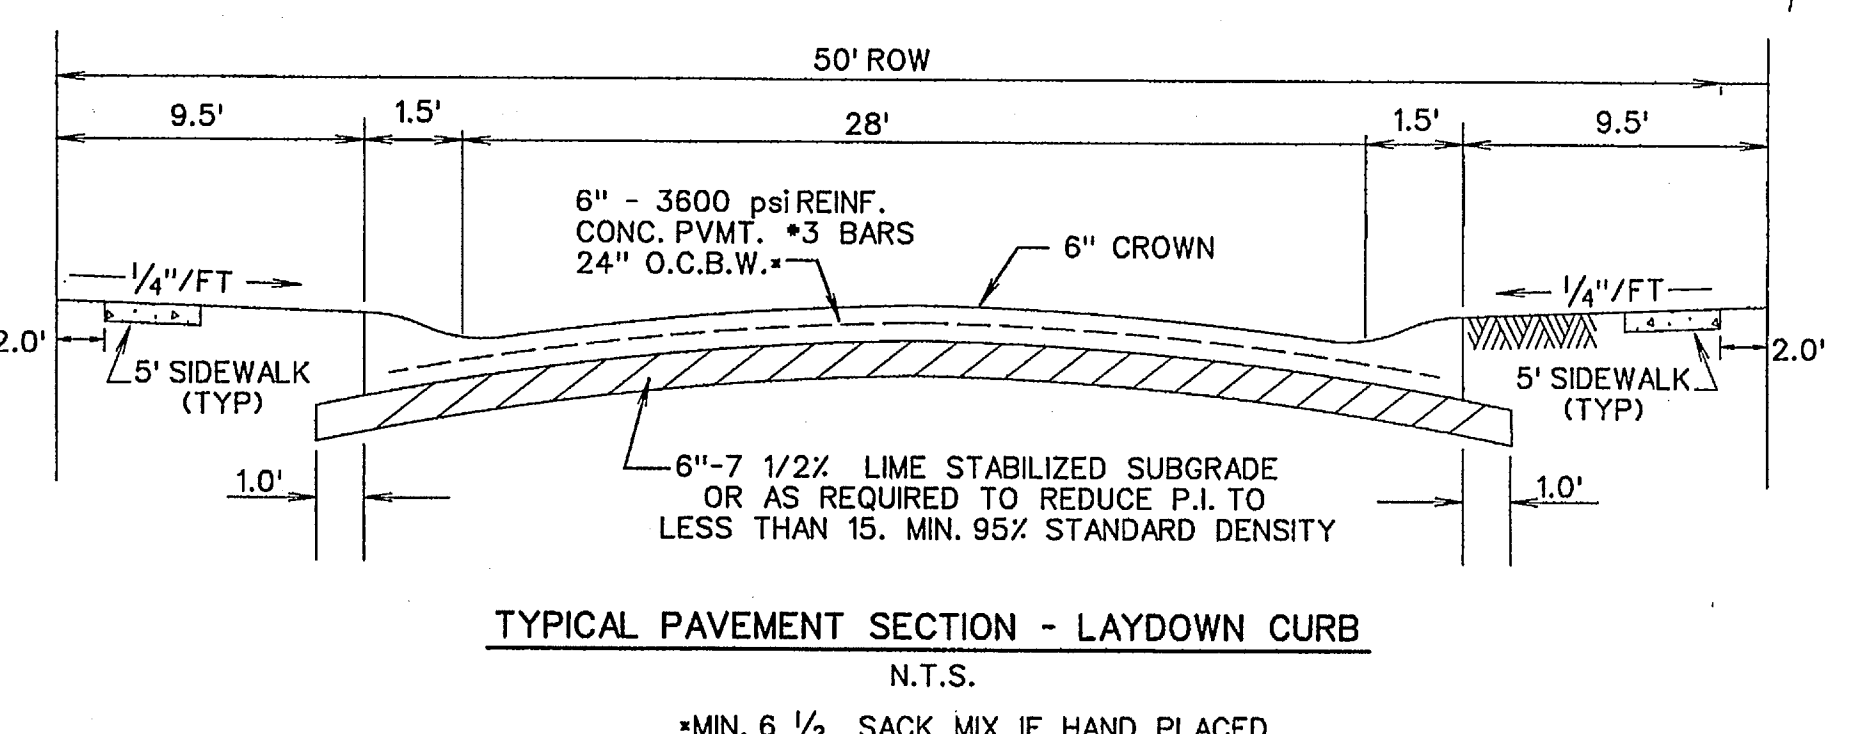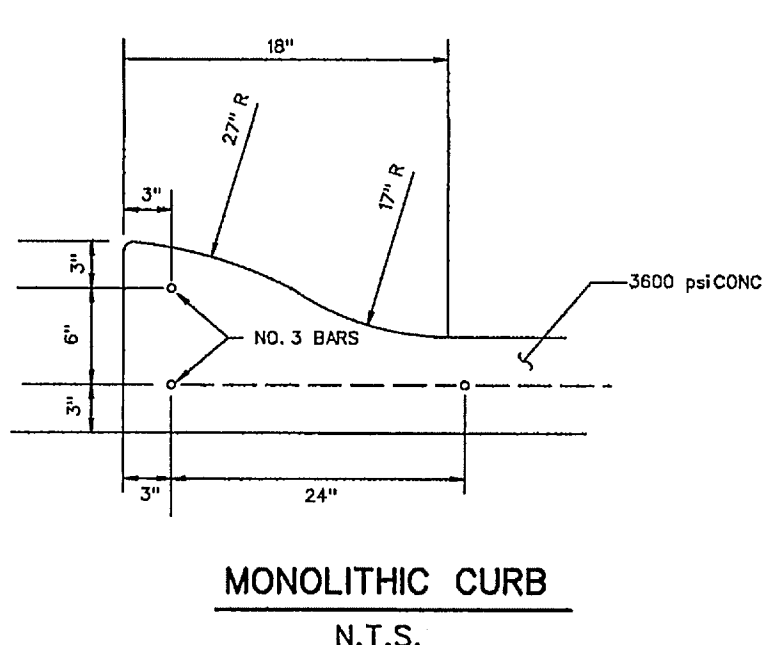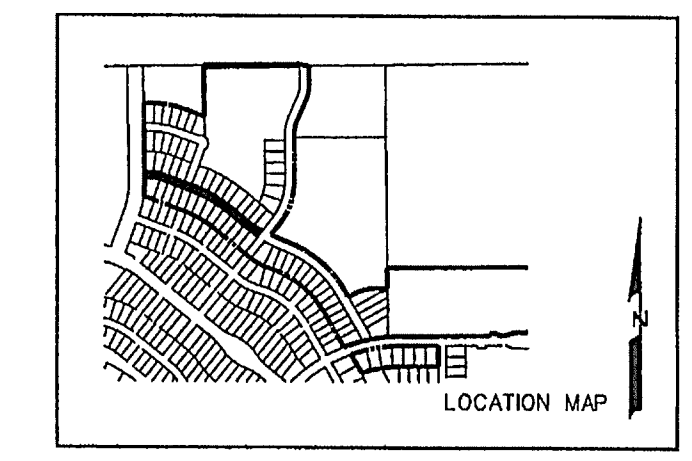

The seal appearing on this document was authorized by Warren L. Corwin, P.E. 57875, on September 10, 2014.



AS-BUILT SEPTEMBER 2015
INFORMATION PROVIDED BY CONTRACTORS (NOT FIELD VERIFIED)

CORWIN ENGINEERING, INC.
200 W. BELMONT, SUITE E
ALLEN, TEXAS 75013 (972)396-1200
TBPE FIRM #5951



DEVELOPMENT PLANS FOR
**STONE CREEK
PHASE VI**
ROCKWALL, TEXAS

MOUNTCASTLE DRIVE


DRAWN BY	DESIGNED BY	CHECKED BY	SHEET NO.
JOB NUMBER	DATE	SCALE: HOR: 1"=40' VER: 1"=4'	11 OF 26
13068	MAY 2014		

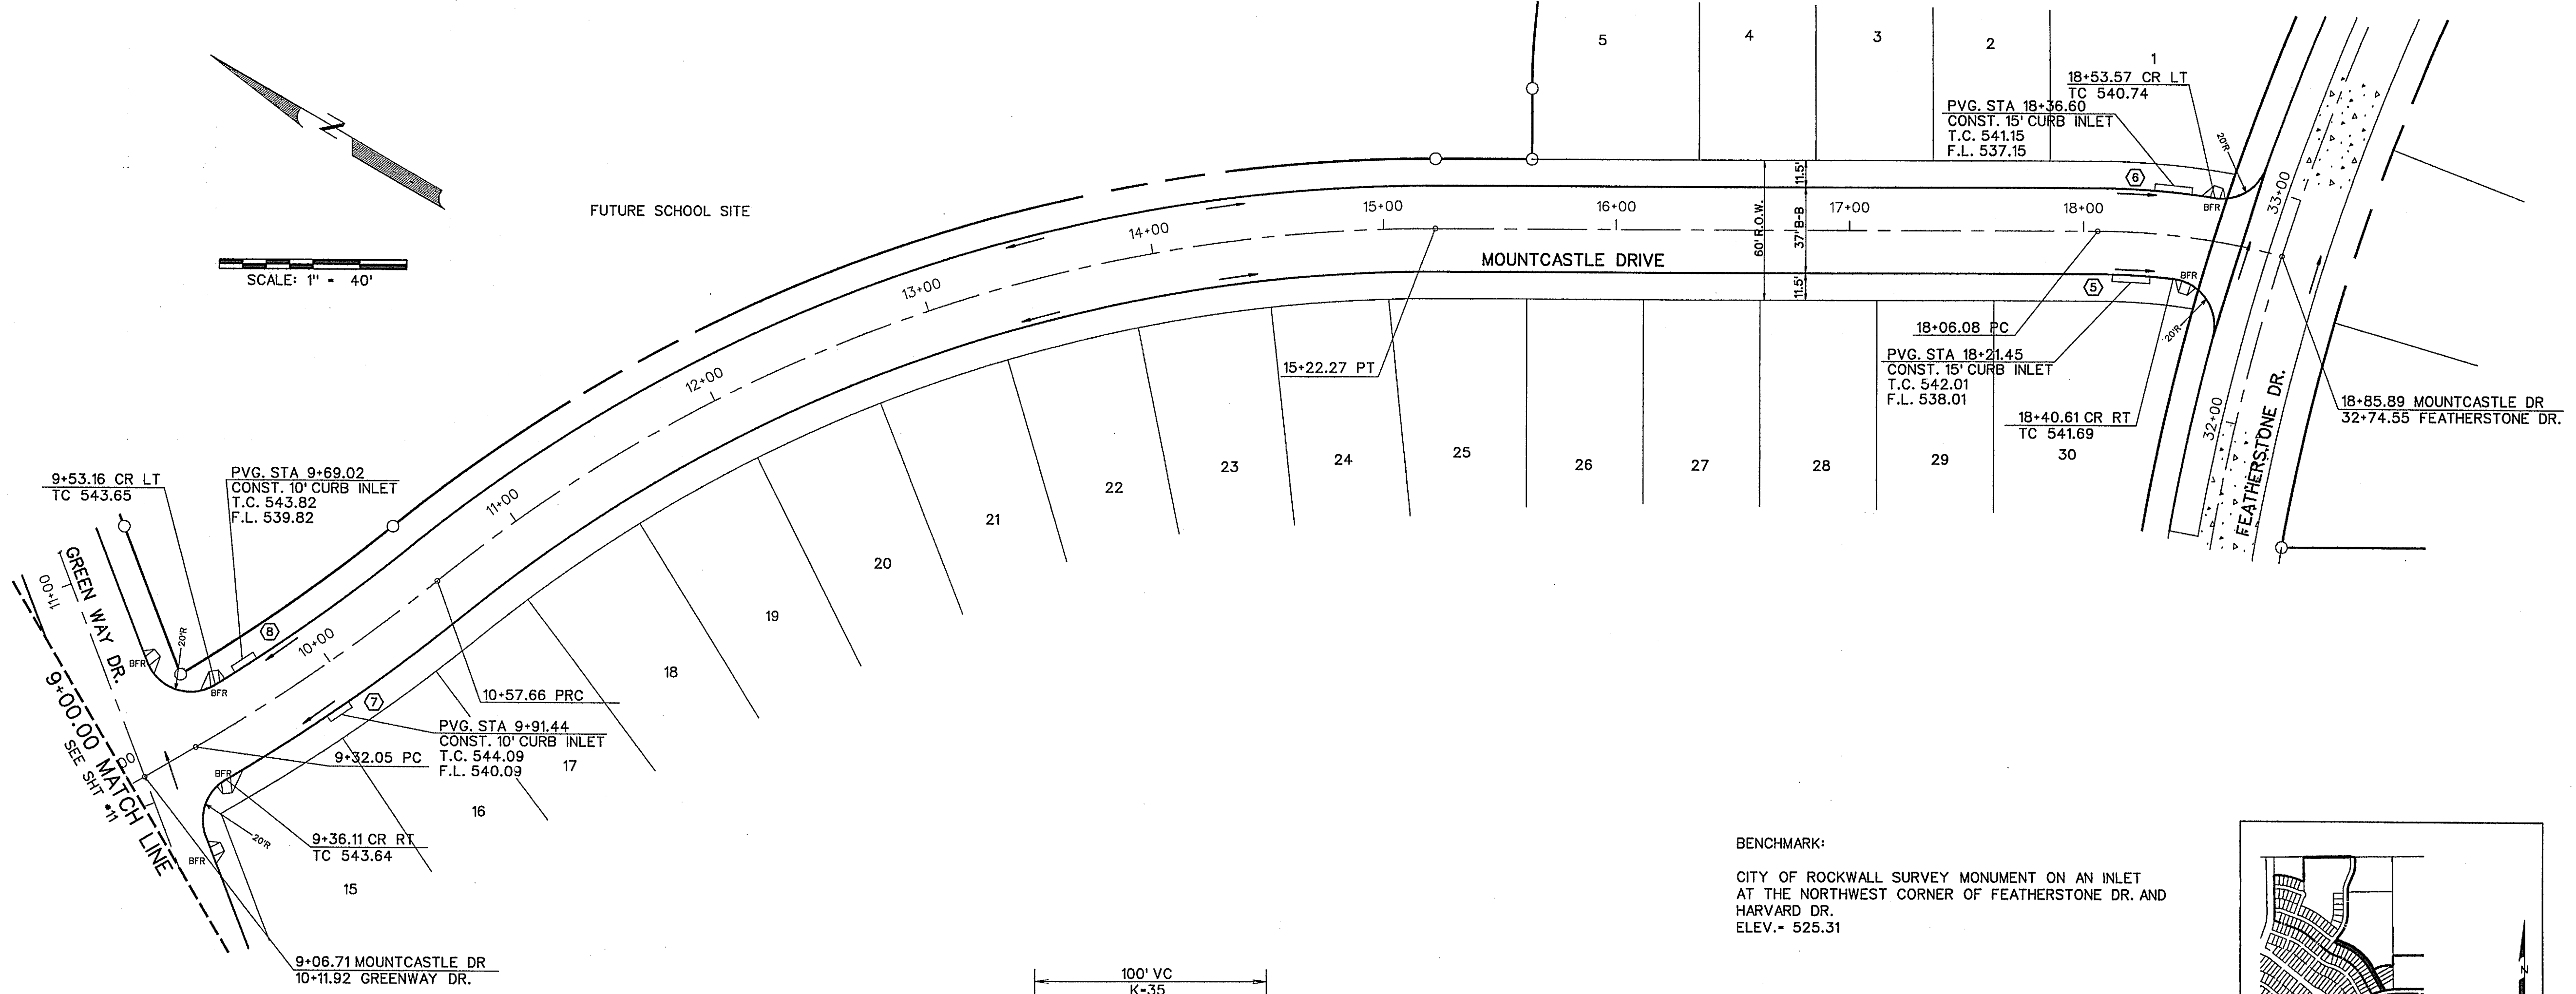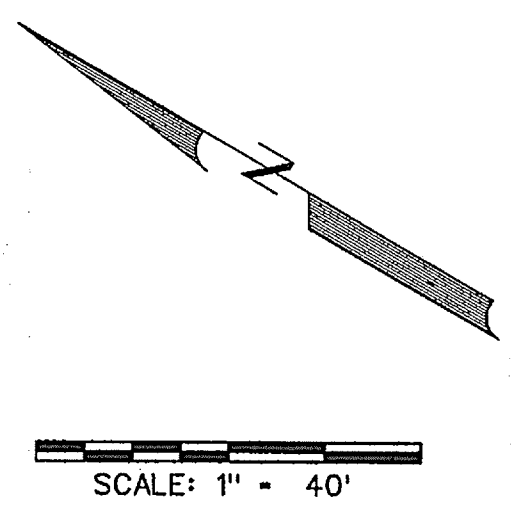

BENCHMARK:
 CITY OF ROCKWALL SURVEY MONUMENT ON AN INLET
 AT THE NORTHWEST CORNER OF FEATHERSTONE DR. AND
 HARVARD DR.
 ELEV. = 525.31

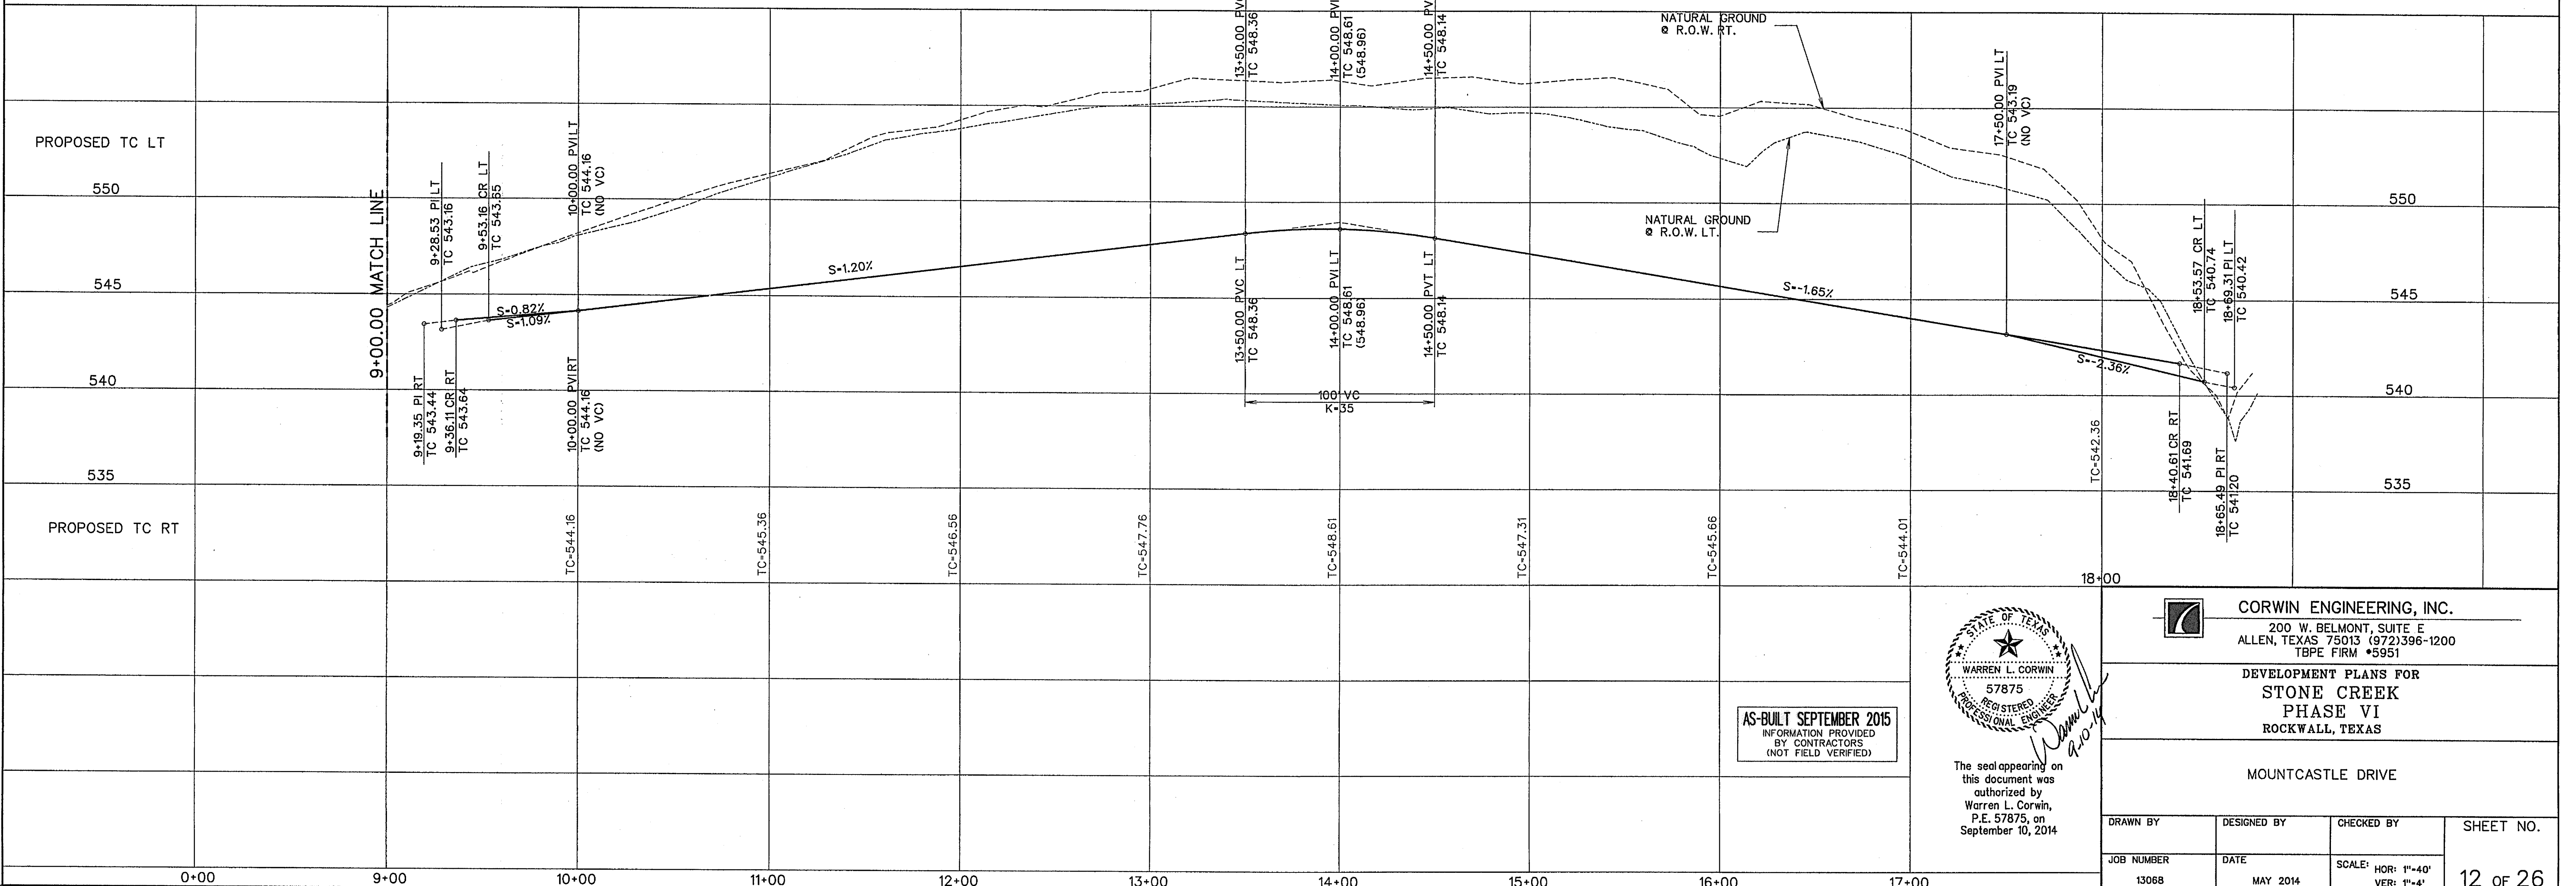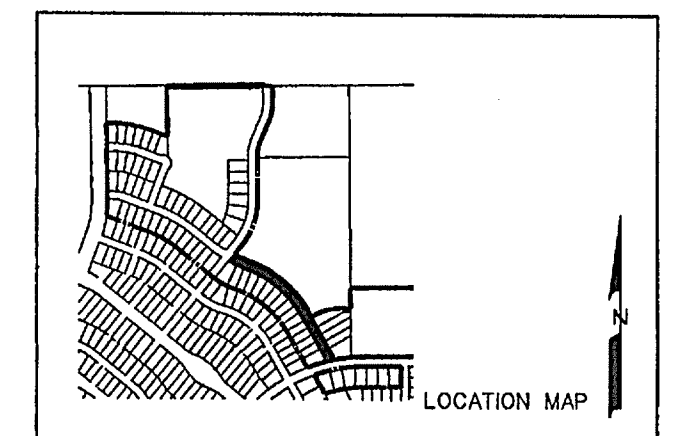

AS-BUILT SEPTEMBER 2015
 INFORMATION PROVIDED
 BY CONTRACTORS
 (NOT FIELD VERIFIED)

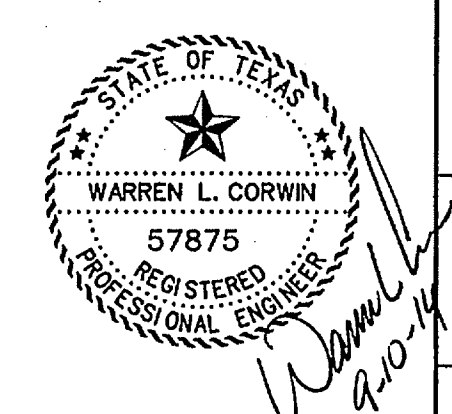



The seal appearing on
 this document was
 authorized by
 Warren L. Corwin,
 P.E. 57875, on
 September 10, 2014


CORWIN ENGINEERING, INC.
 200 W. BELMONT, SUITE E
 ALLEN, TEXAS 75013 (972)396-1200
 TBPE FIRM #5951

DEVELOPMENT PLANS FOR
**STONE CREEK
 PHASE VI**
 ROCKWALL, TEXAS




MOUNTCASTLE DRIVE

DRAWN BY	DESIGNED BY	CHECKED BY	SHEET NO.
JOB NUMBER	DATE	SCALE: HOR: 1"=40' VER: 1"=4'	12 OF 26
13068	MAY 2014		

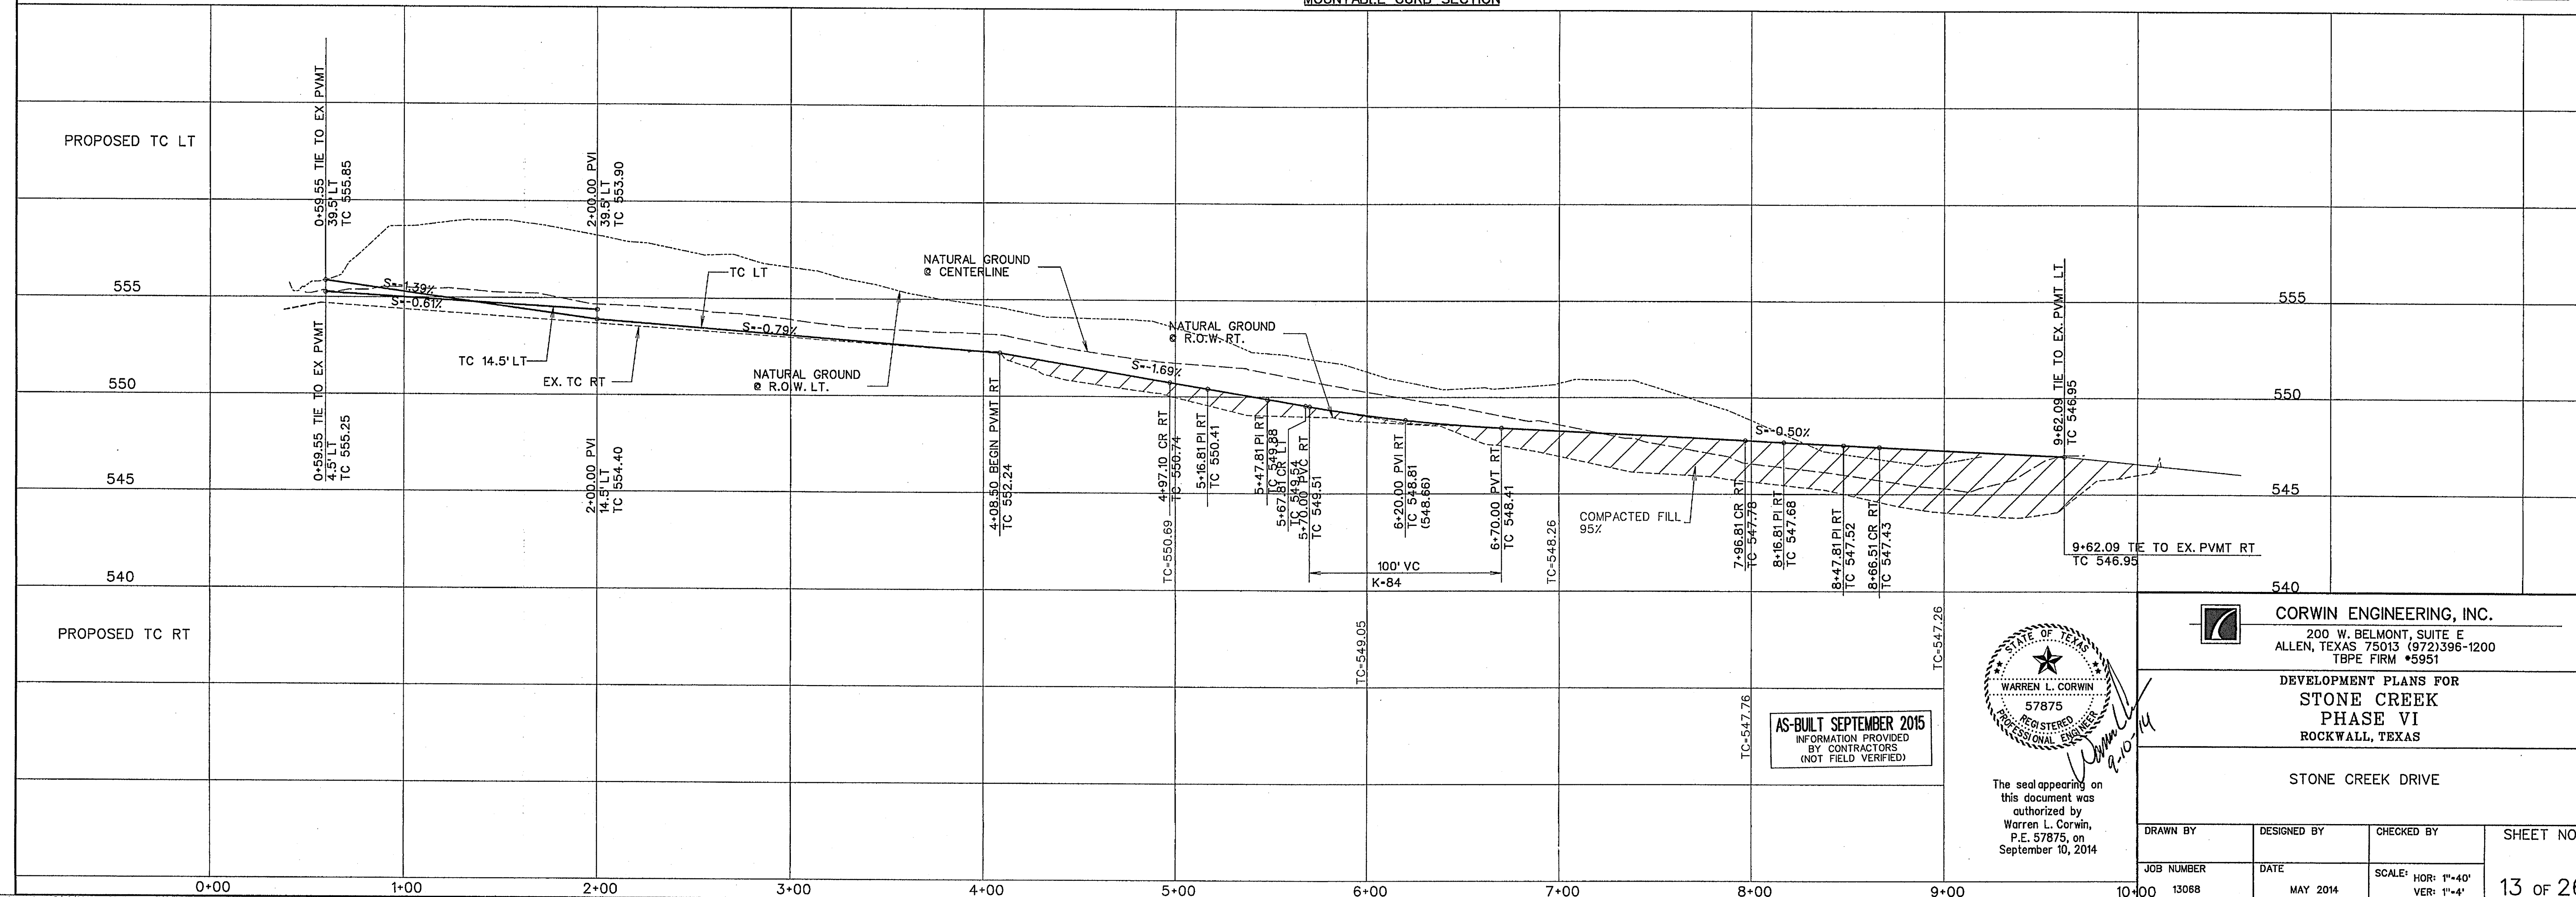
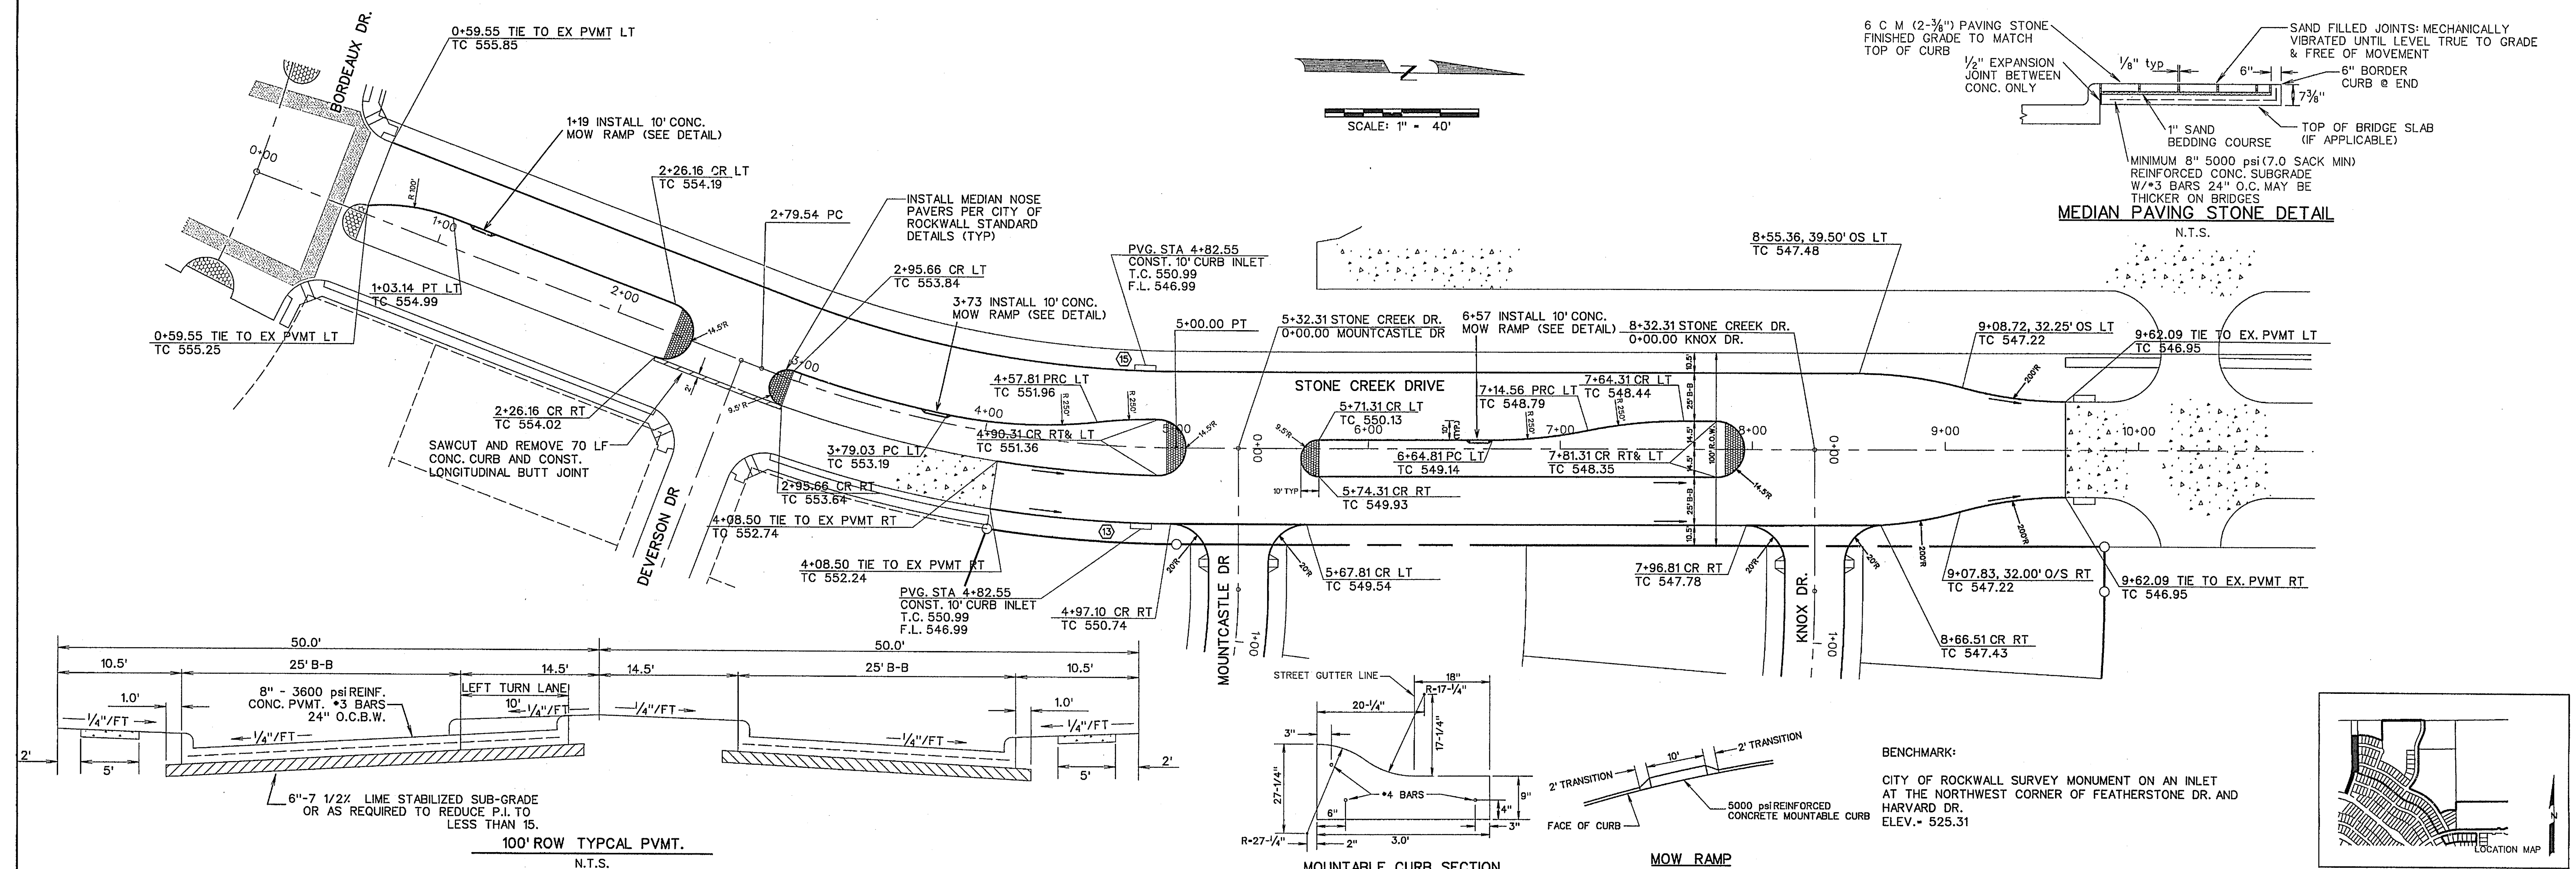


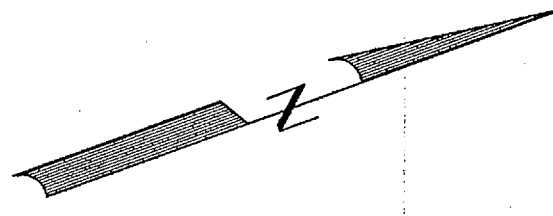

SCALE: 1" = 40'

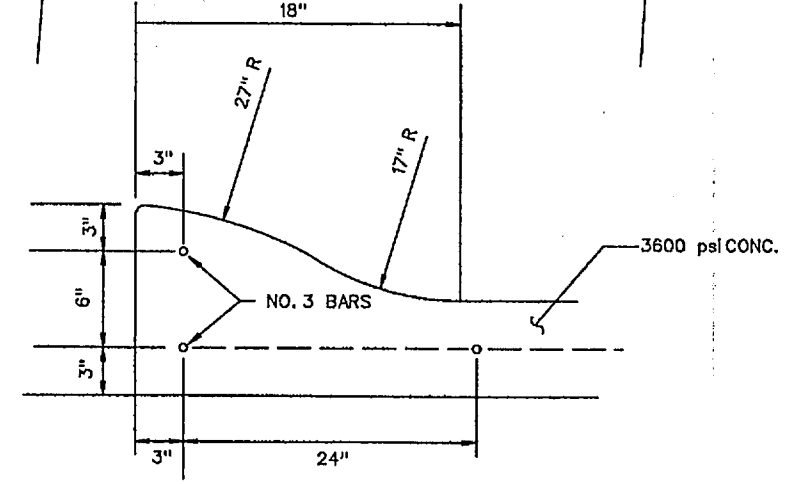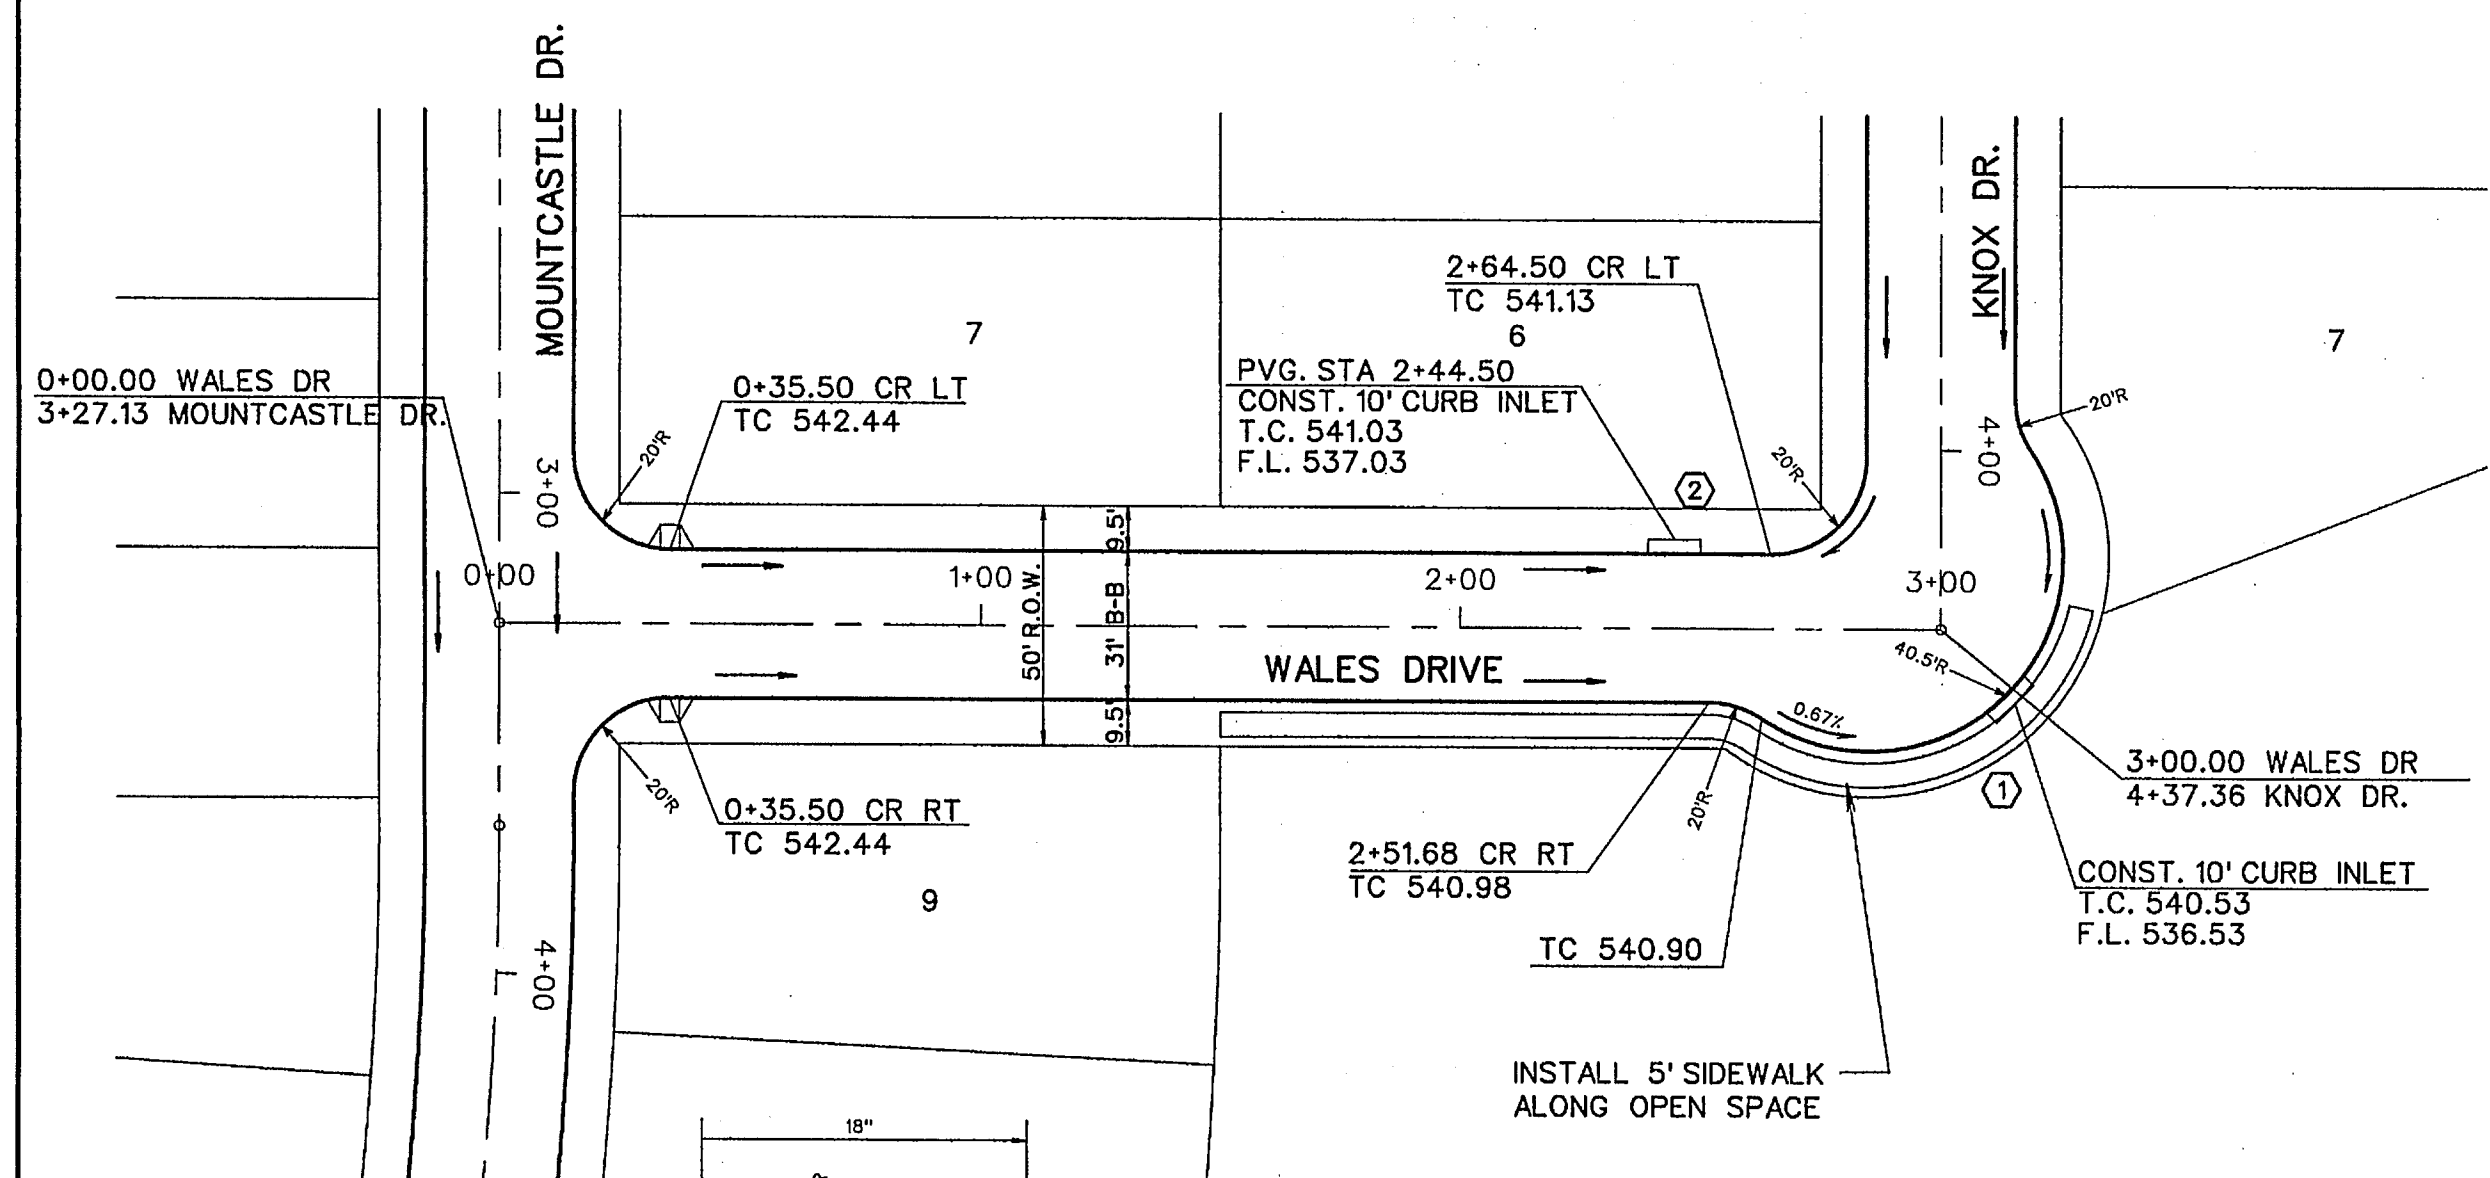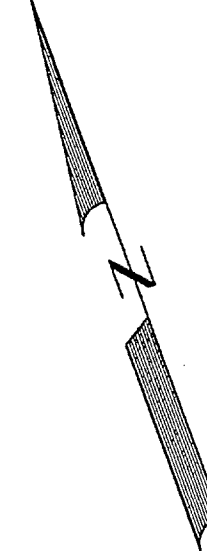


MONOLITHIC CURB
N.T.S.

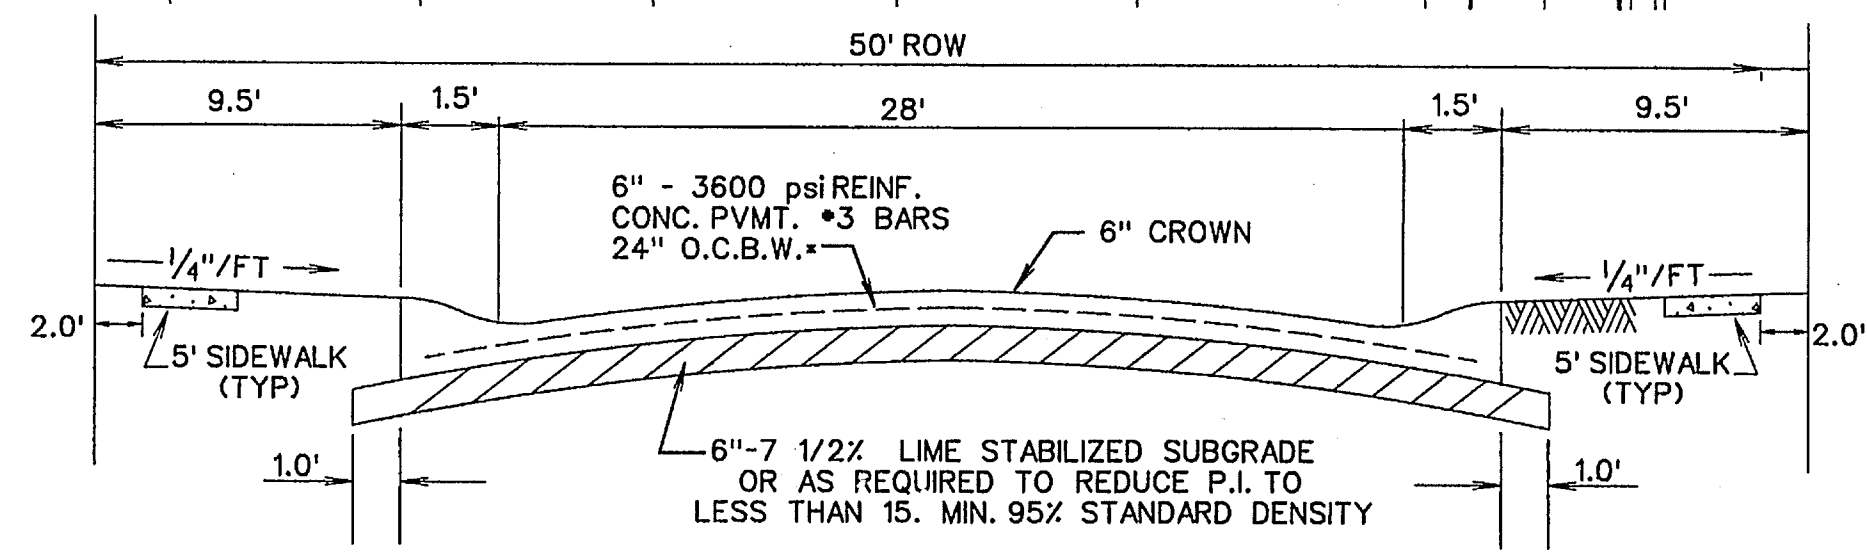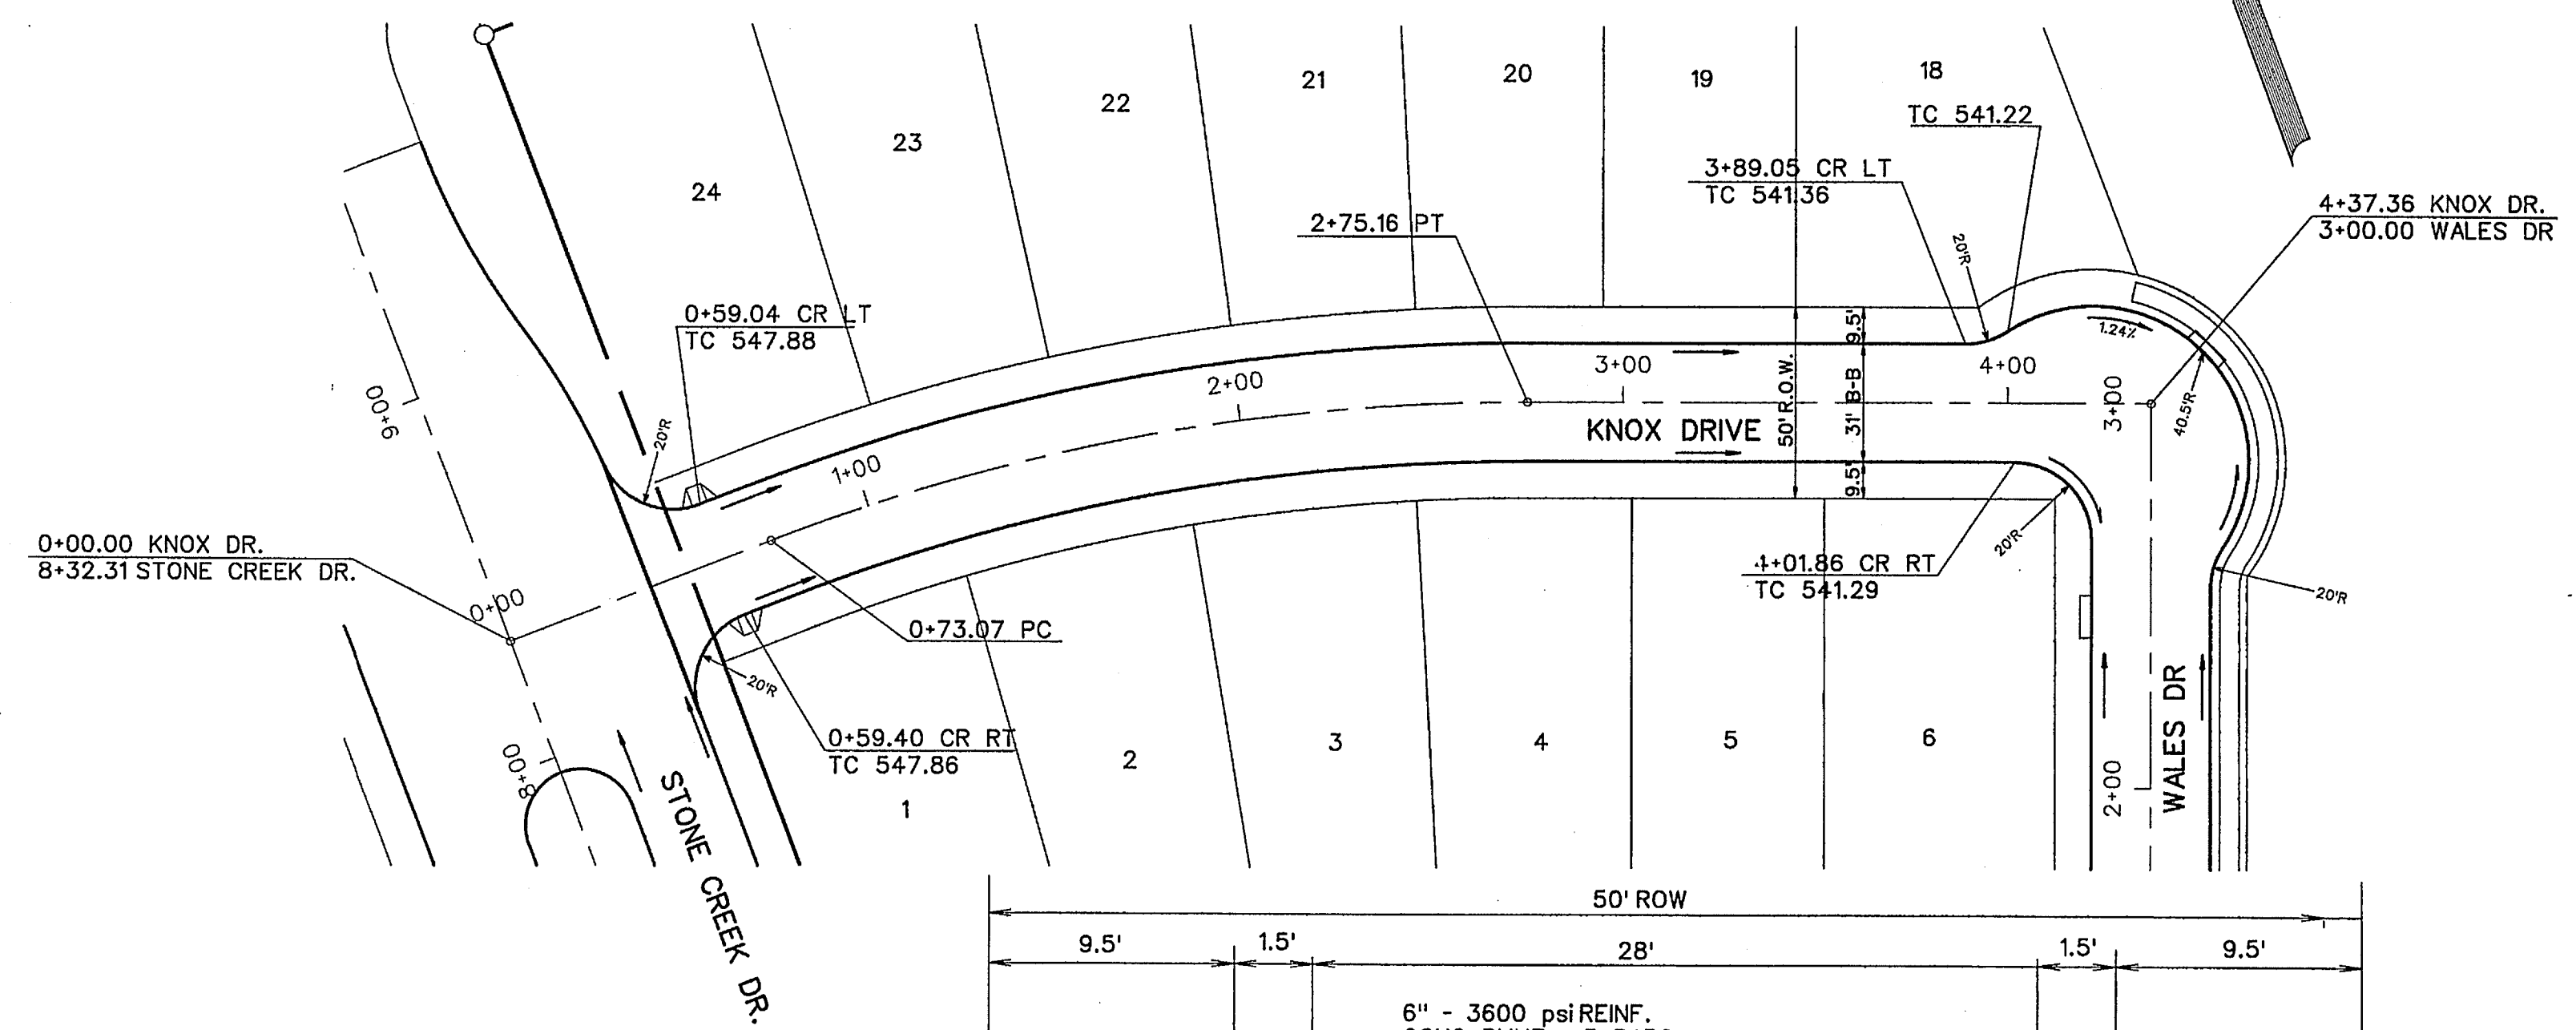


TYPICAL PAVEMENT SECTION - LAYDOWN CURB
N.T.S.
*MIN. 6 1/2 SACK MIX IF HAND PLACED

BENCHMARK:
CITY OF ROCKWALL SURVEY MONUMENT ON AN INLET
AT THE NORTHWEST CORNER OF FEATHERSTONE DR. AND
HARVARD DR.
ELEV. 525.31

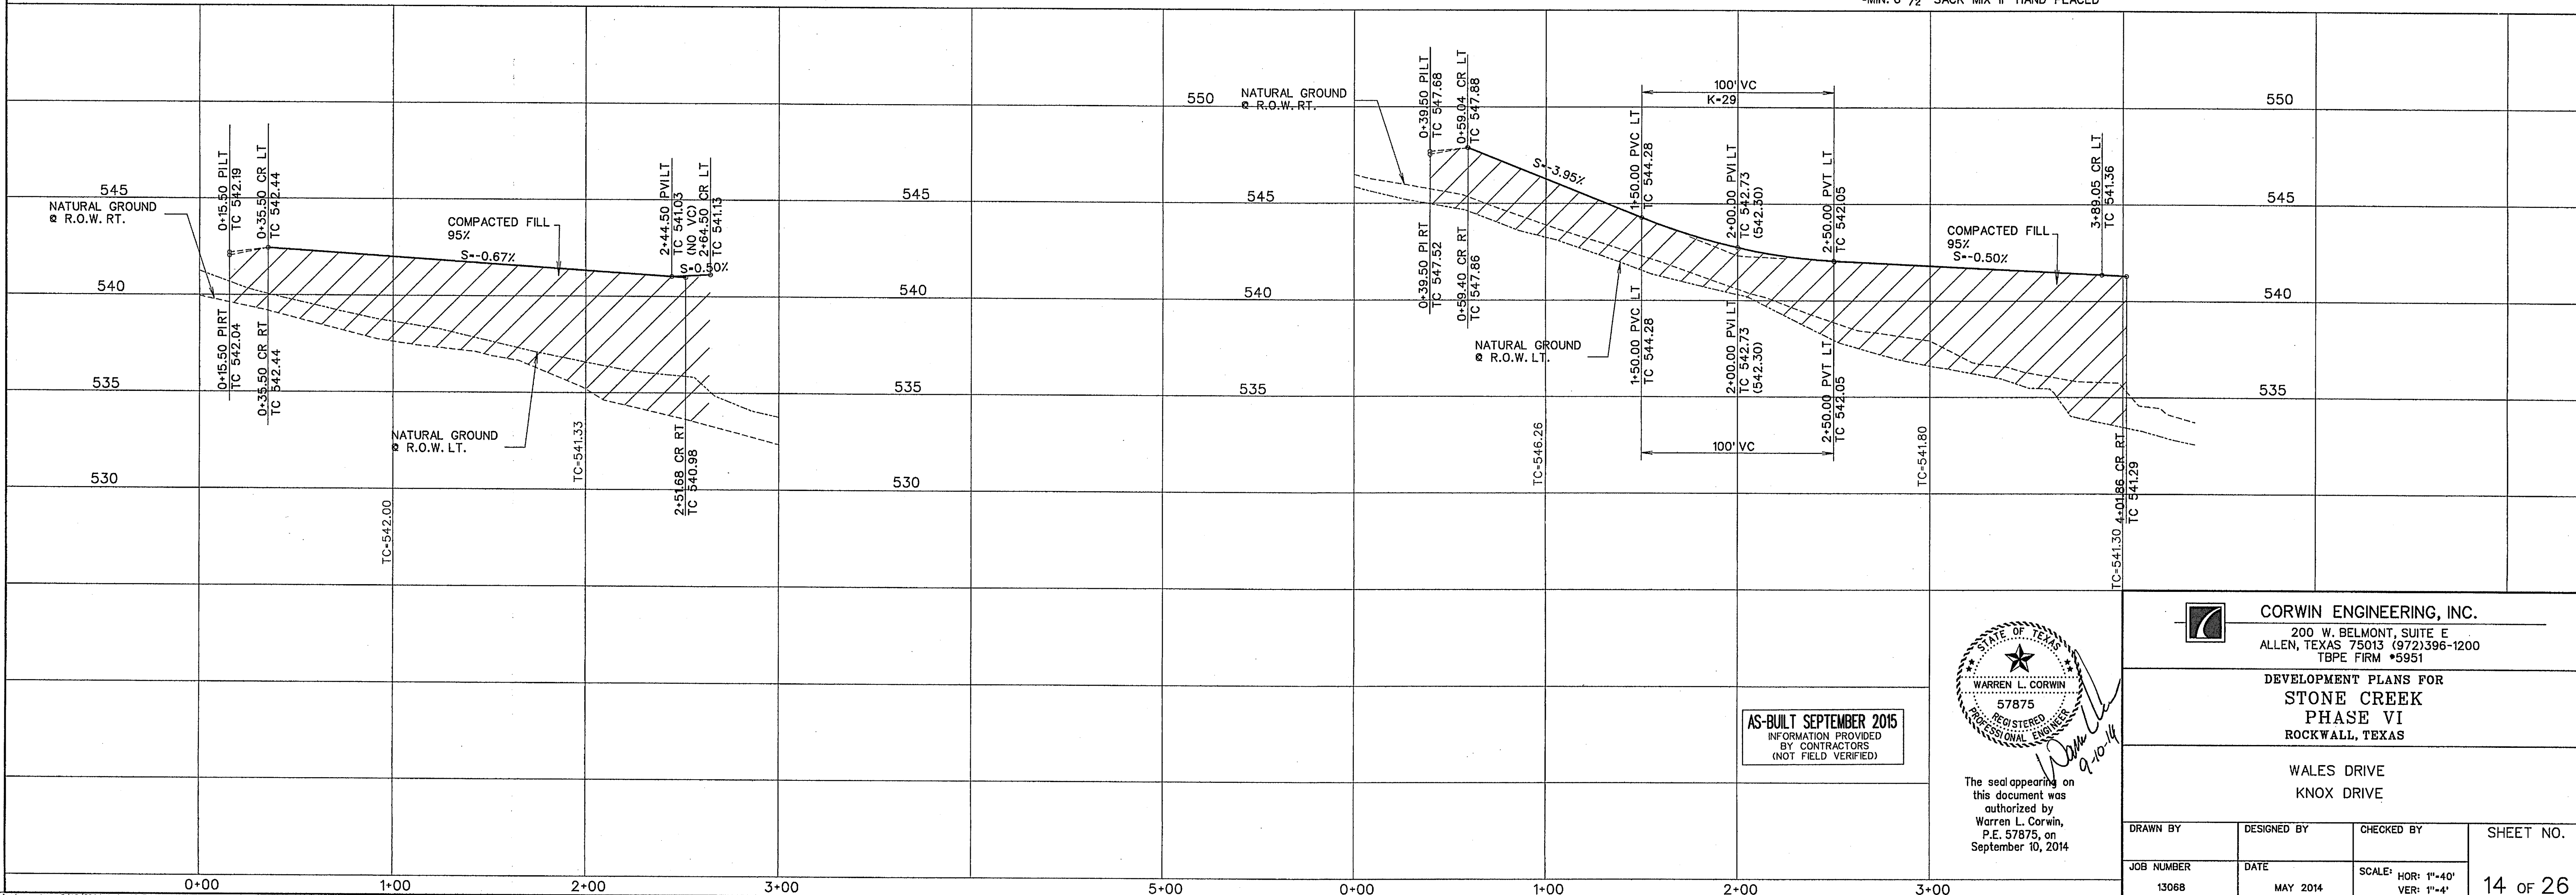

AS-BUILT SEPTEMBER 2015
INFORMATION PROVIDED
BY CONTRACTORS
(NOT FIELD VERIFIED)

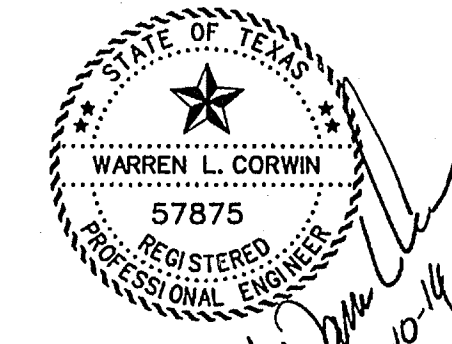

The seal appearing on
this document was
authorized by
Warren L. Corwin,
P.E. 57875, on
September 10, 2014

CORWIN ENGINEERING, INC.
200 W. BELMONT, SUITE E
ALLEN, TEXAS 75013 (972)396-1200
TBPE FIRM #5951

DEVELOPMENT PLANS FOR
STONE CREEK
PHASE VI
ROCKWALL, TEXAS

WALES DRIVE
KNOX DRIVE

DRAWN BY	DESIGNED BY	CHECKED BY	SHEET NO.
JOB NUMBER	DATE	SCALE: HOR: 1"=40' VER: 1"=4'	14 OF 26
13068	MAY 2014		

F.M. 552

CURVE TABLE

CURVE NO.	DELTA	RADIUS	LENGTH	TANGENT
1.	36°51'07"	401.00'	257.92'	133.60'
2.	10°55'35"	294.50'	56.16'	28.17'
3.	10°22'00"	846.00'	153.07'	76.74'
4.	08°25'46"	846.00'	124.46'	62.34'
5.	20°18'52"	271.00'	96.08'	48.55'
6.	19°34'51"	529.00'	180.80'	91.29'
7.	11°06'09"	796.00'	154.25'	77.36'
8.	27°23'35"	704.00'	336.58'	171.57'
9.	10°13'59"	945.00'	168.78'	84.61'
10.	06°29'38"	945.00'	30.51'	45.34'
11.	09°58'09"	329.00'	57.24'	28.69'
12.	11°45'16"	704.00'	144.43'	72.47'

SCALE: 1" = 100'

BENCHMARK:


CITY OF ROCKWALL SURVEY MONUMENT ON AN INLET AT THE NORTHWEST CORNER OF FEATHERSTONE DR. AND HARVARD DR. ELEV. = 525.31

SERVICE SCHEDULE		
TYPE	SIZE	NO.
SANITARY	4"	76
WATER	1"	76

NOTE:
 ALL WATER LINES TO BE CLASS 200 PIPE SDR 14.
 ALL SANITARY SEWER PIPE TO BE SDR 35 FOR 5'-10" DEEP AND SDR 26 FOR 10' AND GREATER.
 INSTALL BLUE "EMS" DISK ON WATER LINE AT EVERY 250' AND CHANGE IN DIRECTION, VALVE, AND SERVICE.
 INSTALL GREEN "EMS" DISK ON SANITARY SEWER LINE EVERY 250' AND AT EVERY CHANGE IN DIRECTION, MANHOLE, CLEANOUT, AND SERVICE.
 ALL MANHOLES TO BE RAVEN EPOXY LINED AND SEALED OR APPROVED EQUAL TO BE SPARK AND PRESSURE TESTED.

LEGEND

	PROP. WATER LINE
	PROP. FIRE HYDRANT AND VALVE
	PROP. GATE VALVE
	PROP. FLUSH VALVE
	EXIST. WATER LINE
	EXIST. FIRE HYDRANT AND VALVE
	PROP. SANITARY SEWER
	PROP. MANHOLE
	PROP. CLEANOUT
	EXIST. SANITARY SEWER
	EXIST. MANHOLE
	PROP. STORM SEWER
	PROP. CURB INLETS
	PROP. CONC. HEADWALL

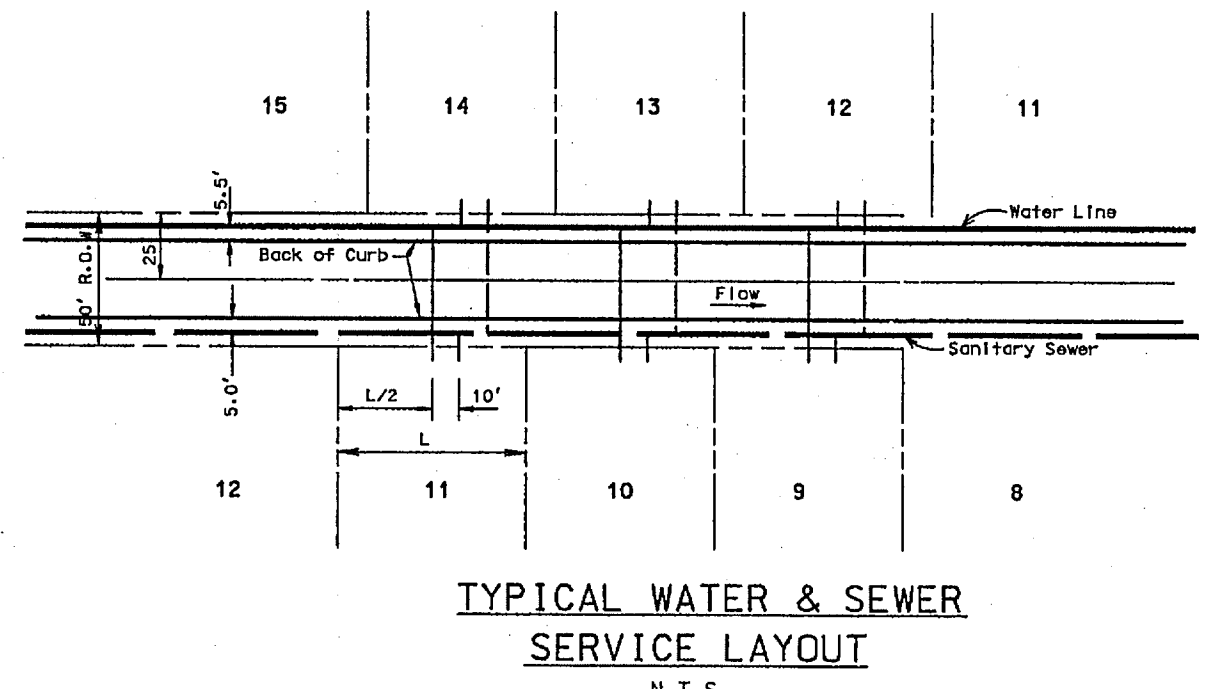

AS-BUILT SEPTEMBER 2015
 INFORMATION PROVIDED BY CONTRACTORS (NOT FIELD VERIFIED)


WARREN L. CORWIN
 57875
 REGISTERED PROFESSIONAL ENGINEER
 The seal appearing on this document was authorized by Warren L. Corwin, P.E. 57875, on September 10, 2014.

CORWIN ENGINEERING, INC.
 200 W. BELMONT, SUITE E
 ALLEN, TEXAS 75013 (972)396-1200
 TBPE FIRM #5951

DEVELOPMENT PLANS FOR
 STONE CREEK
 PHASE VI
 ROCKWALL, TEXAS


WATER AND SANITARY SEWER PLAN

DRAWN BY	DESIGNED BY	CHECKED BY	SHEET NO.
13068	MAY 2014	1"=100'	15 of 26

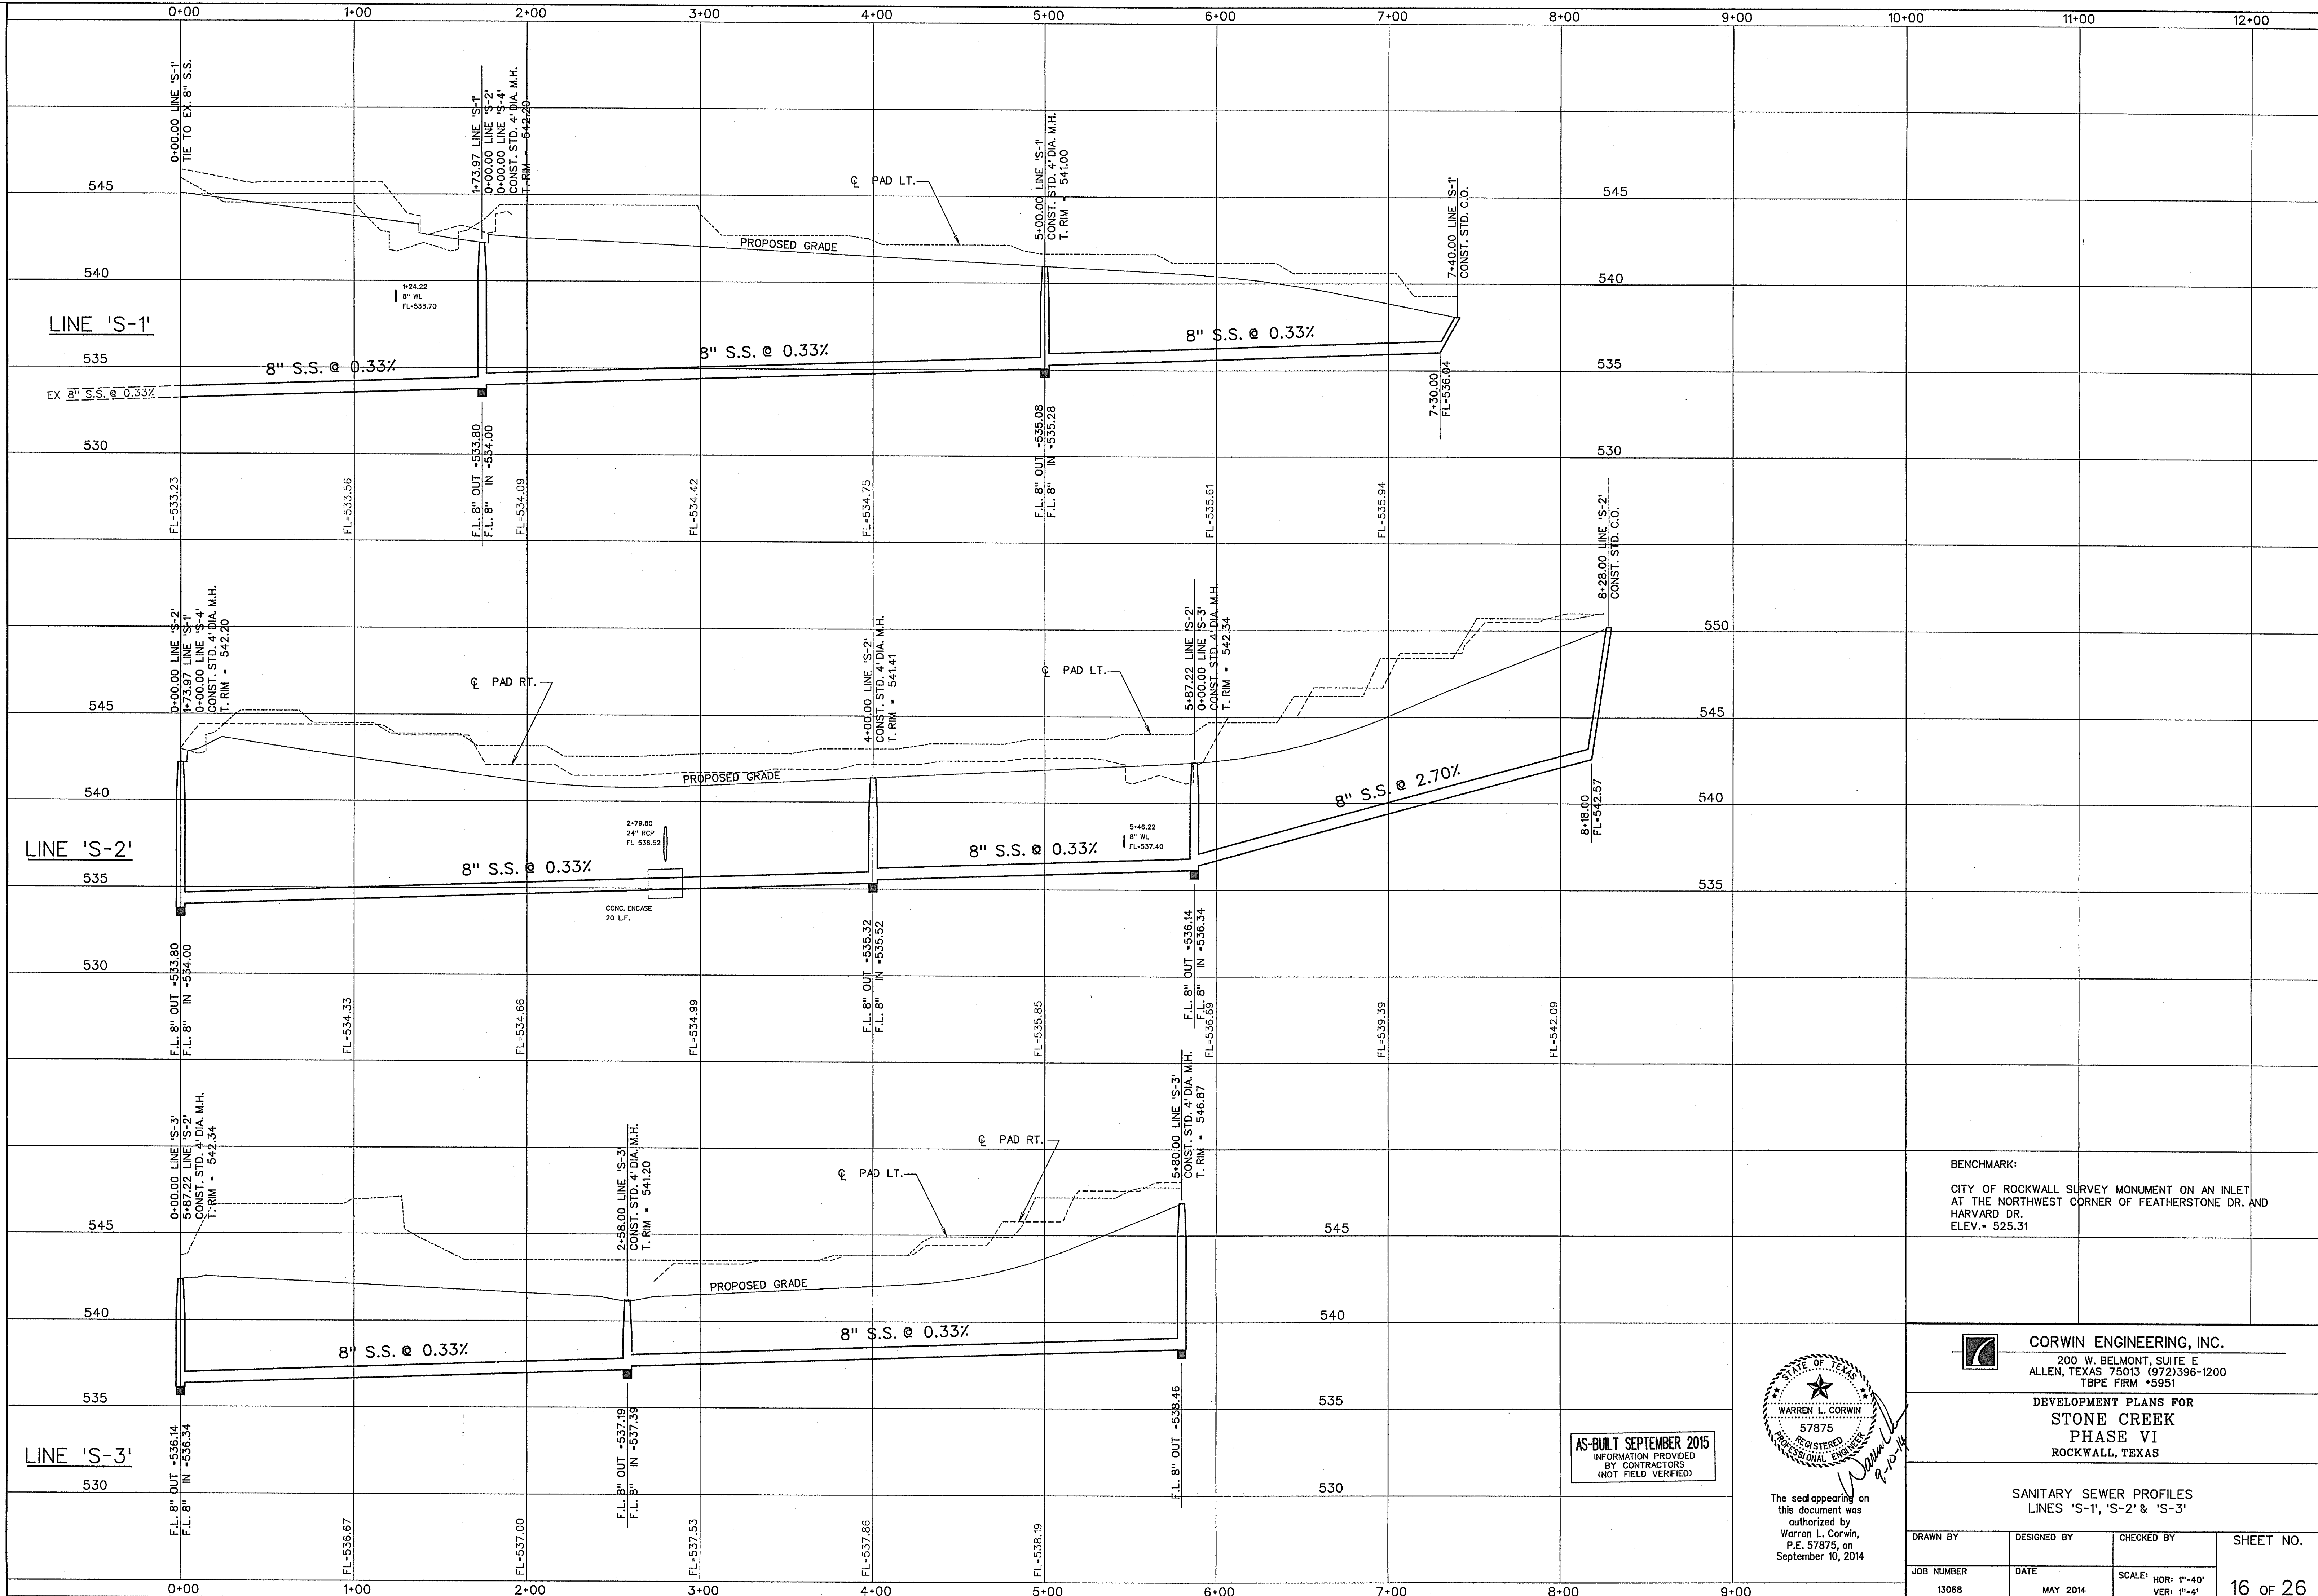

BENCHMARK:
 CITY OF ROCKWALL SURVEY MONUMENT ON AN INLET
 AT THE NORTHWEST CORNER OF FEATHERSTONE DR. AND
 HARVARD DR.
 ELEV. = 525.31

AS-BUILT SEPTEMBER 2015
 INFORMATION PROVIDED
 BY CONTRACTORS
 (NOT FIELD VERIFIED)

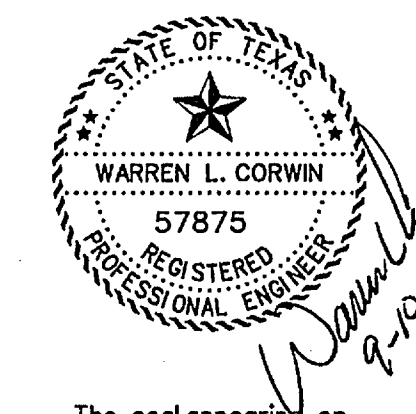


The seal appearing on
 this document was
 authorized by
 Warren L. Corwin,
 P.E. 57875, on
 September 10, 2014.

CORWIN ENGINEERING, INC.
 200 W. BELMONT, SUITE E
 ALLEN, TEXAS 75013 (972)396-1200
 TBPE FIRM #5951

DEVELOPMENT PLANS FOR
STONE CREEK
PHASE VI
 ROCKWALL, TEXAS

SANITARY SEWER PROFILES
 LINES 'S-1', 'S-2' & 'S-3'

DRAWN BY	DESIGNED BY	CHECKED BY	SHEET NO.
JOB NUMBER	DATE	SCALE: HOR: 1"=40' VER: 1"=4'	16 OF 26
13068	MAY 2014		

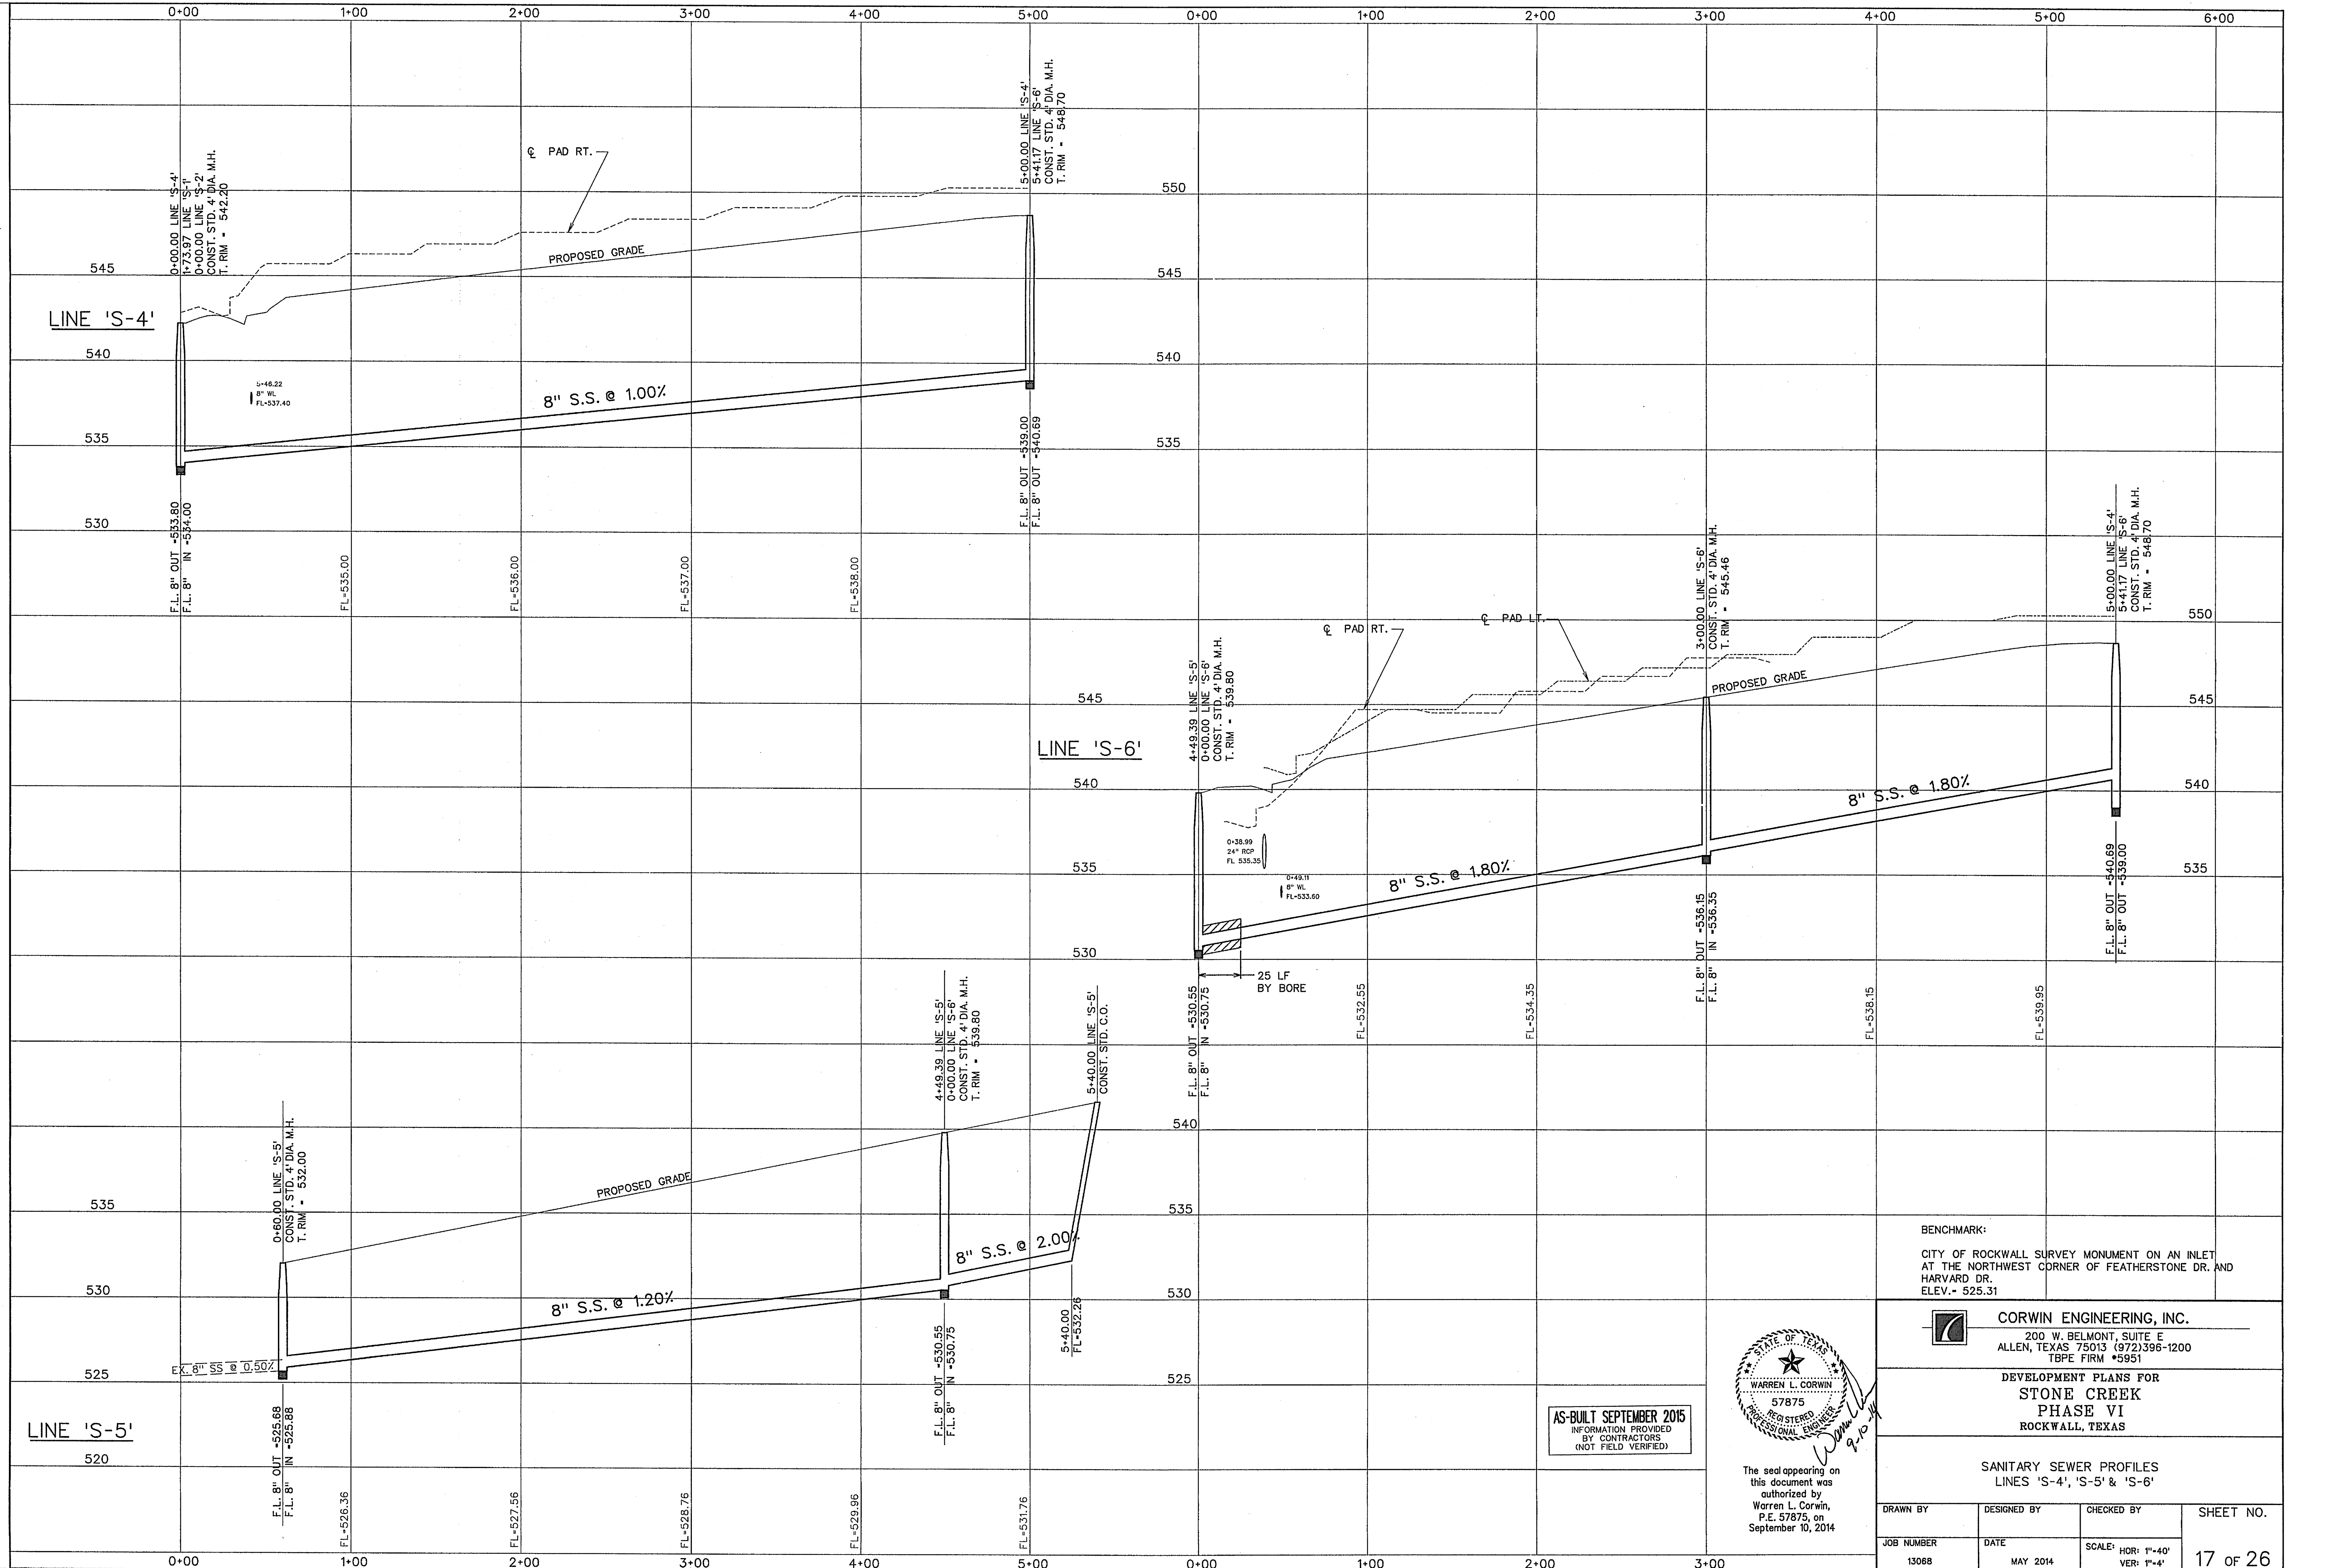

AS-BUILT SEPTEMBER 2015
INFORMATION PROVIDED
BY CONTRACTORS
(NOT FIELD VERIFIED)



The seal appearing on this document was authorized by Warren L. Corwin, P.E. 57875, on September 10, 2014





BENCHMARK:
CITY OF ROCKWALL SURVEY MONUMENT ON AN INLET AT THE NORTHWEST CORNER OF FEATHERSTONE DR. AND HARVARD DR.
ELEV. = 525.31

CORWIN ENGINEERING, INC.
200 W. BELMONT, SUITE E
ALLEN, TEXAS 75013 (972)396-1200
TBPE FIRM #5951

DEVELOPMENT PLANS FOR
STONE CREEK
PHASE VI
ROCKWALL, TEXAS

SANITARY SEWER PROFILES
LINES 'S-4', 'S-5' & 'S-6'

DRAWN BY	DESIGNED BY	CHECKED BY	SHEET NO. 17 of 26
JOB NUMBER 13088	DATE MAY 2014	SCALE: HOR: 1"=40' VER: 1"=4'	

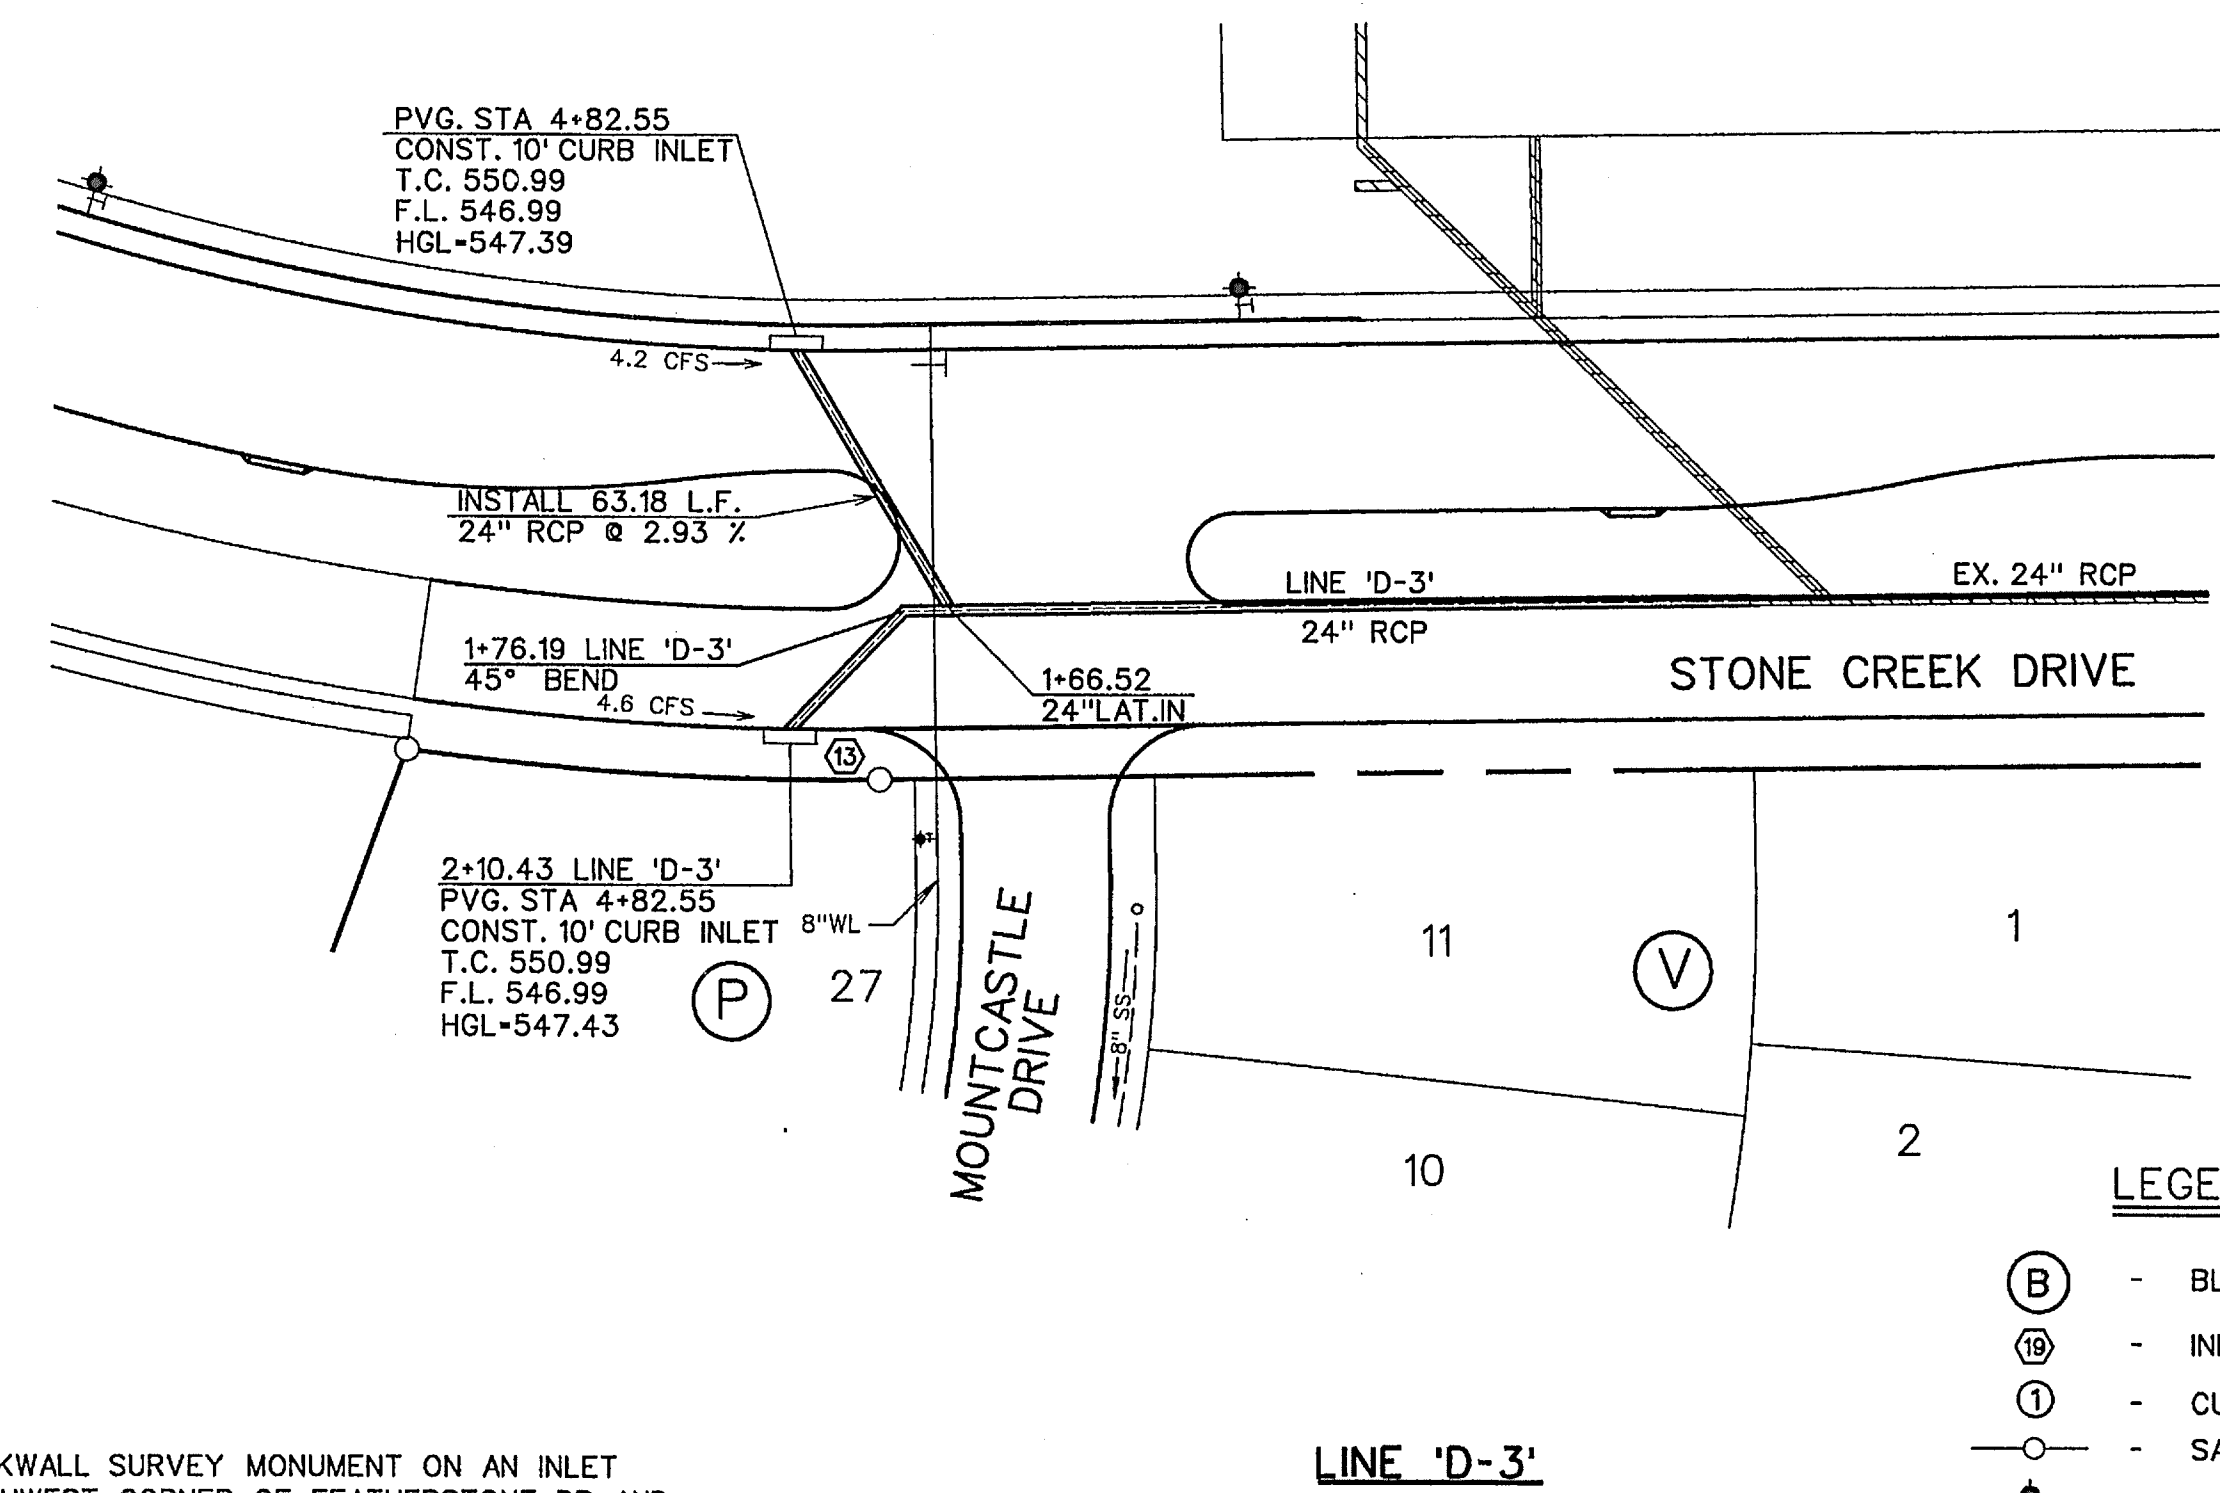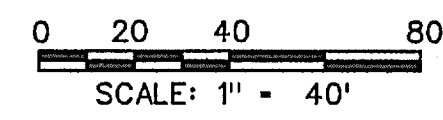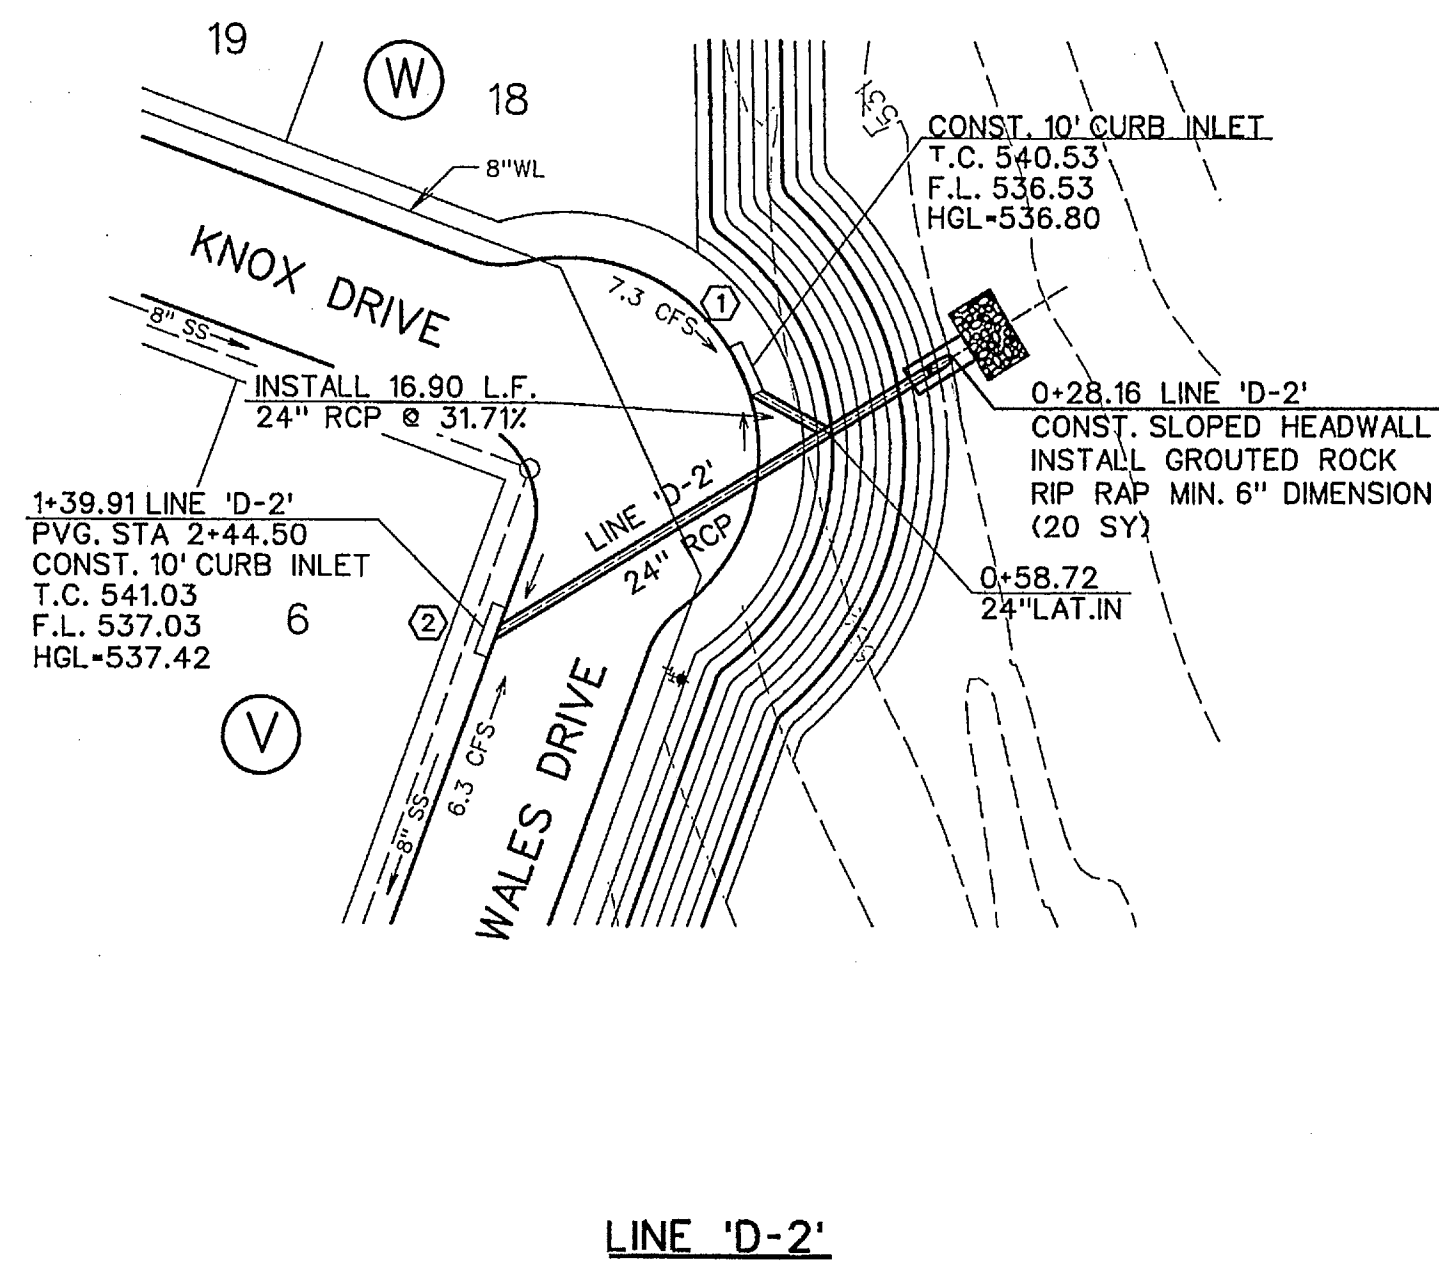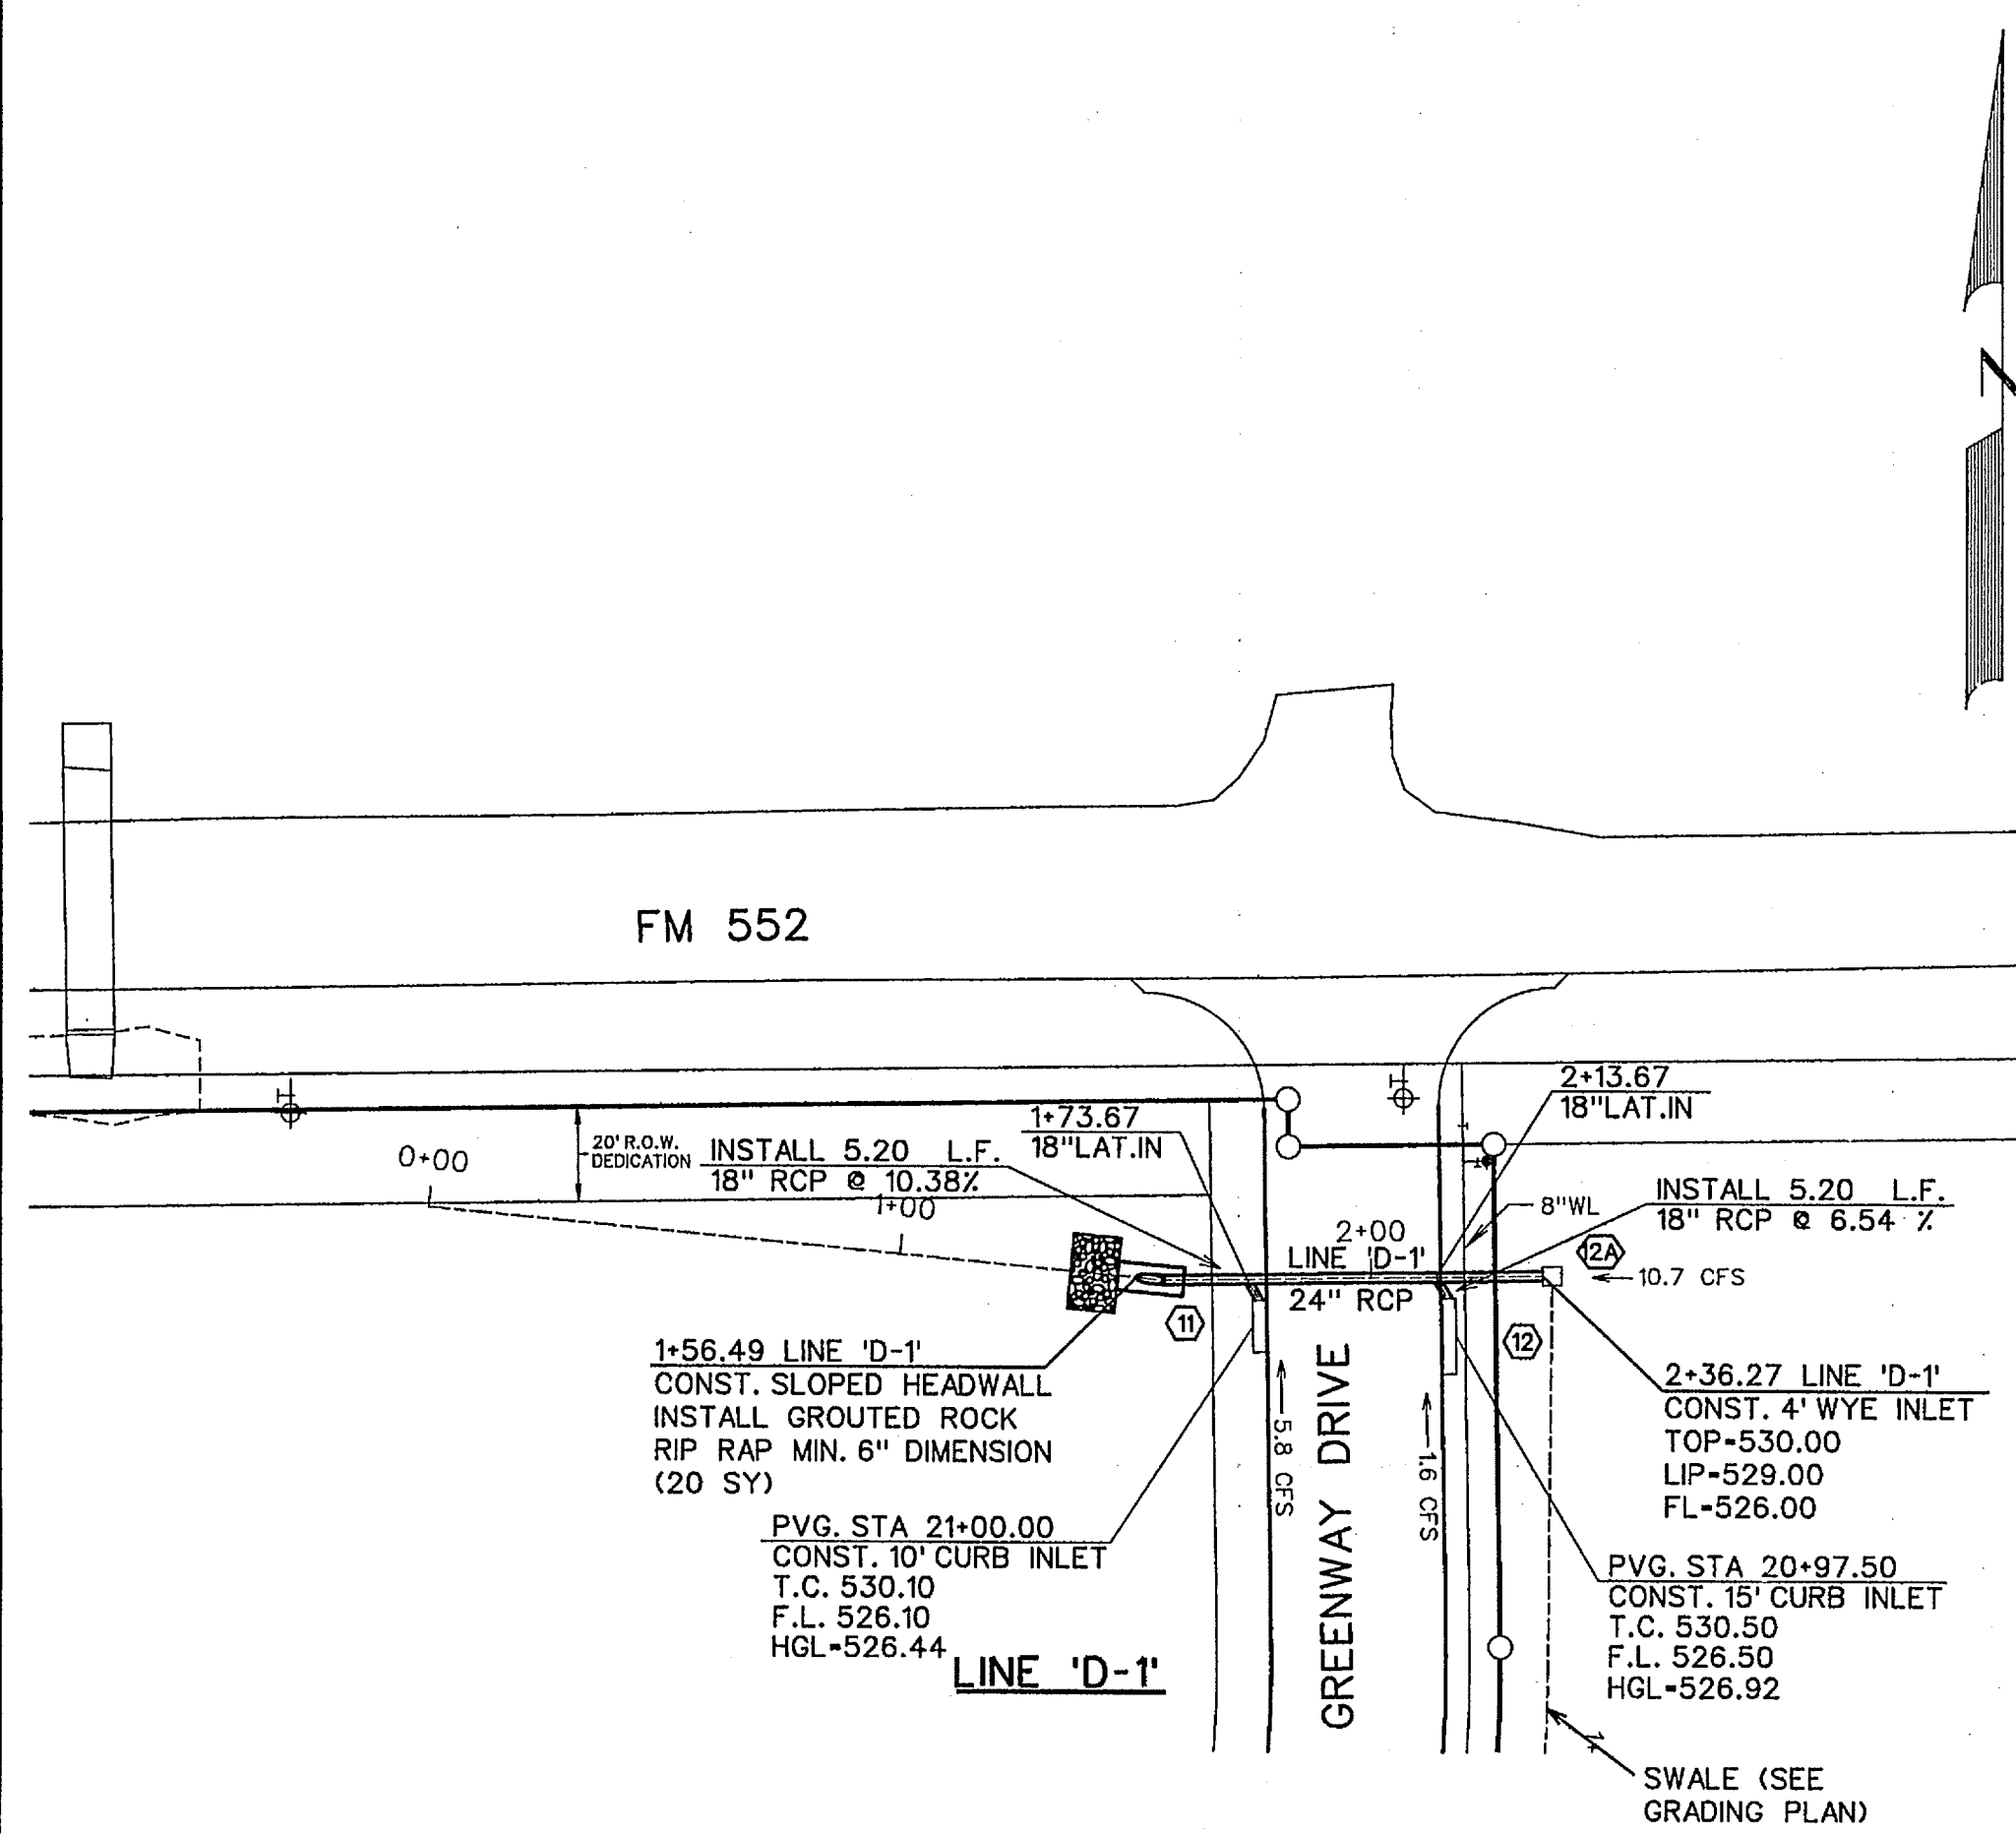


- LEGEND**
- (B) - BLOCK LABEL
 - (10) - INLET NUMBER
 - (C) - CURVE NUMBER
 - - SANITARY SEWER
 - ⊕ - WATER
 - ==== - PROPOSED STORM SEWER
 - ===== - EXISTING STORM SEWER

BENCHMARK:
 CITY OF ROCKWALL SURVEY MONUMENT ON AN INLET
 AT THE NORTHWEST CORNER OF FEATHERSTONE DR. AND
 HARVARD DR.
 ELEV. - 525.31

Station	Line 'D-1' Data	Line 'D-2' Data	Line 'D-3' Data
535	24" RCP Q ₁₀₀ = 18.1 cfs V ₁₀₀ = 5.8 fps S = 0.0064 CAP = 18.1 cfs	24" RCP Q ₁₀₀ = 6.3 cfs V ₁₀₀ = 2.0 fps S = 0.0008 CAP = 64.1 cfs PARTIAL FLOW VEL = 12.0 fps	24" RCP Q ₁₀₀ = 4.6 cfs V ₁₀₀ = 1.5 fps S = 0.0004 CAP = 28.3 cfs PARTIAL FLOW VEL = 6.1 fps
530	24" RCP Q ₁₀₀ = 10.7 cfs V ₁₀₀ = 3.4 fps S = 0.0022 CAP = 16.0 cfs	24" RCP Q ₁₀₀ = 13.6 cfs V ₁₀₀ = 4.3 fps S = 0.0036 CAP = 22.6 cfs PARTIAL FLOW VEL = 5.7 fps	24" RCP Q ₁₀₀ = 8.8 cfs V ₁₀₀ = 2.8 fps S = 0.0015 CAP = 16.0 cfs PARTIAL FLOW VEL = 5.0 fps
525	24" RCP @ 0.30%	24" RCP @ 8.04%	24" RCP @ 1.43%
520	24" RCP @ 5.00%	24" RCP @ 1.00%	EX. 24" RCP @ 3.13%

AS-BUILT SEPTEMBER 2015
 INFORMATION PROVIDED
 BY CONTRACTORS
 (NOT FIELD VERIFIED)


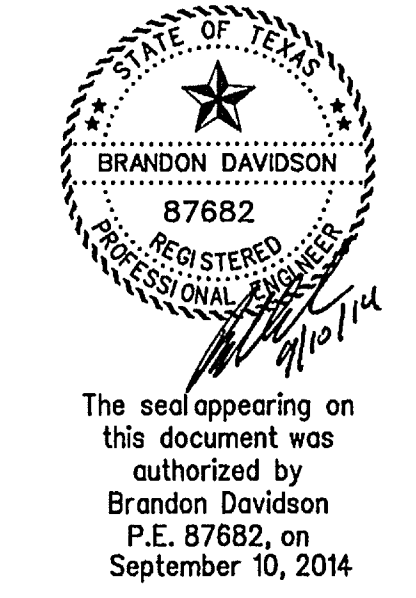



CORWIN ENGINEERING, INC.
 200 W. BELMONT, SUITE E
 ALLEN, TEXAS 75013 (972) 396-1200
 TBPE FIRM #5951

DEVELOPMENT PLANS FOR
STONE CREEK
 PHASE VI
 ROCKWALL, TEXAS


STORM SEWER PLAN AND PROFILE
 LINES 'D-1', 'D-2' & 'D-3'

DRAWN BY	DESIGNED BY	CHECKED BY	SHEET NO.
13068	MAY 2014		18 OF 26

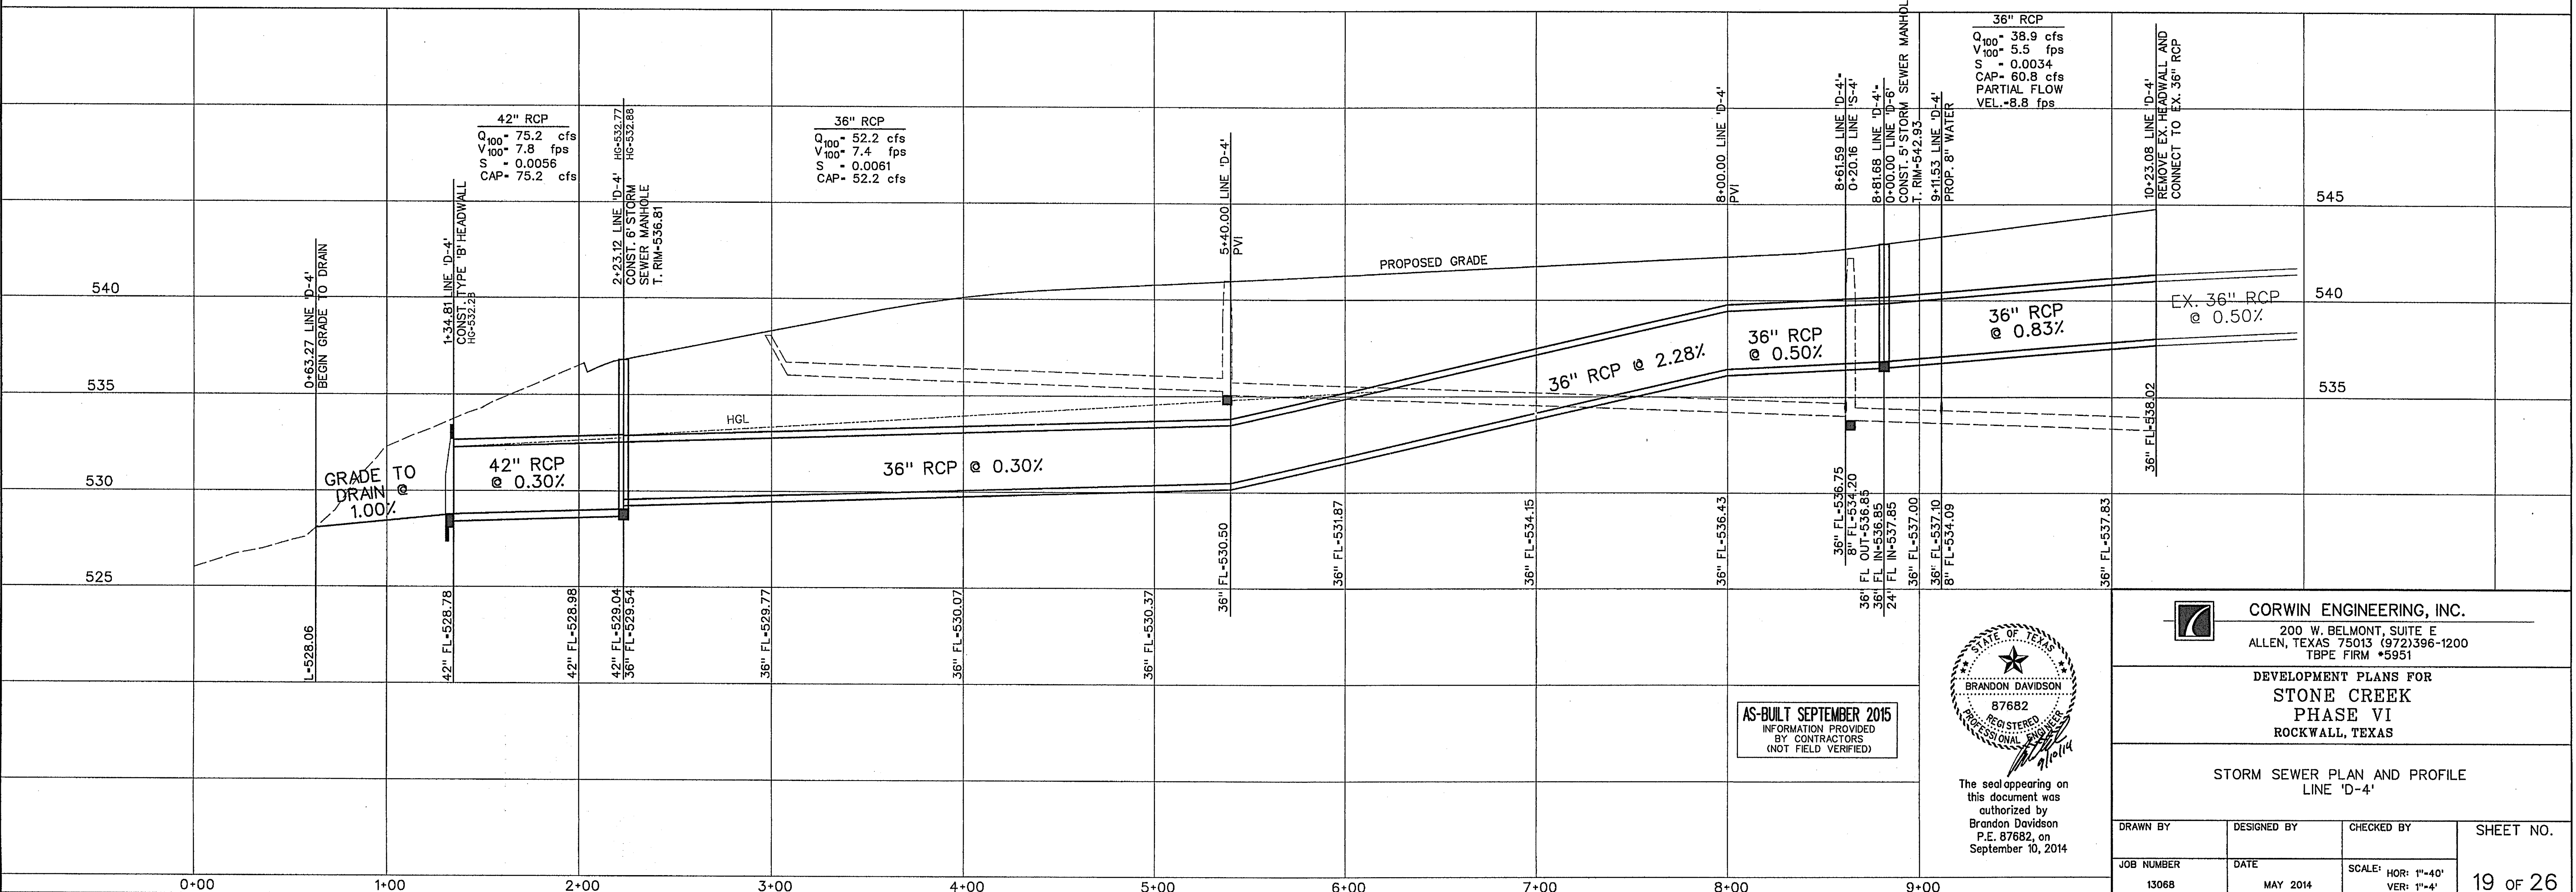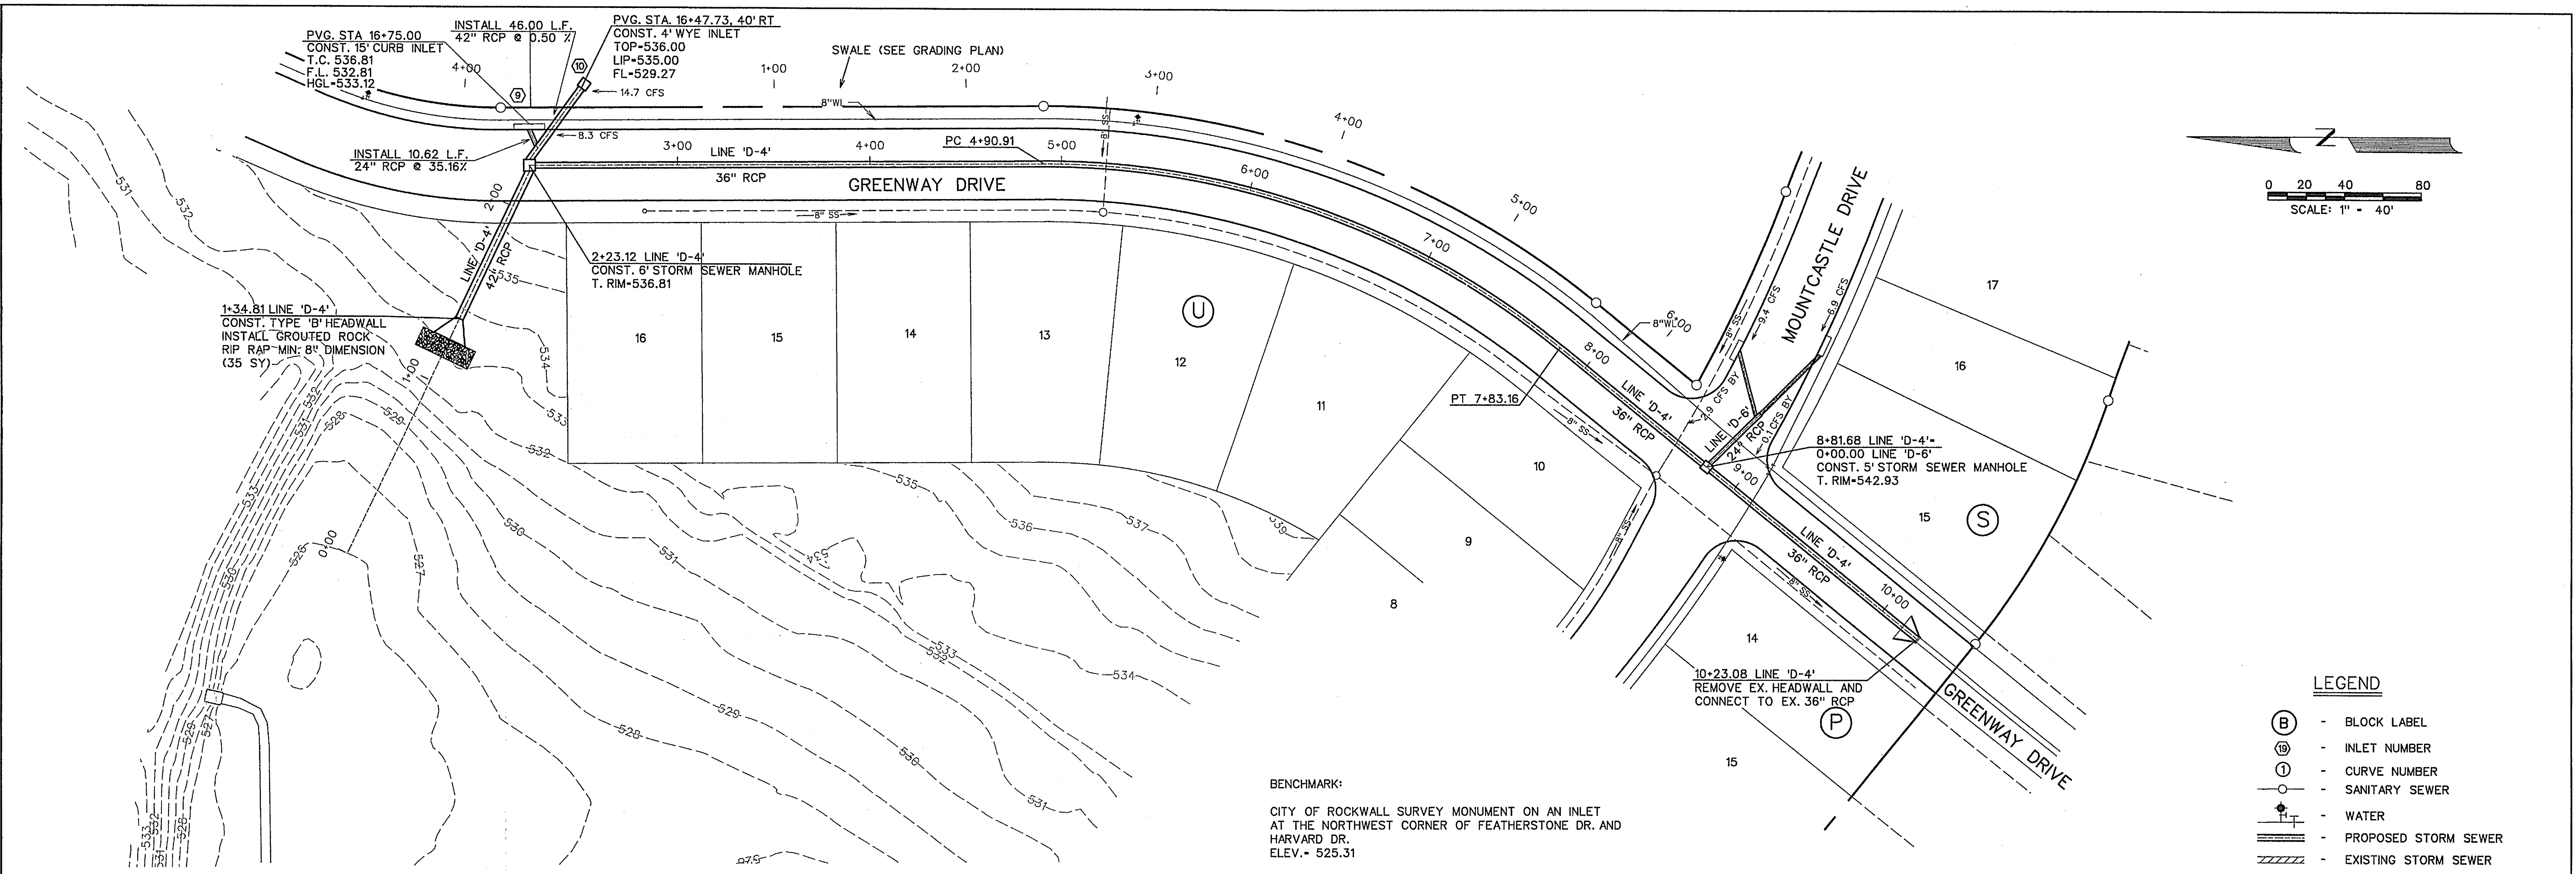


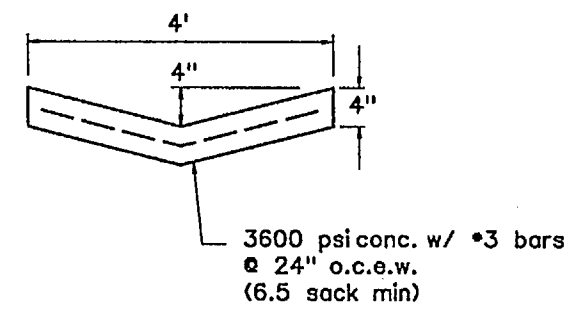


POSITIVE OVERFLOW DETAIL
NTS

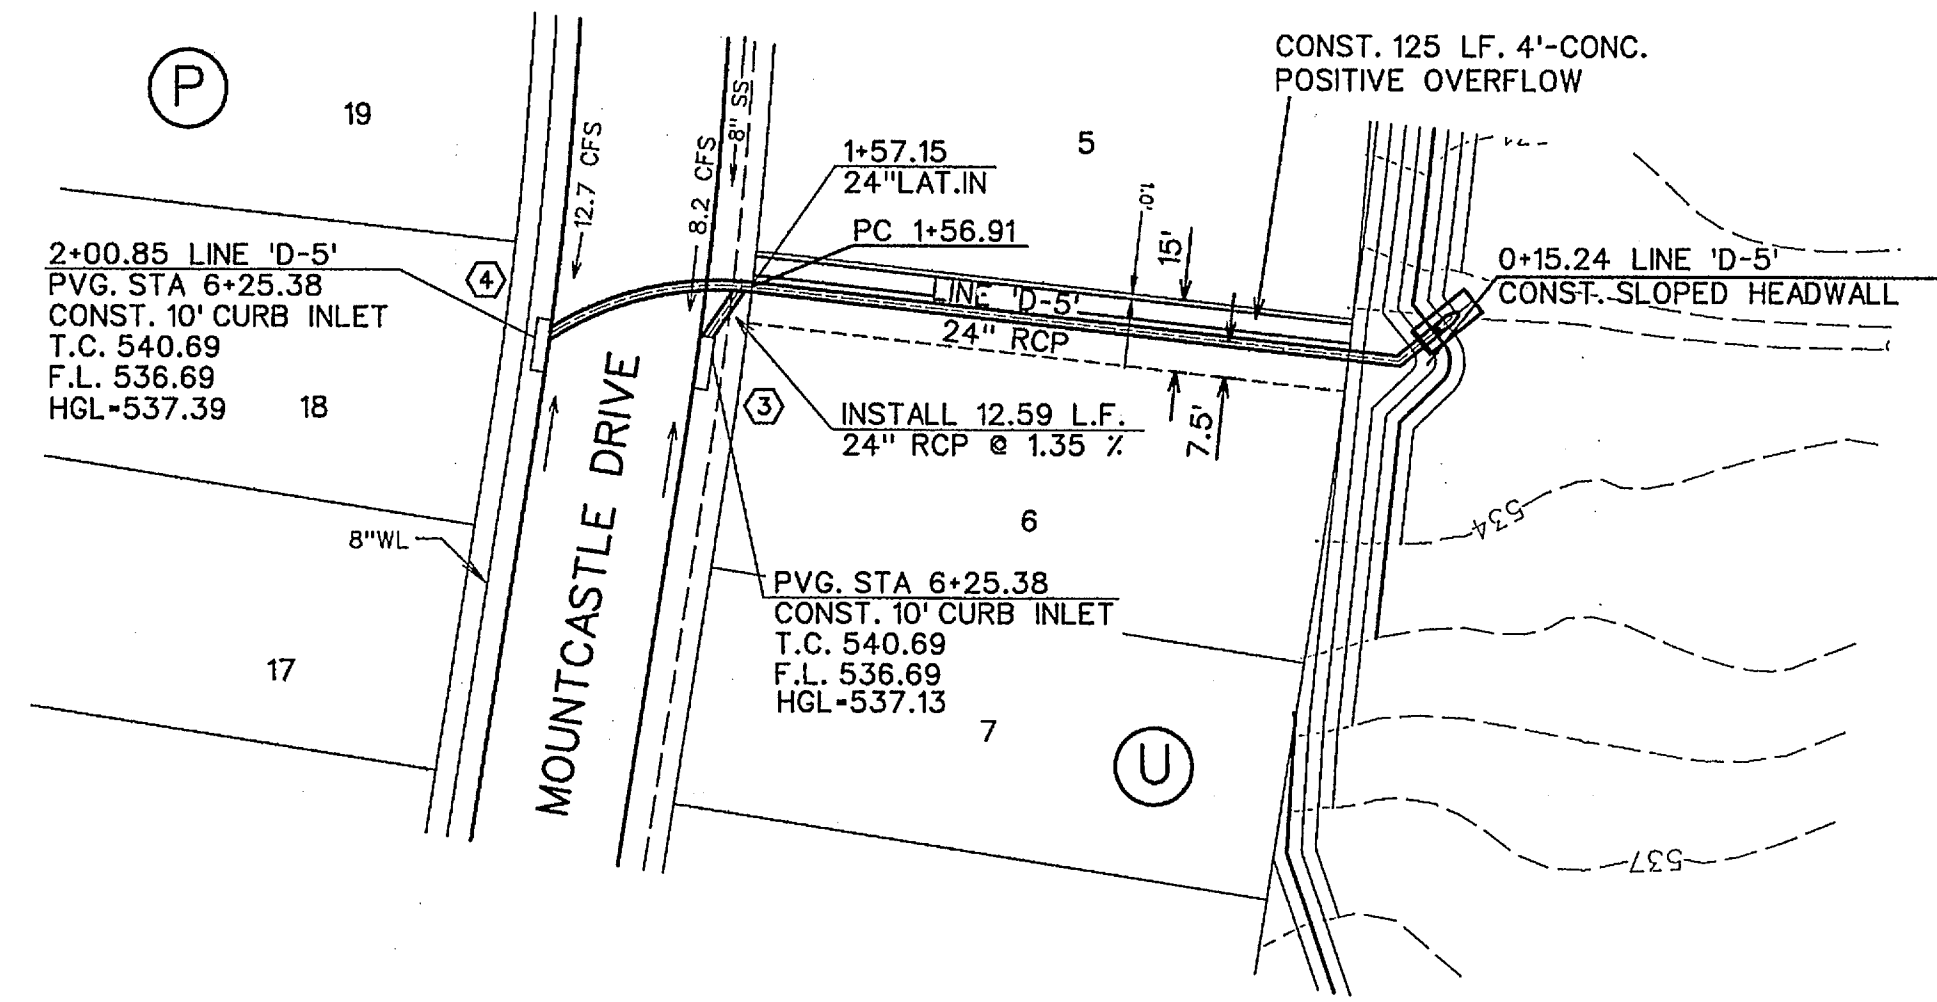

LINE 'D-5'

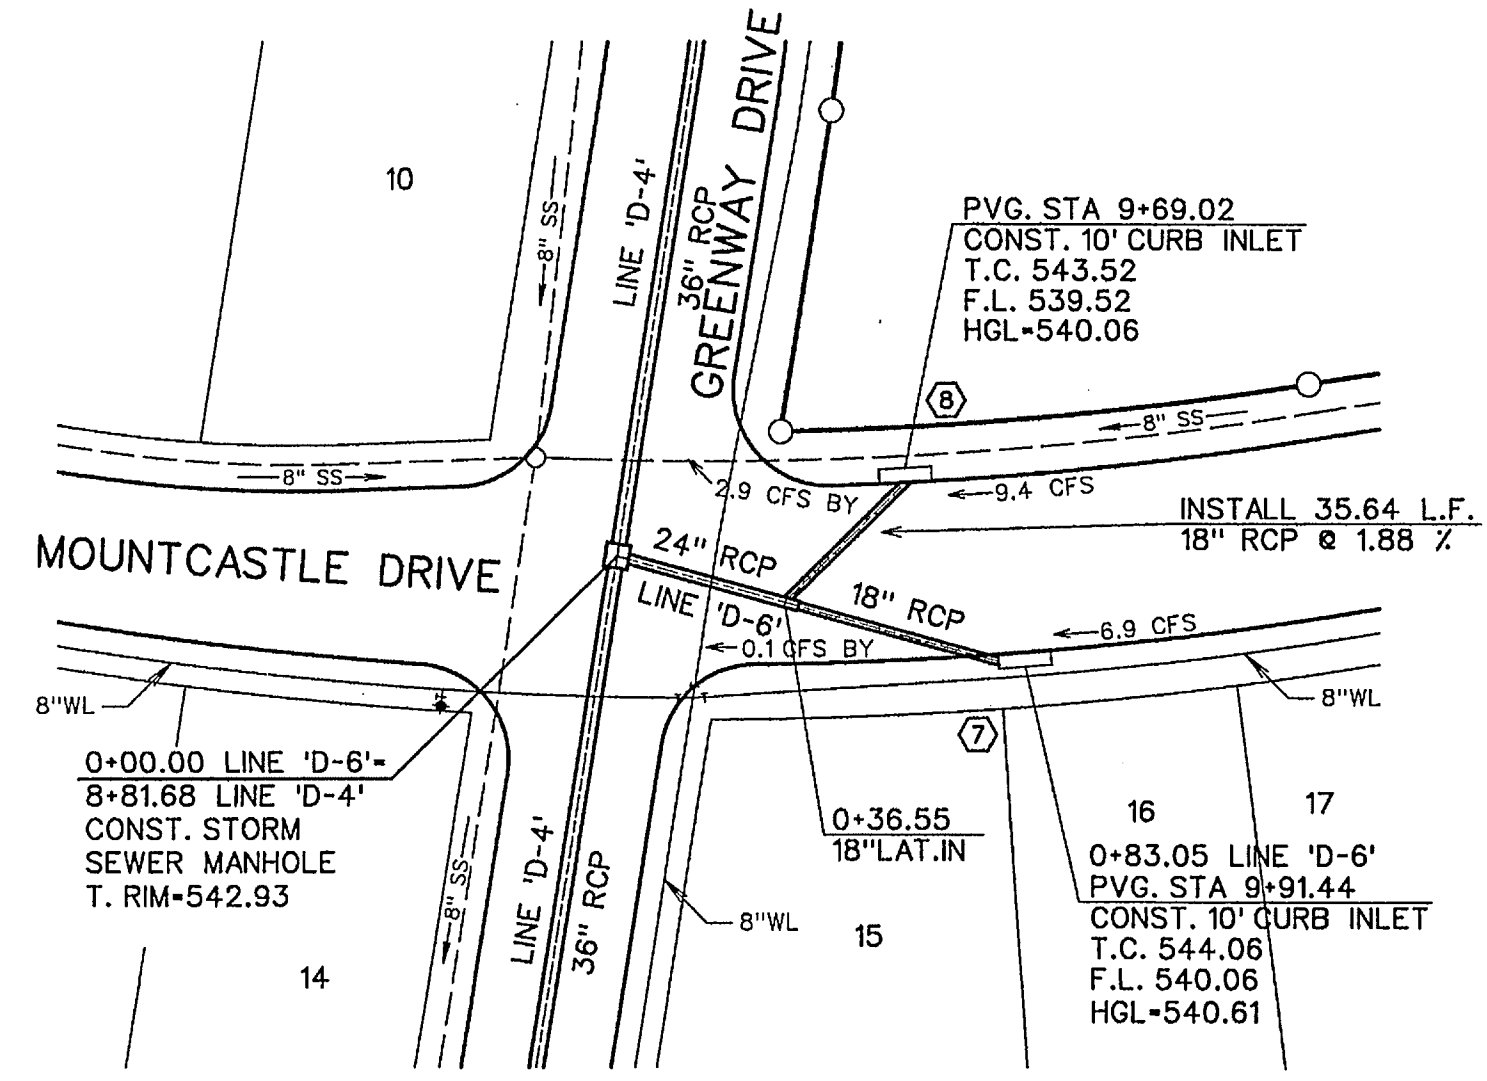


LINE 'D-6'

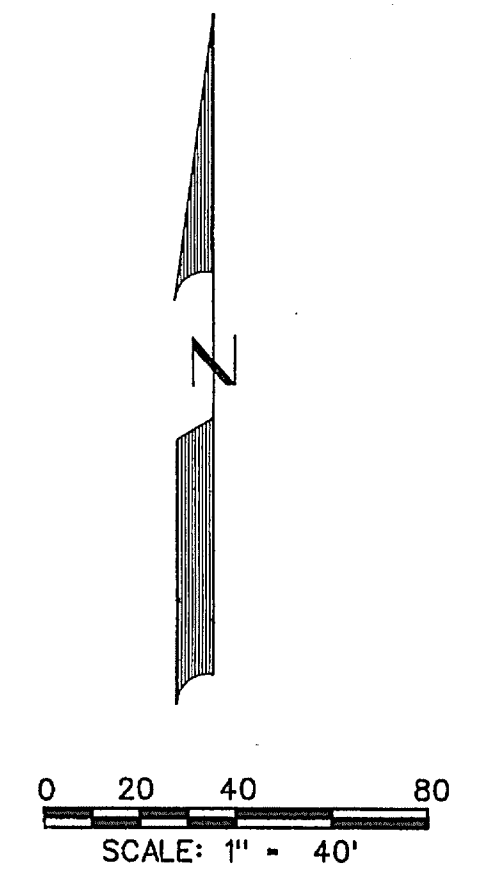

- LEGEND**
- (B) - BLOCK LABEL
 - (10) - INLET NUMBER
 - (1) - CURVE NUMBER
 - - SANITARY SEWER
 - ⊕ - WATER
 - ==== - PROPOSED STORM SEWER
 - ===== - EXISTING STORM SEWER

BENCHMARK:
CITY OF ROCKWALL SURVEY MONUMENT ON AN INLET
AT THE NORTHWEST CORNER OF FEATHERSTONE DR. AND
HARVARD DR.
ELEV. - 525.31

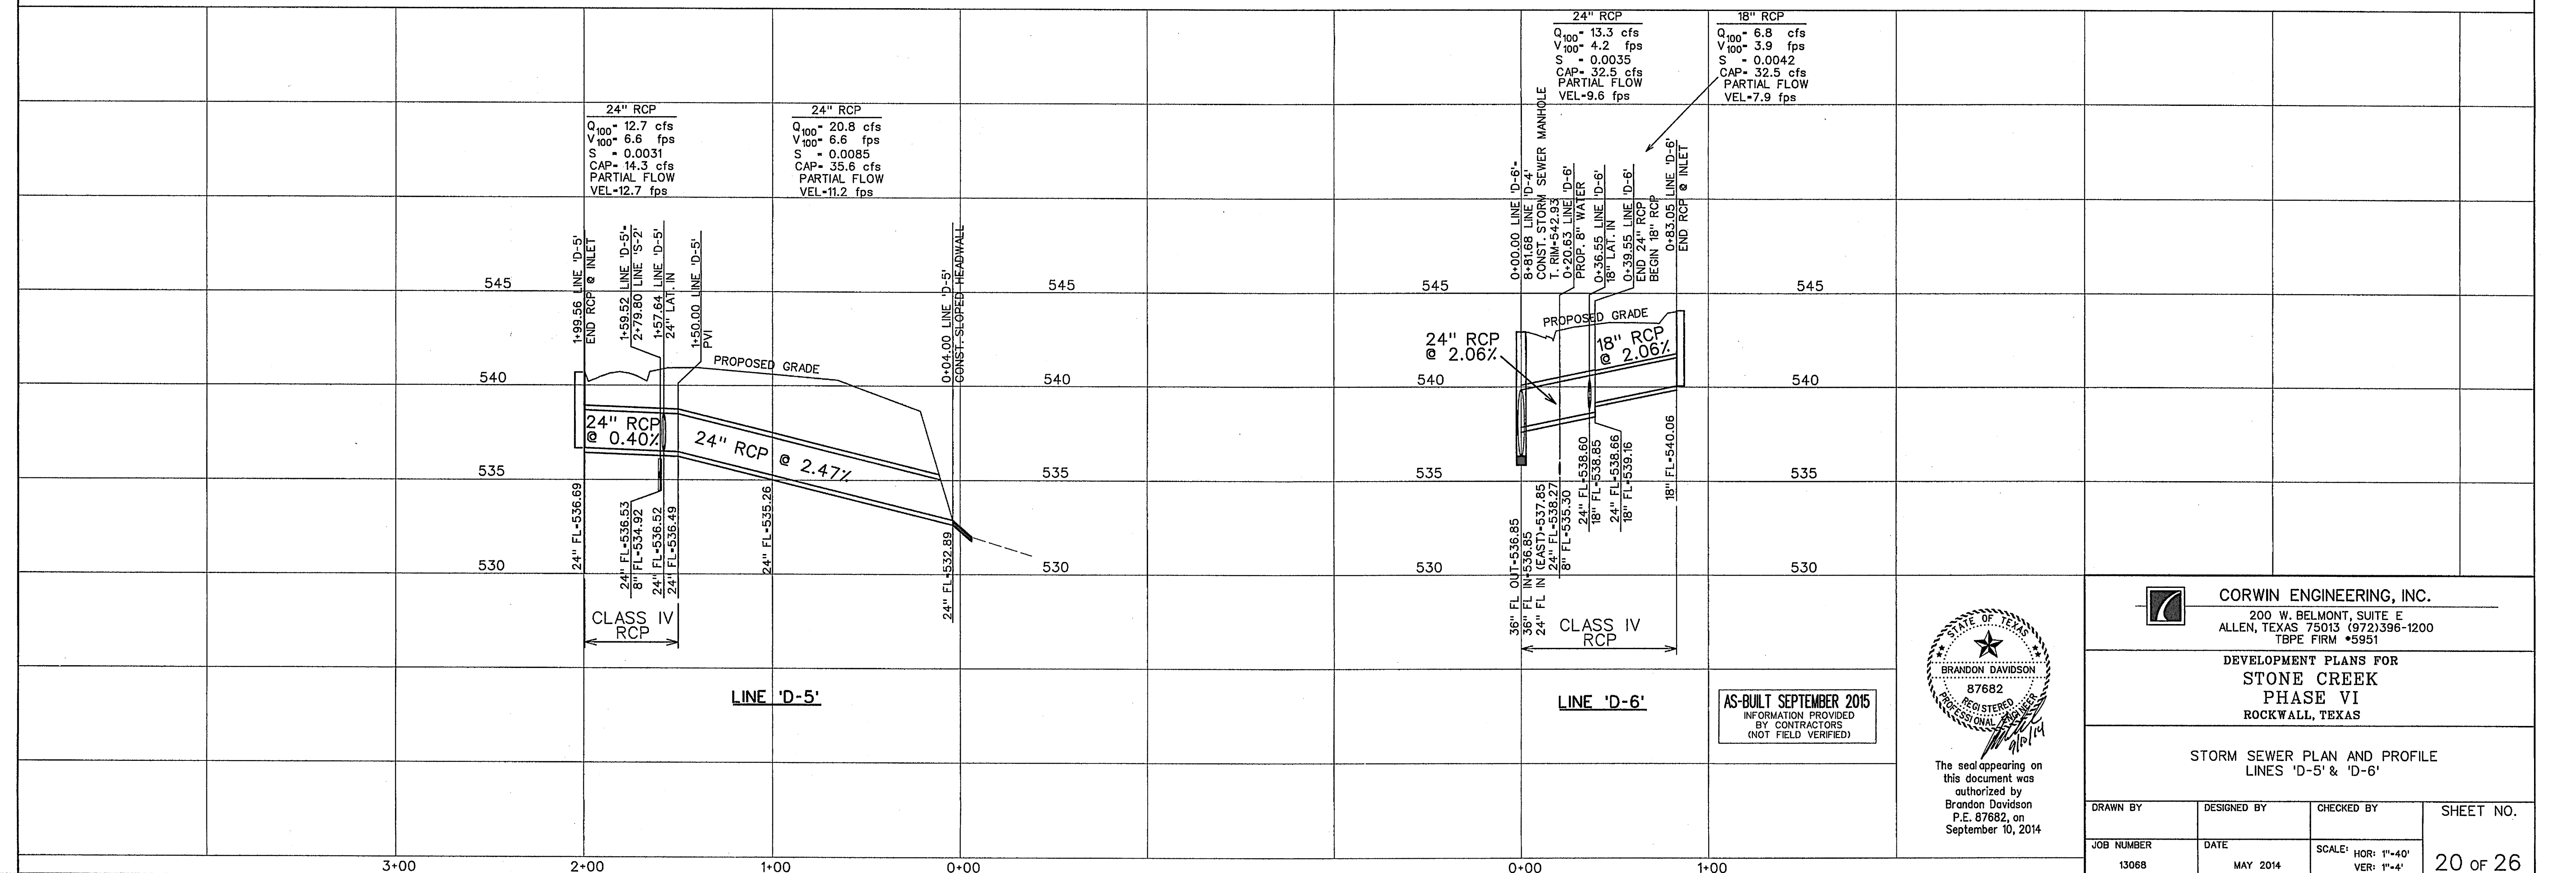

The seal appearing on this document was authorized by Brandon Davidson P.E. 87682, on September 10, 2014



AS-BUILT SEPTEMBER 2015
INFORMATION PROVIDED BY CONTRACTORS (NOT FIELD VERIFIED)

CORWIN ENGINEERING, INC.
200 W. BELMONT, SUITE E
ALLEN, TEXAS 75013 (972)396-1200
TBP# FIRM #5951


DEVELOPMENT PLANS FOR
STONE CREEK
PHASE VI
ROCKWALL, TEXAS

STORM SEWER PLAN AND PROFILE
LINES 'D-5' & 'D-6'

DRAWN BY	DESIGNED BY	CHECKED BY	SHEET NO.
JOB NUMBER	DATE	SCALE: HOR: 1"=40' VER: 1"=4'	20 of 26
13068	MAY 2014		

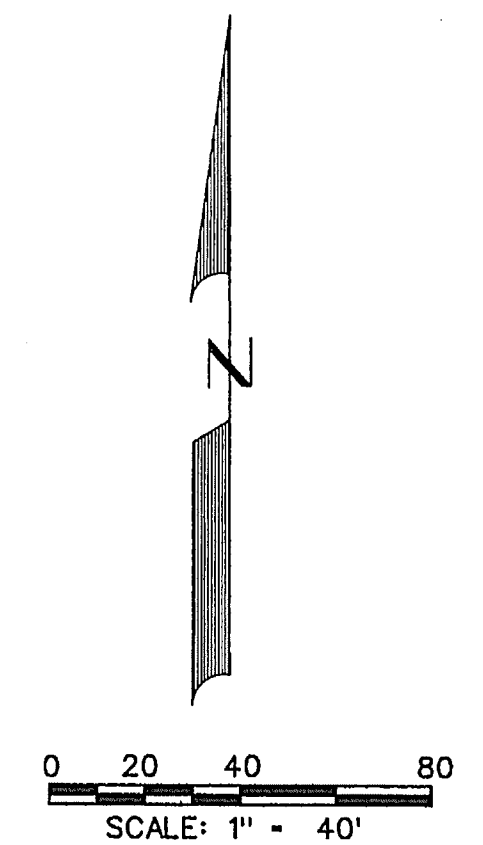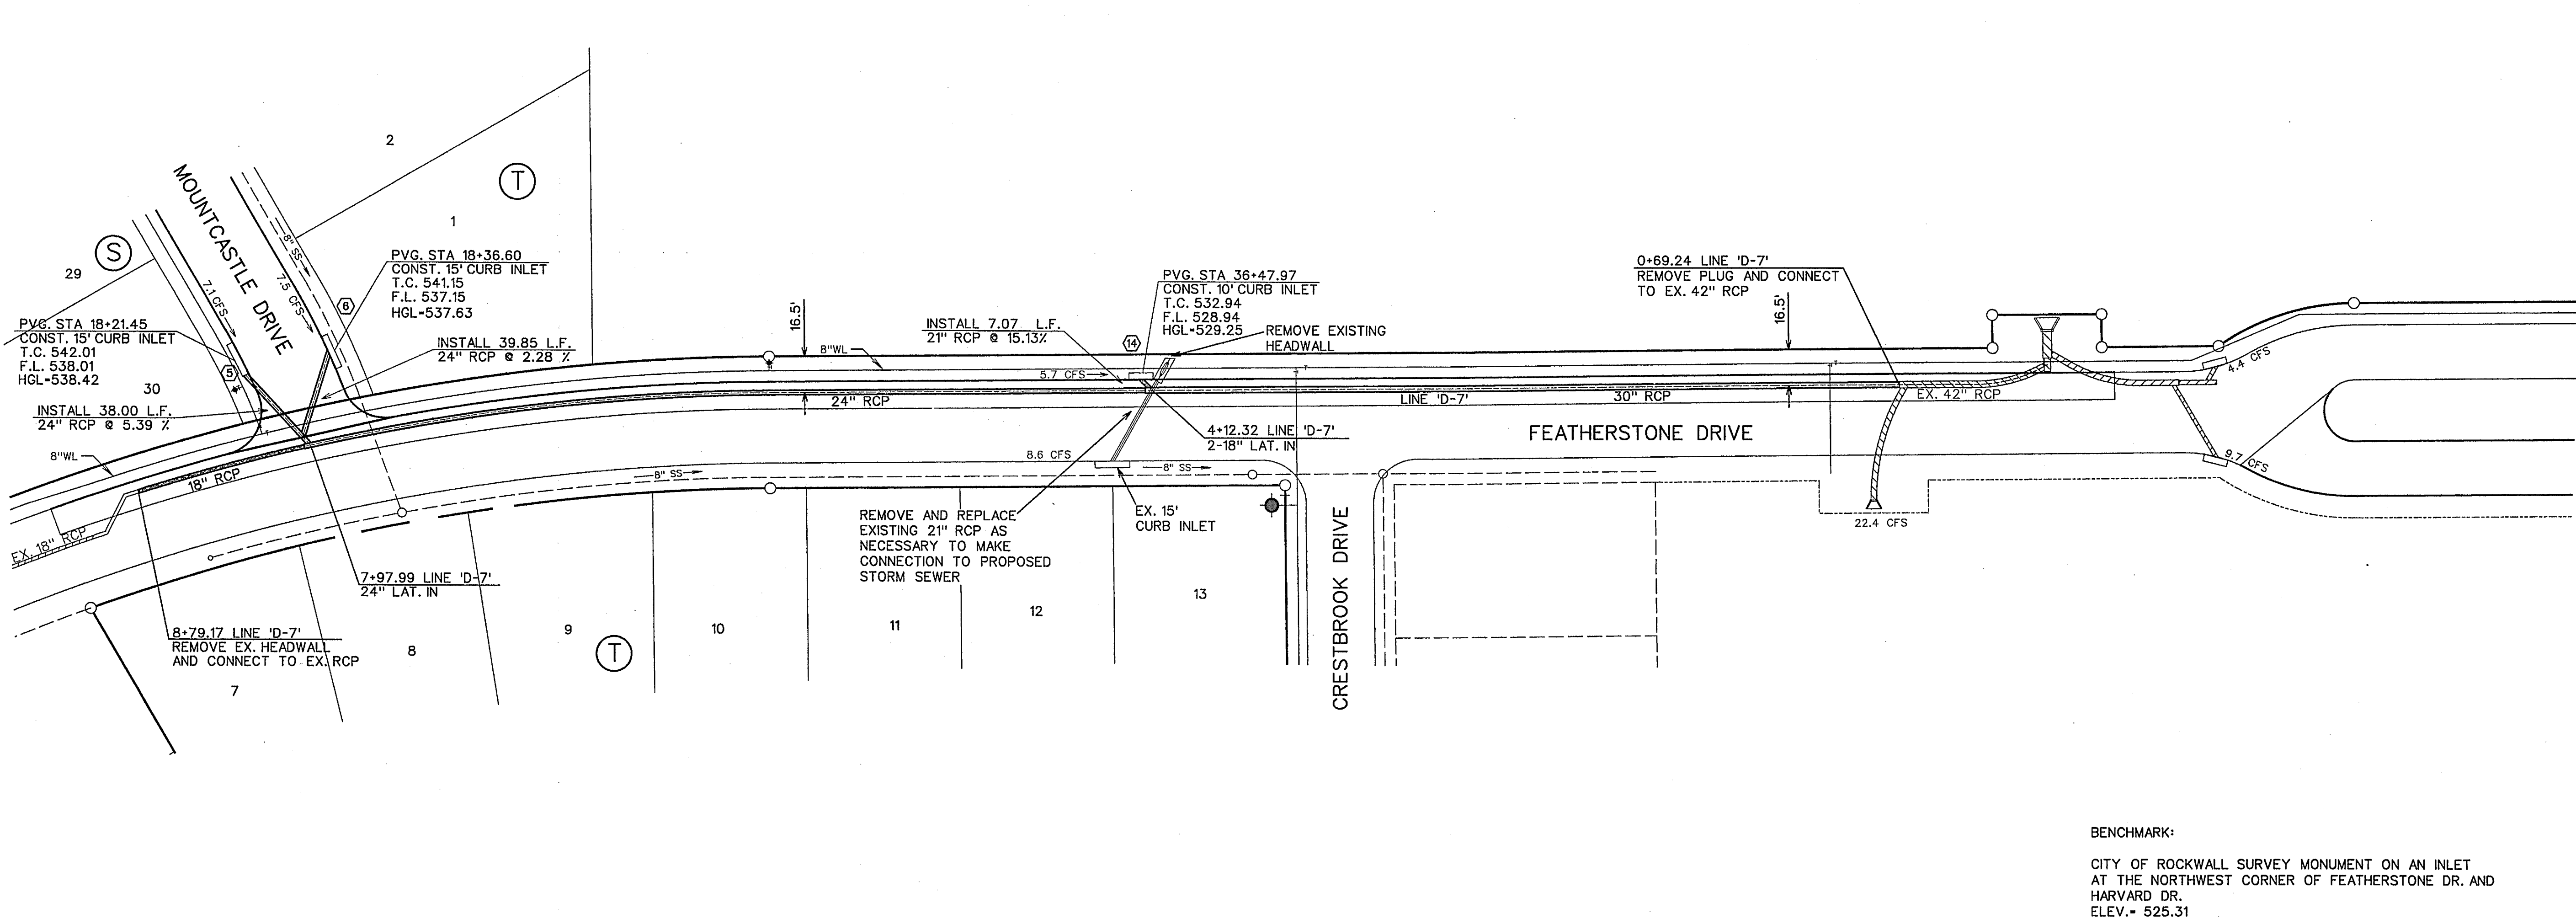

- LEGEND**
- (B) - BLOCK LABEL
 - (19) - INLET NUMBER
 - (1) - CURVE NUMBER
 - - SANITARY SEWER
 - ⊕ - WATER
 - ==== - PROPOSED STORM SEWER
 - ==== - EXISTING STORM SEWER
- BENCHMARK:**
 CITY OF ROCKWALL SURVEY MONUMENT ON AN INLET
 AT THE NORTHWEST CORNER OF FEATHERSTONE DR. AND
 HARVARD DR.
 ELEV.- 525.31

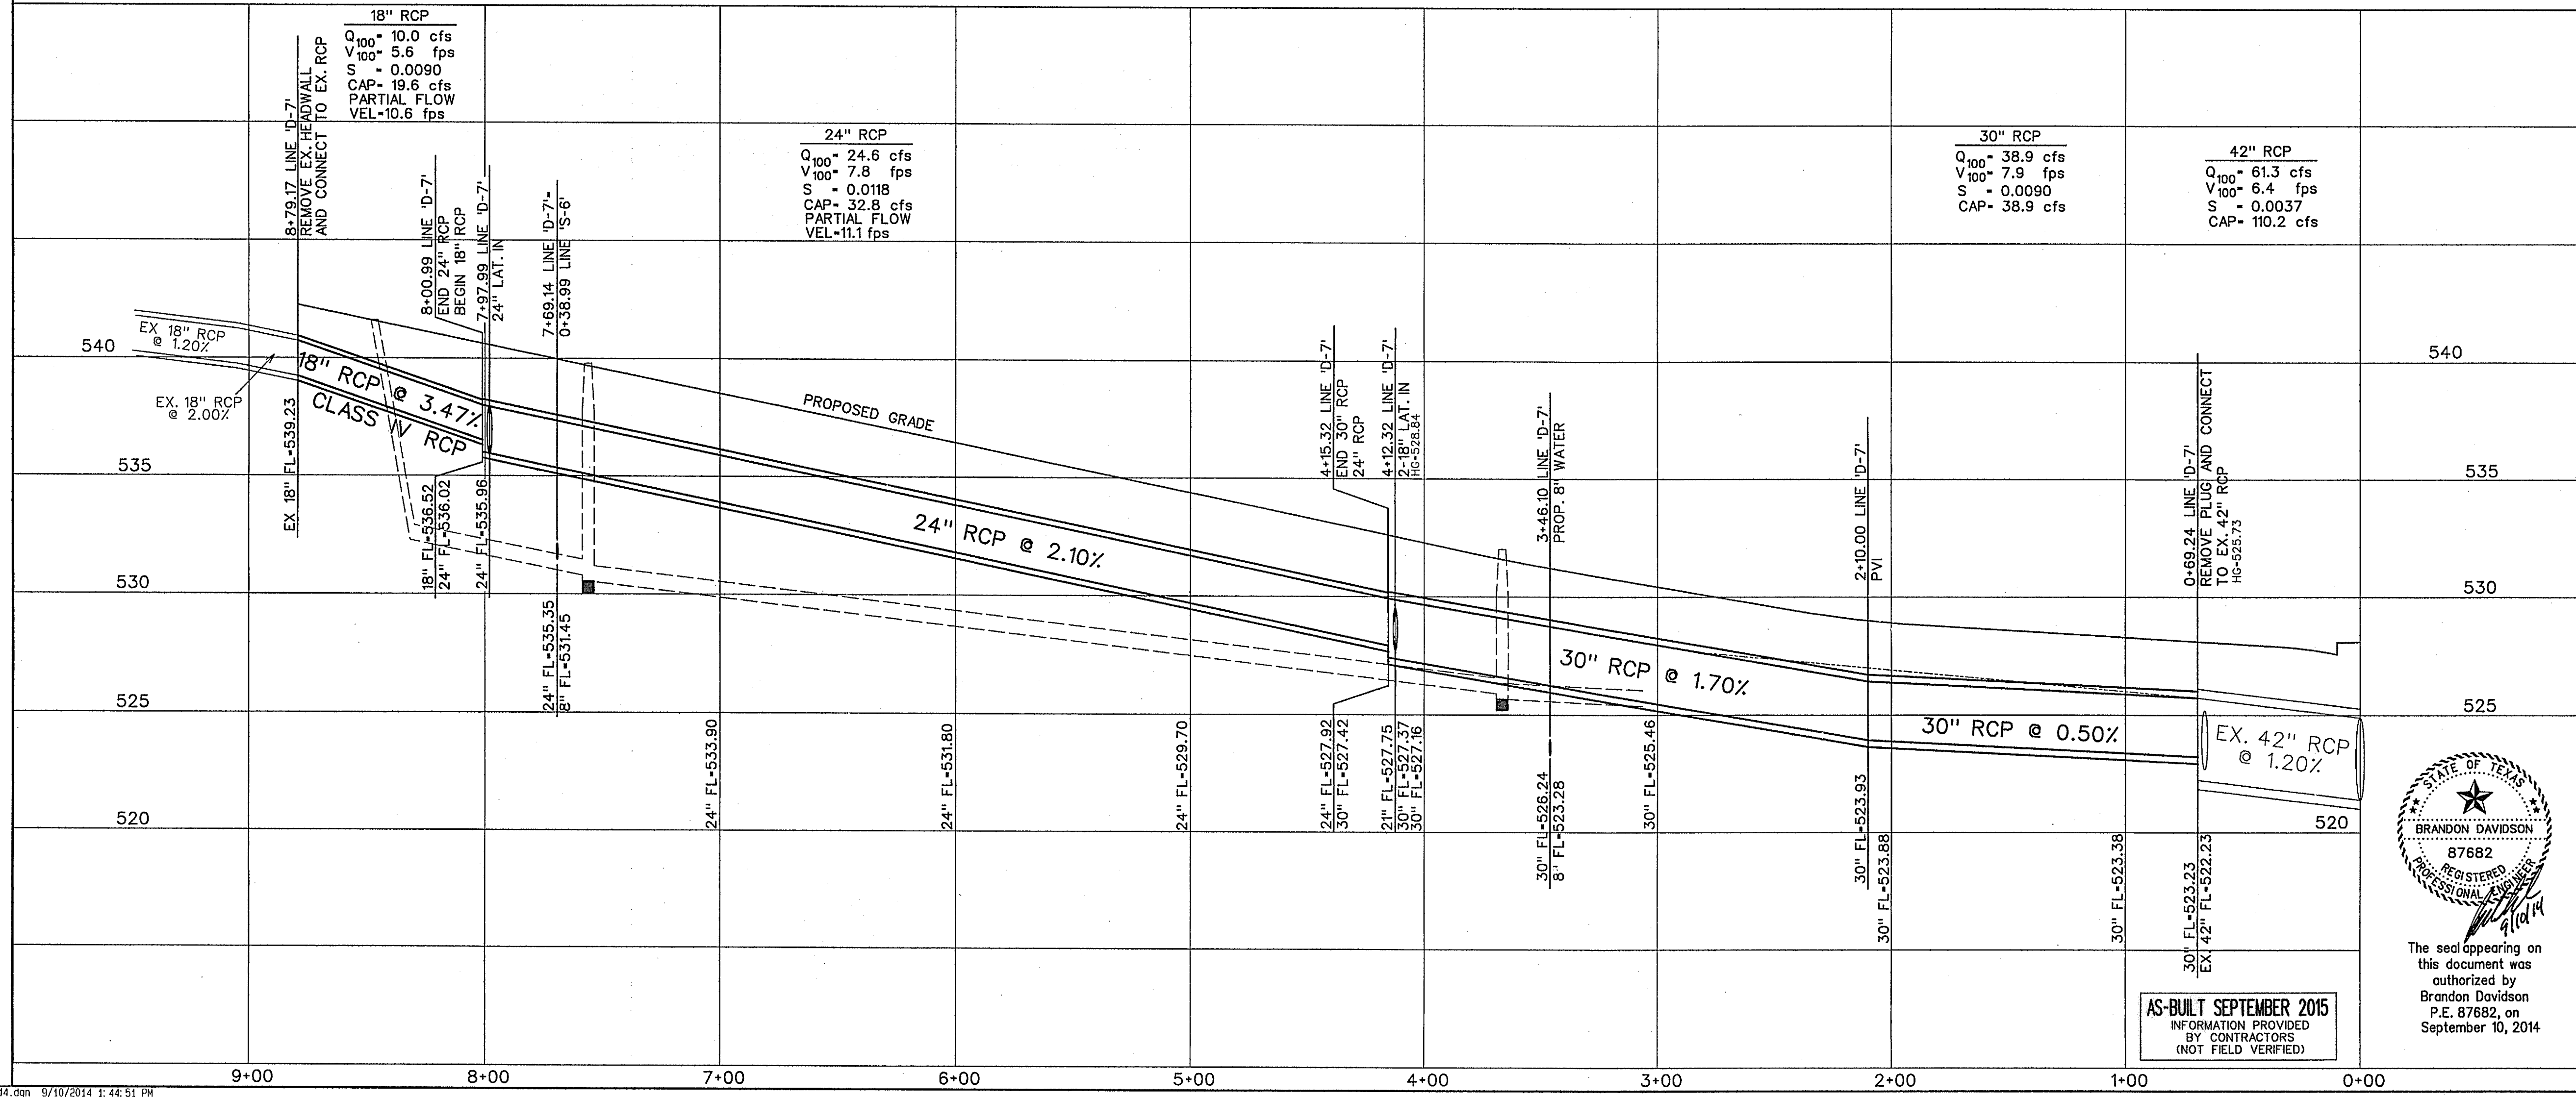

CORWIN ENGINEERING, INC.
 200 W. BELMONT, SUITE E
 ALLEN, TEXAS 75013 (972)396-1200
 TBPE FIRM #5951


**DEVELOPMENT PLANS FOR
 STONE CREEK
 PHASE VI
 ROCKWALL, TEXAS**

**STORM SEWER PLAN AND PROFILE
 LINE 'D-7'**

DRAWN BY	DESIGNED BY	CHECKED BY	SHEET NO.
13068	MAY 2014	SCALE: HOR: 1"=40' VER: 1"=4'	21 of 26



AS-BUILT SEPTEMBER 2015
 INFORMATION PROVIDED
 BY CONTRACTORS
 (NOT FIELD VERIFIED)

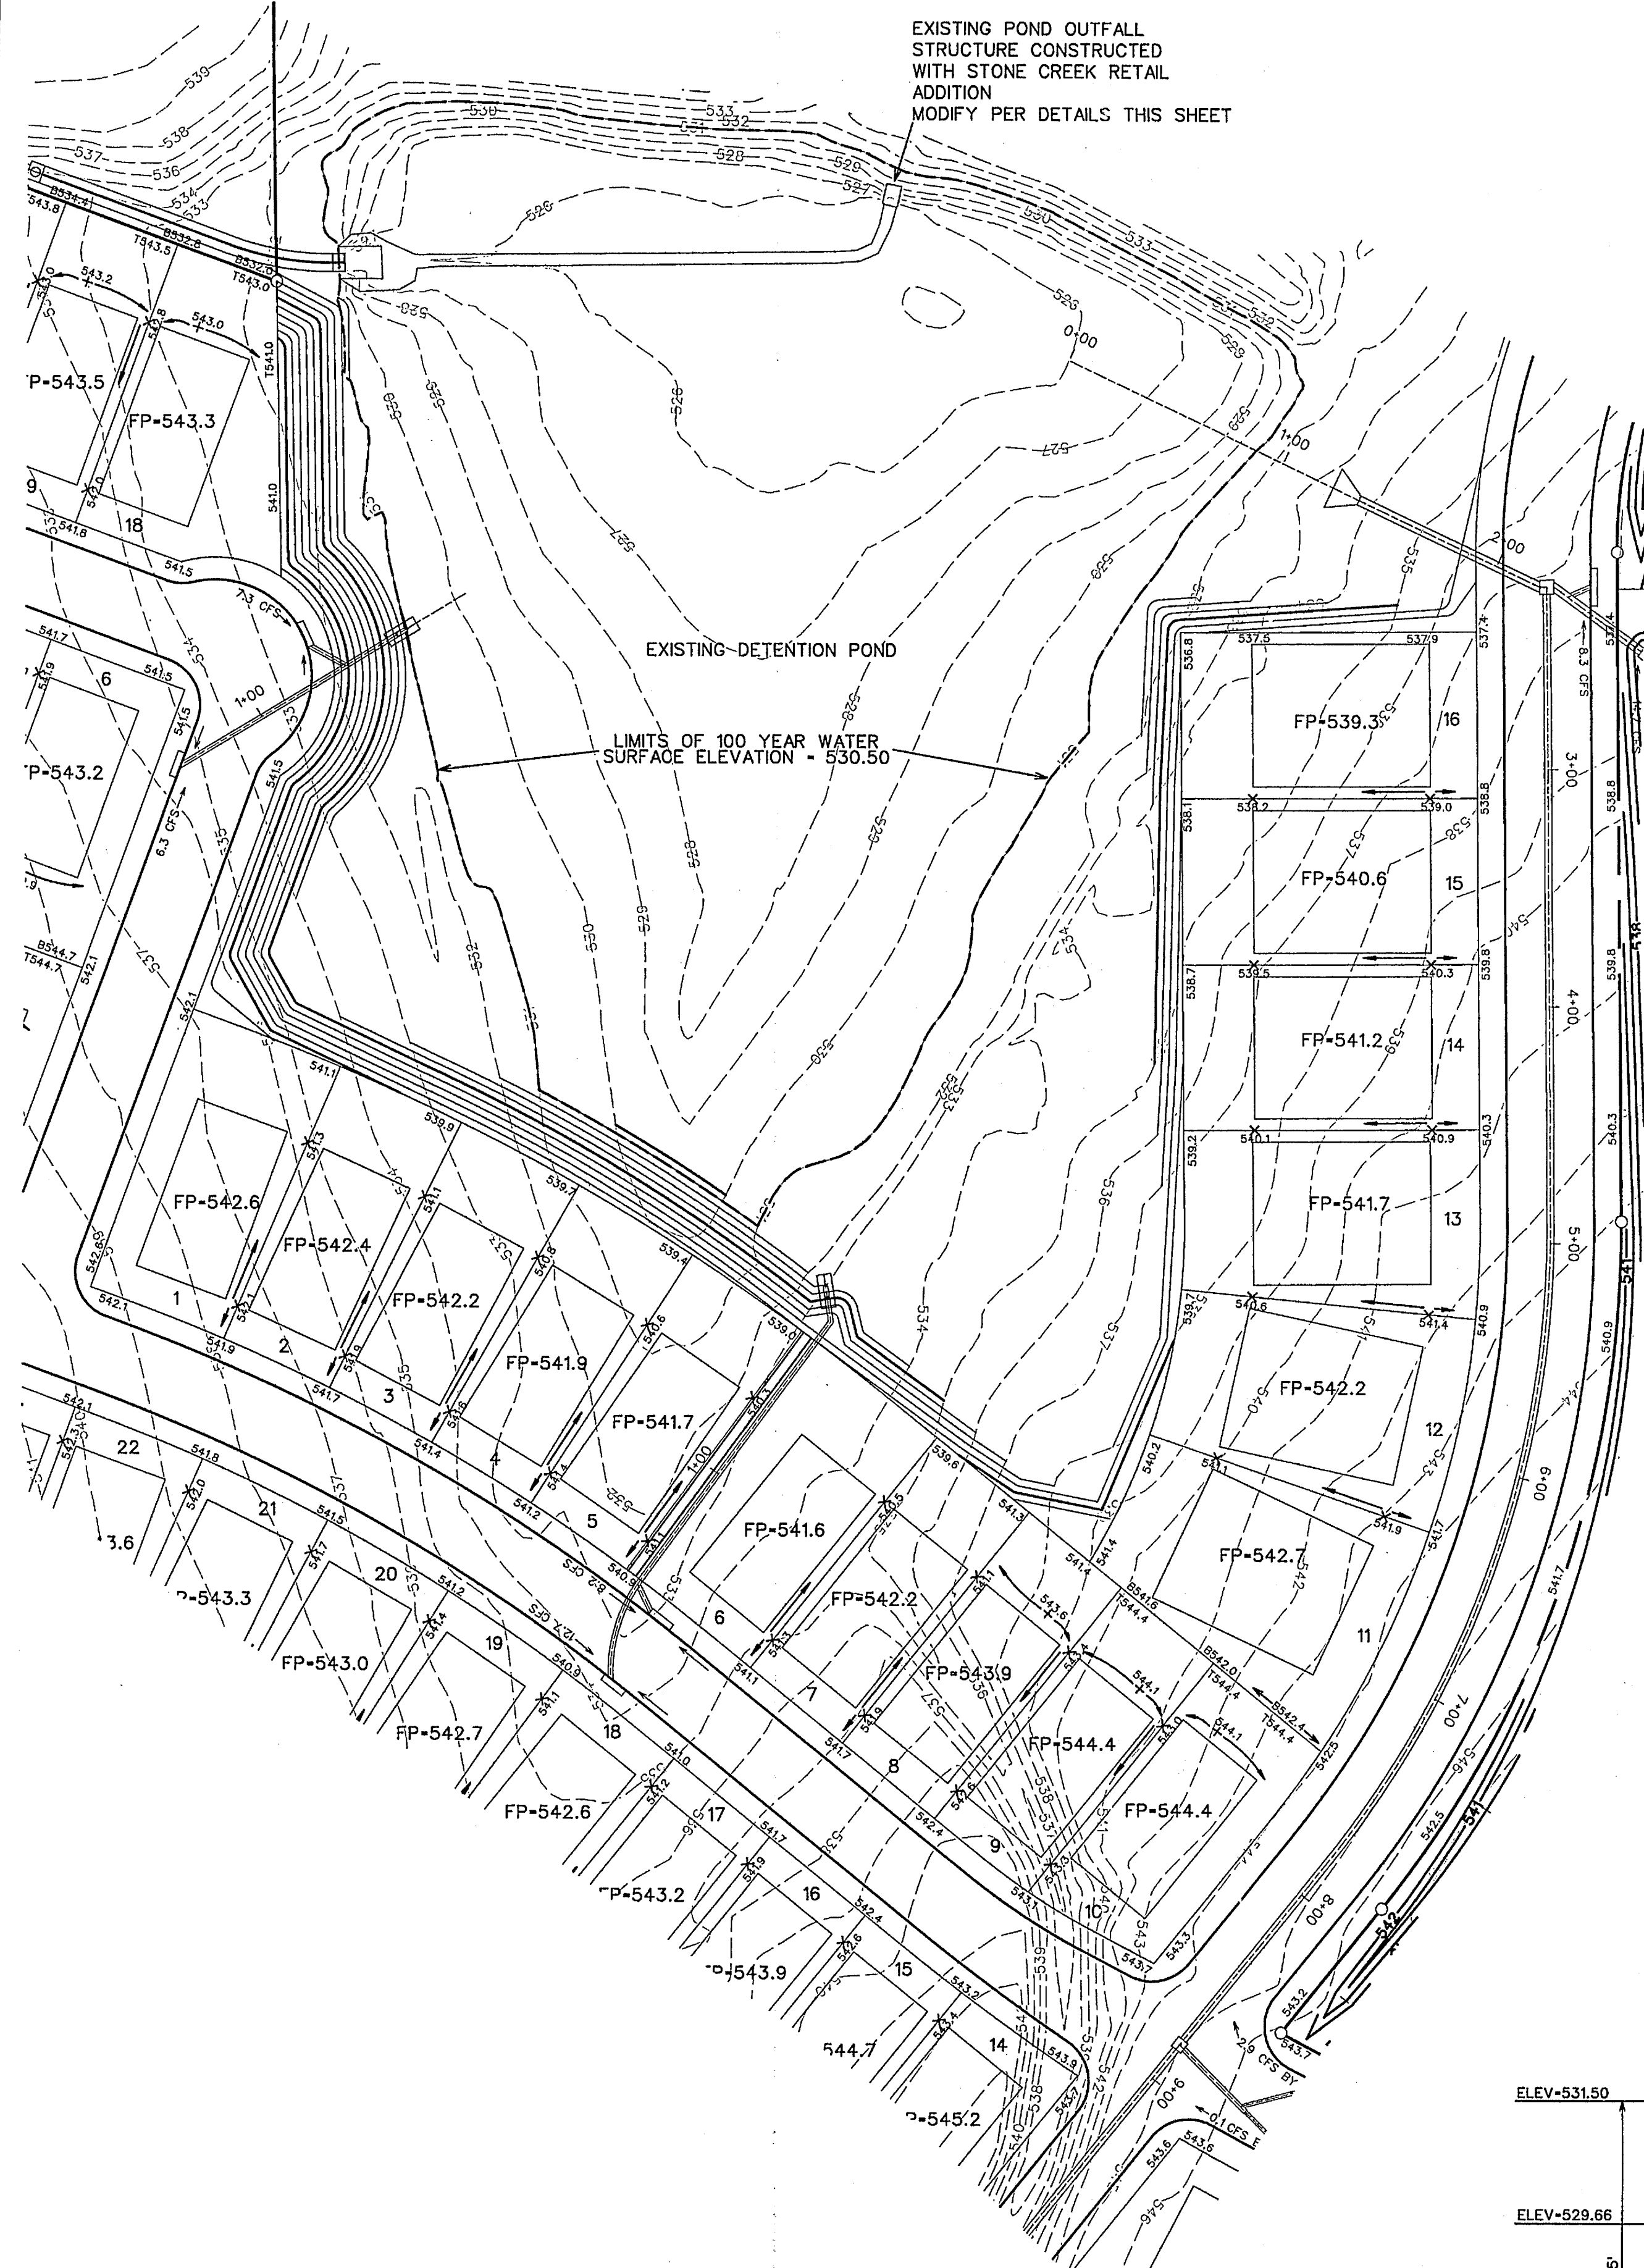

EXISTING POND OUTFALL STRUCTURE CONSTRUCTED WITH STONE CREEK RETAIL ADDITION MODIFY PER DETAILS THIS SHEET

EXISTING DETENTION POND

LIMITS OF 100 YEAR WATER SURFACE ELEVATION - 530.50

DETENTION POND CALCULATIONS
SEE MEMORANDUM TO CITY OF ROCKWALL FROM CORWIN ENGINEERING, INC. DATED JUNE 17, 2014, FOR MORE DETAILED EXPLANATION OF THE NEED FOR UPDATED DETENTION CALCULATIONS.

REVISED DRAINAGE AREAS TO POND

RUNOFF CALCULATIONS - DEVELOPED CONDITIONS

Area ID	Area (sf)	Area (acres)	Proposed Use	Runoff Coefficient	CA	Tc (min)	Rainfall Intensity (in/hr)	Q (cfs)	Comment
A	941551	21.62	Commercial	0.50	18.45	10	9.6	190.6	To Detention Pond
B	607116	13.81	Single-Family	0.50	6.91	10	9.6	67.7	To Detention Pond
C	207002	4.73	Park	0.35	1.68	20	8.3	13.8	To Detention Pond
D	165086	3.79	Park	0.35	1.33	20	8.3	11.0	Bypass
E	103946	2.39	Single-Family	0.50	1.19	10	9.6	11.7	Bypass
F	66788	1.51	Single-Family	0.50	0.76	10	9.6	7.4	Bypass
G	149476	3.43	School	0.70	2.40	10	9.6	23.5	To Detention Pond
H	285440	6.56	Single-Family	0.50	2.93	10	9.6	28.7	To Detention Pond
Area to Detention Pond				49.48	CA to Detention Pond	33.36	Weighted Cc = 0.67		

100 Year Downstream Culvert Capacity = 148.0 cfs
Bypass flow = 11.0 cfs
11.7 cfs
7.4 cfs
118.9 cfs

100-Year Pond Release Rate

50 Year Downstream Culvert Capacity = 134.6 cfs
Bypass flow = 9.9 cfs
10.7 cfs
6.8 cfs
107.1 cfs

50-Year Pond Release Rate

25 Year Downstream Culvert Capacity = 118.4 cfs
Bypass flow = 8.8 cfs
9.9 cfs
6.3 cfs
93.5 cfs

25-Year Pond Release Rate

10 Year Downstream Culvert Capacity = 105.9 cfs
Bypass flow = 7.8 cfs
8.5 cfs
5.4 cfs
84.2 cfs

10-Year Pond Release Rate

Elevation/Storage Table From Topographic Survey

Elevation (ft)	Area (sq. ft.)	Incremental Volume (cu. ft.)	Cumulative Volume (cu. ft.)
525	0	0	0
526	18907	9454	9454
527	41042	29975	39429
528	60891	50867	90296
529	70597	69644	159940
530	99043	88820	248760
531	120391	109717	358477
532	142155	131273	489750

Office #1 42" Wide x 35" tall, FL=525.0
Office #2 40" Wide x 8.5" Tall, FL=529.66
Office #3 11" Wide by 1" Tall, FL=530.0

Stage-Discharge Table

Stage	Orifice 1			Orifice 2			Orifice 3			Total Discharge	Allowable Discharge	Above (Below)
	H	Area	Discharge	H	Area	Discharge	H	Area	Discharge			
525.00	0	0	0	-	-	-	-	-	-	0.0		
526.00	0.50	3.50	11.9	-	-	-	-	-	-	11.9		
527.00	1.00	7.00	33.7	-	-	-	-	-	-	33.7		
528.00	1.48	10.20	69.3	-	-	-	-	-	-	69.3		
529.00	2.46	19.20	171.0	-	-	-	-	-	-	171.0		
529.45	2.91	10.20	63.7	-	-	-	-	-	-	63.7	84.2	(0.53) 10-year
529.66	3.12	10.20	66.8	-	-	-	-	-	-	66.8		
529.97	3.43	10.20	91.0	0.16	1.03	2.0	-	-	-	92.9	93.5	(0.56) 25-year
530.00	3.46	10.20	91.4	0.17	1.13	2.2	-	-	-	93.6		
530.26	3.72	10.20	94.8	0.25	2.98	5.7	0.13	2.90	5.1	106.6	107.1	(1.53) 50-year
530.50	3.98	10.20	97.7	0.49	2.36	8.0	0.25	5.50	13.2	116.9	118.9	0.00 100-year
531.00	4.46	10.20	103.7	0.99	2.36	11.3	0.50	11.00	37.5	152.5		
531.50	4.95	10.20	109.4	1.49	2.36	13.9	1.00	11.00	53.0	176.2		

Elevation Calculations

Event	Allowed Release Rate	Actual Release Rate	Storage Requirement	Occurs at Elevation
10-year	84.2	83.7	198680	529.45
25-year	93.5	92.9	245485	529.97
50-year	107.1	105.6	277682	530.26
100-year	118.9	118.9	303347	530.50

POND STORAGE CALCULATIONS

DETENTION CALCULATIONS - 10 Year

Storm Duration	Outflow Duration	Area (AC)	Future "C"	Future "KF"	Future "CA"	Rainfall Intensity	Inflow (cfs)	Volume (cu. ft.)	Volume (cu. ft.)	Volume (cu. ft.)	Volume (acre-ft.)	Outflow (cfs)
10	20	49.48	0.67	1.00	33.36	7.10	236.8	142103	50225	91878	2.11	83.7
20	30	49.48	0.67	1.00	33.36	5.90	186.6	236172	75537	160334	3.69	83.7
30	40	49.48	0.67	1.00	33.36	4.80	161.1	289210	100450	187760	4.31	83.7
40	50	49.48	0.67	1.00	33.36	4.00	133.4	320233	125662	194671	4.47	83.7
50	60	49.48	0.67	1.00	33.36	3.50	116.8	350255	150675	199580	4.58	83.7
60	70	49.48	0.67	1.00	33.36	3.00	100.1	360262	175767	184475	4.23	83.7
70	80	49.48	0.67	1.00	33.36	2.80	93.4	392285	200869	191386	4.39	83.7
80	90	49.48	0.67	1.00	33.36	2.60	86.7	416303	225912	190391	4.37	83.7
90	100	49.48	0.67	1.00	33.36	2.50	83.4	450327	251214	199203	4.57	83.7
100	110	49.48	0.67	1.00	33.36	2.30	76.7	460335	276237	184098	4.23	83.7
110	120	49.48	0.67	1.00	33.36	2.20	73.4	484352	301349	183903	4.20	83.7
120	130	49.48	0.67	1.00	33.36	2.10	70.1	504367	326462	177905	4.08	83.7
130	140	49.48	0.67	1.00	33.36	2.00	66.7	520378	351574	168904	3.98	83.7
140	150	49.48	0.67	1.00	33.36	1.90	63.4	532387	376686	155701	3.57	83.7

DETENTION CALCULATIONS - 25 Year


Storm Duration	Outflow Duration	Area (AC)	Future "C"	Future "KF"	Future "CA"	Rainfall Intensity	Inflow (cfs)	Volume (cu. ft.)	Volume (cu. ft.)	Volume (cu. ft.)	Volume (acre-ft.)	Outflow (cfs)
10	20	49.48	0.67	1.00	33.36	8.30	276.9	165121	55750	110771	2.53	92.9
20	30	49.48	0.67	1.00	33.36	6.80	220.2	264192	83650	180567	4.15	92.9
30	40	49.48	0.67	1.00	33.36	5.50	183.5	330240	111500	219740	5.02	92.9
40	50	49.48	0.67	1.00	33.36	4.60	153.4	368268	139375	228892	5.25	92.9
50	60	49.48	0.67	1.00	33.36	4.00	133.4	400291	167251	233041	5.35	92.9
60	70	49.48	0.67	1.00	33.36	3.50	116.8	423356	195260	225160	5.17	92.9
70	80	49.48	0.67	1.00	33.36	3.00	100.1	452336	223501	239336	5.49	92.9
80	90	49.48	0.67	1.00	33.36	3.10	103.4	498361	250876	245485	5.64	92.9
90	100	49.48	0.67	1.00	33.36	2.90	96.7	522380	278751	243629	5.59	92.9
100	110	49.48	0.67	1.00	33.36	2.70	90.1	540393	306626	233767	5.37	92.9
110	120	49.48	0.67	1.00	33.36	2.50	83.4	550400	334501	215899	4.96	92.9
120	130	49.48	0.67	1.00	33.36	2.40	80.1	576419	362376	214043	4.91	92.9
130	140	49.48	0.67	1.00	33.36	2.30	76.7	598435	390251	208184	4.78	92.9
140	150	49.48	0.67	1.00	33.36	2.20	73.4	616448	418126	188322	4.55	92.9

DETENTION CALCULATIONS - 50 Year

Storm Duration	Outflow Duration	Area (AC)	Future "C"	Future "KF"	Future "CA"	Rainfall Intensity	Inflow (cfs)	Volume (cu. ft.)	Volume (cu. ft.)	Volume (cu. ft.)	Volume (acre-ft.)	Outflow (cfs)
10	20	49.48	0.67	1.00	33.36	9.00	300.2	180131	63350	116781	2.68	105.6
20	30	49.48	0.67	1.00	33.36	7.50	250.2	300218	95025	205193	4.71	105.6
30	40	49.48	0.67	1.00	33.36	6.10	203.5	366266	126700	238566	5.50	105.6
40	50	49.48	0.67	1.00	33.36	5.20	173.5	416303	158375	257929	5.92	105.6
50	60	49.48	0.67	1.00	33.36	4.50	150.1	450327	193350	260278	5.98	105.6
60	70	49.48	0.67	1.00	33.36	3.80	130.1	488341	221725	246416	5.69	105.6
70	80	49.48	0.67	1.00	33.36	3.70	123.4	518377	253400	248977	6.08	105.6
80	90	49.48	0.67	1.00	33.36	3.50	116.8	560408	285075	275333	6.32	105.6
90	100	49.48	0.67	1.00	33.36	3.30	110.1	594432	316750	277682	6.37	105.6
100	110	49.48	0.67	1.00	33.36	3.00	100.1	600437	348425	252172	5.79	105.6
110	120	49.48	0.67	1.00	33.36	2.80	93.4	616448	380100	236348	5.43	105.6
120	130	49.48	0.67	1.00	33.36	2.70	90.1	648472	411775	236697	5.43	105.6
130	140	49.48	0.67	1.00	33.36	2.60	86.7	676492	443450	233042	5.35	105.6
140	150	49.48	0.67	1.00	33.36	2.40	80.1	672489	475125	197364	4.53	105.6

DETENTION CALCULATIONS - 100 Year

Storm Duration	Outflow Duration	Area (AC)	Future "C"	Future "KF"	Future "CA"	Rainfall Intensity	Inflow (cfs)	Volume (cu. ft.)	Volume (cu. ft.)	Volume (cu. ft.)	Volume (acre-ft.)	Outflow (cfs)
10	20	49.48	0.67	1.00	33.36	9.80	326.9	196143	63350	116781	2.68	118.9
20	30	49.48	0.67	1.00	33.36	8.30	276.9	332242	107036	225206	5.17	118.9
30	40	49.48	0.67	1.00	33.36	6.80	220.2	414301	142714	271567	6.23	118.9
40	50	49.48	0.67	1.00	33.36	5.80	193.5	464335	175933	285045	6.56	118.9
50	60	49.48	0.67	1.00	33.36	5.00	166.8	500364	214072	286292	6.57	118.9
60	70	49.48	0.67	1.00	33.36	4.50	150.1	540393	249750	290463	6.67	118.9
70	80	49.48	0.67	1.00	33.36	4.10	136.8	574419	285429	288989	6.63	118.9
80	90	49.48	0.67	1.00	33.36	3.90	130.1	624454	321107	303347	6.98	118.9
90	100	49.48	0.67	1.00	33.36	3.60	120.1	648472	356766	291885	6.70	118.9
100	110	49.48	0.67	1.00	33.36	3.20	106.7	640466	392465	248901	5.69	118.9
110	120	49.48	0.67	1.00	33.36	2.80	93.4	616448	428143	188305	4.32	118.9
120	130	49.48	0.67	1.00	33.36	2.70	90.1	648472	463822	184630	4.24	118.9
130	140	49.48	0.67	1.00	33.36	2.60	86.7	678492	499500	176291	4.06</	




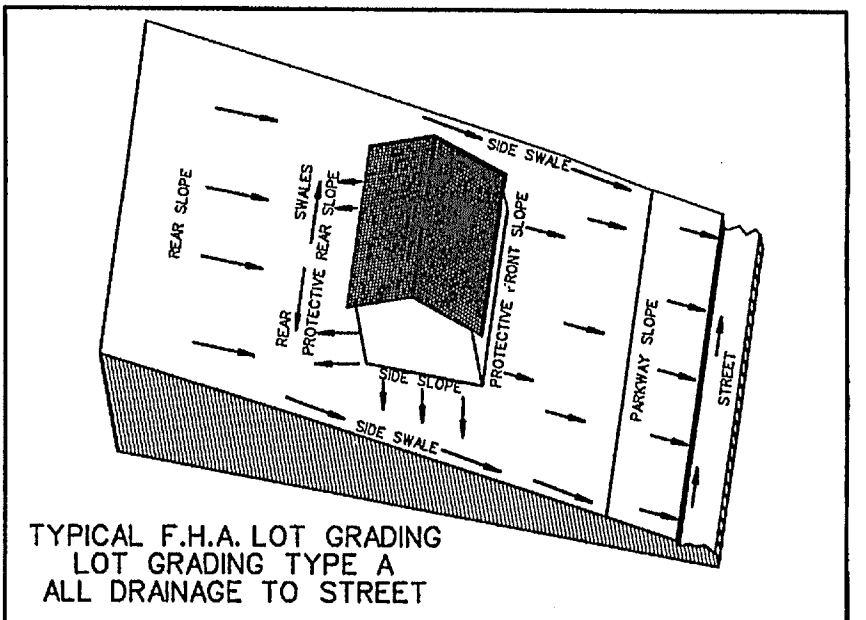


Note:
Each lot will need a detailed grading plan with building permit submittal. This is a general grading plan for site work only.

- Wall Notes:**
1. No part of the wall (footing, tie back etc. shall be const. offsite, in an easement or in the R.O.W. Walls must be on one property.
 2. All walls 4' or taller shall require a signed/sealed set of engineered drawings. Wall engineer shall submit signed/sealed letter prior to acceptance stating that the walls were constructed per drawings.
 3. All fill to be compacted to 95% std. density using a sheep's foot roller.


⊗ Driveway must be located on noted side.

- NOTES:**
1. Finish Floor Elevation to be 0.70 Feet above Finished Pad.(FP)
 2. Additional Erosion Control to be installed in Parkways as determined by the City Inspector.
 3. Finished Pad Elevations are within ± 0.3 Feet.
 4. No lot to lot drainage allowed.
 5. All fill to be min. 95% compaction using sheep's foot roller.

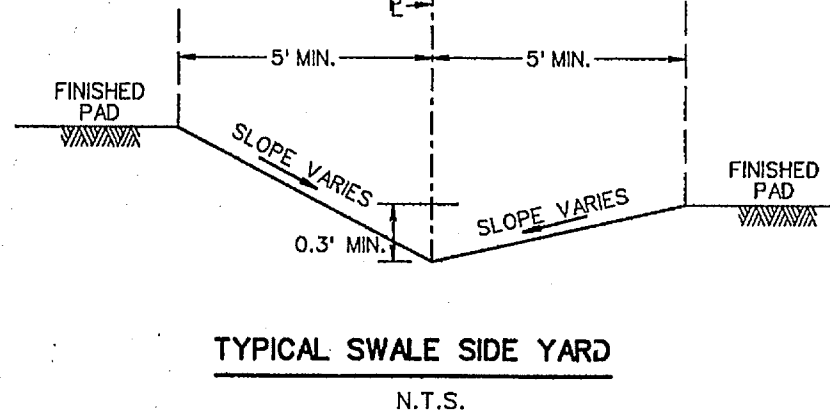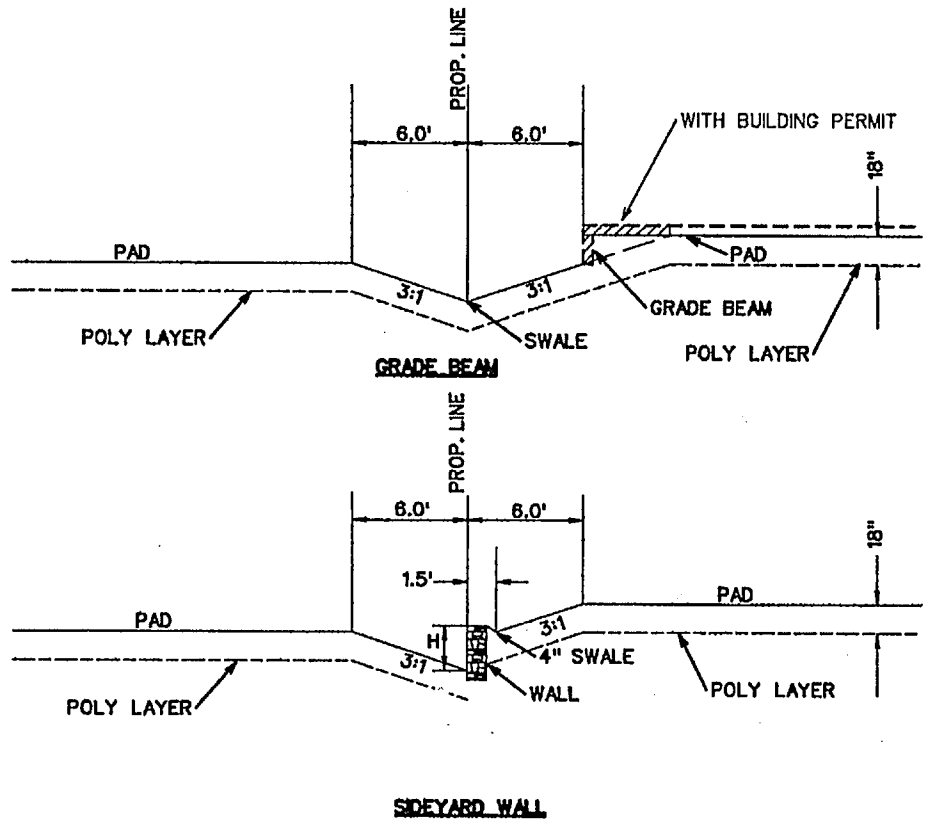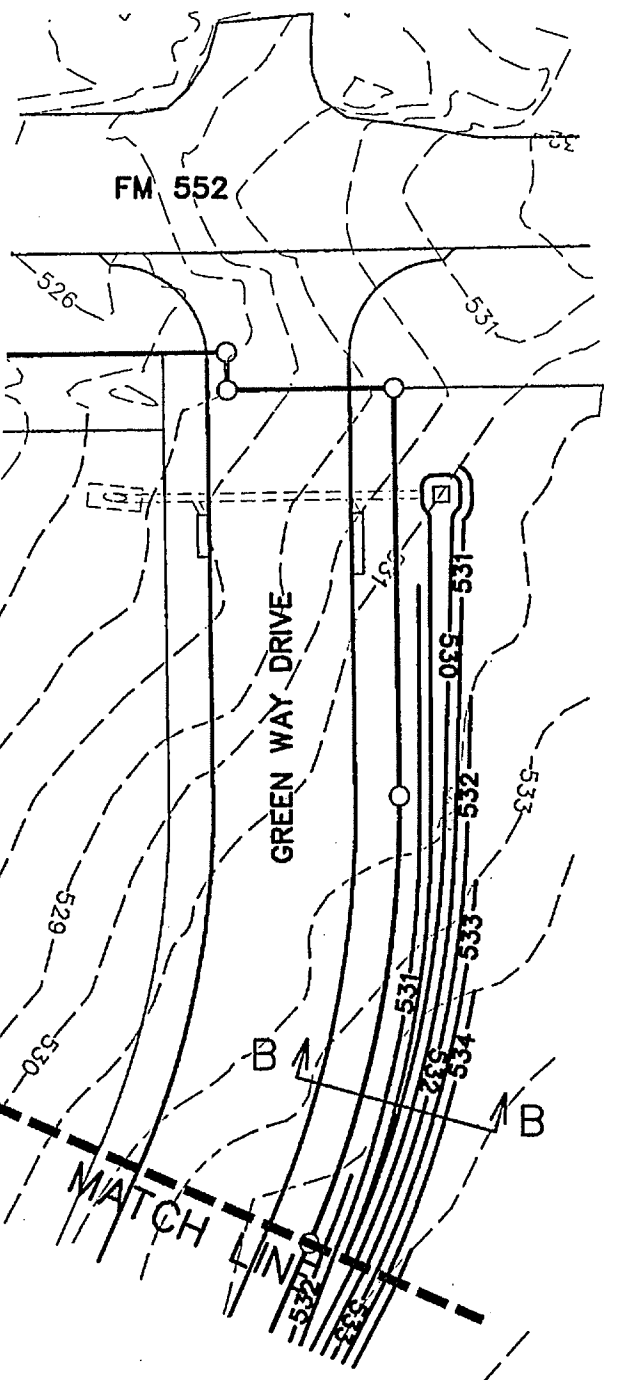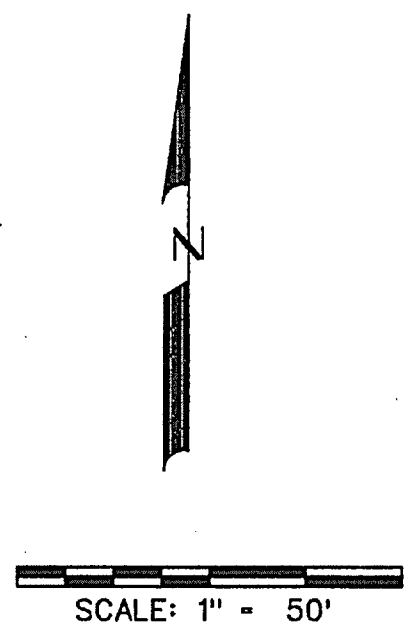


BENCHMARK:
CITY OF ROCKWALL SURVEY MONUMENT ON AN INLET AT THE NORTHWEST CORNER OF FEATHERSTONE DR. AND HARVARD DR.
ELEV. = 525.31

AS-BUILT SEPTEMBER 2015
INFORMATION PROVIDED BY CONTRACTORS (NOT FIELD VERIFIED)

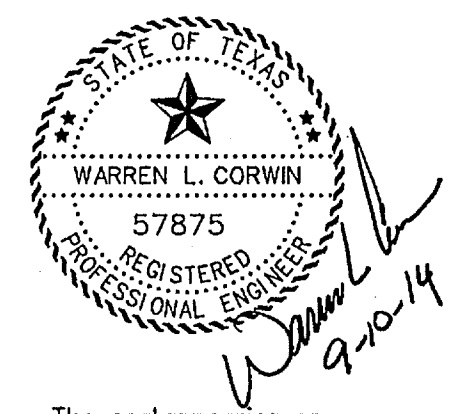

The seal appearing on this document was authorized by Warren L. Corwin, P.E. 57875, on September 10, 2014

<p>CORWIN ENGINEERING, INC. 200 W. BELMONT, SUITE E ALLEN, TEXAS 75013 (972)396-1200 TDP FIRM #5951</p>			
<p>DEVELOPMENT PLANS FOR STONE CREEK PHASE VI ROCKWALL, TEXAS</p>			
GRADING PLAN			
DRAWN BY	DESIGNED BY	CHECKED BY	SHEET NO.
JOB NUMBER	DATE	SCALE	23 OF 26
13068	MAY 2014	1" = 50'	

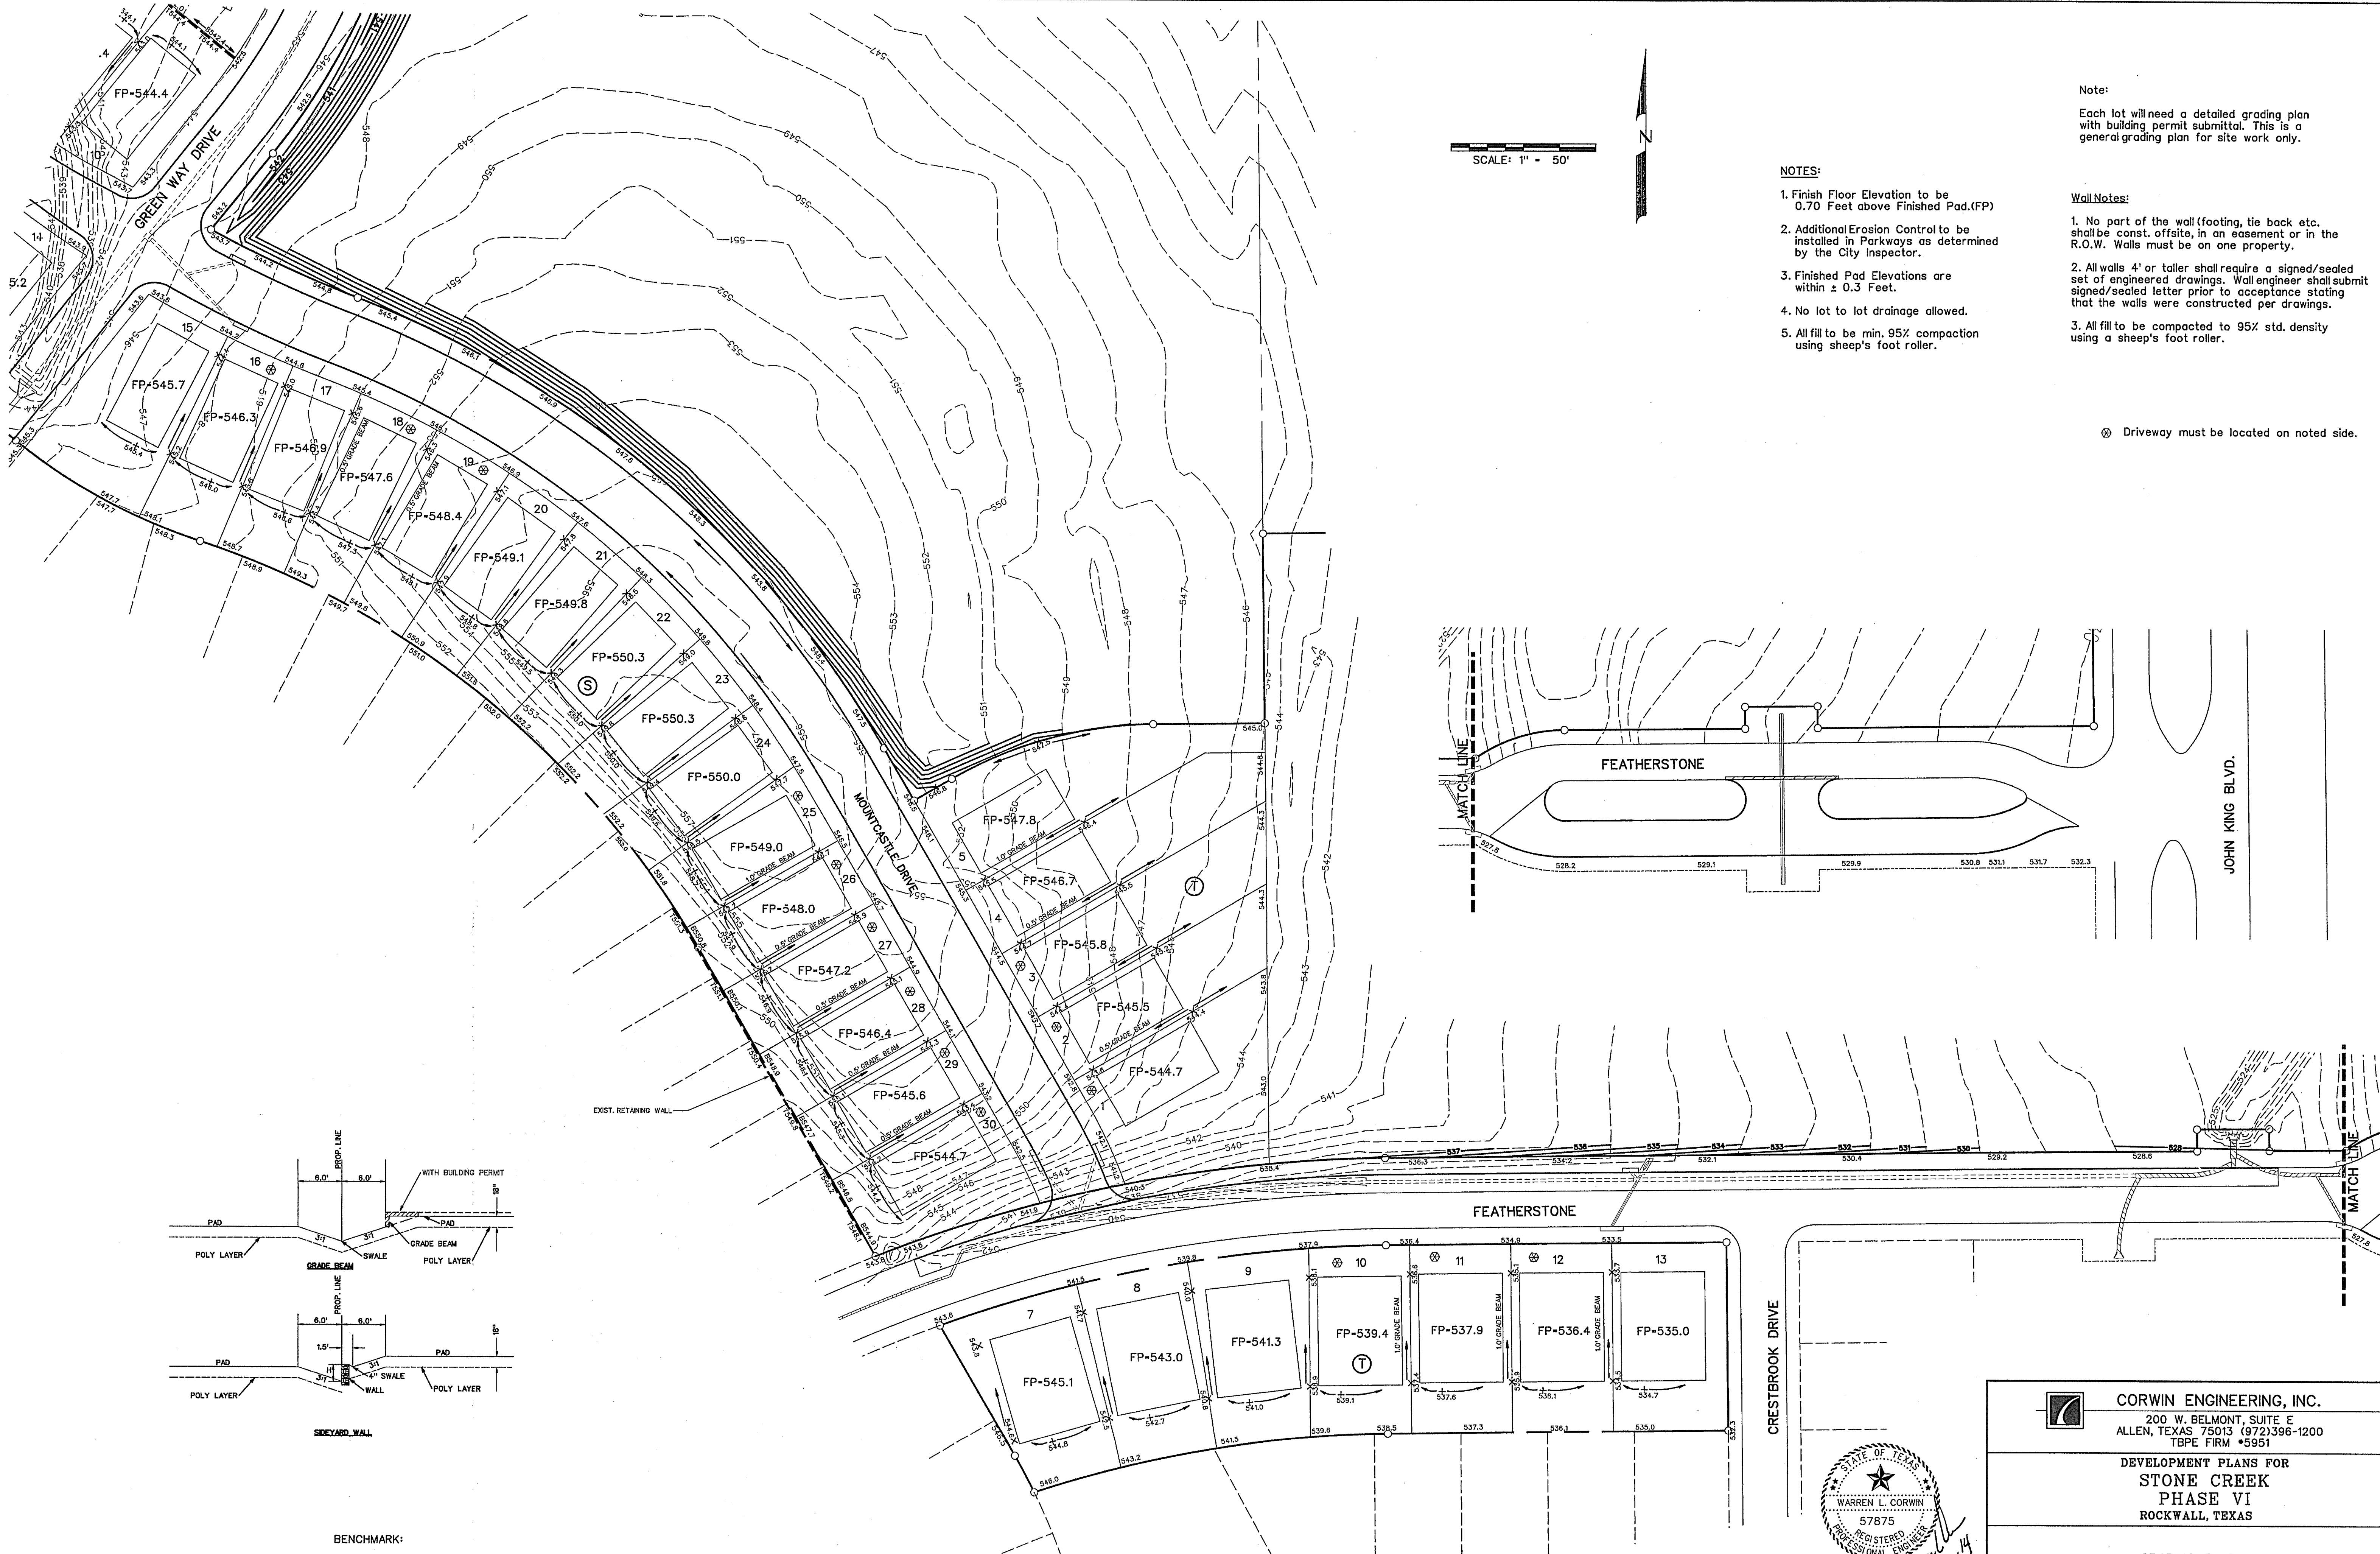

Note:
Each lot will need a detailed grading plan with building permit submittal. This is a general grading plan for site work only.


NOTES:

1. Finish Floor Elevation to be 0.70 Feet above Finished Pad.(FP)
2. Additional Erosion Control to be installed in Parkways as determined by the City Inspector.
3. Finished Pad Elevations are within ± 0.3 Feet.
4. No lot to lot drainage allowed.
5. All fill to be min. 95% compaction using sheep's foot roller.



Wall Notes:

1. No part of the wall (footing, tie back etc. shall be const. offsite, in an easement or in the R.O.W. Walls must be on one property.
2. All walls 4' or taller shall require a signed/sealed set of engineered drawings. Wall engineer shall submit signed/sealed letter prior to acceptance stating that the walls were constructed per drawings.
3. All fill to be compacted to 95% std. density using a sheep's foot roller.

⊗ Driveway must be located on noted side.

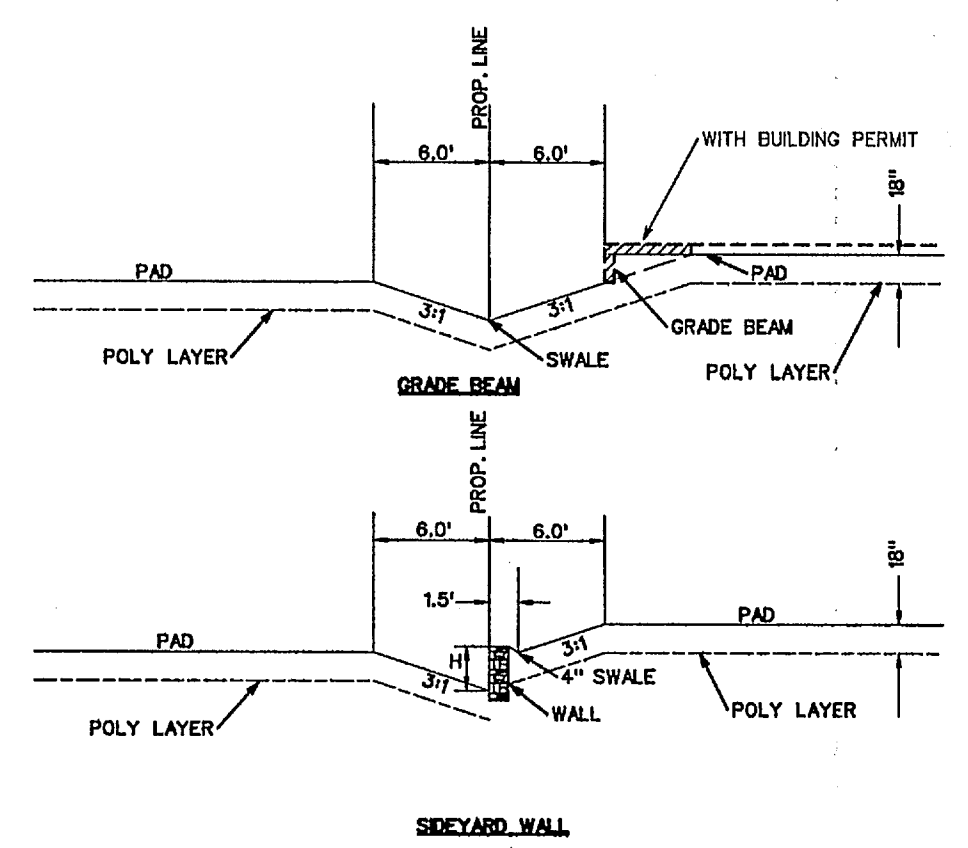


BENCHMARK:
CITY OF ROCKWALL SURVEY MONUMENT ON AN INLET AT THE NORTHWEST CORNER OF FEATHERSTONE DR. AND HARVARD DR. ELEV. = 525.31

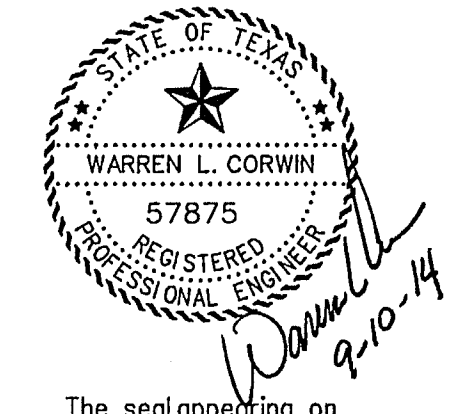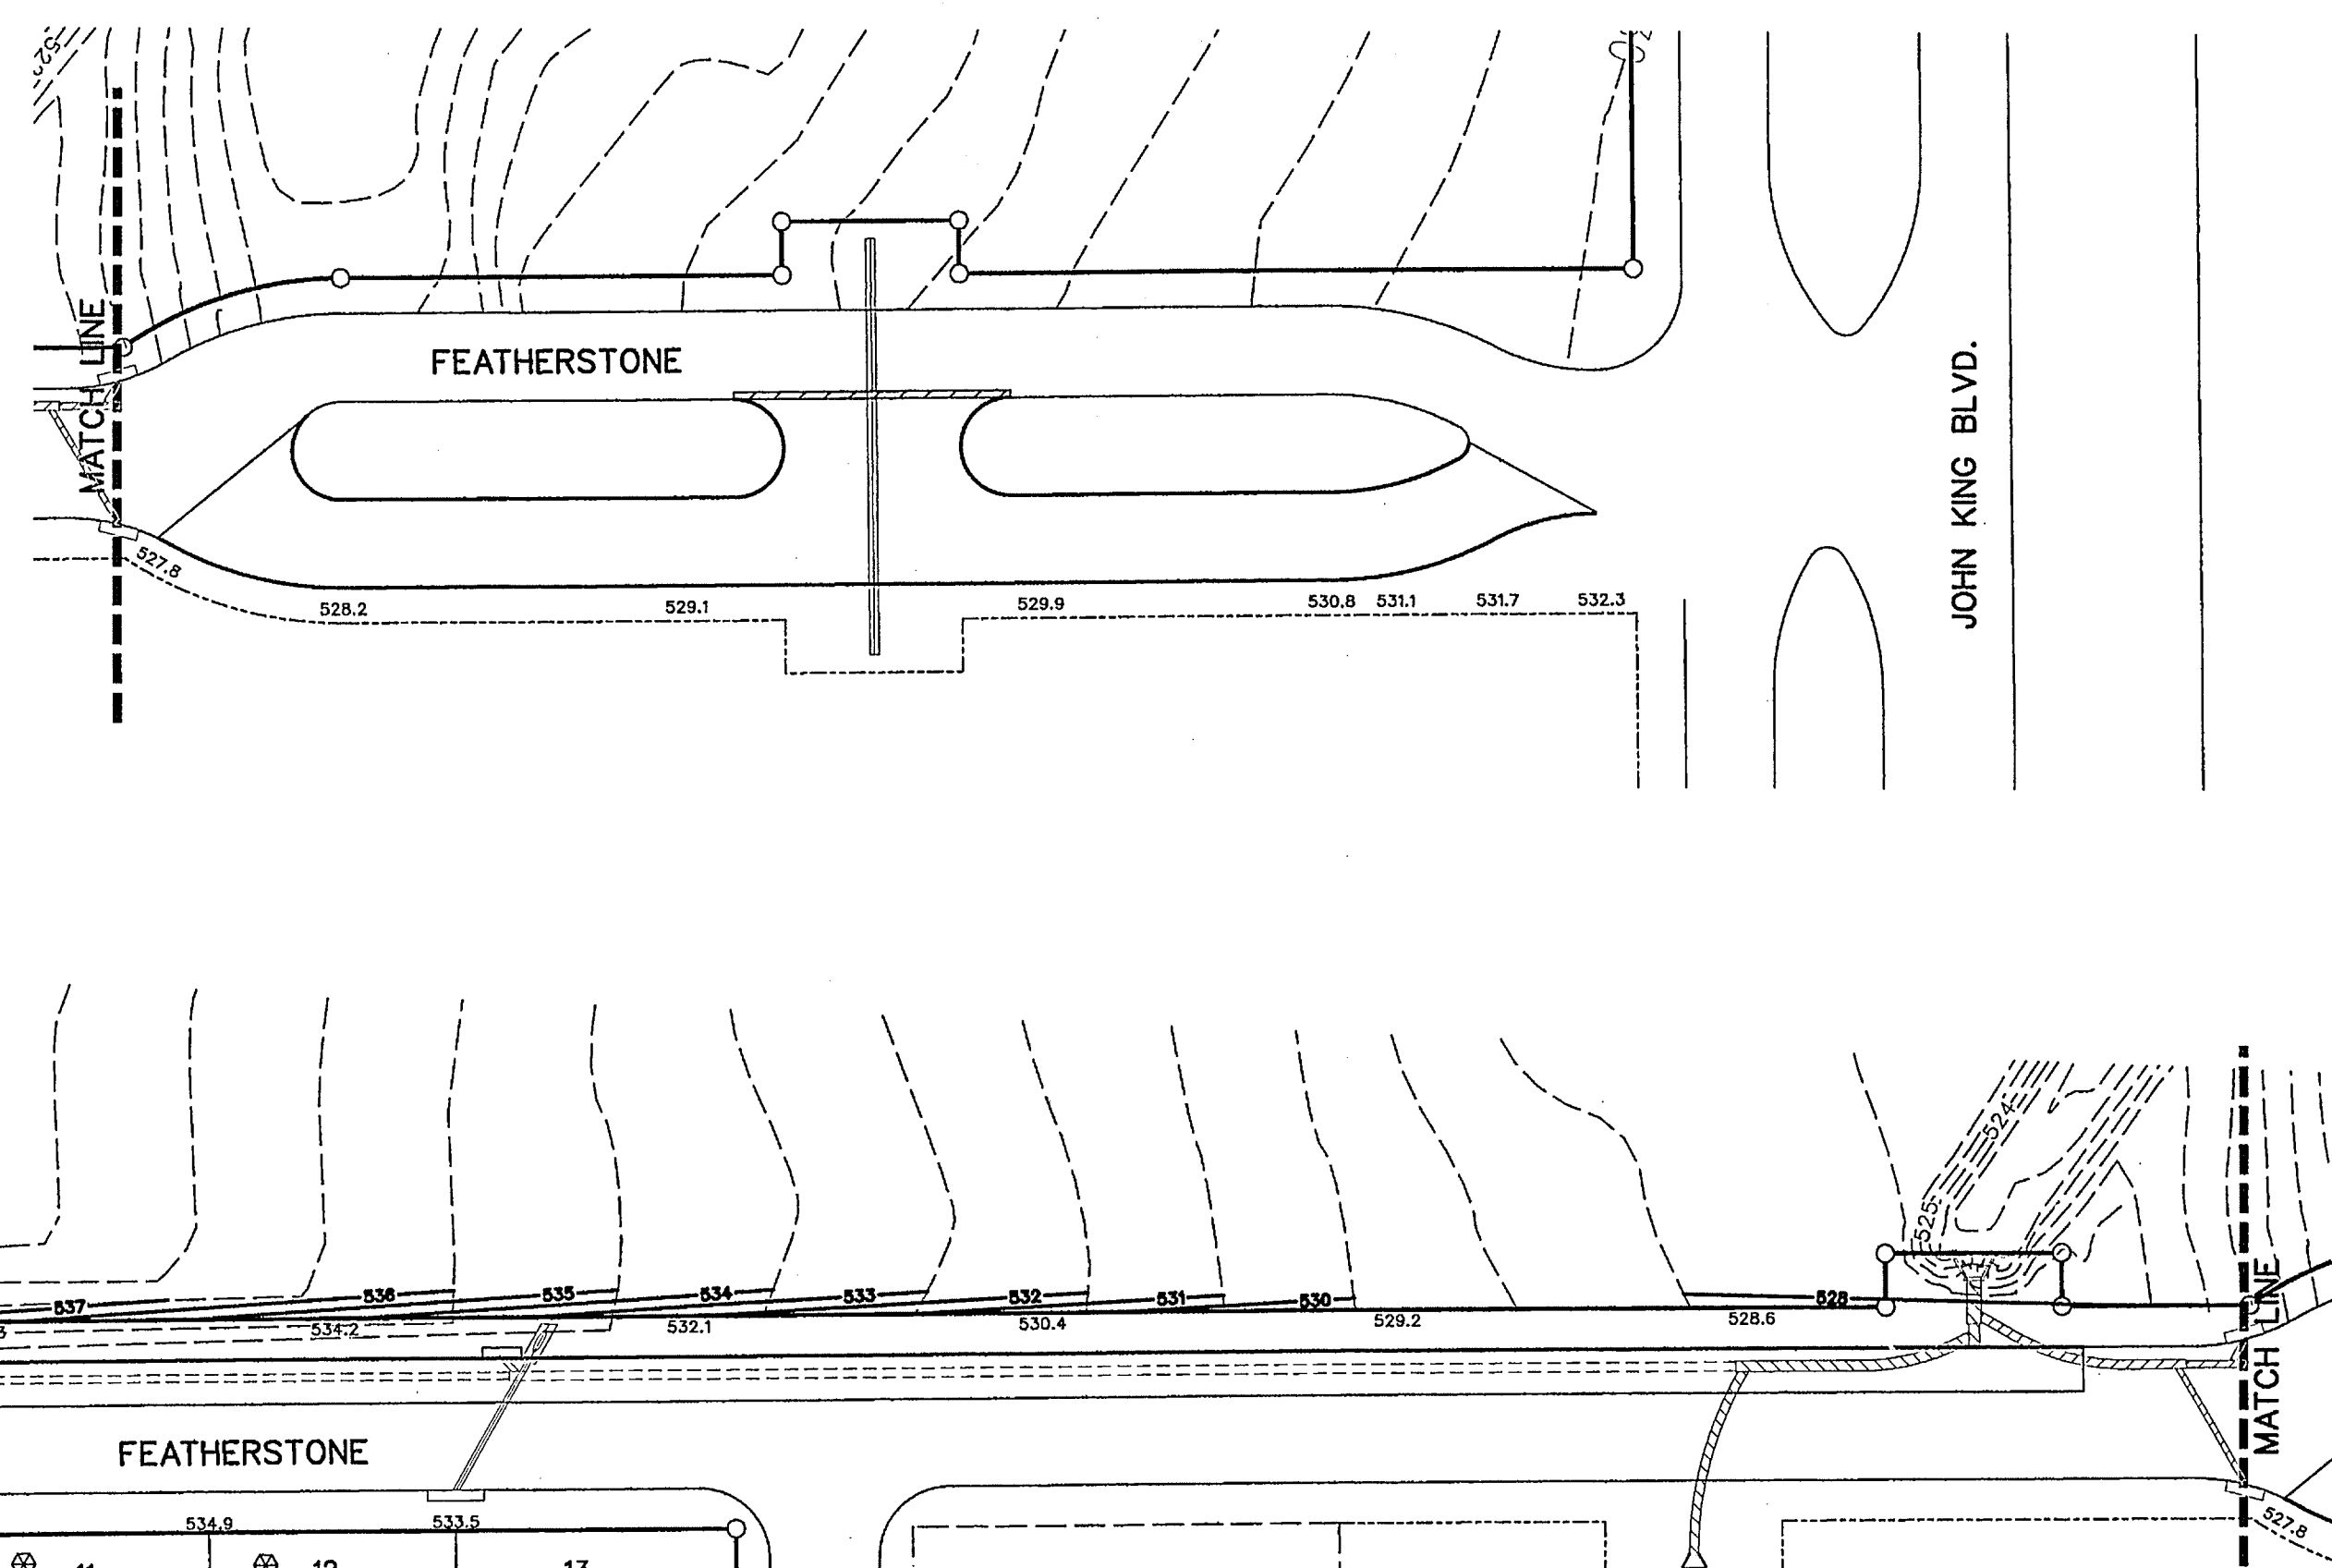

AS-BUILT SEPTEMBER 2015
INFORMATION PROVIDED BY CONTRACTORS (NOT FIELD VERIFIED)

The seal appearing on this document was authorized by Warren L. Corwin, P.E. 57875, on September 10, 2014


<p>CORWIN ENGINEERING, INC. 200 W. BELMONT, SUITE E ALLEN, TEXAS 75013 (972)396-1200 TBPE FIRM #5951</p>			
<p>DEVELOPMENT PLANS FOR STONE CREEK PHASE VI ROCKWALL, TEXAS</p>			
<p>GRADING PLAN</p>			
DRAWN BY	DESIGNED BY	CHECKED BY	SHEET NO.
JOB NUMBER	DATE	SCALE:	24 OF 26
13068	MAY 2014	1" = 50'	

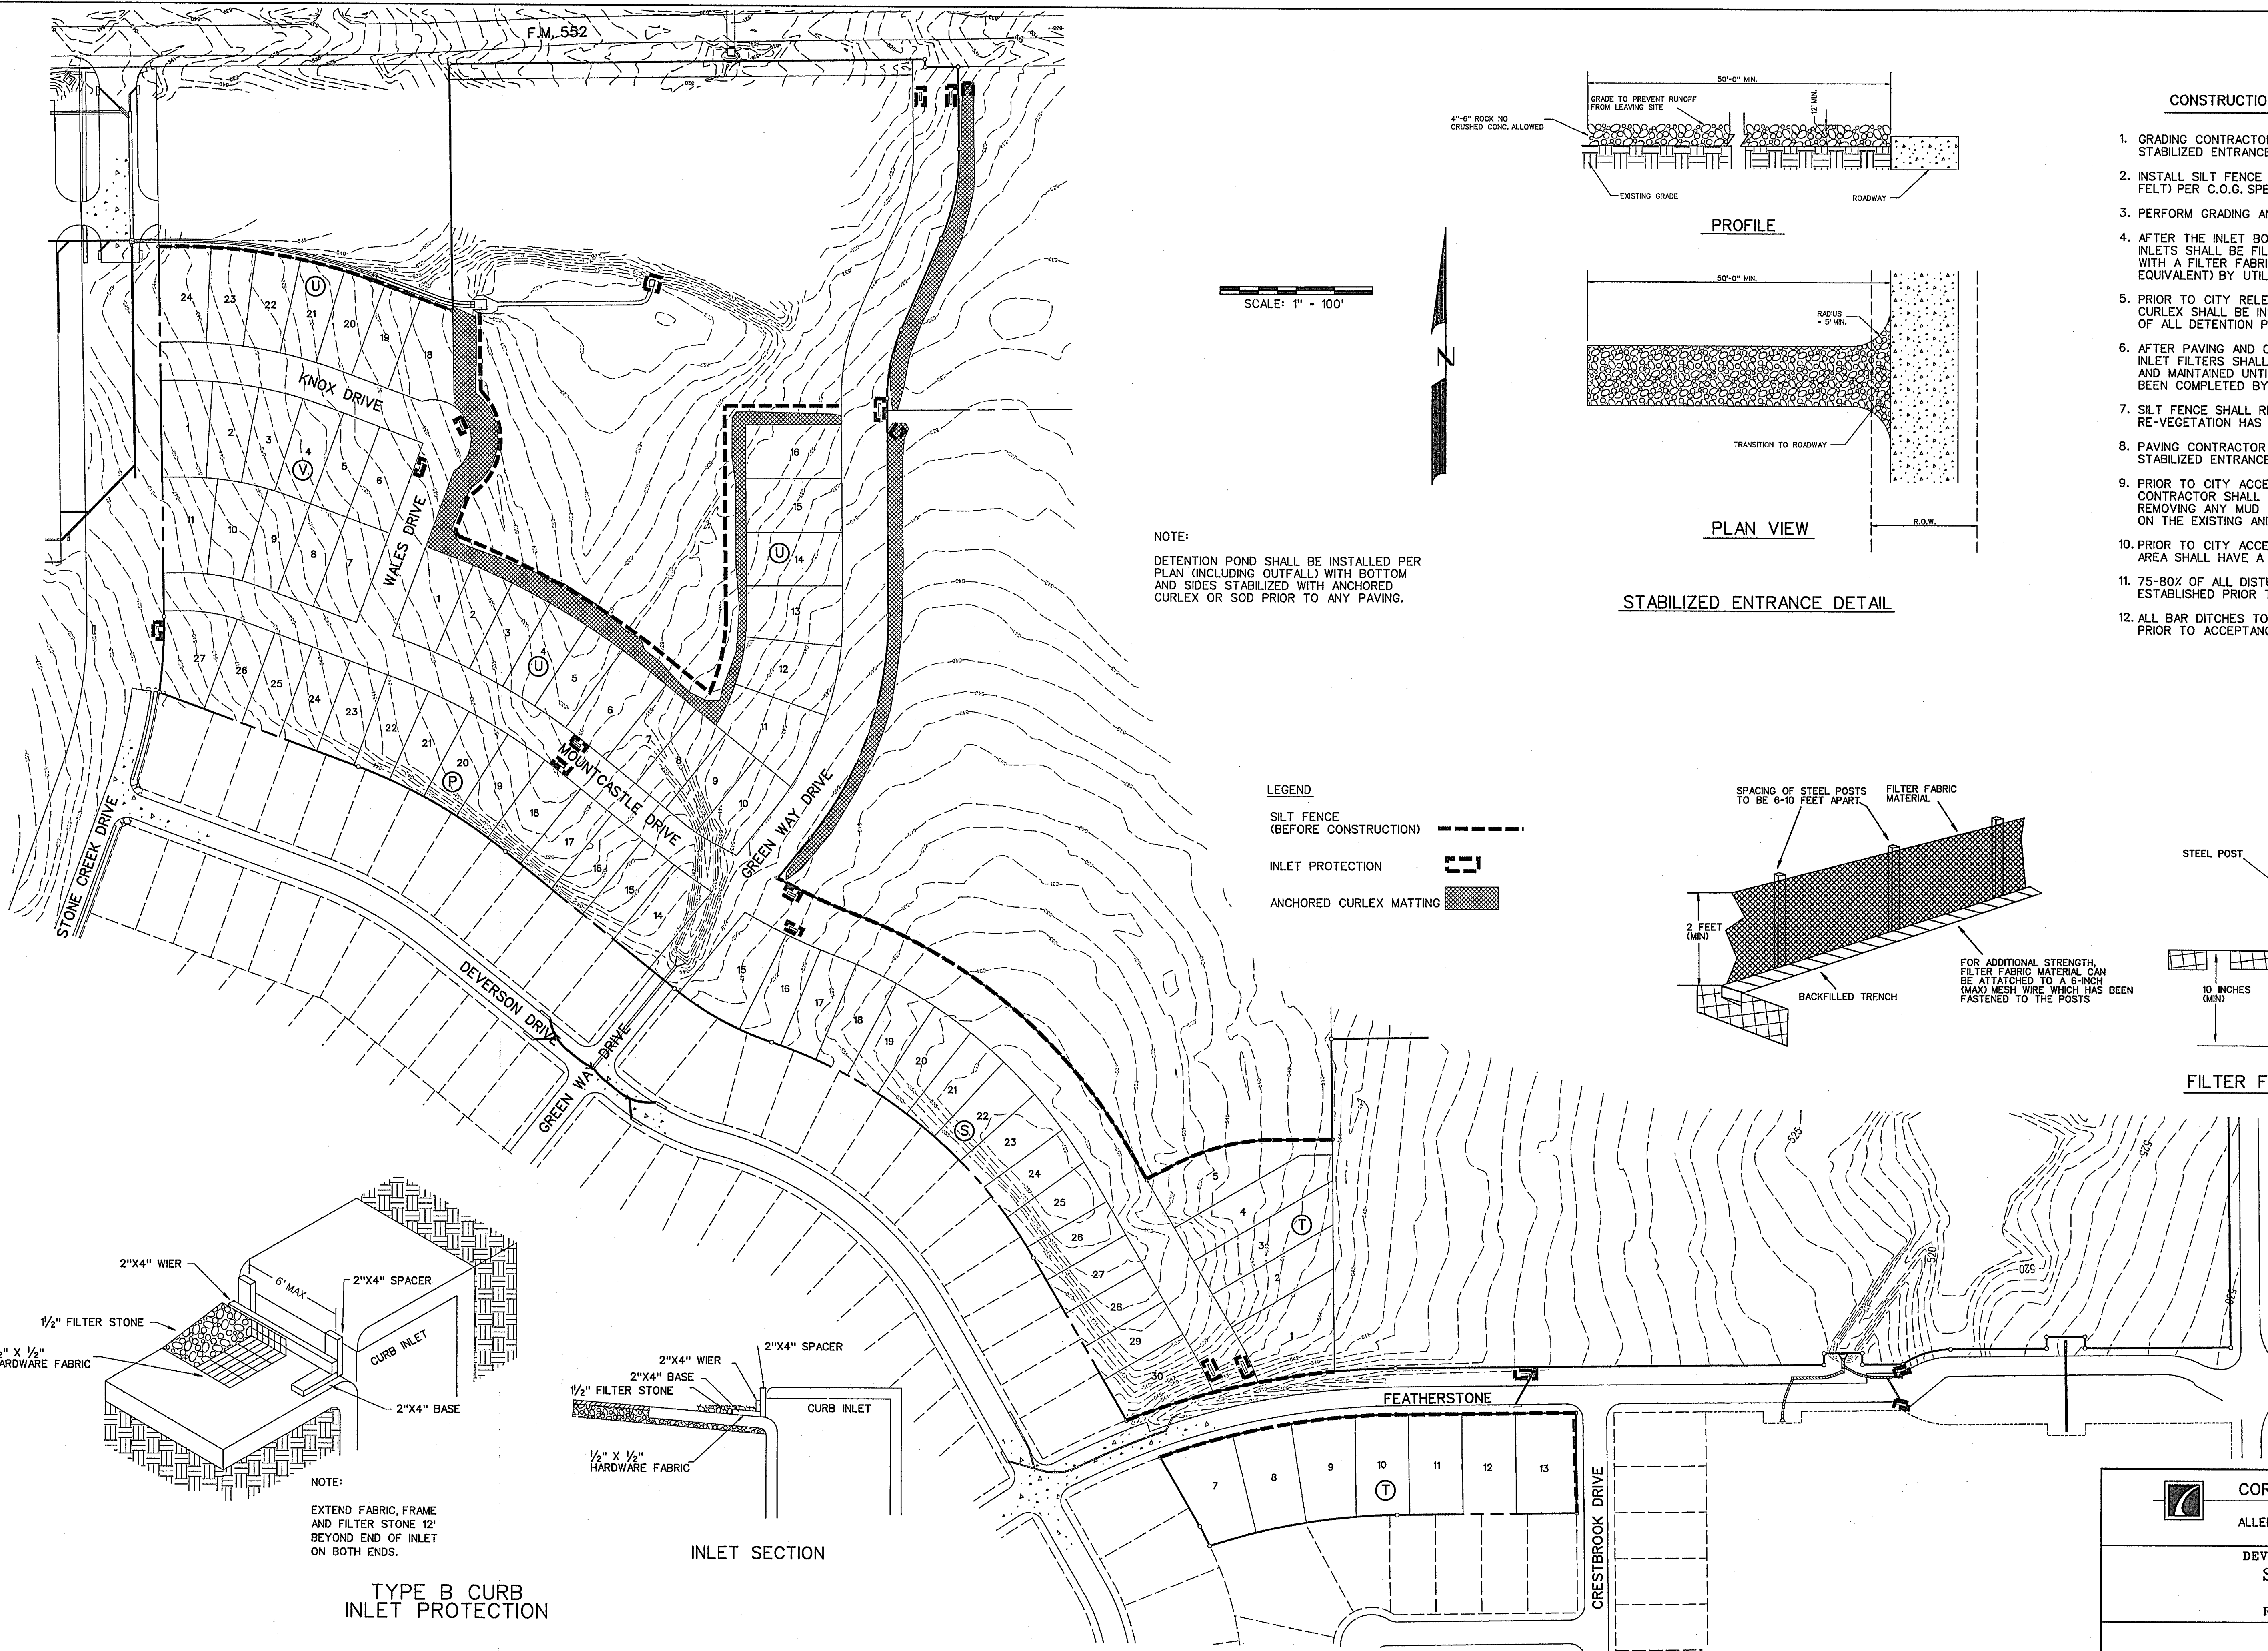

SCALE: 1" = 100'


NOTE:
 DETENTION POND SHALL BE INSTALLED PER PLAN (INCLUDING OUTFALL) WITH BOTTOM AND SIDES STABILIZED WITH ANCHORED CURLEX OR SOD PRIOR TO ANY PAVING.

LEGEND
 SILT FENCE (BEFORE CONSTRUCTION)
 INLET PROTECTION
 ANCHORED CURLEX MATTING

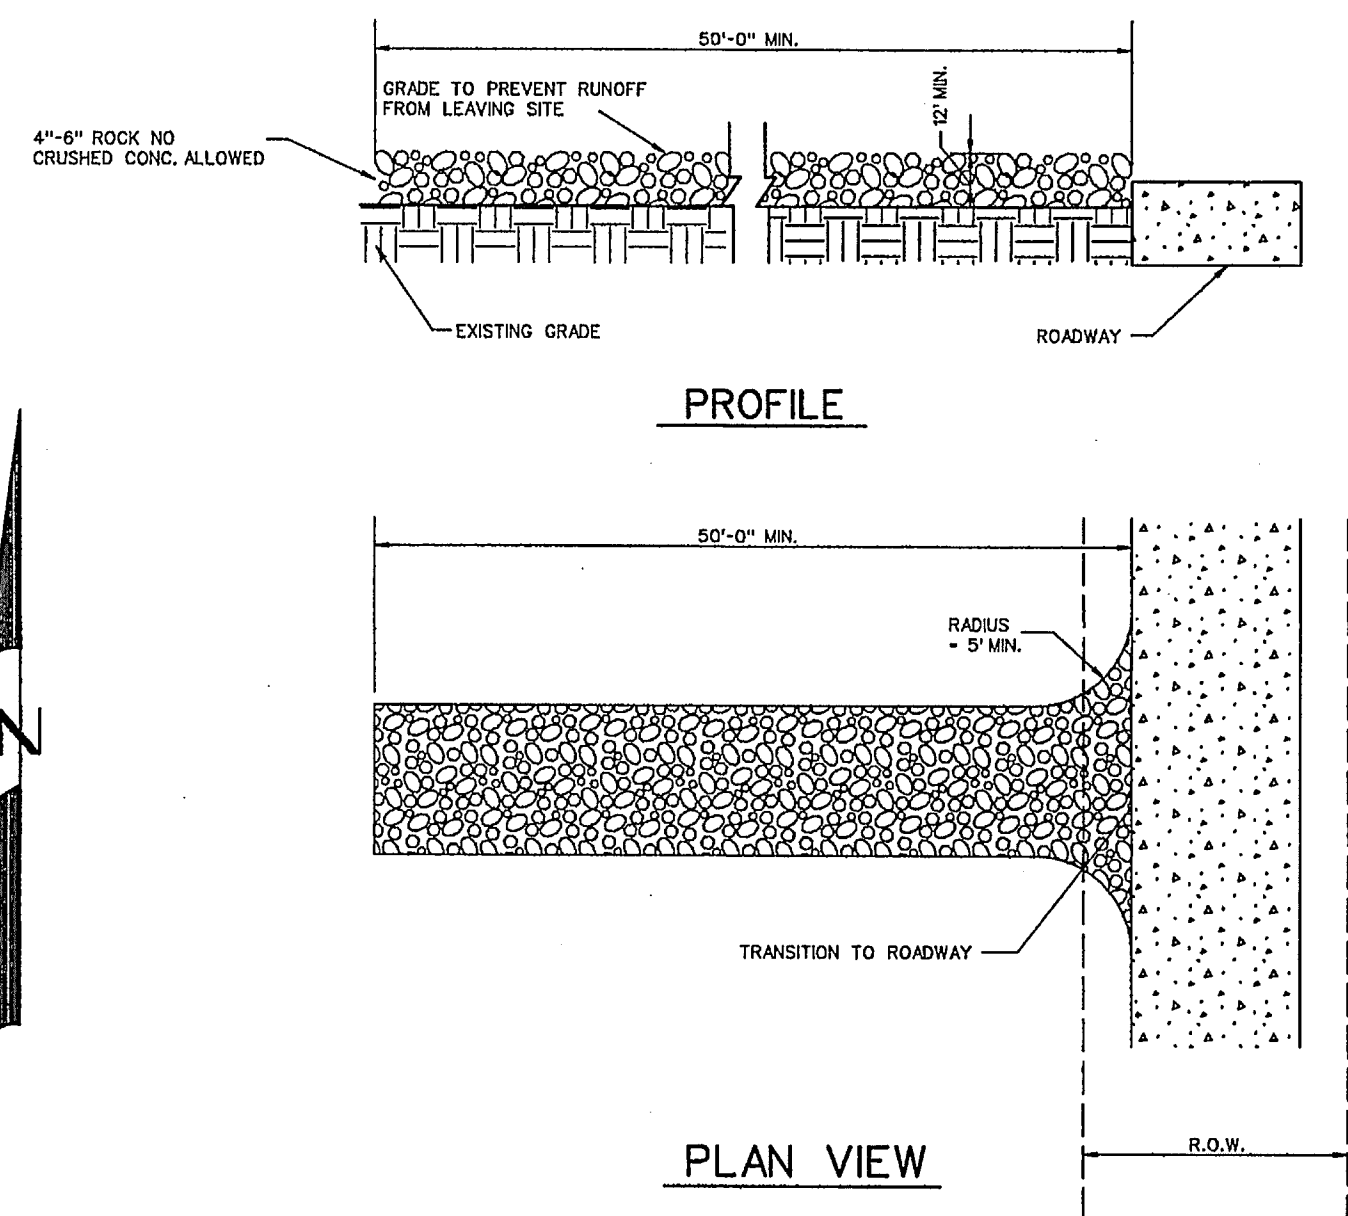


STABILIZED ENTRANCE DETAIL


- CONSTRUCTION SEQUENCE**
1. GRADING CONTRACTOR TO INSTALL TEMPORARY STABILIZED ENTRANCE.
 2. INSTALL SILT FENCE AS SHOWN, (TS-600 POLY FELT) PER C.O.G. SPECIFICATIONS.
 3. PERFORM GRADING AND UTILITY CONSTRUCTION.
 4. AFTER THE INLET BOTTOMS ARE CONSTRUCTED, THE INLETS SHALL BE FILLED WITH STONE AND COVERED WITH A FILTER FABRIC (TS-600 POLY FELT OR EQUIVALENT) BY UTILITY CONTRACTOR.
 5. PRIOR TO CITY RELEASING PAVING, SOD OR SEEDED CURLEX SHALL BE INSTALLED ON SIDES AND BOTTOM OF ALL DETENTION PONDS.
 6. AFTER PAVING AND COMPLETION OF INLETS, INLET FILTERS SHALL BE INSTALLED IN ALL INLETS AND MAINTAINED UNTIL RE-VEGETATION HAS BEEN COMPLETED BY PAVING CONTRACTOR.
 7. SILT FENCE SHALL REMAIN IN PLACE UNTIL RE-VEGETATION HAS BEEN COMPLETED.
 8. PAVING CONTRACTOR SHALL REMOVE TEMPORARY STABILIZED ENTRANCE.
 9. PRIOR TO CITY ACCEPTANCE THE PAVING CONTRACTOR SHALL BE RESPONSIBLE FOR REMOVING ANY MUD OR SILT WHICH COLLECTS ON THE EXISTING AND NEW PAVEMENT.
 10. PRIOR TO CITY ACCEPTANCE 75-80% OF ALL DISTURBED AREA SHALL HAVE A MIN. 1" TALL GRASS ESTABLISHED
 11. 75-80% OF ALL DISTURBED AREA TO HAVE 1" HIGH GRASS ESTABLISHED PRIOR TO ENGINEERING ACCEPTANCE.
 12. ALL BAR DITCHES TO BE ANCHORED, SEEDED & CURLEXED PRIOR TO ACCEPTANCE OF GRASS ISN'T ESTABLISHED.

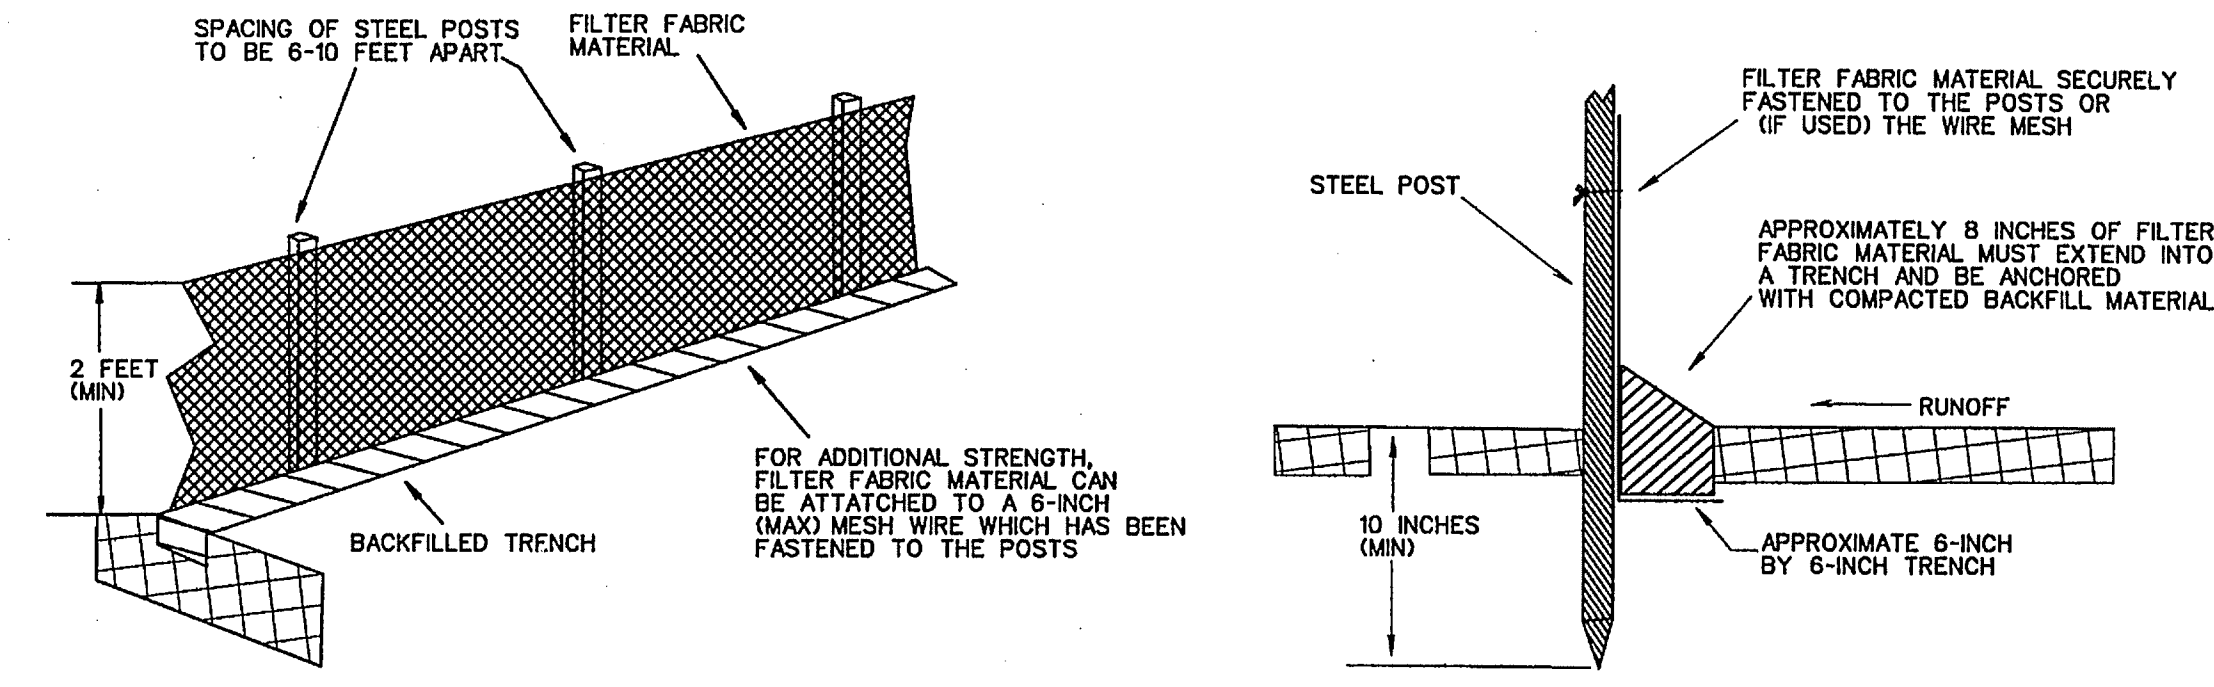

FILTER FABRIC FENCE DETAIL

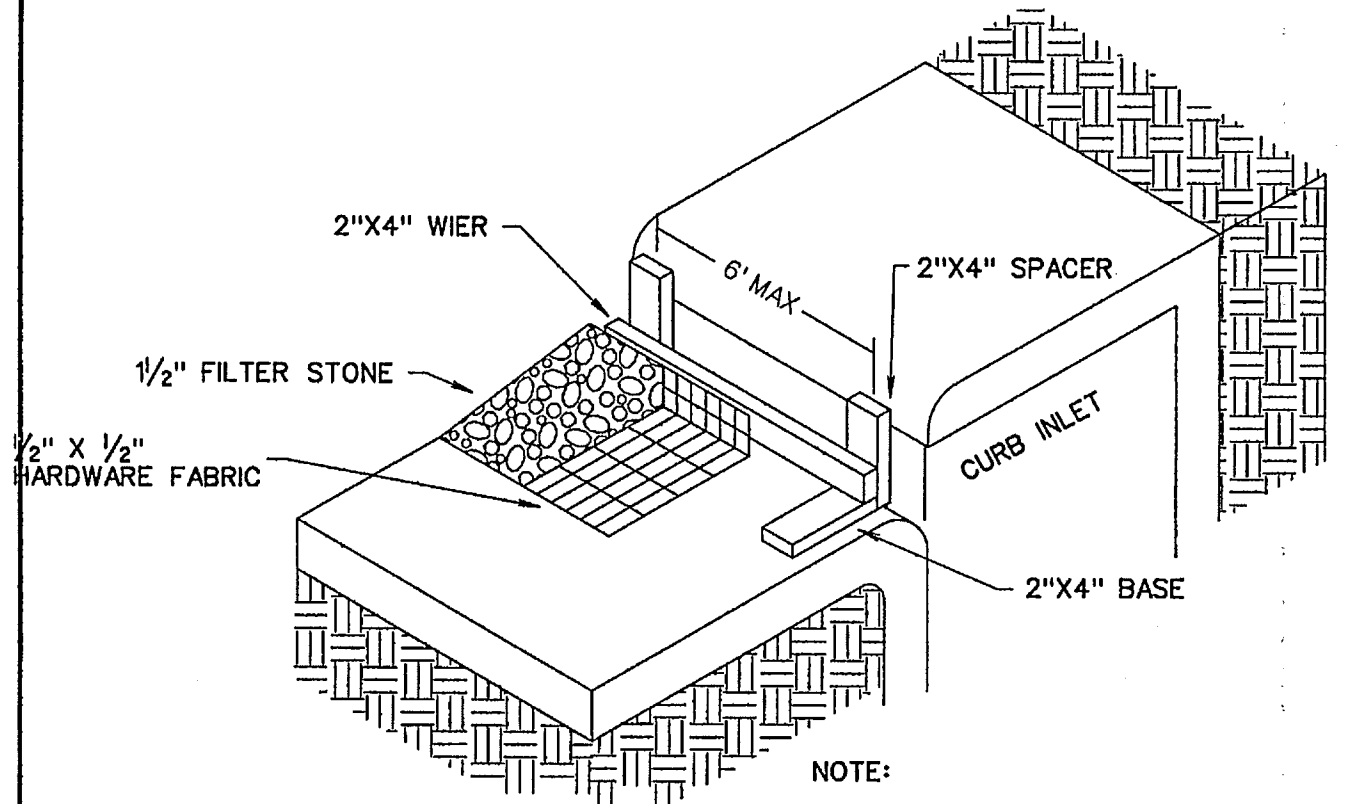


TYPE B CURB INLET PROTECTION

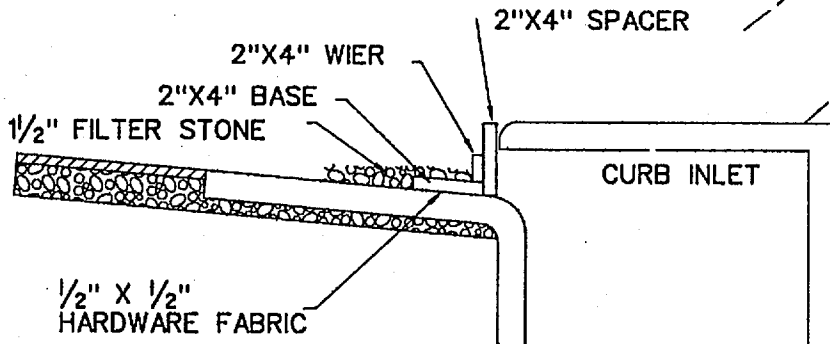

INLET SECTION

CORWIN ENGINEERING, INC. 200 W. BELMONT, SUITE E ALLEN, TEXAS 75013 (972)396-1200 TBPE FIRM #5951			
DEVELOPMENT PLANS FOR STONE CREEK PHASE VI ROCKWALL, TEXAS			
EROSION CONTROL PLAN			
DRAWN BY	DESIGNED BY	CHECKED BY	SHEET NO.
JOB NUMBER	DATE	SCALE:	25 OF 26
13088	MAY 2014	1"=100'	

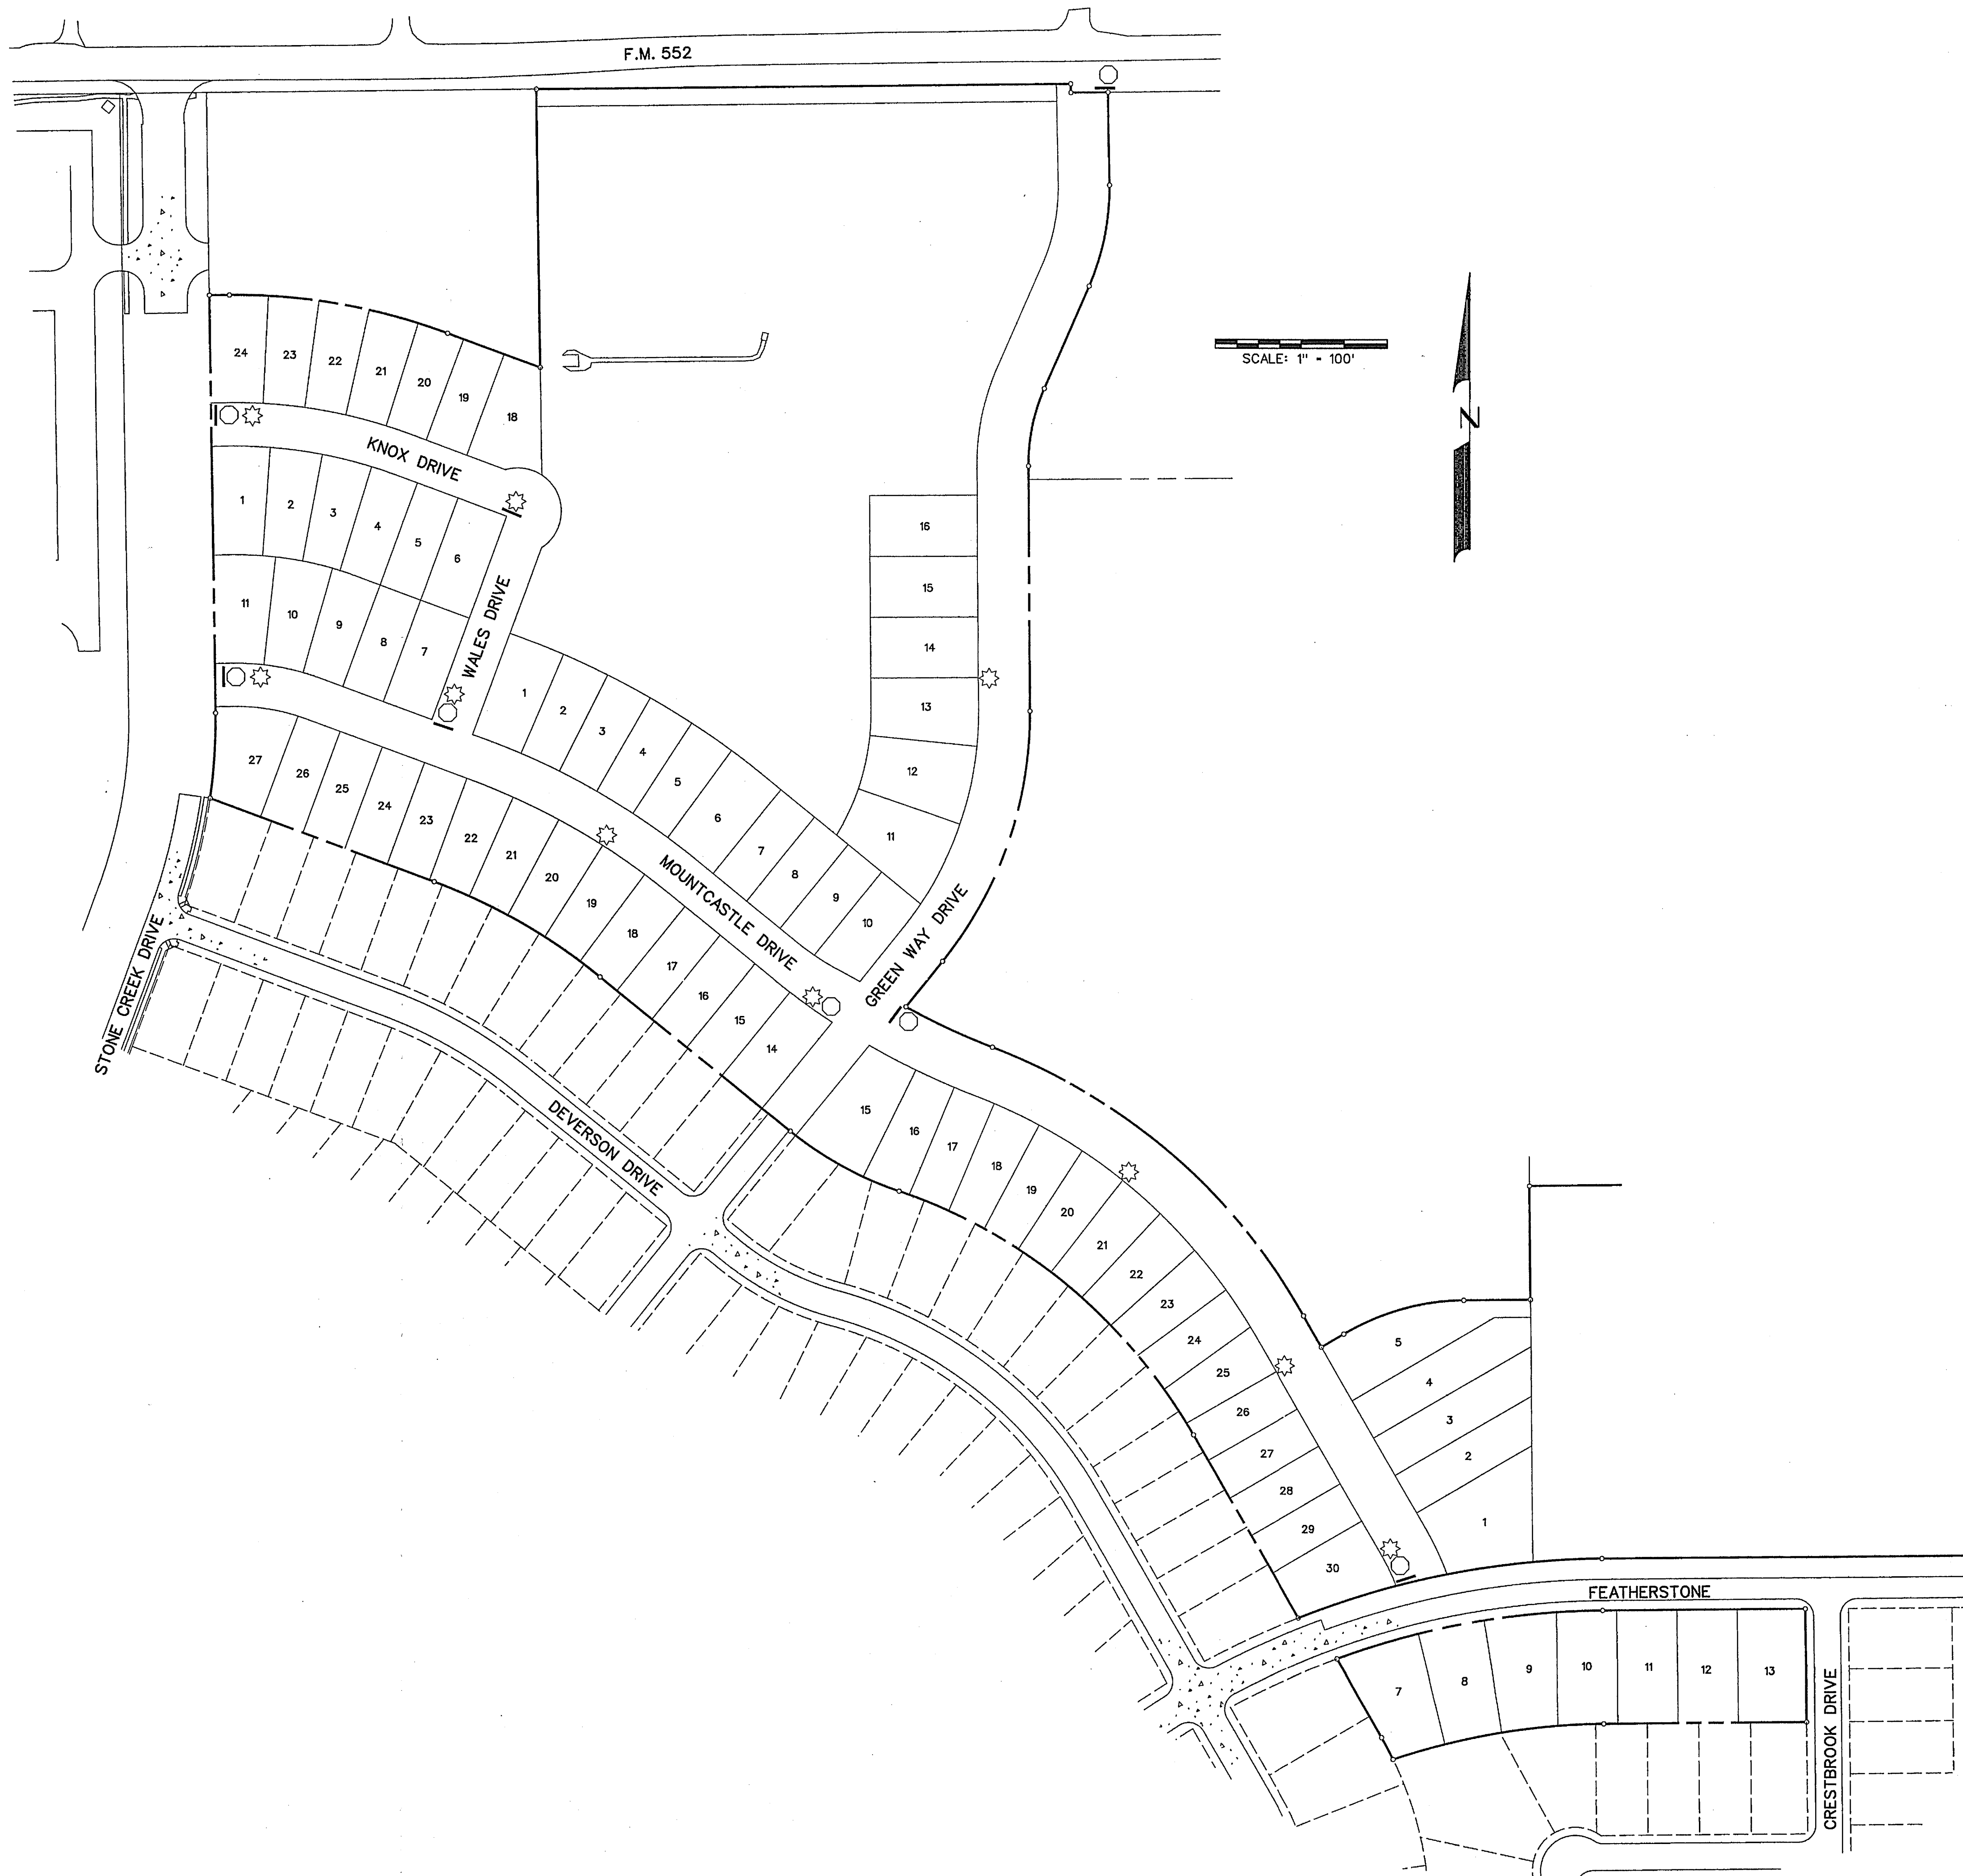

STREET SIGN NOTES

All signage installed shall comply with the current "Texas Manual on Uniform Traffic Control Devices" and the "Standard Highway Sign Designs for Texas".
 The developer shall be responsible for furnishing and installing all regulatory, warning and street name signs and sign mounts in accordance with the approved engineering plans.

Block Numbers are required on all street name blades.

Street Name Blades shall be nine inch (9") tall extruded aluminum. The blades shall be 0.080 inches thick.

High Intensity Retro reflective Sheeting for Street, Regulatory, and Warning Signs - shall be high intensity diamond grade type III prismatic.

The Lettering for the street blades shall be HIROAD B with all uppercase fonts. "Highway Gothic B" with six-inch letters. Letters for abbreviated street designations shall be three inches (3") tall with all uppercase fonts (i.e., LN, PKWY, CT, etc.). Block numbers shall be three-inch (3") tall.

The street sign background shall be green and the legend shall be white.

The street sign blade must incorporate the current City of Rockwall logo.

For a street with a cul-de-sac end, a standard W 14-2a shall be mounted over the street name blade.

Sign posts shall be 2 3/8" O.D. galvanized steel tube sign post with a galvanized finish.


Sign clamps and brackets shall be high strength aluminum.

LEGEND

☼ - STREET LIGHT

○ - STOP SIGN

— - STREET NAME BLADE

 CORWIN ENGINEERING, INC. 200 W. BELMONT, SUITE E ALLEN, TEXAS 75013 (972)396-1200 TBPE FIRM #5951			
DEVELOPMENT PLANS FOR STONE CREEK PHASE VI ROCKWALL, TEXAS			
SIGN AND LIGHT PLAN			
DRAWN BY 13068	DESIGNED BY MAY 2014	CHECKED BY SCALE: 1"=100'	SHEET NO. 26 OF 26