


DEVELOPMENT PLANS FOR STONE CREEK PHASE VII CITY OF ROCKWALL, TEXAS

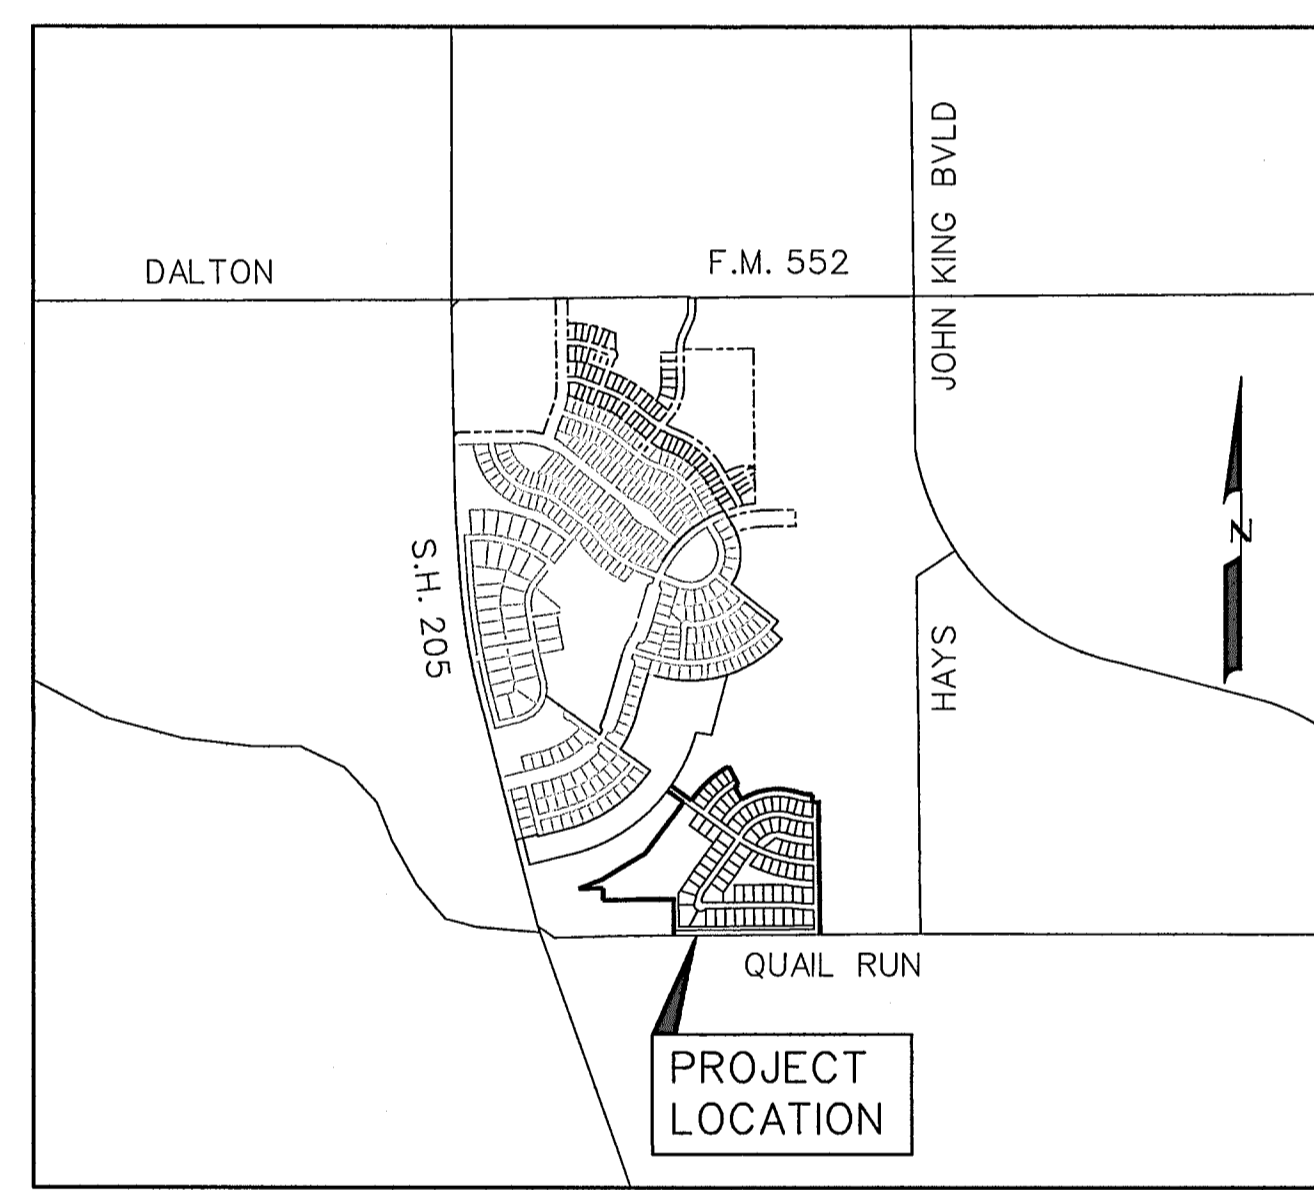


PREPARED FOR
MERITAGE HOMES OF TEXAS, LLC.
909 HIDDEN RIDGE, SUITE 190, IRVING, TEXAS 75038

CORWIN ENGINEERING, INC. — CONSULTING ENGINEERS
200 W. BELMONT, SUITE E TBPE FIRM #5951 ALLEN, TEXAS 75013

INDEX

1	TITLE
2	PLAT
3	PROPOSED ULTIMATE CONDITIONS DRAINAGE AREA MAP
3A	DRAINAGE CALCULATIONS
3B	INTERIM CONDITIONS DRAINAGE AREA MAP
4	EXISTING CONDITIONS DRAINAGE AREA MAP
5	PROPOSED CONDITIONS OVERALL DRAINAGE AREA MAP
6	HARVARD DRIVE
7	MEMORIAL DRIVE
8	EMERSON DRIVE
9	NAKOMA DRIVE
10	MONTROSE DRIVE, NAKOMA DRIVE
11	QUAIL RUN ROAD
12	QUAIL RUN ROAD, HARVARD DRIVE
12B	QUAIL RUN ROAD CROSS SECTIONS
13	WATER AND SANITARY SEWER PLAN
14	SANITARY SEWER PROFILES
15	SANITARY SEWER PROFILES
16	STORM SEWER PLAN AND PROFILE LINE 'D-1' & 'D-2'
17	STORM SEWER PLAN AND PROFILE LINE 'D-3'
18	STORM SEWER PLAN AND PROFILE LINE 'D-4' & 'D-11'
19	STORM SEWER PLAN AND PROFILE LINE 'D-5' & 'D-8'
20	STORM SEWER PLAN AND PROFILE LINE 'D-6' & 'D-9'
21	STORM SEWER PLAN AND PROFILE LINE 'D-7'
22	STORM SEWER PLAN AND PROFILE LINE 'D-7', 'D-10', 'D-12', 'D-13'
23	STORM SEWER LATERAL PROFILES
24	STORM SEWER LATERAL PROFILES
25	DETENTION POND
26	FLOODPLAIN WORKMAP
27	GRADING PLAN
28	GRADING PLAN
28B	GRADING PLAN
29	EROSION CONTROL PLAN
30	SIGN AND LIGHT PLAN
31	QUAIL RUN TRAFFIC SIGNAGE PLAN

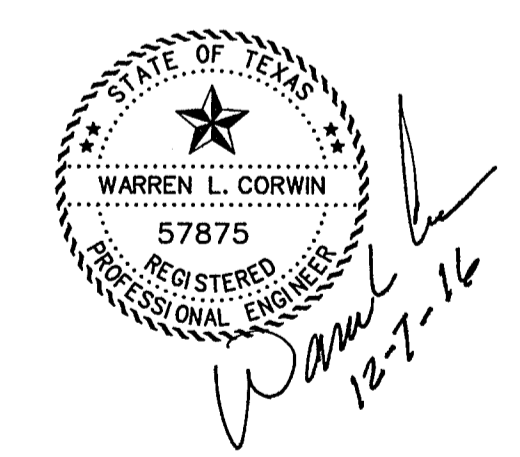

AS-BUILT DECEMBER 2016
INFORMATION PROVIDED
BY CONTRACTORS
(NOT FIELD VERIFIED)

BENCHMARK:
CITY OF ROCKWALL SURVEY MONUMENT ON AN INLET
AT THE NORTHWEST CORNER OF FEATHERSTONE DR. AND
HARVARD DR.
ELEV. - 525.31

NOTE:
CITY OF ROCKWALL STANDARDS
AND NCTCOG 3rd ADDITION STANDARDS
SHALL BE USED FOR REFERENCE.

3	CONSTRUCTION SET	4-4-16
2	CITY COMMENTS	3-30-16
1	CITY COMMENTS	1-11-16
NO.	REVISIONS	DATE

NOTE:
THE PURPOSE OF THIS AMENDING PLAT IS
TO REVISE LOT 6 BLOCK C TO LOT 12 BLOCK D.

AMENDED PLAT
OF
**STONE CREEK
PHASE VII**

TOTAL LOTS 80 TOTAL ACRES 37.827
OUT OF THE
S. KING SURVEY, ABSTRACT NO. 131


IN THE
CITY OF ROCKWALL
ROCKWALL COUNTY, TEXAS

OWNER
MERITAGE HOMES OF TEXAS, L.L.C.
8840 CYPRESS WATERS BLVD., SUITE 100
DALLAS, TEXAS 75019

PREPARED BY
CORWIN ENGINEERING, INC.
200 W. BELMONT, SUITE E
ALLEN, TEXAS 75015
972-396-1200

NOVEMBER 2016 SCALE 1" = 100'
CASE NO. P2016-003
SHEET 1 OF 3

0 50 100
SCALE 1" = 100'

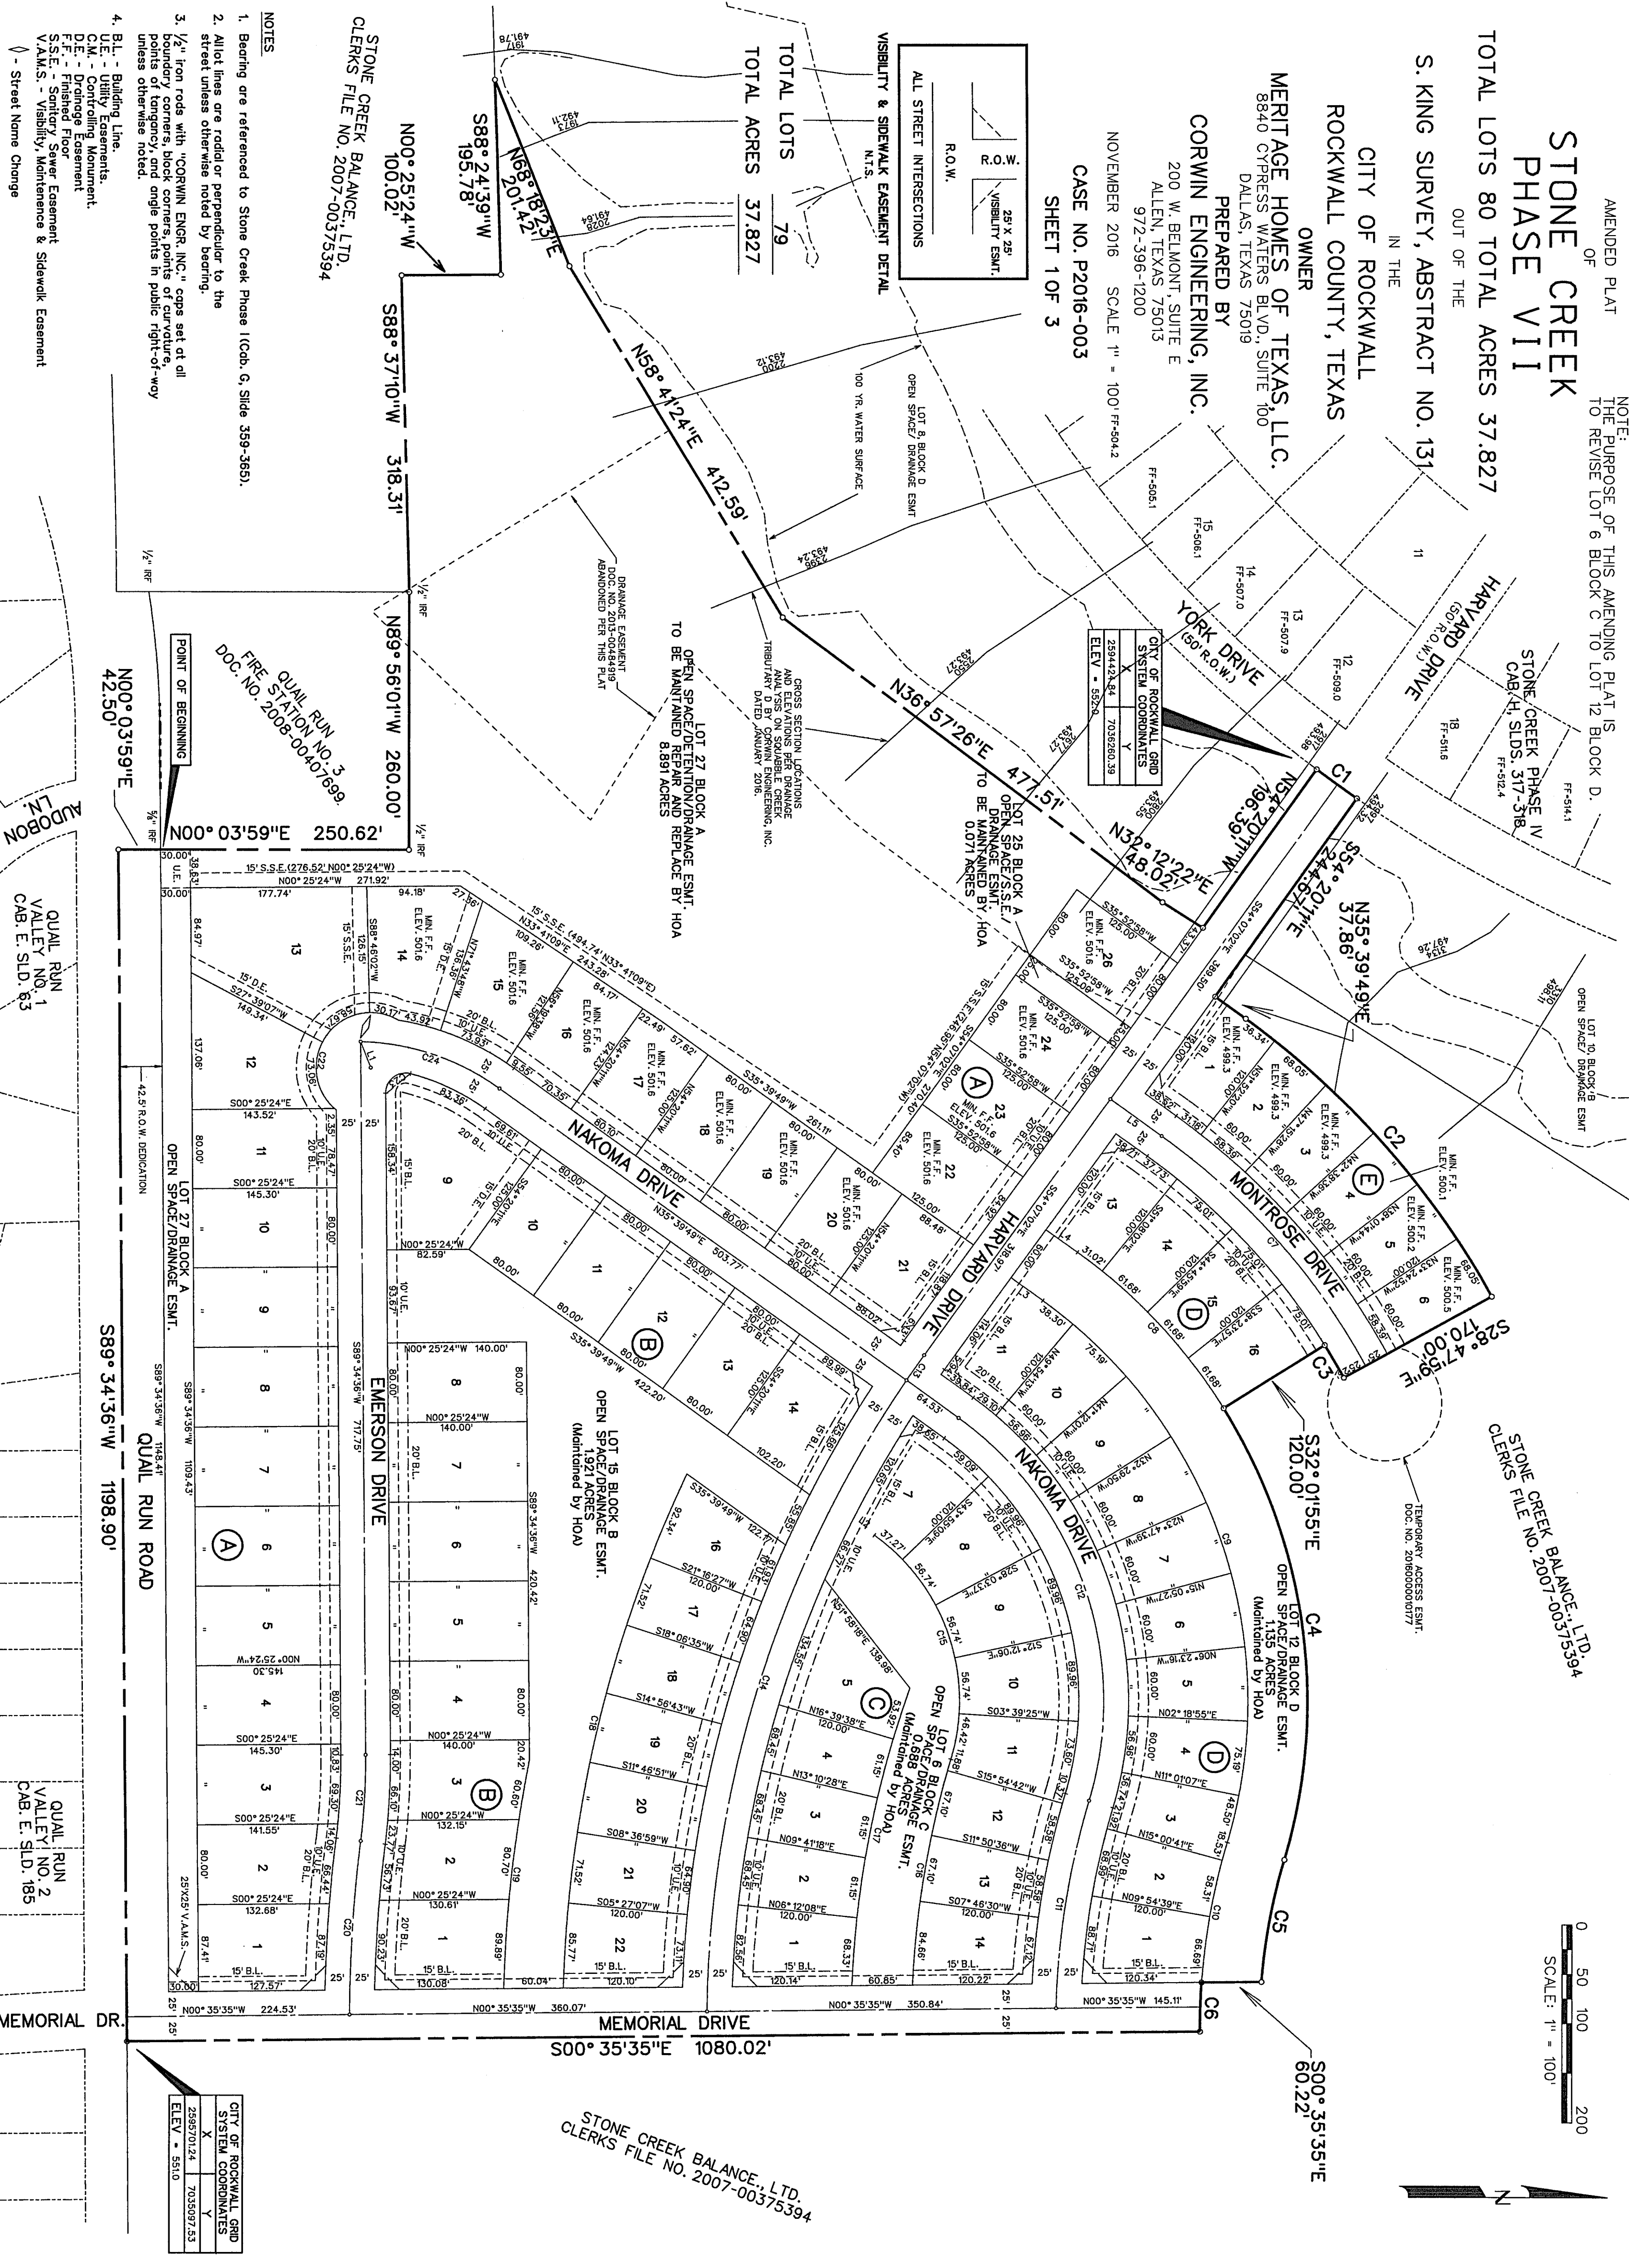

NOTES:
1. Bearing one referenced to Stone Creek Phase I (Case G, Slide 359-363).
2. All lot lines are rounded perpendicular to the street unless otherwise noted by survey.
3. 1/2" from roads with CORWIN ENGR., INC. caps set at all points of tangency, and angle points in public right-of-way unless otherwise noted.
4. B.L. - Building Line.
U.E. - Utility Easement.
D.E. - Driveway Easement.
F.E. - Finished Floor.
V.S.E. - Stormwater Easement.
V.S.W.E. - Stormwater Easement & Sidewalk Easement.
- Street Name Change

OWNERS CERTIFICATE

NOW, THEREFORE, KNOW ALL MEN BY THESE PRESENTS:

STATE OF TEXAS

COUNTY OF ROCKWALL

DO hereby certify that the above and foregoing plat of an addition to the City of Rockwall, Texas, was approved by the City Council of the City of Rockwall on the _____ day of _____, 2016.

This approved shall be invalid unless the approved plat for such addition is recorded in the office of the County Clerk of Rockwall, County, Texas, within one hundred eighty (180) days from said date of final approval.

WITNESS OUR HANDS, this _____ day of _____, 2016.

Mayor, City of Rockwall _____ City Secretary _____ City Engineer _____

1. No buildings shall be constructed or placed upon, over, or across the utility easements as described herein.
2. Any public utility shall have the right to remove and keep removed all or part of any buildings, fences, trees, shrubs or other growths or improvements which in any way endanger or interfere with the safe and proper operation of any public utility.
3. The City of Rockwall will not be responsible for any claims of any nature resulting from or occasioned by the establishment of grade or streets in the subdivision.
4. The developer and subdivision engineer shall bear total responsibility for storm drain improvements.
5. The developer shall be responsible for the necessary facilities to provide drainage patterns and drainage controls such that properties within the drainage area are not adversely affected by storm drainage from the development.
6. The detention drainage system is to be maintained, repaired and owned by the subdivision.
7. No home dwelling unit, or other structure shall be constructed on any lot in this addition by the owner of the subdivision, or any other person, which is in violation of the subdivision regulations of the City of Rockwall regarding improvements with respect to the entire block on the street or streets on which property abuts, including the actual installation of streets, sidewalks, curbs, gutters, and other improvements, or the actual installation of stormwater storage structures, storm sewers, and drywells, or access to the specifications of the City of Rockwall or

Union sewer deposit sufficient to pay for the cost of such improvements as determined by the city's engineer and/or city administrator, computed on a private commercial rate basis has been made with the city secretary, accompanied by an agreement signed by the owner, authorizing the city to make such improvements of prevailing private commercial rates, or have the owner, authorizing the city to make such improvements of prevailing private commercial rates, or have the owner, author, or owner's agent or representative, in writing, agree to pay for the cost of such improvements within the time stated in such written agreement, but in no case shall the City be obligated to make such improvements itself. Such deposit may be used by the owner and/or developer as progress payments on the work progress evidence of work done or

Liability of developer and/or owner files a corporate surety bond with the city secretary in a sum equal to the amount of the deposit. The surety bond shall be in full force and effect from the date the time stated in the bond, which time shall be fixed by the city council of the City of Rockwall. No further acknowledgment that the dedications and/or easements made herein are irrevocable to the City of Rockwall upon the public services rendered in order that the development will comply with the present and future growth needs of the City, or our successors and assigns, hereto, hereby waives any claim, damage, or cause of action that we may have as a result of the dedication of easements made herein.

MERITAGE HOMES OF TEXAS, L.L.C.
an Arizona limited liability company

Bobby Samuel
Vice President of Land Development
STATE OF TEXAS
COUNTY OF ROCKWALL
Before me, the undersigned authority, on this day personally appeared BOBBY SAMUEL, and acknowledged to me that he executed the same for the purposes and consideration therein stated. Given upon my hand and seal of office this _____ day of _____, 2016.


Notary Public in and for the State of Texas My Commission Expires: _____

LINE TABLE

LINE NO.	BEARING	DISTANCE
1.	N 68° 33' 15" E	27.88'
2.	N 35° 39' 49" E	26.67'
3.	N 35° 39' 49" E	39.40'
4.	N 35° 39' 49" E	39.17'
5.	N 35° 39' 49" E	63.61'

CURVE TABLE

CURVE NO.	DELTA	RADIUS	LENGTH	TANGENT	CHORD	BEARING
1.	02°04'34"	1380.00'	50.00'	25.00'	50.00'	N35°47'17" E
2.	25°32'42"	845.00'	376.62'	193.49'	373.51'	N48°25'55" E
3.	03°13'45"	675.00'	38.08'	19.40'	38.07'	S89°35'03" W
4.	48°03'40"	853.00'	471.39'	230.97'	457.35'	N82°18'08" E
5.	02°04'41"	653.00'	123.47'	62.97'	123.44'	S78°24'33" E
6.	25°42'12"	653.00'	330.98'	153.04'	300.44'	N88°09'52" E
7.	70°48'07"	550.00'	216.06'	109.47'	212.69'	S46°48'57" W
8.	22°18'15"	655.00'	613.12'	352.88'	574.67'	N71°08'52" E
9.	15°11'44"	800.00'	143.52'	72.05'	143.24'	S87°58'43" W
10.	12°33'17"	350.00'	433.52'	106.71'	406.34'	N60°57'56" W
11.	15°11'44"	800.00'	143.52'	72.05'	143.24'	S87°58'43" W
12.	01°32'47"	1150.00'	31.04'	15.52'	31.04'	S54°53'25" E
13.	01°32'47"	1150.00'	31.04'	15.52'	31.04'	S72°29'04" E
14.	33°38'31"	1150.00'	675.23'	347.66'	655.58'	N71°08'52" E
15.	70°48'07"	205.00'	253.92'	146.14'	238.00'	S80°21'46" W
16.	13°59'23"	945.00'	230.74'	115.95'	230.17'	N78°58'45" W
17.	17°29'40"	1005.00'	305.70'	154.04'	304.52'	N78°58'45" W
18.	23°42'10"	1295.00'	535.72'	271.75'	531.92'	N83°33'11" W
19.	09°34'32"	1355.00'	231.18'	115.87'	230.90'	N83°33'11" W
20.	06°39'07"	1510.00'	175.31'	87.75'	175.21'	N86°41'31" W
21.	07°21'46"	665.00'	164.24'	86.56'	164.24'	N86°41'31" W
22.	17°10'51"33"	55.00'	26.00'	109.67'	31.70'	S37°59'36" E
23.	104°51'33"	20.00'	26.00'	31.70'	26.00'	S37°59'36" E
24.	34°21'05"	250.00'	149.89'	77.27'	147.65'	S18°29'16" W

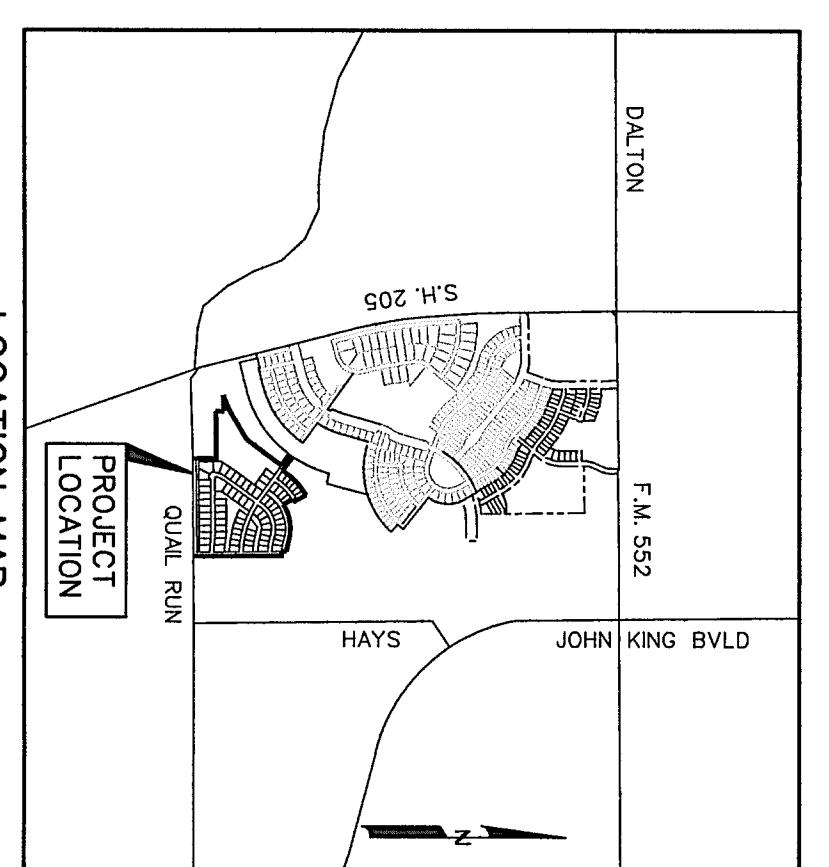

AMENDED PLAT
OF
**STONE CREEK
PHASE VII**
TOTAL LOTS 80 TOTAL ACRES 37.827
OUT OF THE
S. KING SURVEY, ABSTRACT NO. 131
IN THE
CITY OF ROCKWALL
ROCKWALL COUNTY, TEXAS

OWNER
MERITAGE HOMES OF TEXAS, L.L.C.
8840 CYPRESS WATERS BLVD., SUITE 100
DALLAS, TEXAS 75019

PREPARED BY
CORWIN ENGINEERING, INC.
200 W. BELMONT, SUITE E
ALLEN, TEXAS 75015
972-396-1200
NOVEMBER 2016

CASE NO. P2016-003 SHEET 2 OF 3

LEGAL DESCRIPTION

WHEREAS, MERITAGE HOMES OF TEXAS, LLC, is the owner of a tract of land situated in the S. King Survey, Abstract No. 131, in the City of Rockwall, Rockwall County, Texas, being all of a 37.782 acre tract, Clerks File No. 20150000013037 in the Deed Records of Rockwall County, Texas, and being more particularly described as follows:

BEGINNING, at a 3/4 inch iron rod found at the southeast corner of the QuailRun Fire Station No. 3, as described in Doc. No. 2005-00407689 in said Deed Records;

THENCE, North 00°03'59" East, along the east line of said QuailRun Fire Station No. 3, for a distance of 250.62 feet, to a 1/2 inch iron rod found with a yellow cap stamped with Corwin Eng. Inc., being at the northeast corner of said QuailRun Fire Station No. 3;

THENCE, North 89°56'01" West, along the north line of said QuailRun Fire Station No. 3, for a distance of 260.00 feet, to a 1/2 inch iron rod found with a yellow cap stamped with Corwin Eng. Inc., being at the northwest corner of said Quail Run Fire Station No. 3 Tract;

THENCE, South 88°37'10" West, for a distance of 318.31 feet to a 1/2 inch iron rod set with a yellow cap stamped with Corwin Eng. Inc.;

THENCE, North 00°25'24" West, for a distance of 100.02 feet to a 1/2 inch iron rod set with a yellow cap stamped with Corwin Eng. Inc.;

THENCE, South 88°24'39" West, for a distance of 195.78 feet to a 1/2 inch iron rod set with a yellow cap stamped with Corwin Eng. Inc., being at the northeast corner of said Quail Run Fire Station No. 3 Tract, in the Plat Records of Rockwall County, Texas;

THENCE, North 68°19'23" East, with the south line of said Stone Creek Phase IV, for a distance of 201.42 feet to a 1/2 inch iron rod set with a yellow cap stamped with Corwin Eng. Inc.;

THENCE, North 58°41'24" East, continuing with said south line for a distance of 412.59 feet to a 1/2 inch iron rod set with a yellow cap stamped with Corwin Eng. Inc.;

THENCE, North 36°57'28" East, continuing with said south line for a distance of 477.51 feet to a 1/2 inch iron rod set with a yellow cap stamped with Corwin Eng. Inc.;

THENCE, North 32°12'22" East, continuing with said south line for a distance of 48.02 feet to a 1/2 inch iron rod set with a yellow cap stamped with Corwin Eng. Inc.;

THENCE, North 54°20'11" West, continuing with said south line for a distance of 196.39 feet to a 1/2 inch iron rod set with a yellow cap stamped with Corwin Eng. Inc., being in the southeast right-of-way line of York Drive, and being a point on a curve to the left having a radius of 1360.00 feet, a tangent of 25.00 feet and a central angle of 02°04'34";

THENCE, with said curve to the left and said York Drive right-of-way, for an arc distance of 50.00 feet, (Chord Bearing N 35°47'17" E = 50.00 feet) to a 1/2 inch iron rod set with a yellow cap stamped with Corwin Eng. Inc.;

THENCE, South 54°20'11" East, departing said York Drive right-of-way and along the south line of said Stone Creek Phase IV, at 193.26 feet passing a point in the south line of said Stone Creek Phase IV, and continuing for a total distance of 244.67 feet, to a 1/2 inch iron rod set with a yellow cap stamped with Corwin Eng. Inc.;

THENCE, North 35°39'49" East, for a distance of 37.86 feet to a 1/2 inch iron rod set with a yellow cap stamped with Corwin Eng. Inc., at the point of curvature of a curve to the right having a radius of 845.00 feet, a tangent of 191.49 feet and a central angle of 23°32'12";

THENCE, with said curve to the right for an arc distance of 376.62 feet, (Chord Bearing N 48°25'55" E = 373.51 feet), to a 1/2 inch iron rod set with a yellow cap stamped with Corwin Eng. Inc.;

THENCE, South 28°47'59" East, for a distance of 170.00 feet to a 1/2 inch iron rod set with a yellow cap stamped with Corwin Eng. Inc., being a point on a curve to the left having a radius of 675.00 feet, a tangent of 19.40 feet and a central angle of 03°13'55";

THENCE, with said curve to the left for an arc distance of 38.08 feet, (Chord Bearing S 59°35'03" W = 38.07 feet), to a 1/2 inch iron rod set with a yellow cap stamped with Corwin Eng. Inc.;

THENCE, South 32°01'55" East, for a distance of 120.00 feet, to a 1/2 inch iron rod set with a yellow cap stamped with Corwin Eng. Inc., being on a curve to the right having a radius of 555.00 feet, a tangent of 250.97 feet and a central angle of 48°39'50";

THENCE, with said curve to the right for an arc distance of 471.39 feet, (Chord Bearing N 82°18'00" E = 457.35 feet), to a 1/2 inch iron rod set with a yellow cap stamped with Corwin Eng. Inc., being at the point of reverse curvature of a curve to the left having a radius of 595.00 feet, a tangent of 82.87 feet and a central angle of 12°04'57";

THENCE, with said curve to the left for an arc distance of 125.47 feet, (Chord Bearing S 79°24'33" E = 125.24 feet), to a 1/2 inch iron rod set with a yellow cap stamped with Corwin Eng. Inc.;

THENCE, South 00°35'35" East, for a distance of 60.22 feet, to a 1/2 inch iron rod set with a yellow cap stamped with Corwin Eng. Inc., being on a curve to the left having a radius of 655.00 feet, a tangent of 23.04 feet and a central angle of 04°22'44";

THENCE, with said curve to the left for an arc distance of 50.06 feet, (Chord Bearing S 88°06'43" East = 50.05 feet), to a 1/2 inch iron rod set with a yellow cap stamped with Corwin Eng. Inc.;

THENCE, South 00°35'35" East, for a distance of 1080.02 feet, to a 1/2 inch iron rod set with a yellow cap stamped with Corwin Eng. Inc., being in the south line of said Stone Creek Balance Tract and being in the north line QuailRun Valley No. 2, on addition to the City of Rockwall, as described in Cab. E, Pg. 185, in said Plat Records;

THENCE, South 89°34'36" West, continuing along said north and south lines of 826.67 feet, passing the northwest corner of said Quail Valley No. 2, and being the northeast corner of QuailRun Valley No. 1, on addition to the City of Rockwall, Texas, as recorded in Cab. E, Side 63 in said Plat Records and continuing for a total distance of 1195.90 feet, to a 1/2 inch iron rod set with a yellow cap stamped Corwin Eng. Inc.;

THENCE, North 00°03'59" East, departing the north line of said QuailRun Valley No. 1, for a distance of 42.50 feet to the POINT OF BEGINNING and containing 37.827 acres of land.

SURVEYOR CERTIFICATE

I, WARREN L. CORWIN, do hereby certify that the plat shown hereon accurately represents the results of an on-the-ground survey made under my direction and supervision and all corners are as shown thereon and there are no encroachments, conflicts, protrusions or visible utilities on the ground except as shown and said plat has been prepared in accordance with the platting rules and regulations of the City Plan Commission of the City of Rockwall, Texas.

DATED the this _____ day of _____, 2016.

WARREN L. CORWIN
R.P.L.S. No. 4821

THE STATE OF TEXAS
COUNTY OF COLLIN

BEFORE ME, the undersigned, a Notary Public in and for the State of Texas, on this day, personally appeared _____, known to me to be the person whose name is subscribed to the foregoing instrument and acknowledged to me that he executed the same in the capacity therein stated and for the purposes and considerations therein expressed.

WITNESS MY HAND AND SEAL OF OFFICE, this the _____ day of _____, 2016.

Notary Public in and for the State of Texas

AMENDED PLAT

**STONE CREEK
PHASE VII**

TOTAL LOTS 80 TOTAL ACRES 37.827

OUT OF THE

S. KING SURVEY, ABSTRACT NO. 131

IN THE

CITY OF ROCKWALL

ROCKWALL COUNTY, TEXAS

MERITAGE HOMES OF TEXAS, LLC,
8840 CYPRESS WATERS BLVD., SUITE 100
DALLAS, TEXAS 75019

PREPARED BY

CORWIN ENGINEERING, INC.

200 W. BELMONT, SUITE E
ALLEN, TEXAS 75013

972-396-1200

NOVEMBER 2016

CASE NO. P2016-003



SHEET 3 OF 3

LIMITS OF 100 YEAR FLOOD PLAIN
 PER LOMR CASE NUMBER 14-06-0263P
 FOR FEMA FIRM PANEL 48397C00301
 EFFECTIVE DATE SEPTEMBER 3, 2014

RUNOFF COMPUTATIONS									
Area #	Area (sq)	Area (acres)	Runoff Coefficient	CA	Tc (min)	Q(100) (cfs)	Q(100) (mgd)	Drains To	
1	107840	2.48	0.50	1.24	10	9.80	12.1	Inlet 1	
2	31904	0.73	0.50	0.37	10	9.80	3.6	Inlet 2	
3	34447	0.79	0.50	0.40	10	9.80	3.9	Inlet 3	
4	99539	2.29	0.50	1.14	10	9.80	11.2	Inlet 4	
5	14448	0.34	0.50	0.17	10	9.80	1.7	Inlet 5	
6	107750	2.47	0.50	1.24	10	9.80	12.1	Inlet 6	
7	33914	0.78	0.50	0.39	10	9.80	3.8	Inlet 7	
8	31321	0.72	0.50	0.36	10	9.80	3.5	Inlet 8	
9	162130	4.18	0.50	2.09	10	9.80	20.5	Inlet 9	
10	34314	0.79	0.50	0.39	10	9.80	3.9	Inlet 10	
11	24396	0.56	0.50	0.28	10	9.80	2.7	Inlet 11	
12	32853	0.76	0.50	0.38	10	9.80	3.7	Inlet 12	
13	39744	0.91	0.50	0.46	10	9.80	4.5	Inlet 13	
14	77900	1.79	0.50	0.89	10	9.80	8.8	Inlet 14	
15	69891	1.60	0.50	0.80	10	9.80	7.9	Inlet 15	
16	95536	2.19	0.50	1.10	10	9.80	10.7	Inlet 16	
17	48027	1.10	0.50	0.55	10	9.80	5.4	Inlet 17	
18	18997	0.43	0.50	0.22	10	9.80	2.1	Inlet 18	
19	62388	1.43	0.50	0.72	10	9.80	7.0	Inlet 19	
20	47277	1.09	0.50	0.54	10	9.80	5.3	Inlet 20	
21	78668	1.81	0.50	0.91	10	9.80	8.9	Inlet 21	
22	132752	3.05	0.50	1.52	10	9.80	14.9	Inlet 22	
23	104576	2.40	0.50	1.20	10	9.80	11.8	Inlet 23	
24	74017	1.70	0.50	0.85	10	9.80	8.3	Inlet 24	
25	46842	1.08	0.50	0.54	10	9.80	5.9	Inlet 25	
25A	52152	1.20	0.50	0.60	10	9.80	5.9	Inlet 25	
26	40189	0.92	0.50	0.46	10	9.80	4.5	Inlet 26	
27	55782	1.28	0.50	0.64	10	9.80	6.3	Inlet 27	
28	244439	5.61	0.50	2.81	10	9.80	27.5	Lat D5a	
29	11443	0.26	0.50	0.13	10	9.80	1.3	Inlet 29	
29A	4508	0.10	0.50	0.05	10	9.80	0.5	Inlet 29	
30	9663	0.21	0.50	0.10	10	9.80	1.0	Inlet 30	
30A	8719	0.20	0.50	0.10	10	9.80	1.0	Inlet 30	
31	8700	0.20	0.50	0.10	10	9.80	1.0	Inlet 31	
31A	8707	0.20	0.50	0.10	10	9.80	1.0	Inlet 31	
32	8700	0.20	0.50	0.10	10	9.80	1.0	Inlet 32	
32A	8718	0.20	0.50	0.10	10	9.80	1.0	Inlet 32	
33	8700	0.20	0.50	0.10	10	9.80	1.0	Inlet 33	
33A	8718	0.20	0.50	0.10	10	9.80	1.0	Inlet 33	
34	8700	0.20	0.50	0.10	10	9.80	1.0	Inlet 34	
34A	8718	0.20	0.50	0.10	10	9.80	1.0	Inlet 34	
35	11600	0.27	0.50	0.13	10	9.80	2.3	Inlet 35	
35A	11623	0.27	0.50	0.13	10	9.80	1.3	Inlet 35	
36	7458	0.17	0.50	0.08	10	9.80	1.5	Inlet 36	
36A	5882	0.14	0.50	0.07	10	9.80	0.7	Inlet 36	
37	41800	0.96	0.50	0.48	10	9.80	4.7	Inlet 37	
38	51851	1.19	0.50	0.60	10	9.80	10.5	Inlet 38	
39	39246	0.90	0.50	0.45	10	9.80	4.4	To Creek	
40	795029	18.25	0.50	9.13	10	9.80	89.4	Line D4	
41	322578	7.41	0.50	3.70	10	9.80	38.3	To Pond	
INT 7	30455	0.70	0.50	0.35	10	9.80	3.4	Interim to Inlet 7	
INT 8	12800	0.29	0.50	0.15	10	9.80	1.4	Interim to Inlet 8	
INT 9	304352	6.99	0.35	2.45	20	8.30	20.3	Interim to Inlet 9	
INT 17	40090	0.92	0.50	0.46	10	9.80	4.5	Interim to Inlet 17	
INT 18	13035	0.30	0.50	0.15	10	9.80	1.5	Interim to Inlet 18	
INT 25	22979	5.96	0.35	2.98	20	8.30	17.3	Interim to Inlet 25	
INT 26	14263	0.33	0.50	0.16	10	9.80	1.6	Interim to Inlet 26	
INT 28	370008	8.49	0.35	2.97	20	8.30	24.7	Interim to Inlet 28	

LEGEND

- PROP. STORM SEWER
- PROP. CURB INLETS
- PROP. CONC. HEADWALL
- EXIST. STORM SEWER
- DRAINAGE AREA DIVIDE
- FLOW ARROW
- DRAINAGE AREA NO.

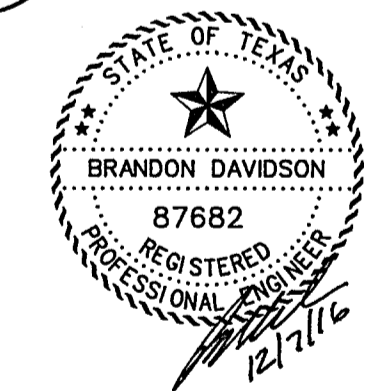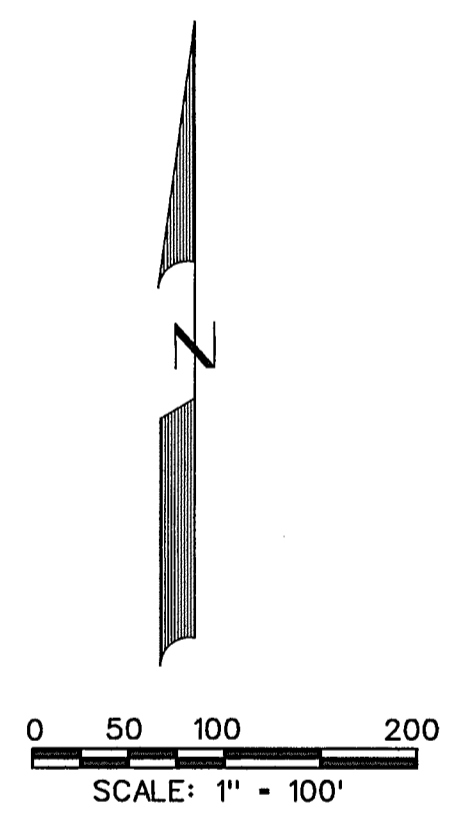


AS-BUILT DECEMBER 2016
 INFORMATION PROVIDED
 BY CONTRACTORS
 (NOT FIELD VERIFIED)

CORWIN ENGINEERING, INC.
 200 W. BELMONT, SUITE E
 ALLEN, TEXAS 75013 (972)396-1200
 TBPE FIRM #5951

DEVELOPMENT PLANS FOR
**STONE CREEK
 PHASE VII**
 ROCKWALL, TEXAS

PROPOSED ULTIMATE CONDITIONS
 DRAINAGE AREA MAP

DRAWN BY	DESIGNED BY	CHECKED BY	SHEET NO.
15047	MARCH 2016	HOR: 1"=100'	3 OF 31

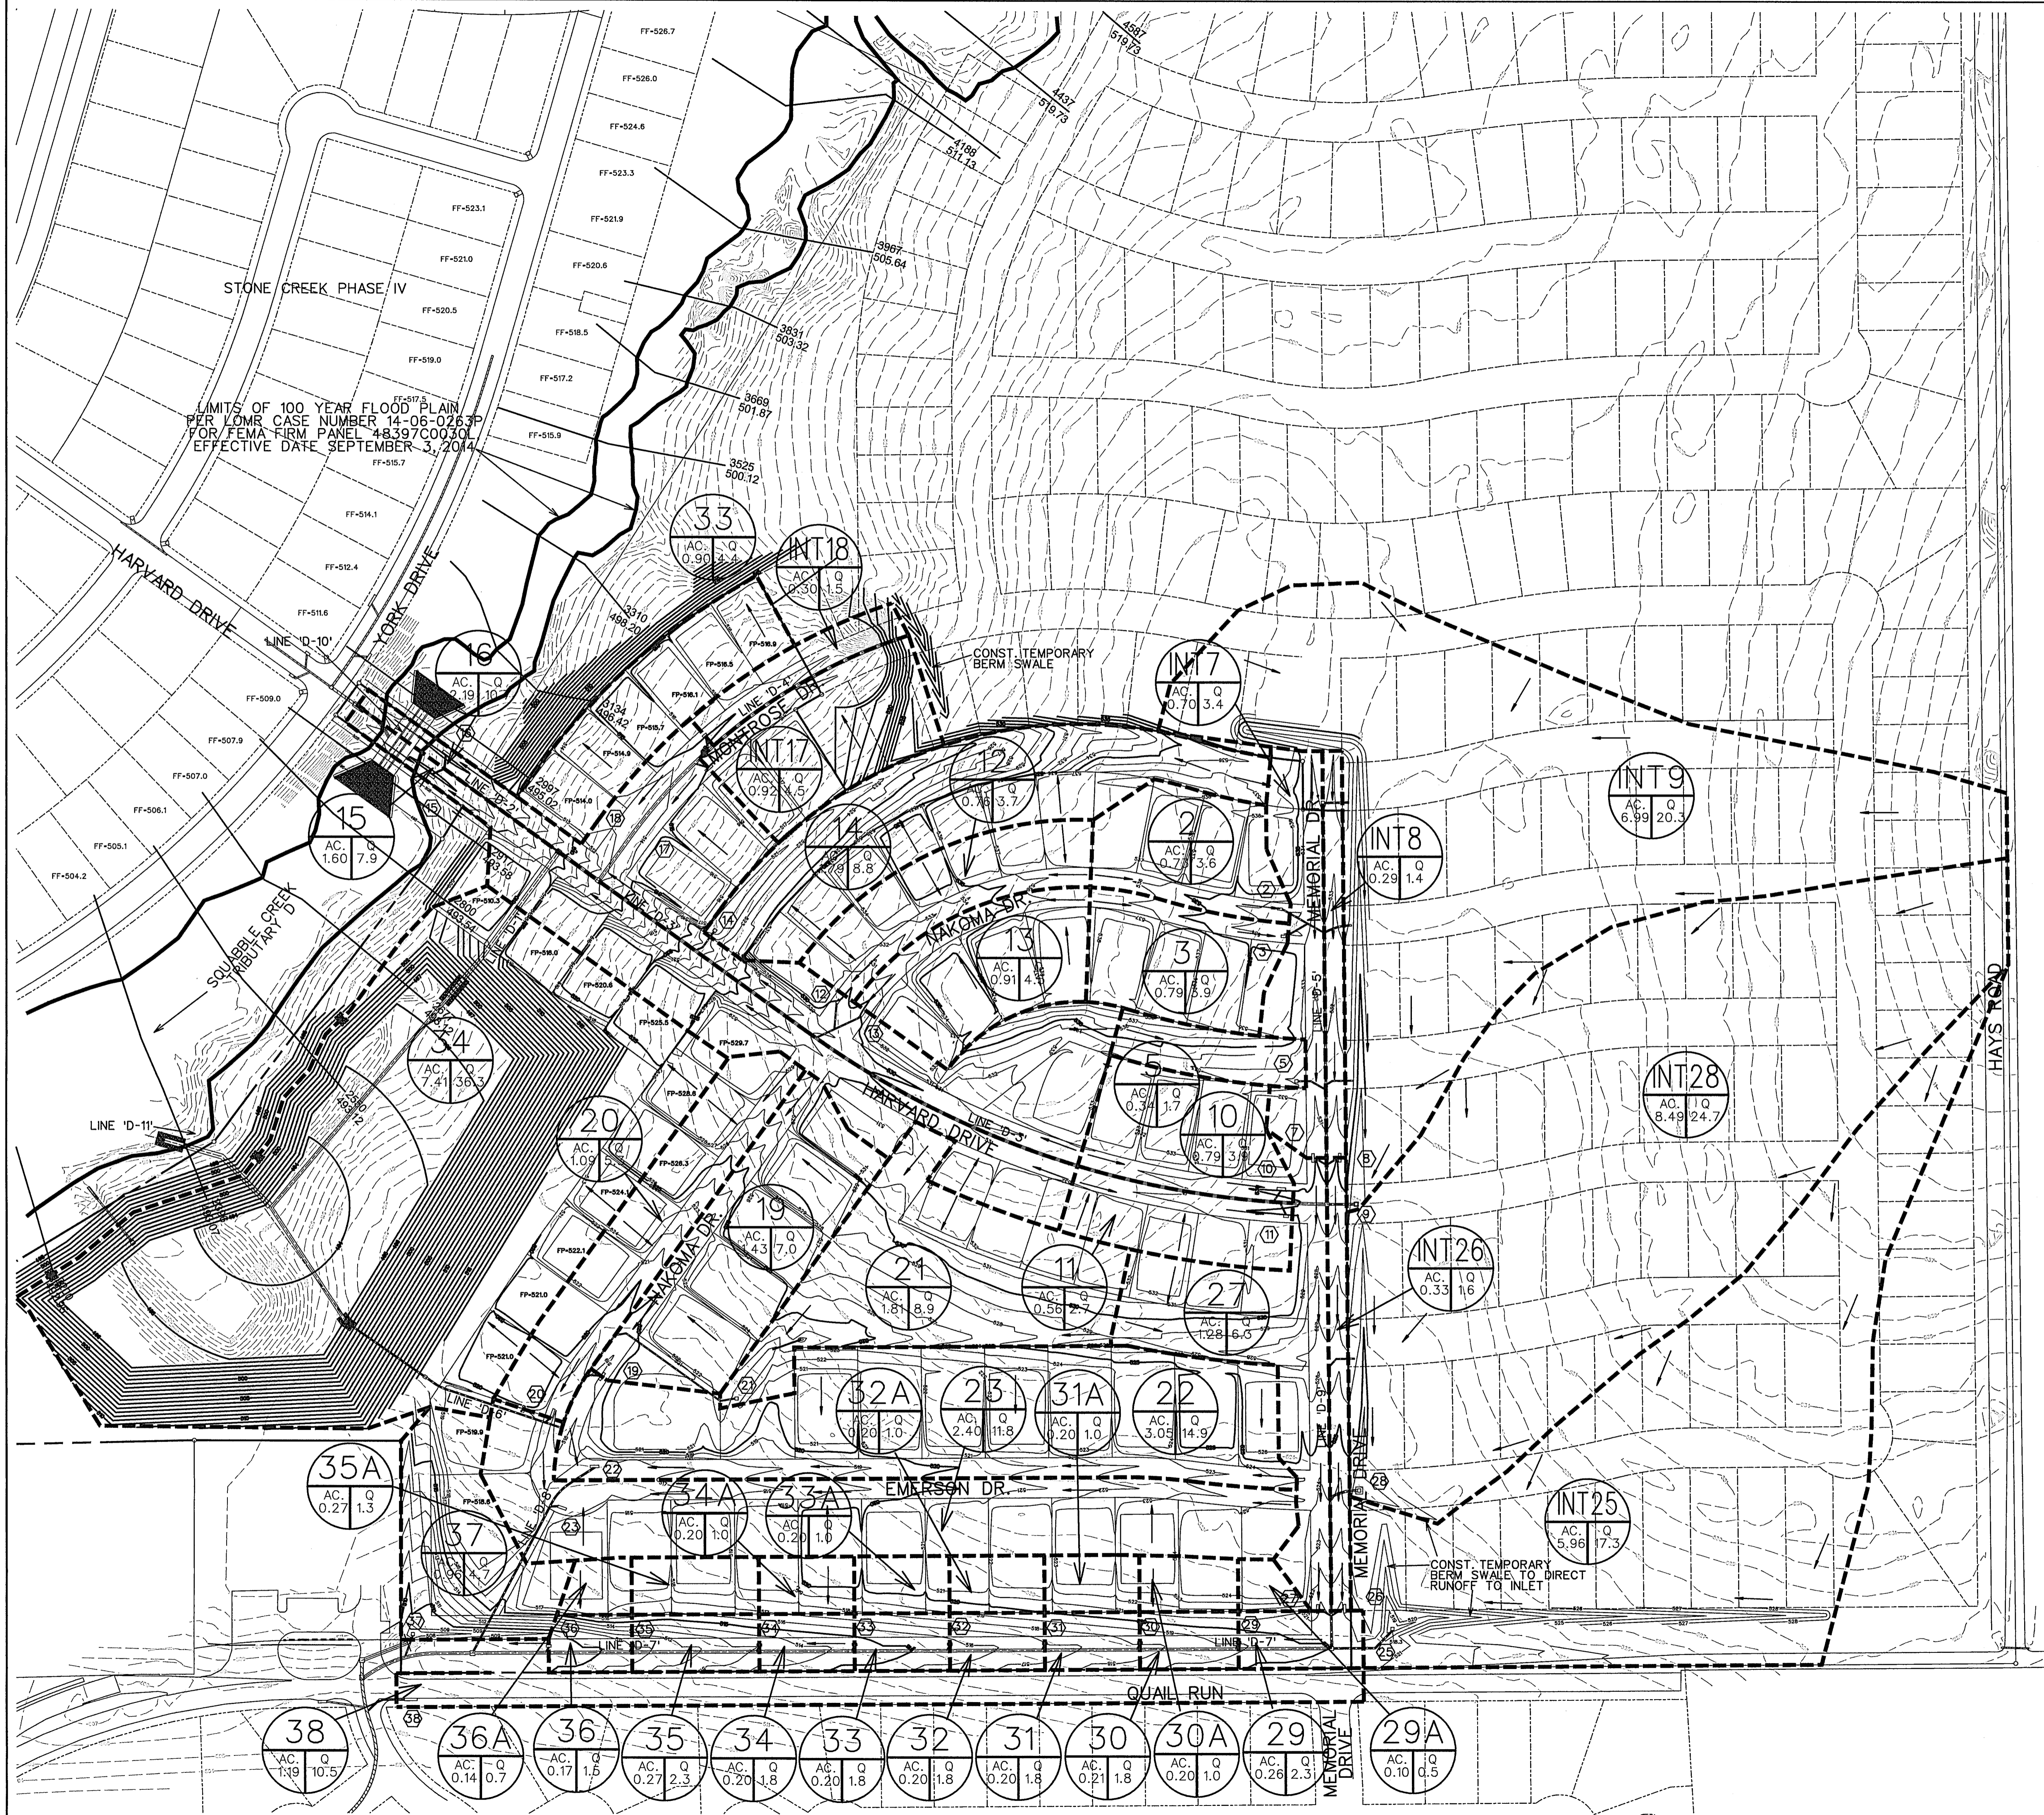

RUNOFF COMPUTATIONS

Area #	Area (sf)	Area (acres)	Runoff Coefficient	CA	Tc (min)	Q(100) (cfs)	Drains To
1	107840	2.48	0.50	1.24	10	9.80	Inlet 1
2	31904	0.73	0.50	0.37	10	9.80	Inlet 2
3	34447	0.79	0.50	0.40	10	9.80	Inlet 3
4	99539	2.29	0.50	1.14	10	9.80	Inlet 4
5	14848	0.34	0.50	0.17	10	9.80	Inlet 5
6	107750	2.47	0.50	1.24	10	9.80	Inlet 6
7	33914	0.78	0.50	0.39	10	9.80	Inlet 7
8	31321	0.72	0.50	0.36	10	9.80	Inlet 8
9	182130	4.18	0.50	2.09	10	9.80	Inlet 9
10	34314	0.79	0.50	0.39	10	9.80	Inlet 10
11	24396	0.56	0.50	0.28	10	9.80	Inlet 11
12	32553	0.76	0.50	0.38	10	9.80	Inlet 12
13	39744	0.91	0.50	0.46	10	9.80	Inlet 13
14	77900	1.79	0.50	0.89	10	9.80	Inlet 14
15	69881	1.60	0.50	0.80	10	9.80	Inlet 15
16	95536	2.19	0.50	1.10	10	9.80	Inlet 16
17	48927	1.10	0.50	0.55	10	9.80	Inlet 17
18	18897	0.43	0.50	0.22	10	9.80	Inlet 18
19	62388	1.43	0.50	0.72	10	9.80	Inlet 19
20	47277	1.09	0.50	0.54	10	9.80	Inlet 20
21	78968	1.81	0.50	0.91	10	9.80	Inlet 21
22	132752	3.05	0.50	1.52	10	9.80	Inlet 22
23	104576	2.40	0.50	1.20	10	9.80	Inlet 23
24	74017	1.70	0.50	0.85	10	9.80	Inlet 24
25	48842	1.08	0.90	0.97	10	9.80	Inlet 25
26	40189	0.92	0.50	0.46	10	9.80	Inlet 26
27	55782	1.28	0.50	0.64	10	9.80	Inlet 27
28	244439	5.61	0.50	2.81	10	9.80	Inlet 28
29	14443	0.33	0.50	0.17	10	9.80	Inlet 29
29A	4538	0.10	0.50	0.05	10	9.80	Inlet 29
30	9063	0.21	0.90	0.19	10	9.80	Inlet 30
30A	8719	0.20	0.50	0.10	10	9.80	Inlet 30
31	8700	0.20	0.90	0.18	10	9.80	Inlet 31
31A	8707	0.20	0.50	0.10	10	9.80	Inlet 31
32	8700	0.20	0.90	0.18	10	9.80	Inlet 32
32A	8718	0.20	0.50	0.10	10	9.80	Inlet 32
33	8700	0.20	0.90	0.18	10	9.80	Inlet 33
33A	8718	0.20	0.50	0.10	10	9.80	Inlet 33
34	8700	0.20	0.90	0.18	10	9.80	Inlet 34
34A	8718	0.20	0.50	0.10	10	9.80	Inlet 34
35	11600	0.27	0.90	0.24	10	9.80	Inlet 35
35A	11623	0.27	0.50	0.13	10	9.80	Inlet 35
36	7458	0.17	0.90	0.15	10	9.80	Inlet 36
36A	5882	0.14	0.50	0.07	10	9.80	Inlet 36
37	41800	0.96	0.50	0.48	10	9.80	Inlet 37
38	51851	1.19	0.90	1.07	10	9.80	Inlet 38
39	35266	0.80	0.50	0.40	10	9.80	Inlet 39
40	795029	18.25	0.50	9.13	10	9.80	Line D4
41	322578	7.41	0.50	3.70	10	9.80	To Pond
INT 7	30455	0.70	0.50	0.35	10	9.80	Inlet 7
INT 8	12800	0.29	0.50	0.15	10	9.80	Inlet 8
INT 9	30452	0.69	0.35	0.25	20	6.30	Inlet 9
INT 17	40290	0.92	0.50	0.46	10	9.80	Inlet 17
INT 18	13035	0.30	0.50	0.15	10	9.80	Inlet 18
INT 25	259779	5.96	0.35	2.09	20	6.30	Inlet 25
INT 26	14263	0.33	0.50	0.16	10	9.80	Inlet 26
INT 28	370006	8.49	0.35	2.97	20	6.30	Inlet 28

LEGEND

- PROP. STORM SEWER
- PROP. CURB INLETS
- PROP. CONC. HEADWALL
- EXIST. STORM SEWER
- DRAINAGE AREA DIVIDE
- FLOW ARROW
- DRAINAGE AREA NO.

0 50 100 200
SCALE: 1" = 100'


AS-BUILT DECEMBER 2016
INFORMATION PROVIDED BY CONTRACTORS (NOT FIELD VERIFIED)

CORWIN ENGINEERING, INC.
200 W. BELMONT, SUITE E
ALLEN, TEXAS 75013 (972)396-1200
TBPE FIRM #5951

**DEVELOPMENT PLANS FOR
STONE CREEK
PHASE VII
ROCKWALL, TEXAS**

INTERIM CONDITIONS DRAINAGE AREA MAP

DRAWN BY	DESIGNED BY	CHECKED BY	SHEET NO.
JOB NUMBER	DATE	SCALE	
15047	MARCH 2016	HOR: 1"=100'	3B OF 31

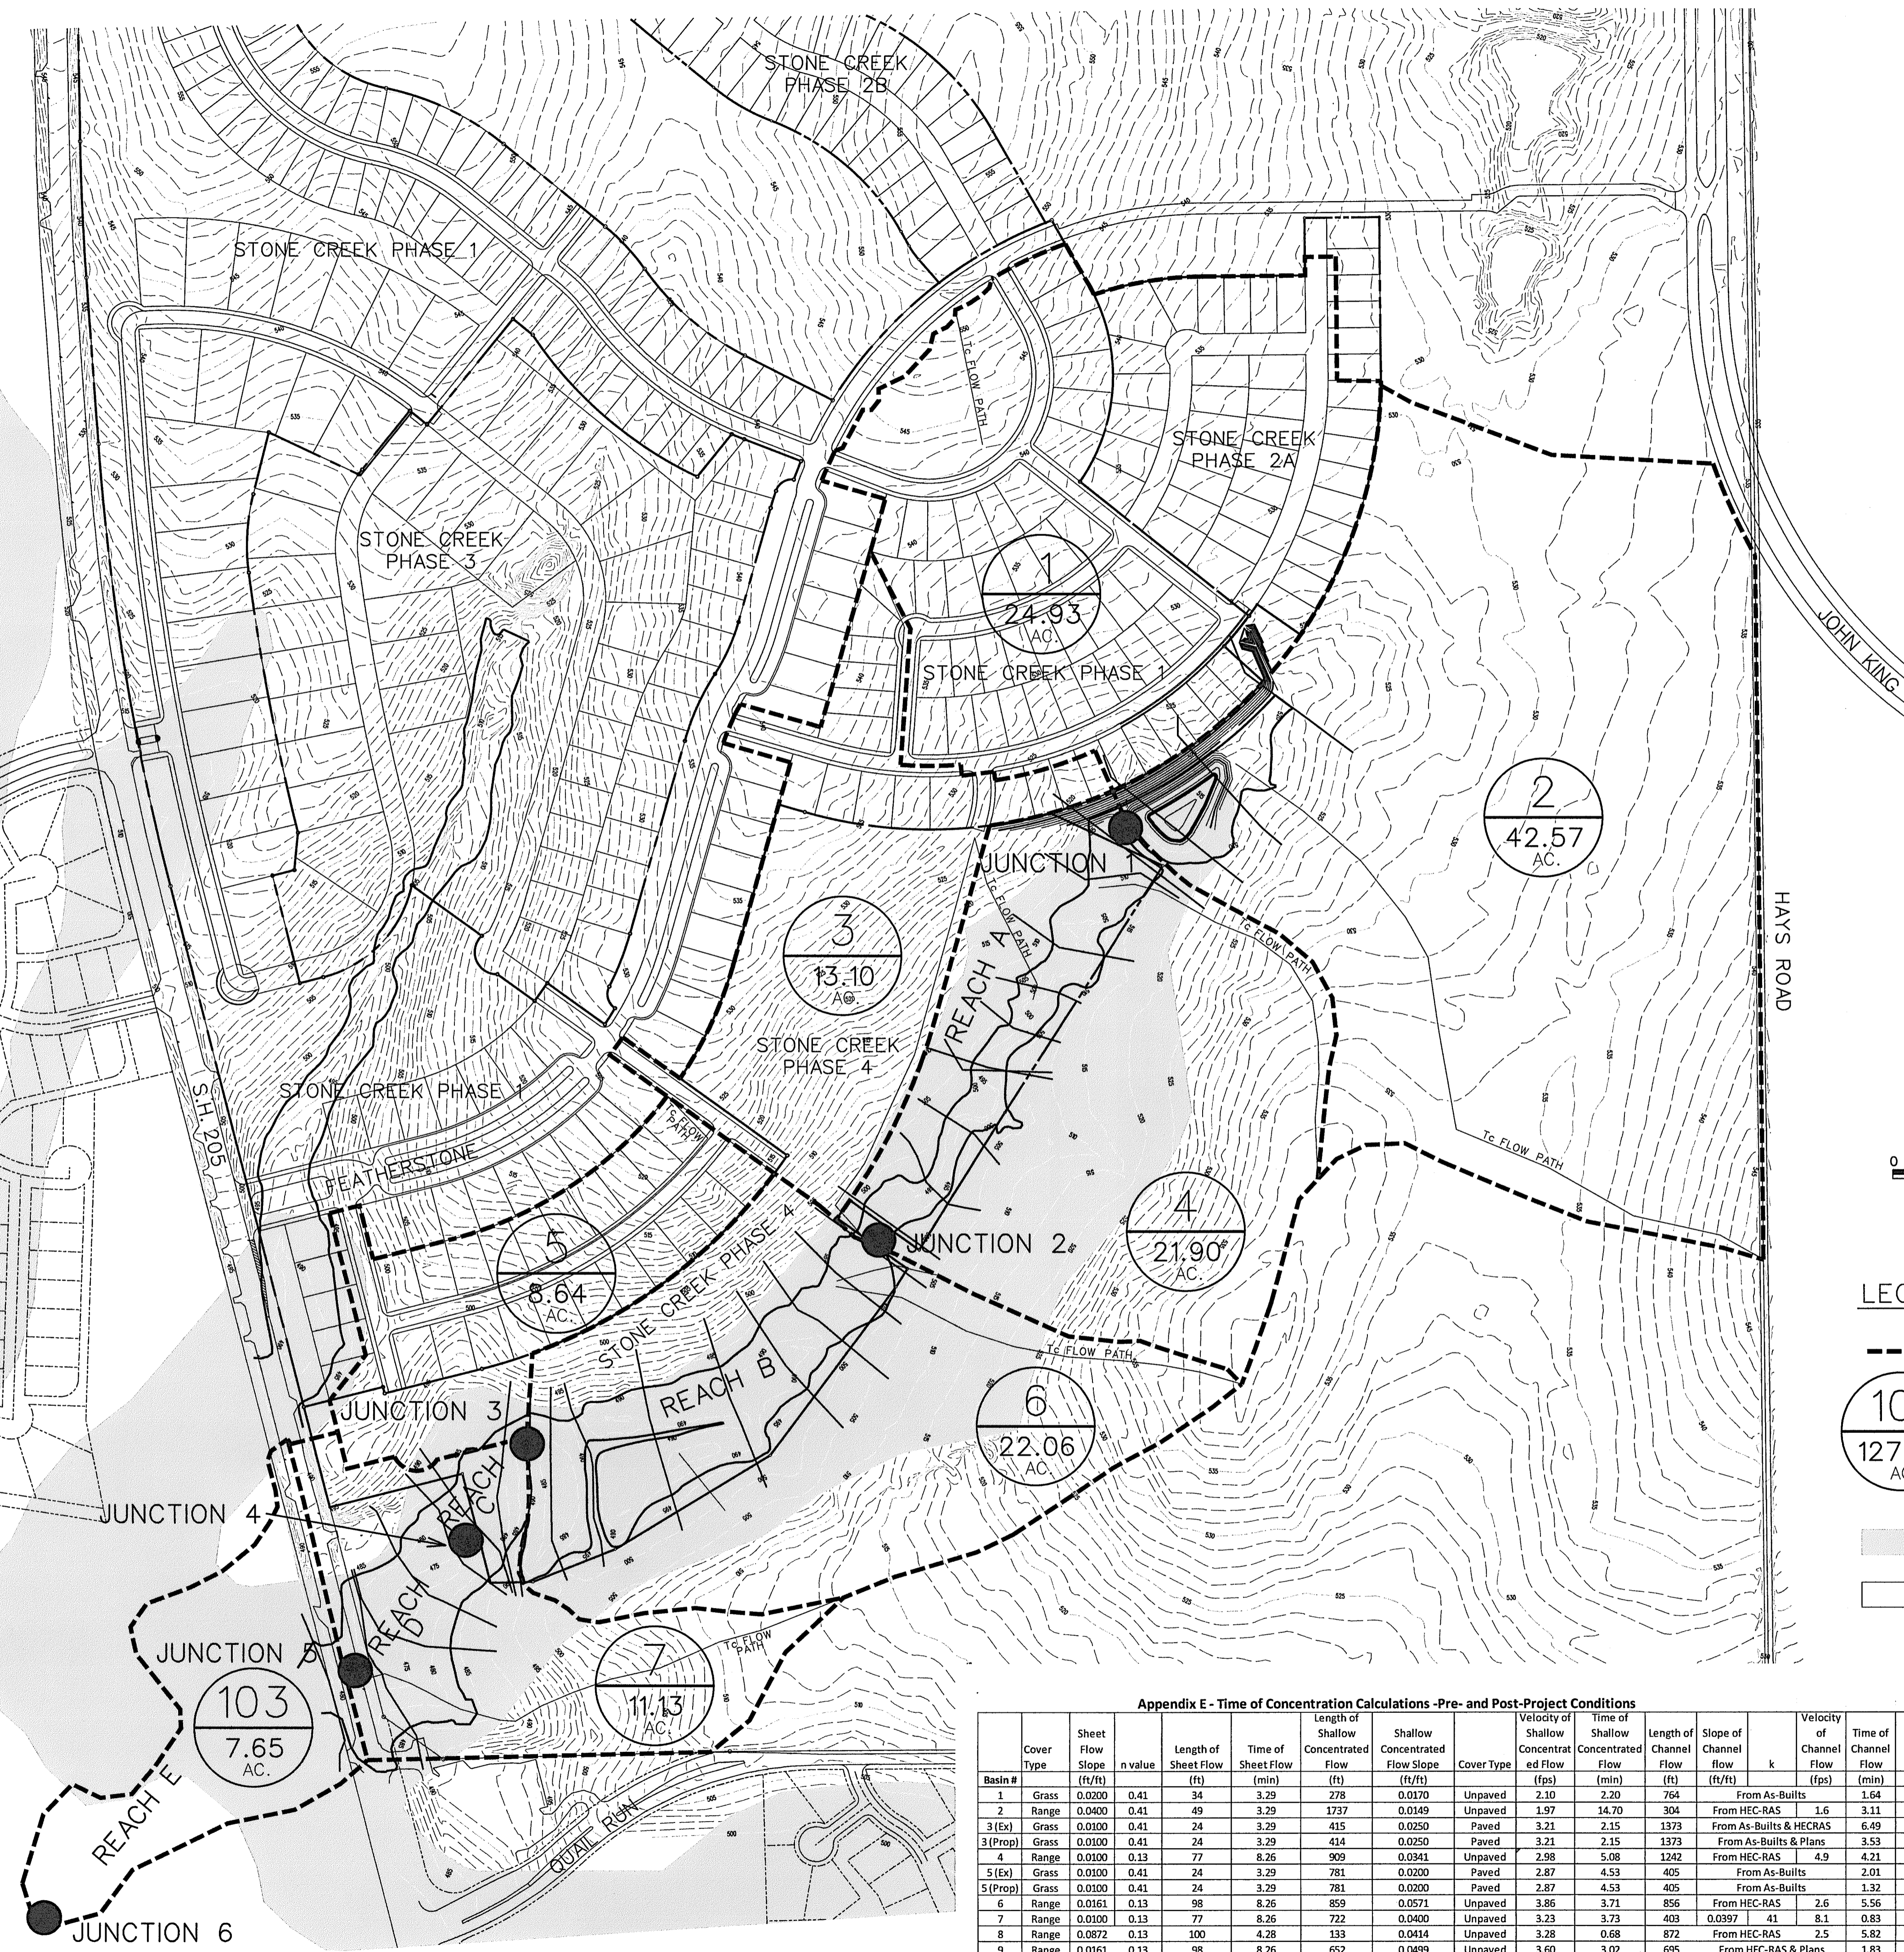

DRAINAGE BASIN ATTRIBUTES

Basin #	Sq. Ft.	Acres	Sq. Mi.	Future Land Use						Weighted CN
				Type C Soil		Type D Soil		Type D Soil		
				Open Space	Single Family Lot Size	Open Space	Single Family Lot Size	Open Space	Single Family Lot Size	
1	1085911	24.93	0.0390	0	0	0	125989	959922		95.64
2	1854244	42.57	0.0665	52310			1801934			90.10
3 (Ex)	570777	13.10	0.0205	4660			392738	173379		92.04
3 (Prop)	570777	13.10	0.0205		4660			566117		96.35
4	953767	21.90	0.0342	505506	37995		377976	327293		88.78
5 (Ex)	376382	8.64	0.0135					337708		96.26
5 (Prop)	513765	11.79	0.0184			39074	9758	174875	290058	94.81
6	960755	22.06	0.0345	524031				436724		88.32
7	484878	11.13	0.0174	256669				228209		88.37
8	387445	8.89	0.0139	352855				34590		87.06
9	435927	10.01	0.0156	161019				274908		88.92
103	333219	7.65	0.0120							76.87


Used Values from MDS

DATA TAKEN FROM DRAINAGE STUDY FOR SQUABBLE CREEK TRIBUTARY D, DONE WITH THE STONE CREEK PHASE IV DEVELOPMENT, DATED FEBRUARY, 2013

HEC-HMS RESULTS - PRE-PROJECT FLOW

Hydrologic Element	Drainage Area (SQM)	10 Year Peak Flow	50 Year Peak Flow	100 Year Peak Flow	500 Year Peak Flow
Junction-1	0.1055	282.8	380.3	428.8	532.4
Junction-2	0.1602	311.9	466.5	547.7	714.6
Junction-3	0.1947	295.2	469.4	545.5	711.2
Junction-4	0.2082	308.9	462.5	539.9	702.2
Junction-5	0.2256	306.5	418.3	463.4	576.8
Junction-6	0.2376	310.0	423.7	469.7	585.2
Reach-A	0.1055	207.6	307.5	358.0	464.0
Reach-B	0.1602	250.3	393.3	453.4	579.6
Reach-C	0.1947	294.9	445.0	519.2	674.7
Reach-D	0.2082	292.5	405.1	449.5	560.1
Reach-E	0.2256	304.7	417.3	462.4	575.9
Reservoir-1	0.1055	221.0	335.2	390.4	493.3
Subbasin-1	0.0390	141.9	188.2	211.3	260.7
Subbasin-103	0.0120	32.2	47.1	54.5	70.5
Subbasin-2	0.0665	175.7	238.1	269.2	335.3
Subbasin-3	0.0205	65.9	88.6	99.8	123.8
Subbasin-4	0.0342	94.6	129.0	146.1	182.5
Subbasin-5	0.0135	47.0	62.2	69.9	88.1
Subbasin-6	0.0245	94.8	129.6	146.8	183.6
Subbasin-7	0.0174	52.4	71.6	81.1	101.4

DATA TAKEN FROM DRAINAGE STUDY FOR SQUABBLE CREEK TRIBUTARY D, DONE WITH THE STONE CREEK PHASE IV DEVELOPMENT, DATED FEBRUARY, 2013

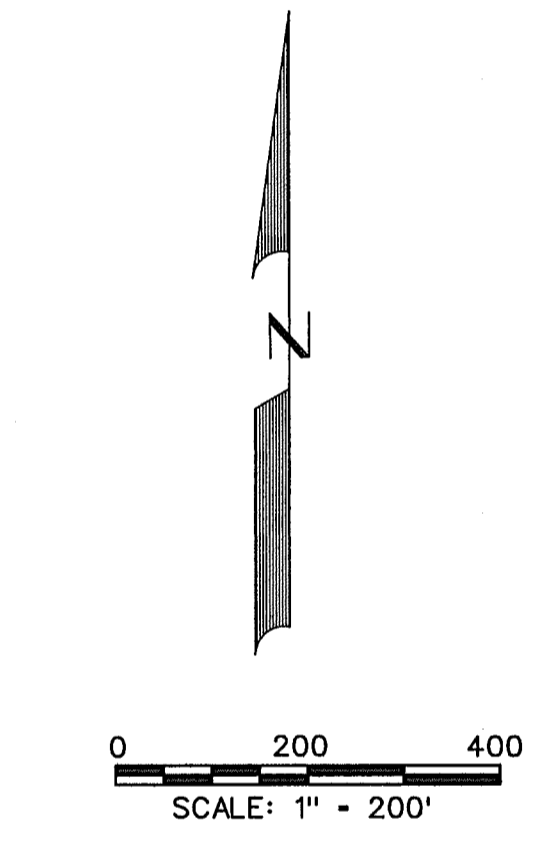

- LEGEND**
- DRAINAGE AREA DIVIDE
 - 101
127.32 AC. DRAINAGE AREA NO.
 - HYDROLOGIC GROUP C SOIL
 - HYDROLOGIC GROUP D SOIL



AS-BUILT DECEMBER 2016
INFORMATION PROVIDED BY CONTRACTORS (NOT FIELD VERIFIED)

Appendix E - Time of Concentration Calculations - Pre- and Post-Project Conditions

Basin #	Cover Type	Sheet Flow Slope (ft/ft)	n value	Length of Sheet Flow (ft)	Time of Sheet Flow (min)	Length of Shallow Concentrated Flow (ft)	Shallow Concentrated Flow Slope (ft/ft)	Cover Type	Velocity of Shallow Concentrated Flow (fps)	Time of Shallow Concentrated Flow (min)	Length of Channel Flow (ft)	Slope of Channel Flow (ft/ft)	Velocity of Channel Flow (fps)	Time of Channel Flow (min)	Total Time of Concentration (min)	Lag Time (0.6 * Tc) (hr)		
1	Grass	0.0200	0.41	34	3.29	278	0.0170	Unpaved	2.10	2.20	764	From As-Built	1.64	7.14	0.12	4.28		
2	Range	0.0400	0.41	49	3.29	1737	0.0149	Unpaved	1.97	14.70	304	From HEC-RAS	1.6	3.11	21.10	0.35	12.66	
3 (Ex)	Grass	0.0100	0.41	24	3.29	415	0.0250	Paved	3.21	2.15	1373	From As-Built & HEC-RAS	6.49	11.93	0.20	7.16		
3 (Prop)	Grass	0.0100	0.41	24	3.29	414	0.0250	Paved	3.21	2.15	1373	From As-Built & Plans	3.53	8.97	0.15	5.38		
4	Range	0.0100	0.13	77	8.26	909	0.0341	Unpaved	2.98	5.08	1242	From HEC-RAS	4.9	4.21	17.55	0.29	10.53	
5 (Ex)	Grass	0.0100	0.41	24	3.29	781	0.0200	Paved	2.87	4.53	405	From As-Built	2.01	9.83	0.16	5.90		
5 (Prop)	Grass	0.0100	0.41	24	3.29	781	0.0200	Paved	2.87	4.53	405	From As-Built	1.32	9.14	0.15	5.49		
6	Range	0.0161	0.13	98	8.26	859	0.0571	Unpaved	3.86	3.71	856	From HEC-RAS	2.6	5.56	17.53	0.29	10.52	
7	Range	0.0100	0.13	77	8.26	722	0.0400	Unpaved	3.23	3.73	403	0.0397	41	8.1	0.83	12.81	0.21	7.69
8	Range	0.0872	0.13	100	4.28	133	0.0414	Unpaved	3.28	0.68	872	From HEC-RAS	2.5	5.82	10.78	0.18	6.47	
9	Range	0.0161	0.13	98	8.26	652	0.0499	Unpaved	3.60	3.02	695	From HEC-RAS & Plans	1.83	13.10	0.22	7.86		
103														6.90	0.12	4.14		

Used Values from MDS


DATA TAKEN FROM DRAINAGE STUDY FOR SQUABBLE CREEK TRIBUTARY D, DONE WITH THE STONE CREEK PHASE IV DEVELOPMENT, DATED FEBRUARY, 2013

CORWIN ENGINEERING, INC.
200 W. BELMONT, SUITE E
ALLEN, TEXAS 75013 (972)396-1200
TBP FIRM #5951

DEVELOPMENT PLANS FOR STONE CREEK PHASE VII
ROCKWALL, TEXAS

EXISTING CONDITIONS DRAINAGE AREA MAP

DRAWN BY	DESIGNED BY	CHECKED BY	SHEET NO.
JOB NUMBER	DATE	SCALE:	4 of 31
15047	MARCH 2016	1"=200'	

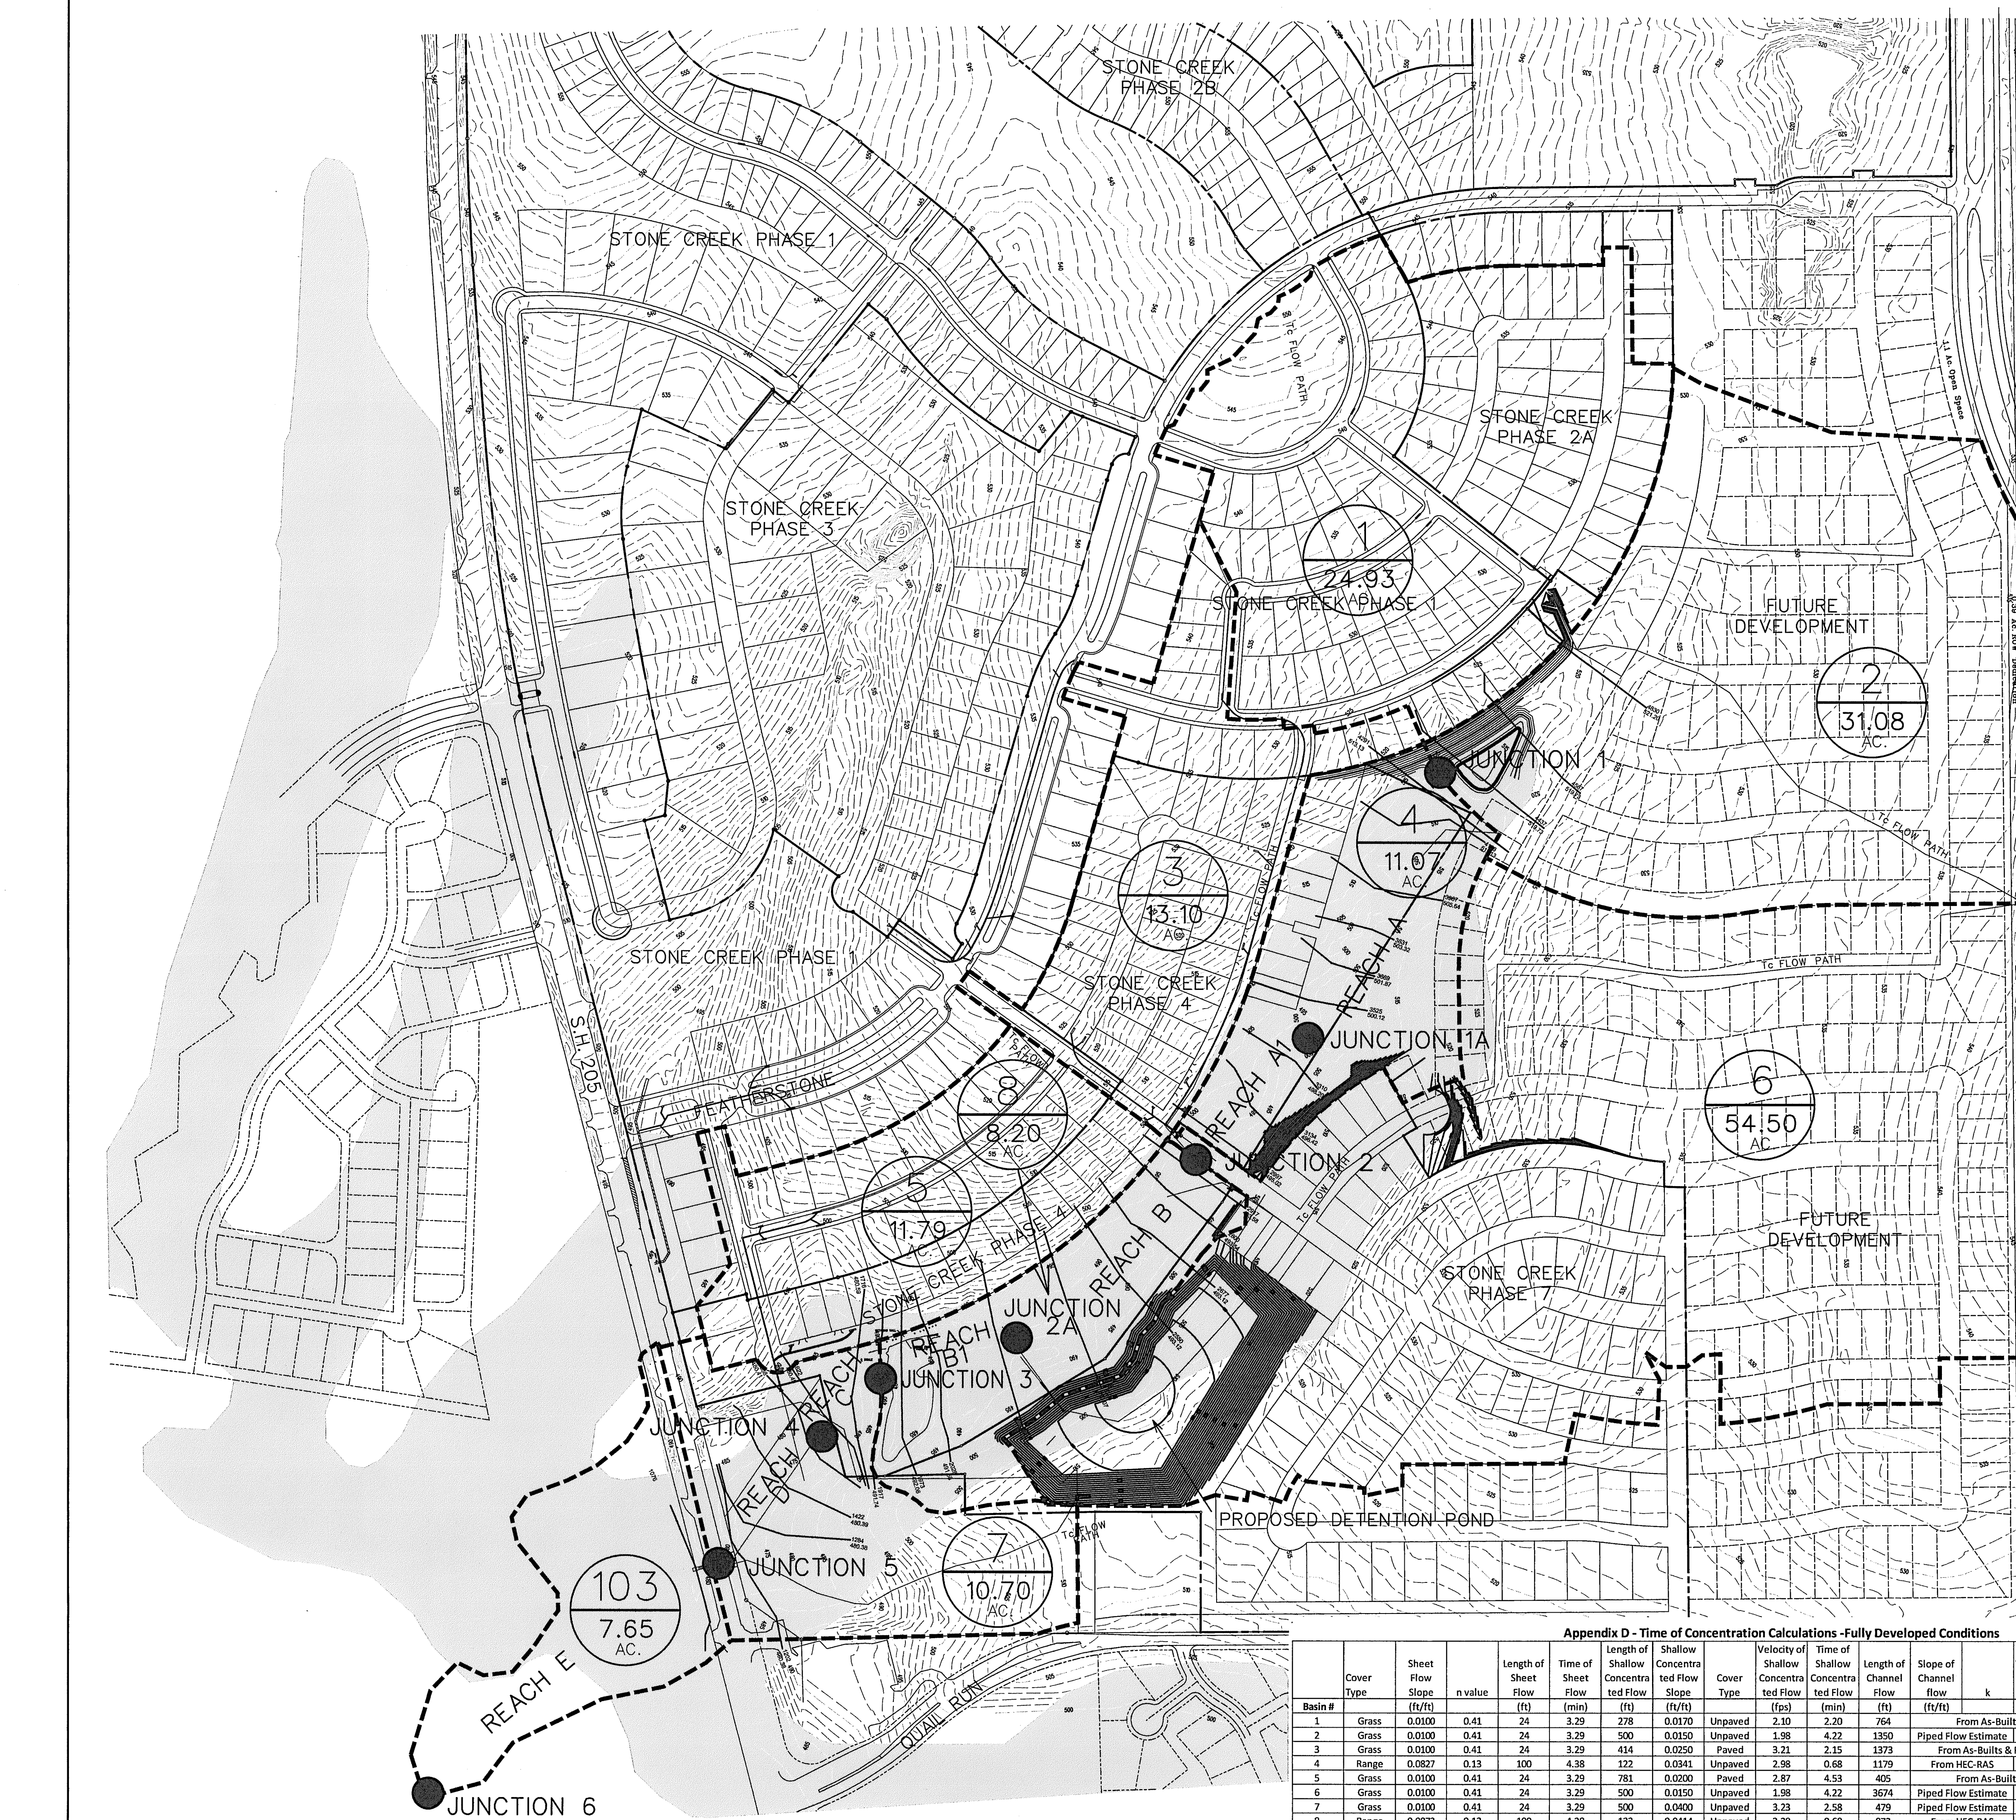

DRAINAGE BASIN ATTRIBUTES - Fully Developed Conditions

Basin #	Sq. Ft.	Acres	Sq. Mi.	Future Land Use			Type C Soil			Type D Soil			Weighted CN (ac)
				Open Space	1/8 Acre	1/4 Acre	Open Space	1/8 Acre	1/4 Acre	Commercial	Open Space	1/8 Acre	
1	108911	24.93	0.0390	0	0	0	125989	959922					95.64
2	1353941	31.08	0.0486	48161	4063		145775	1155942					95.35
3	570777	13.10	0.0205		4660			566117					96.35
4	482250	11.07	0.0173	356946	80697		12316	32291					88.93
5	513765	11.79	0.0184		39074	9758		174875	290058				94.81
6	2374060	54.50	0.0852	129419	163412		119747	1961482					95.46
7	466190	10.70	0.0167	171253			85143	56966				152828	92.71
8	357279	8.20	0.0128	324219	2500			30560					87.10
103	333219	7.65	0.0120										76.87

DATA TAKEN FROM DRAINAGE STUDY FOR SQUABBLE CREEK TRIBUTARY D DONE WITH THE STONE CREEK PHASE VII DEVELOPMENT, DATED JANUARY, 2016.

HEC-HMS RESULTS - FULLY DEVELOPED CONDITIONS FLOW

Hydrologic Element	Drainage Area (SQM)	10 Year Peak Flow	50 Year Peak Flow	100 Year Peak Flow	500 Year Peak Flow
Junction-1	0.0876	305.7	405.7	455.6	562.3
Junction-1A	0.1035	221.4	333.7	395.2	522.7
Junction-2	0.1240	259.3	387.3	458.9	608.7
Junction-2A	0.2106	259.1	394.3	478.4	682.8
Junction-3	0.2234	264.4	409.7	477.5	689.2
Junction-4	0.2418	275.4	418.0	475.5	625.5
Junction-5	0.2585	273.1	383.0	433.0	568.4
Junction-6	0.2705	275.9	387.7	438.0	575.5
Reach-A	0.0876	192.2	288.0	339.8	449.1
Reach-A1	0.1035	220.3	331.1	391.6	518.6
Reach-B	0.1240	194.2	302.0	365.6	475.7
Reach-B1	0.2106	255.5	391.3	458.0	620.6
Reach-C	0.2234	264.2	400.3	459.7	607.3
Reach-D	0.2418	265.7	373.4	423.0	557.2
Reach-E	0.2585	271.6	381.8	431.8	568.1
Reservoir-1	0.0876	212.5	334.6	393.8	500.8
Reservoir-2 FD	0.0866	65.1	102.5	131.8	213.3
Subbasin-1	0.0390	141.9	188.2	211.3	260.7
Subbasin-103	0.0120	32.2	47.1	54.5	70.5
Subbasin-2	0.0486	166.4	221.0	248.2	306.3
Subbasin-3	0.0205	72.4	95.9	107.6	132.7
Subbasin-4	0.0159	56.5	77.0	87.1	108.7
Subbasin-5	0.0184	64.2	85.3	95.8	118.4
Subbasin-6	0.0866	266.1	353.3	396.7	489.7
Subbasin-7	0.0167	59.6	79.8	89.8	111.3
Subbasin-8	0.0128	45.5	62.5	71.0	89.0

DATA TAKEN FROM DRAINAGE STUDY FOR SQUABBLE CREEK TRIBUTARY D DONE WITH THE STONE CREEK PHASE VII DEVELOPMENT, DATED JANUARY, 2016.

LEGEND

- DRAINAGE AREA DIVIDE
- 1
127.32
AC. DRAINAGE AREA NO.
- HYDROLOGIC GROUP C SOIL
- HYDROLOGIC GROUP D SOIL



AS-BUILT DECEMBER 2016
INFORMATION PROVIDED BY CONTRACTORS (NOT FIELD VERIFIED)

Appendix D - Time of Concentration Calculations - Fully Developed Conditions

Basin #	Cover Type	Sheet Flow Slope (ft/ft)	n value	Length of Sheet Flow (ft)	Time of Sheet Flow (min)	Length of Shallow Concentrated Flow (ft)	Shallow Concentrated Flow Slope (ft/ft)	Cover Type	Velocity of Concentrated Flow (fps)	Time of Concentrated Flow (min)	Length of Channel Flow (ft)	Slope of Channel Flow (ft/ft)	Velocity of Channel Flow (fps)	Time of Channel Flow (min)	Total Time of Concentration		Lag Time (min)
															(min)	(hr)	
1	Grass	0.0100	0.41	24	3.29	278	0.0170	Unpaved	2.10	2.20	764		8.0	1.64	7.14	0.12	4.28
2	Grass	0.0100	0.41	24	3.29	500	0.0150	Unpaved	1.98	4.22	1350		8.0	2.81	10.32	0.17	6.19
3	Grass	0.0100	0.41	24	3.29	414	0.0250	Paved	3.21	2.15	1373		4.9	8.97	0.15	5.38	
4	Range	0.0827	0.13	100	4.28	122	0.0341	Unpaved	2.98	0.68	1179		8.0	4.00	9.05	0.15	5.43
5	Grass	0.0100	0.41	24	3.29	781	0.0200	Paved	2.87	4.53	405		8.0	1.32	9.14	0.15	5.49
6	Grass	0.0100	0.41	24	3.29	500	0.0150	Unpaved	1.98	4.22	2674		8.0	7.65	15.17	0.25	9.10
7	Grass	0.0100	0.41	24	3.29	500	0.0400	Unpaved	3.23	2.58	479		8.0	1.00	6.87	0.11	4.12
8	Range	0.0872	0.13	100	4.28	133	0.0414	Unpaved	3.28	0.68	872		2.5	5.82	10.78	0.18	6.47
103															6.90	0.12	4.14


DATA TAKEN FROM DRAINAGE STUDY FOR SQUABBLE CREEK TRIBUTARY D DONE WITH THE STONE CREEK PHASE VII DEVELOPMENT, DATED JANUARY, 2016.

CORWIN ENGINEERING, INC.
200 W. BELMONT, SUITE E
ALLEN, TEXAS 75013 (972)396-1200
TBPE FIRM #5951

DEVELOPMENT PLANS FOR STONE CREEK PHASE VII ROCKWALL, TEXAS


FULLY DEVELOPED CONDITIONS OVERALL DRAINAGE AREA MAP

DRAWN BY	DESIGNED BY	CHECKED BY	SHEET NO.
JOB NUMBER	DATE	SCALE:	5 OF 31
15047	MARCH 2016	1"=200'	

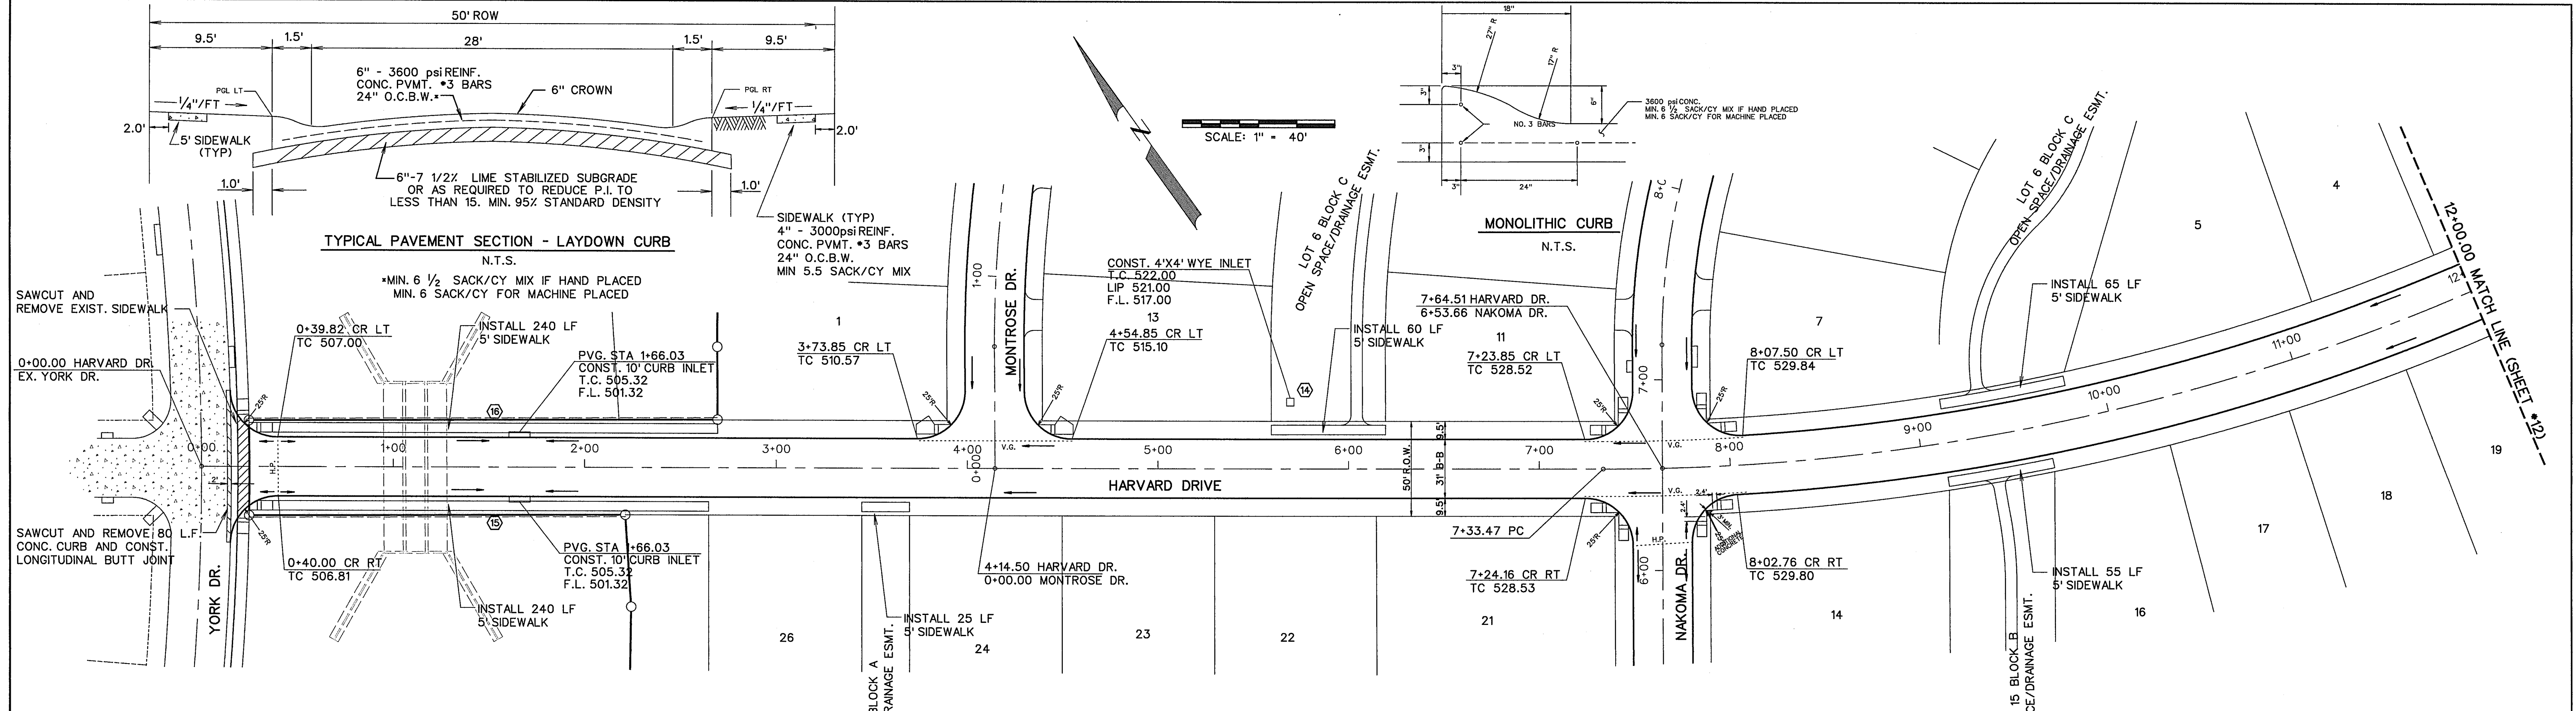


BENCHMARK:
 CITY OF ROCKWALL SURVEY MONUMENT ON AN INLET AT THE NORTHWEST CORNER OF FEATHERSTONE DR. AND HARVARD DR.
 ELEV. = 525.31

NOTE:
 INSTALL BARRIER FREE RAMPS TXDOT PED 12-A TYPE 7 (SEE SHEET *10)

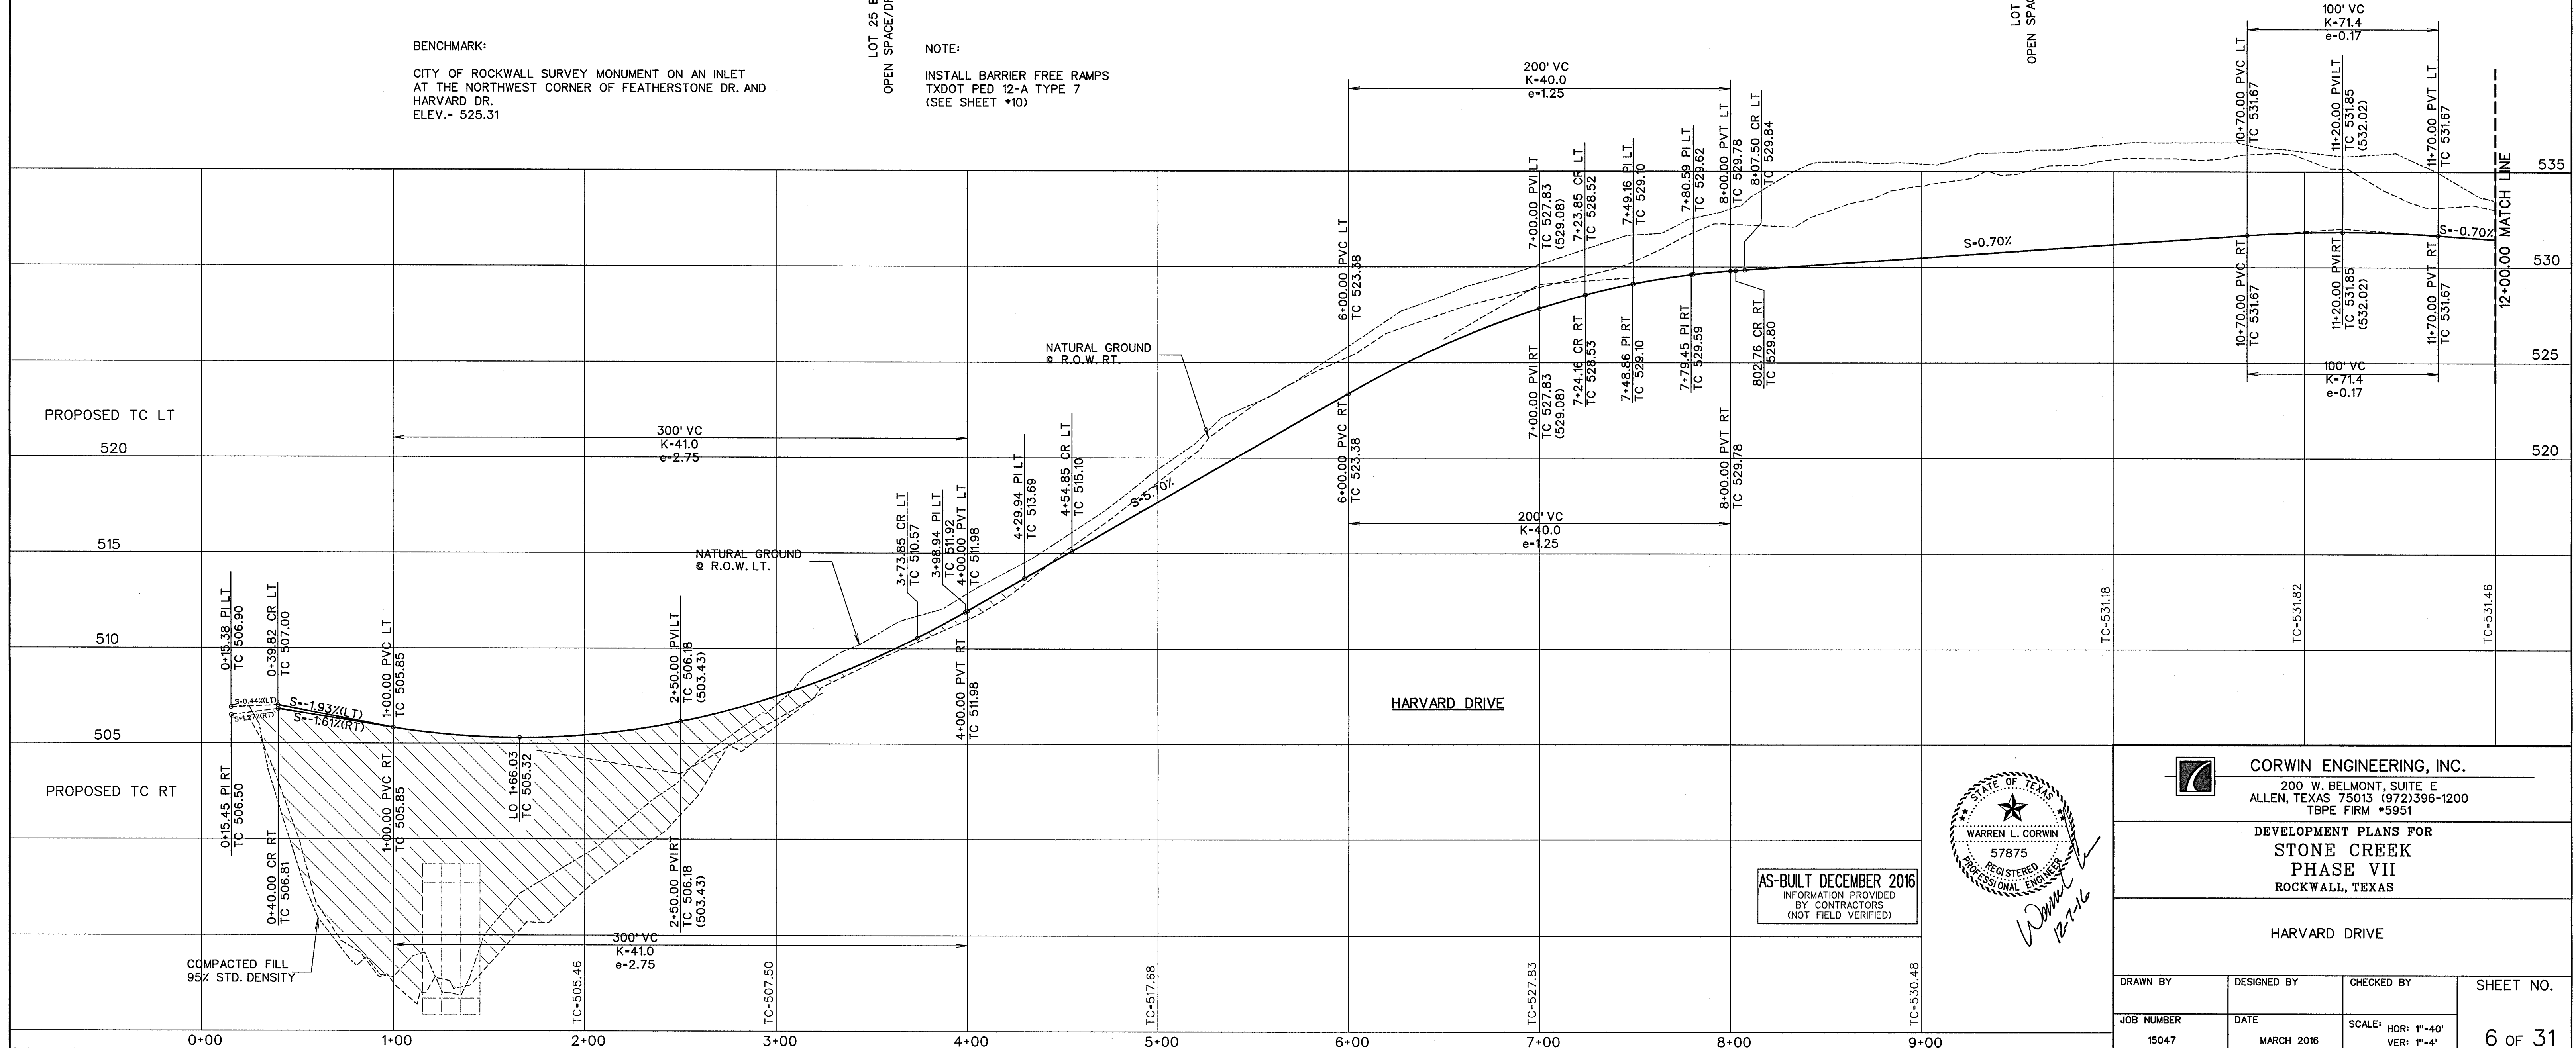

AS-BUILT DECEMBER 2016
 INFORMATION PROVIDED BY CONTRACTORS (NOT FIELD VERIFIED)



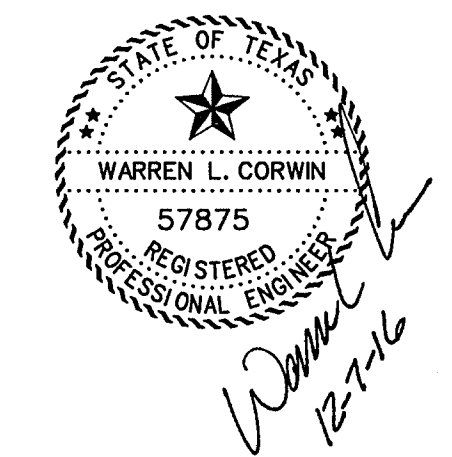


CORWIN ENGINEERING, INC.
 200 W. BELMONT, SUITE E
 ALLEN, TEXAS 75013 (972)396-1200
 TBPE FIRM #5951

**DEVELOPMENT PLANS FOR
 STONE CREEK
 PHASE VII
 ROCKWALL, TEXAS**


HARVARD DRIVE

DRAWN BY	DESIGNED BY	CHECKED BY	SHEET NO.
JOB NUMBER	DATE	SCALE: HOR: 1"=40' VER: 1"=4"	6 OF 31
15047	MARCH 2016		

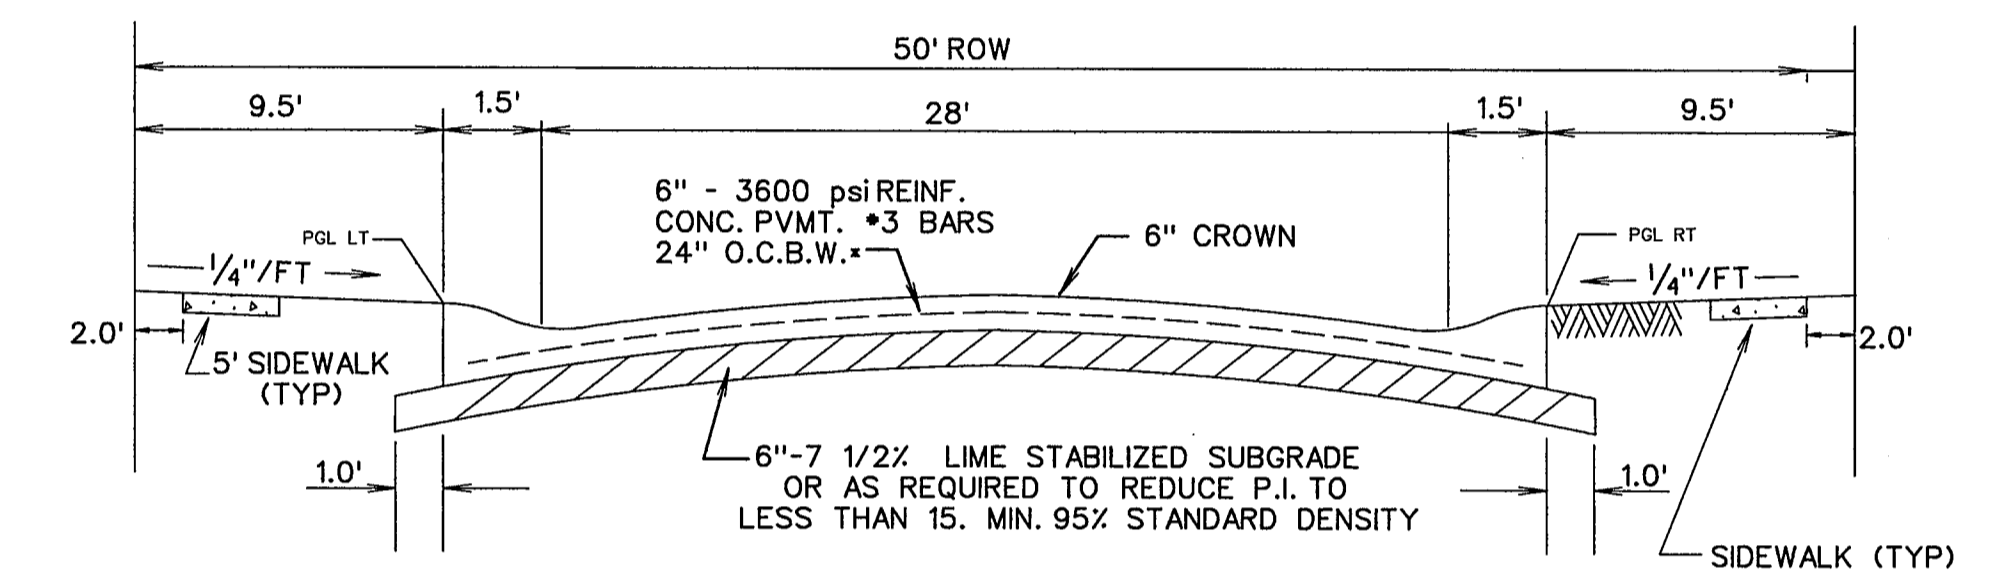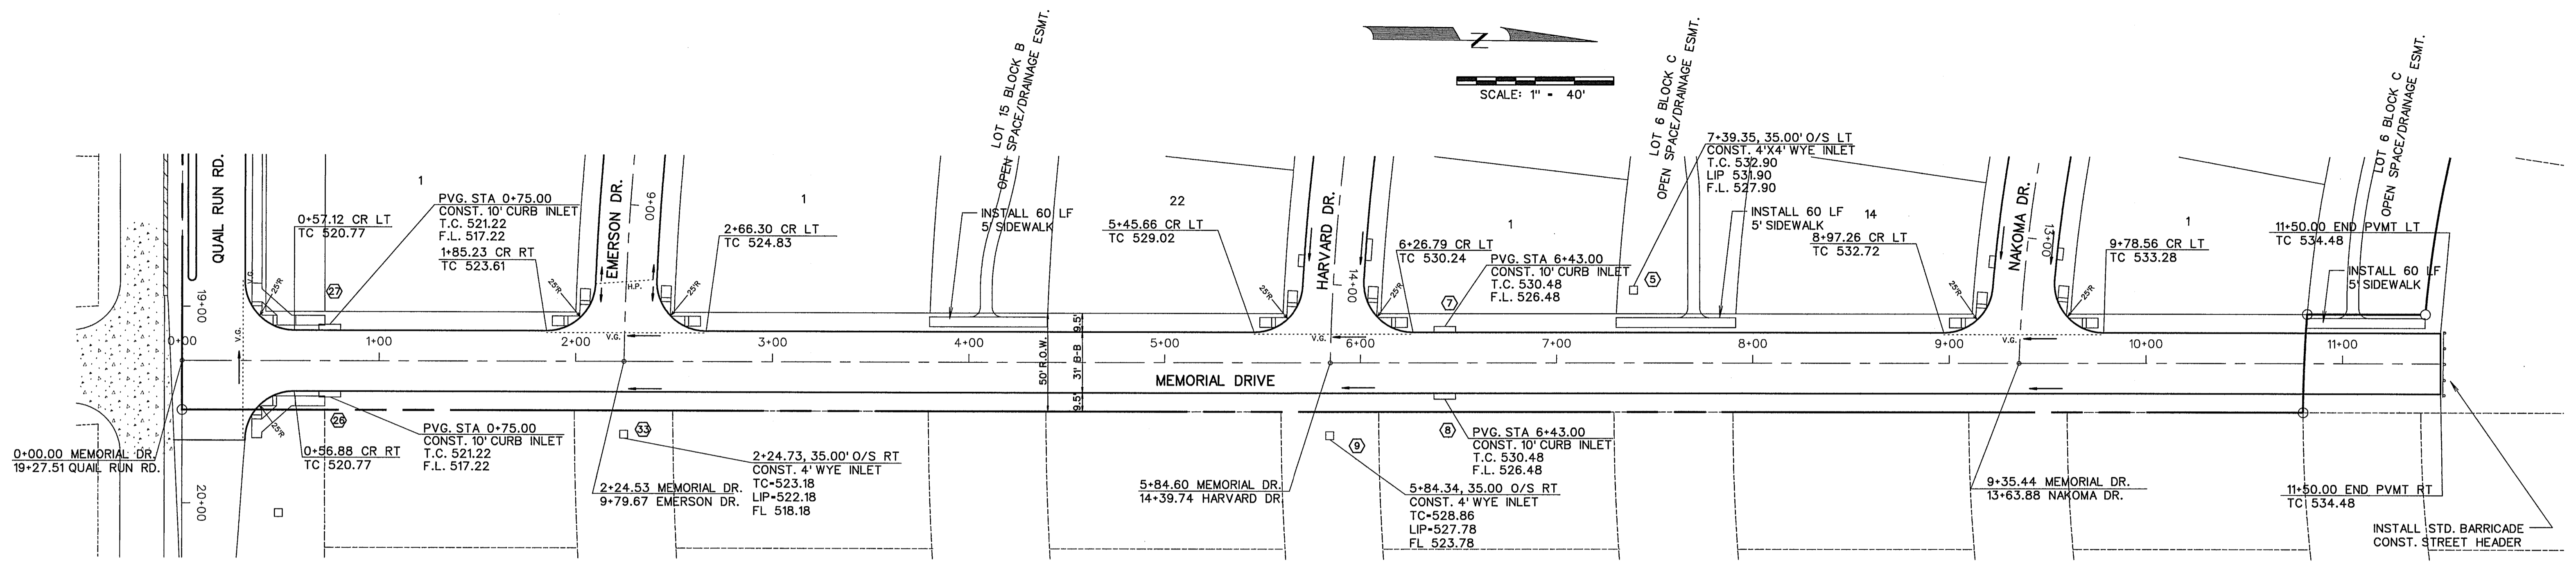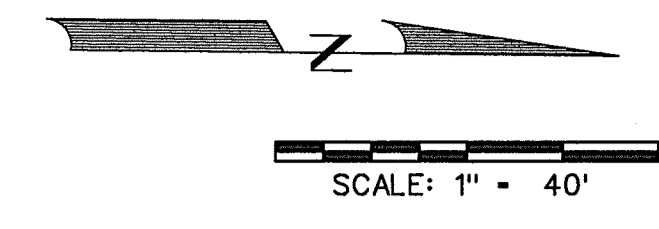



NOTE:
INSTALL BARRIER FREE RAMPS
TXDOT PED 12-A TYPE 7
(SEE SHEET *10)

BENCHMARK:
CITY OF ROCKWALL SURVEY MONUMENT ON AN INLET
AT THE NORTHWEST CORNER OF FEATHERSTONE DR. AND
HARVARD DR.
ELEV. = 525.31

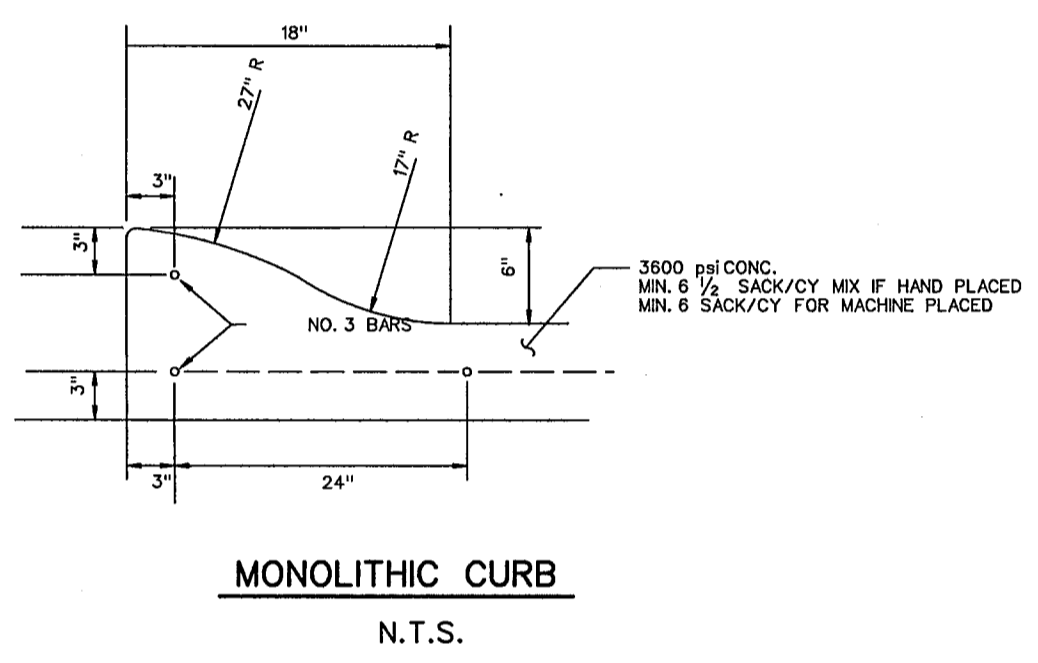

TYPICAL PAVEMENT SECTION - LAYDOWN CURB

MONOLITHIC CURB
N.T.S.

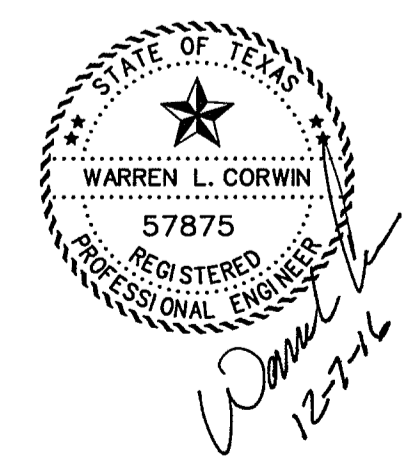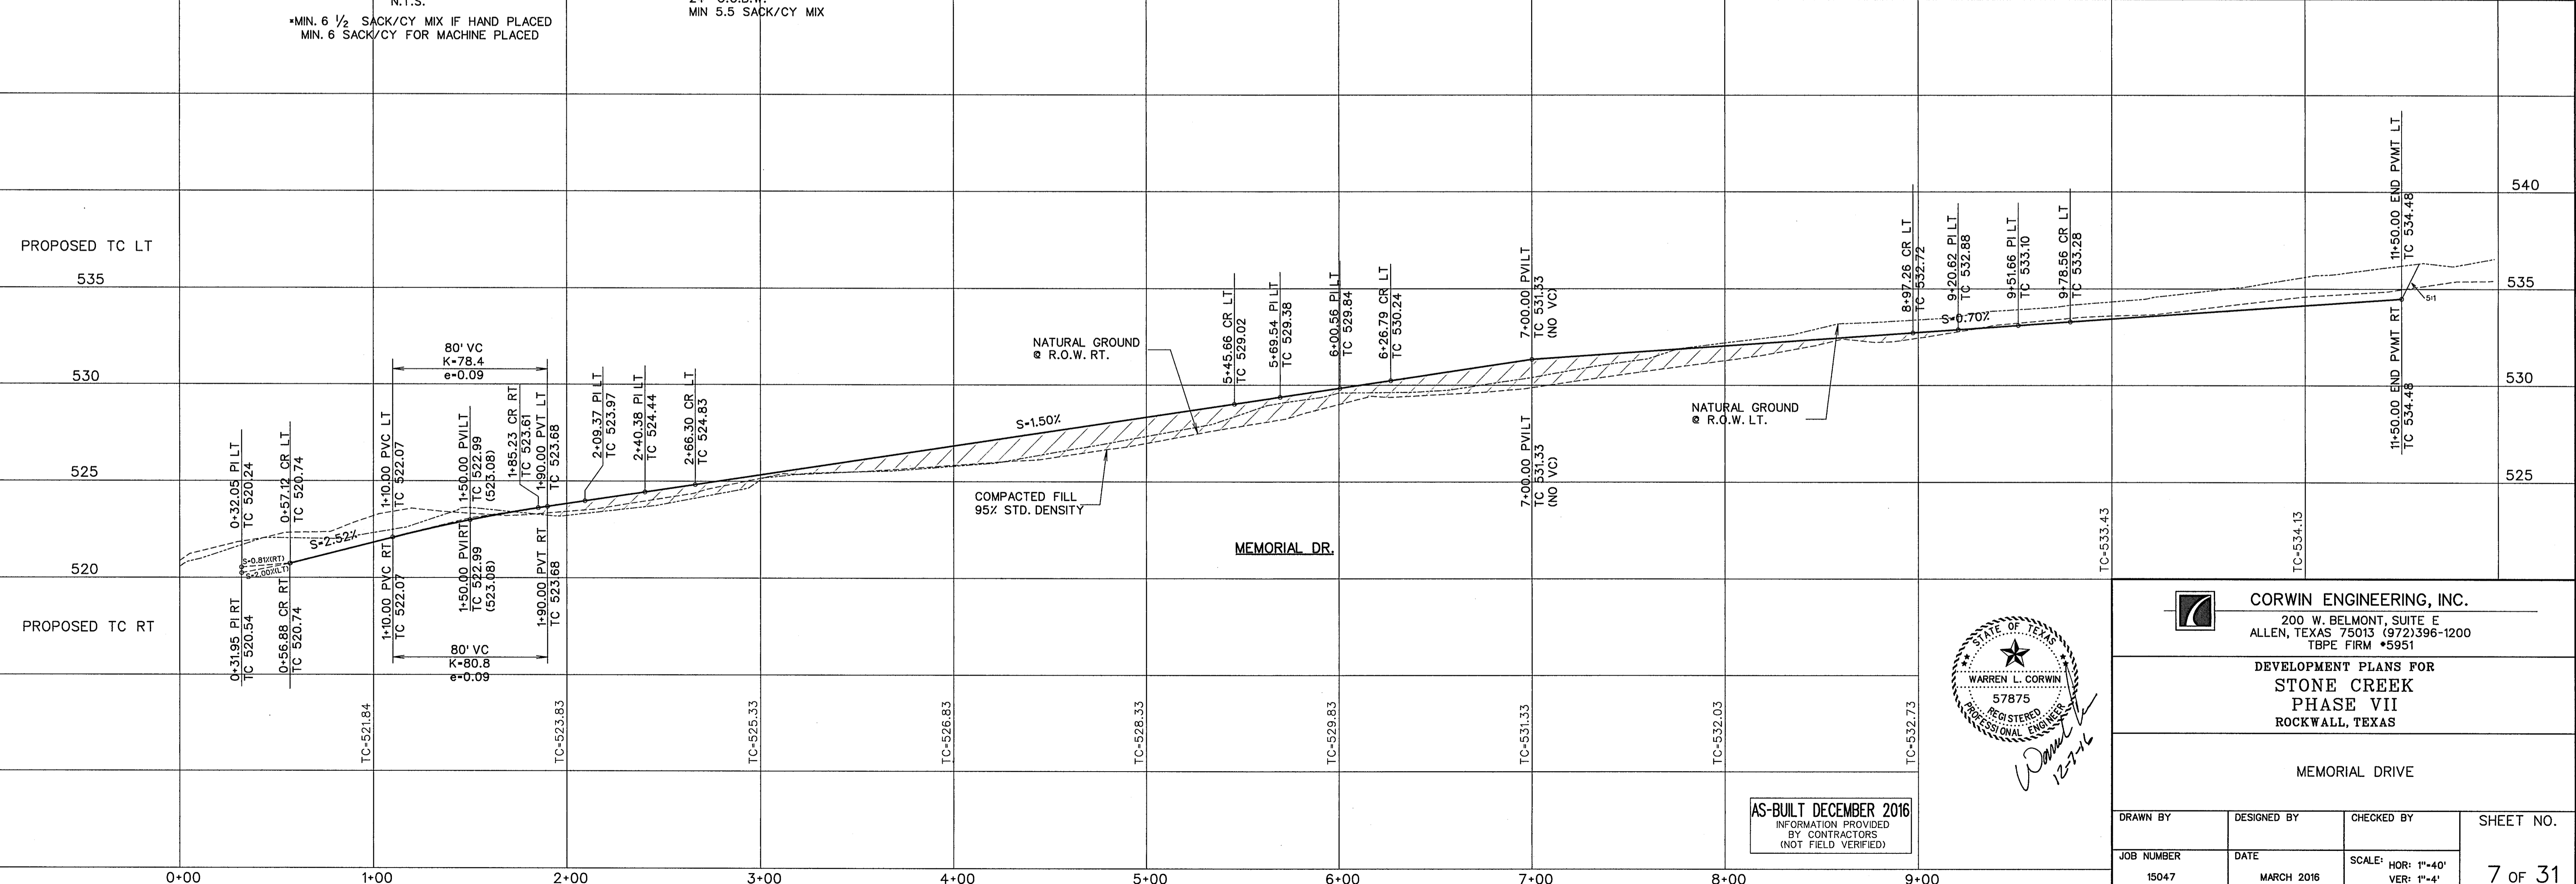

CORWIN ENGINEERING, INC.
200 W. BELMONT, SUITE E
ALLEN, TEXAS 75013 (972) 396-1200
TBPE FIRM #5951







DEVELOPMENT PLANS FOR
**STONE CREEK
PHASE VII**
ROCKWALL, TEXAS

MEMORIAL DRIVE

AS-BUILT DECEMBER 2016
INFORMATION PROVIDED
BY CONTRACTORS
(NOT FIELD VERIFIED)

DRAWN BY	DESIGNED BY	CHECKED BY	SHEET NO.
JOB NUMBER	DATE	SCALE: HOR: 1"=40' VER: 1"=4'	7 OF 31
15047	MARCH 2016		

SCALE: 1" = 40'

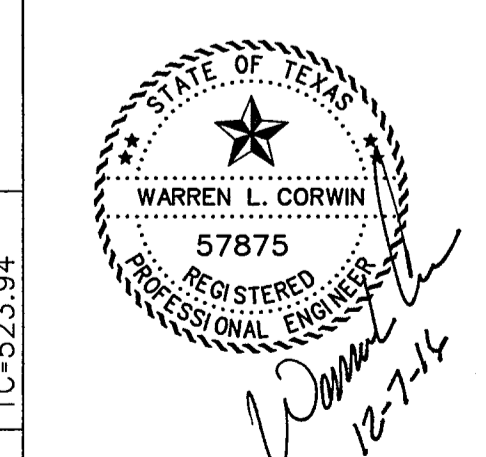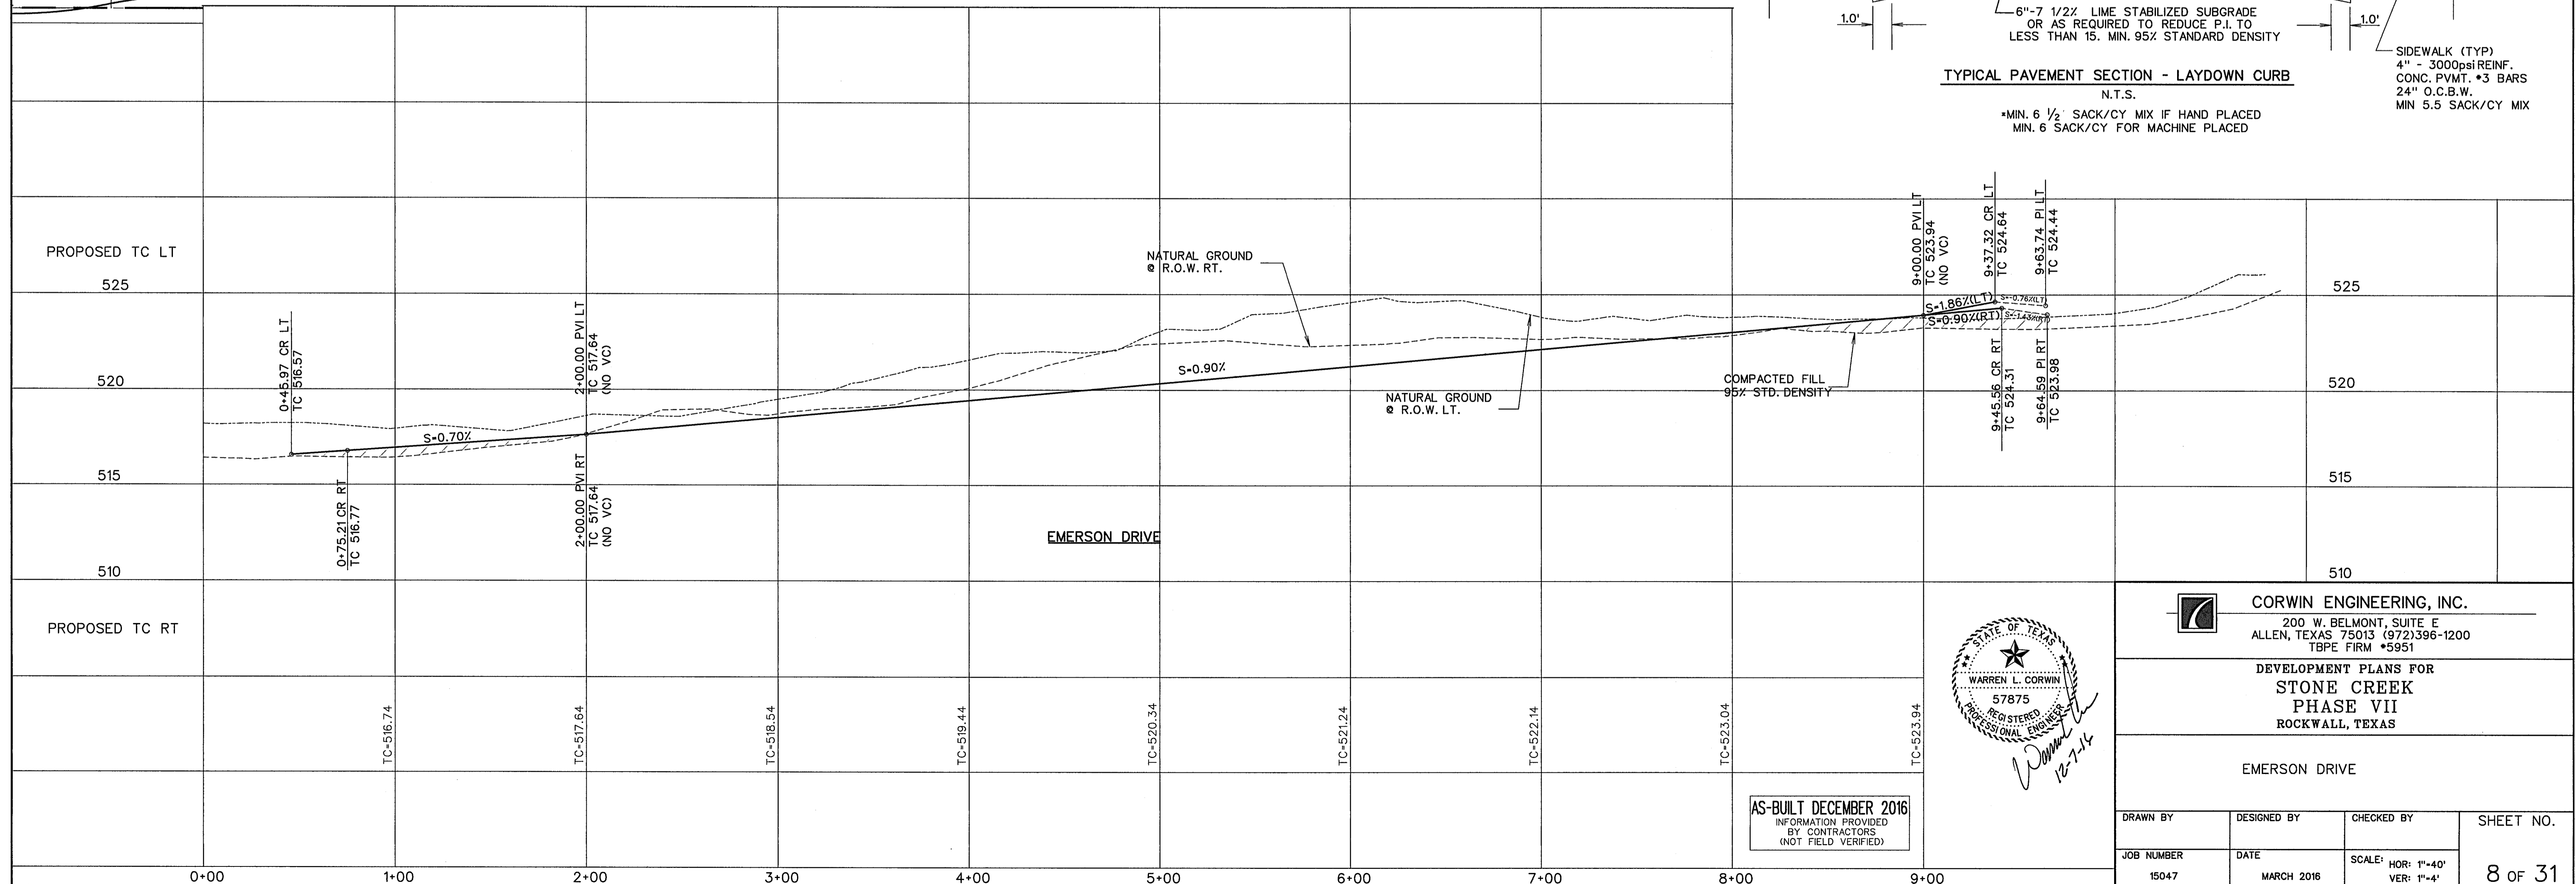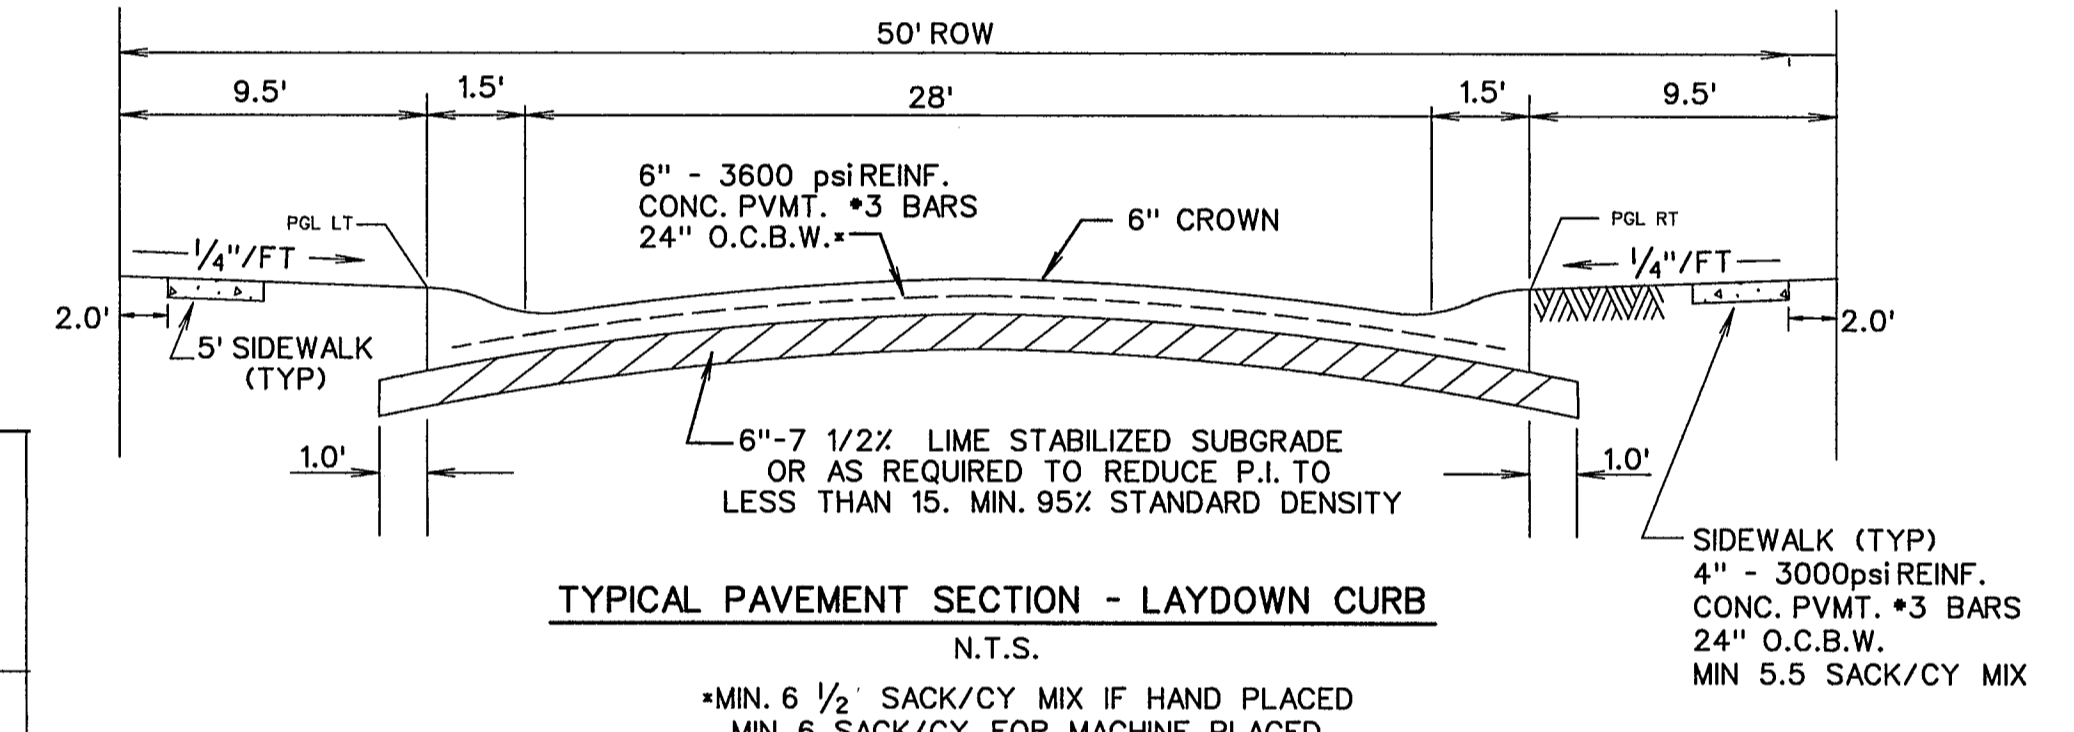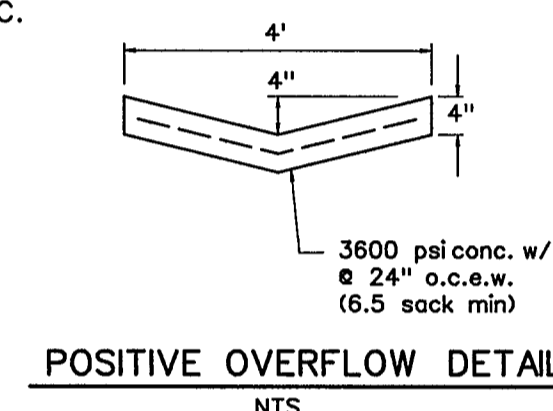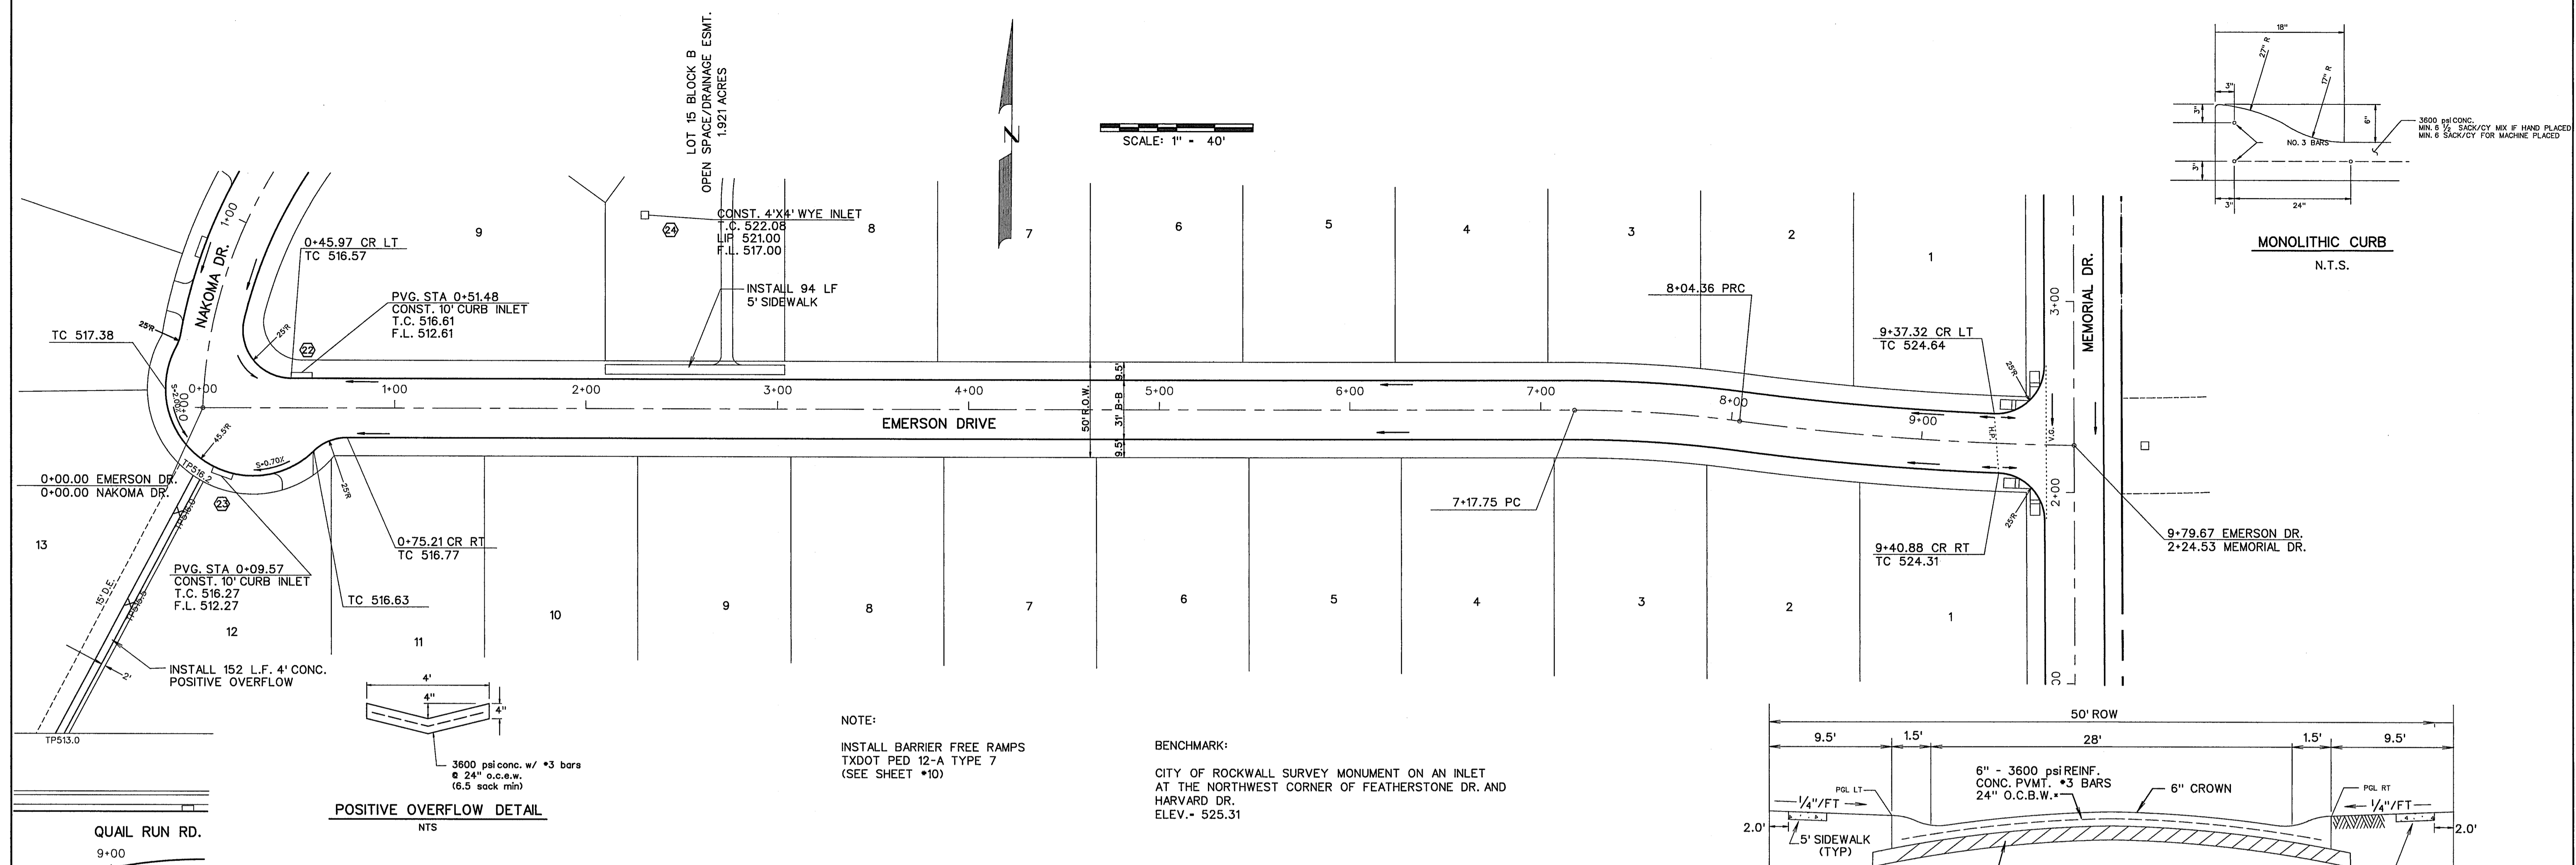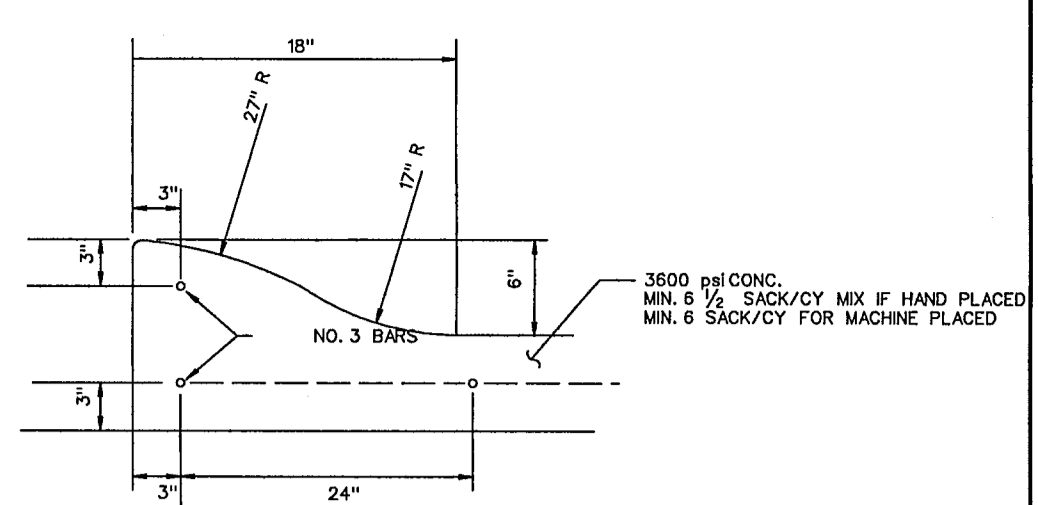



CORWIN ENGINEERING, INC.
 200 W. BELMONT, SUITE E
 ALLEN, TEXAS 75013 (972)396-1200
 TBPE FIRM #5951

DEVELOPMENT PLANS FOR
**STONE CREEK
 PHASE VII**
 ROCKWALL, TEXAS

EMERSON DRIVE



DRAWN BY	DESIGNED BY	CHECKED BY	SHEET NO.
JOB NUMBER	DATE	SCALE: HOR: 1"=40' VER: 1"=4'	8 OF 31

AS-BUILT DECEMBER 2016
 INFORMATION PROVIDED BY CONTRACTORS (NOT FIELD VERIFIED)

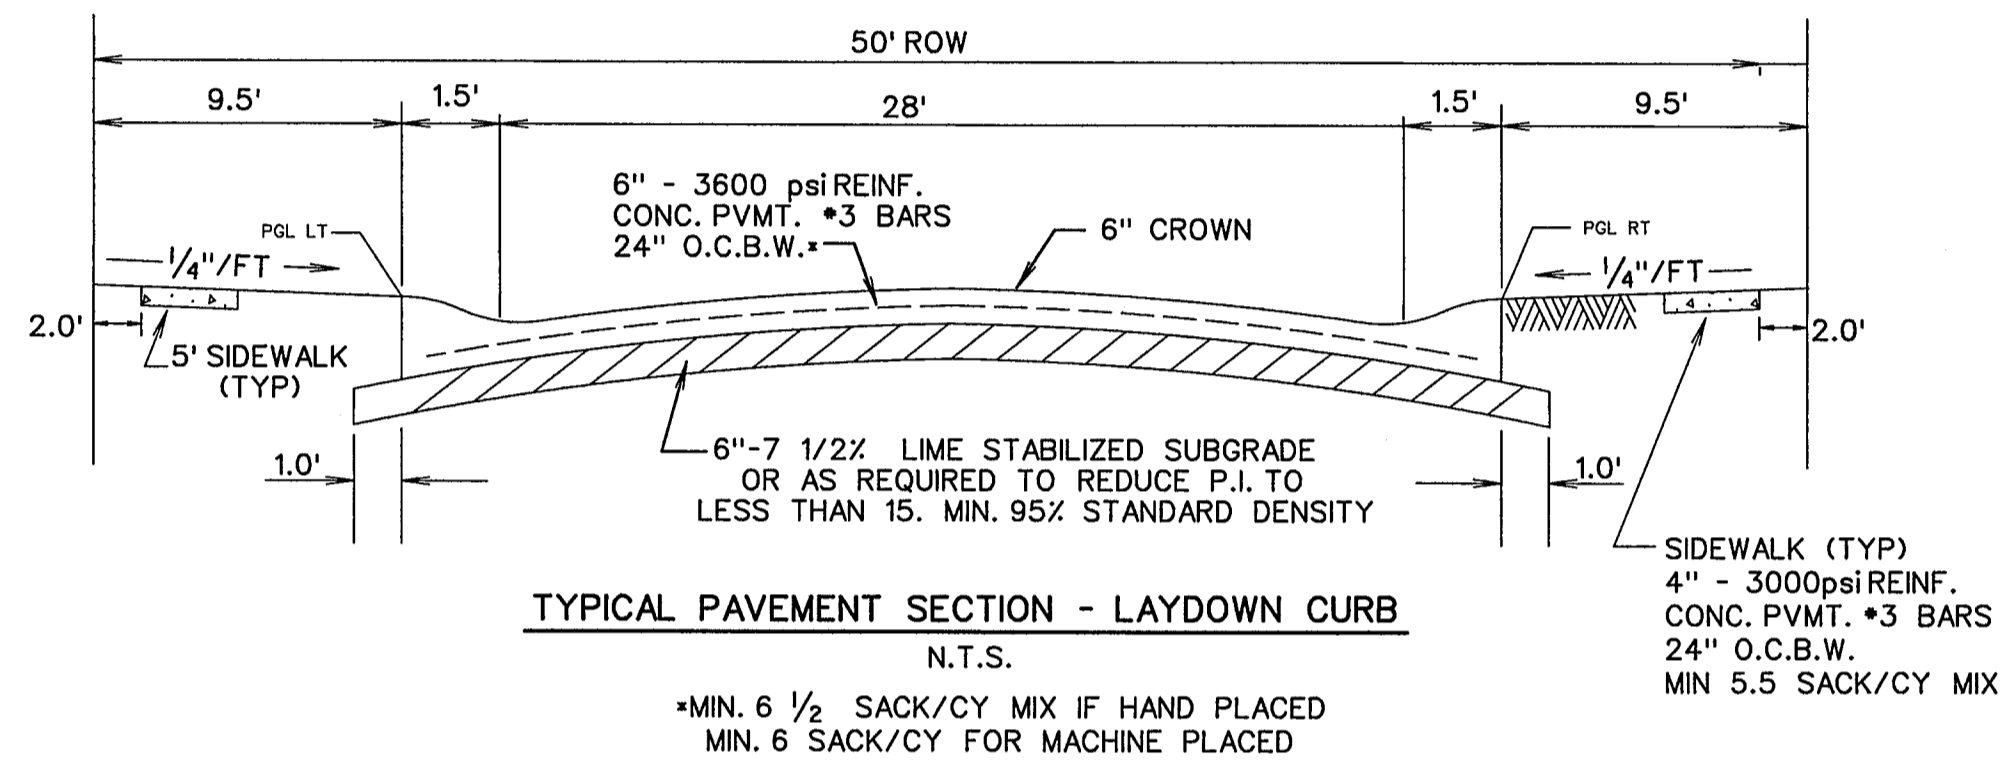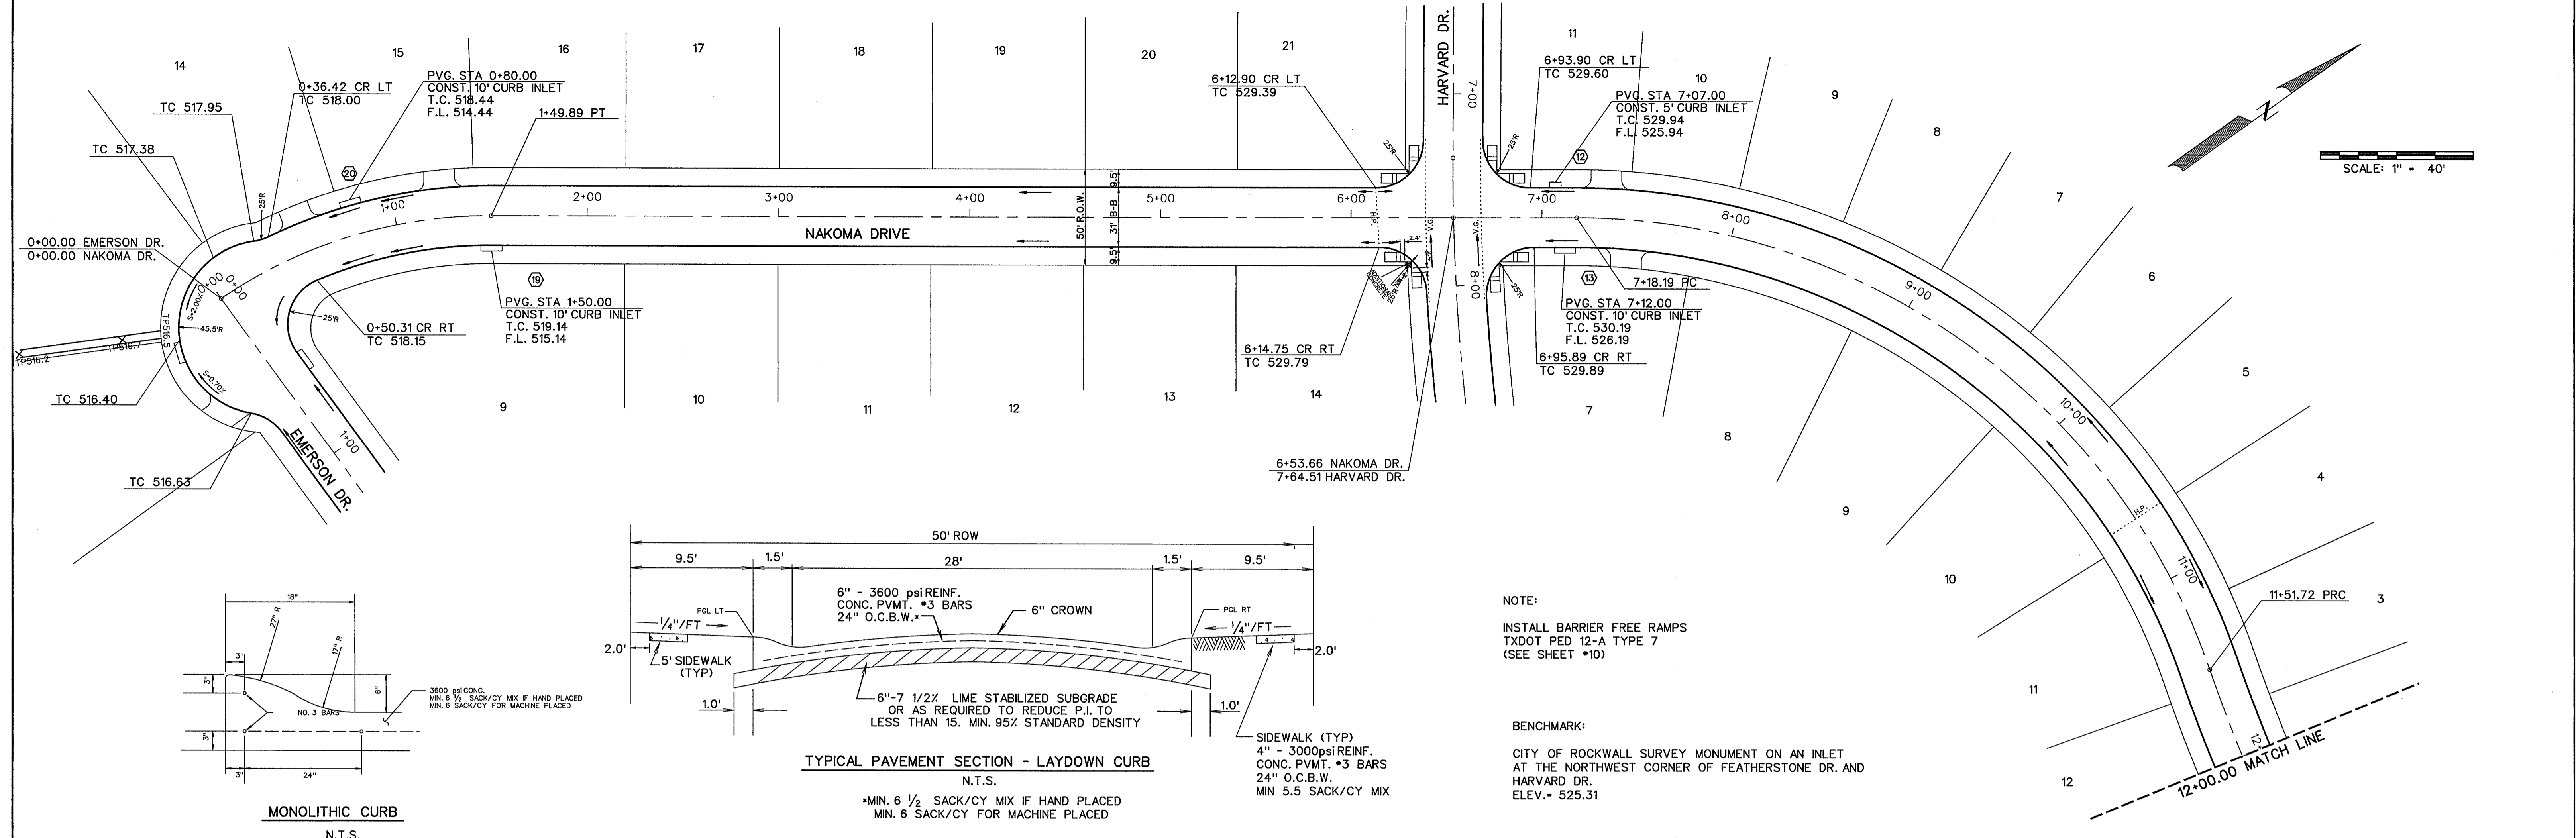


NOTE:
INSTALL BARRIER FREE RAMPS
TXDOT PED 12-A TYPE 7
(SEE SHEET *10)

BENCHMARK:
CITY OF ROCKWALL SURVEY MONUMENT ON AN INLET
AT THE NORTHWEST CORNER OF FEATHERSTONE DR. AND
HARVARD DR.
ELEV. = 525.31

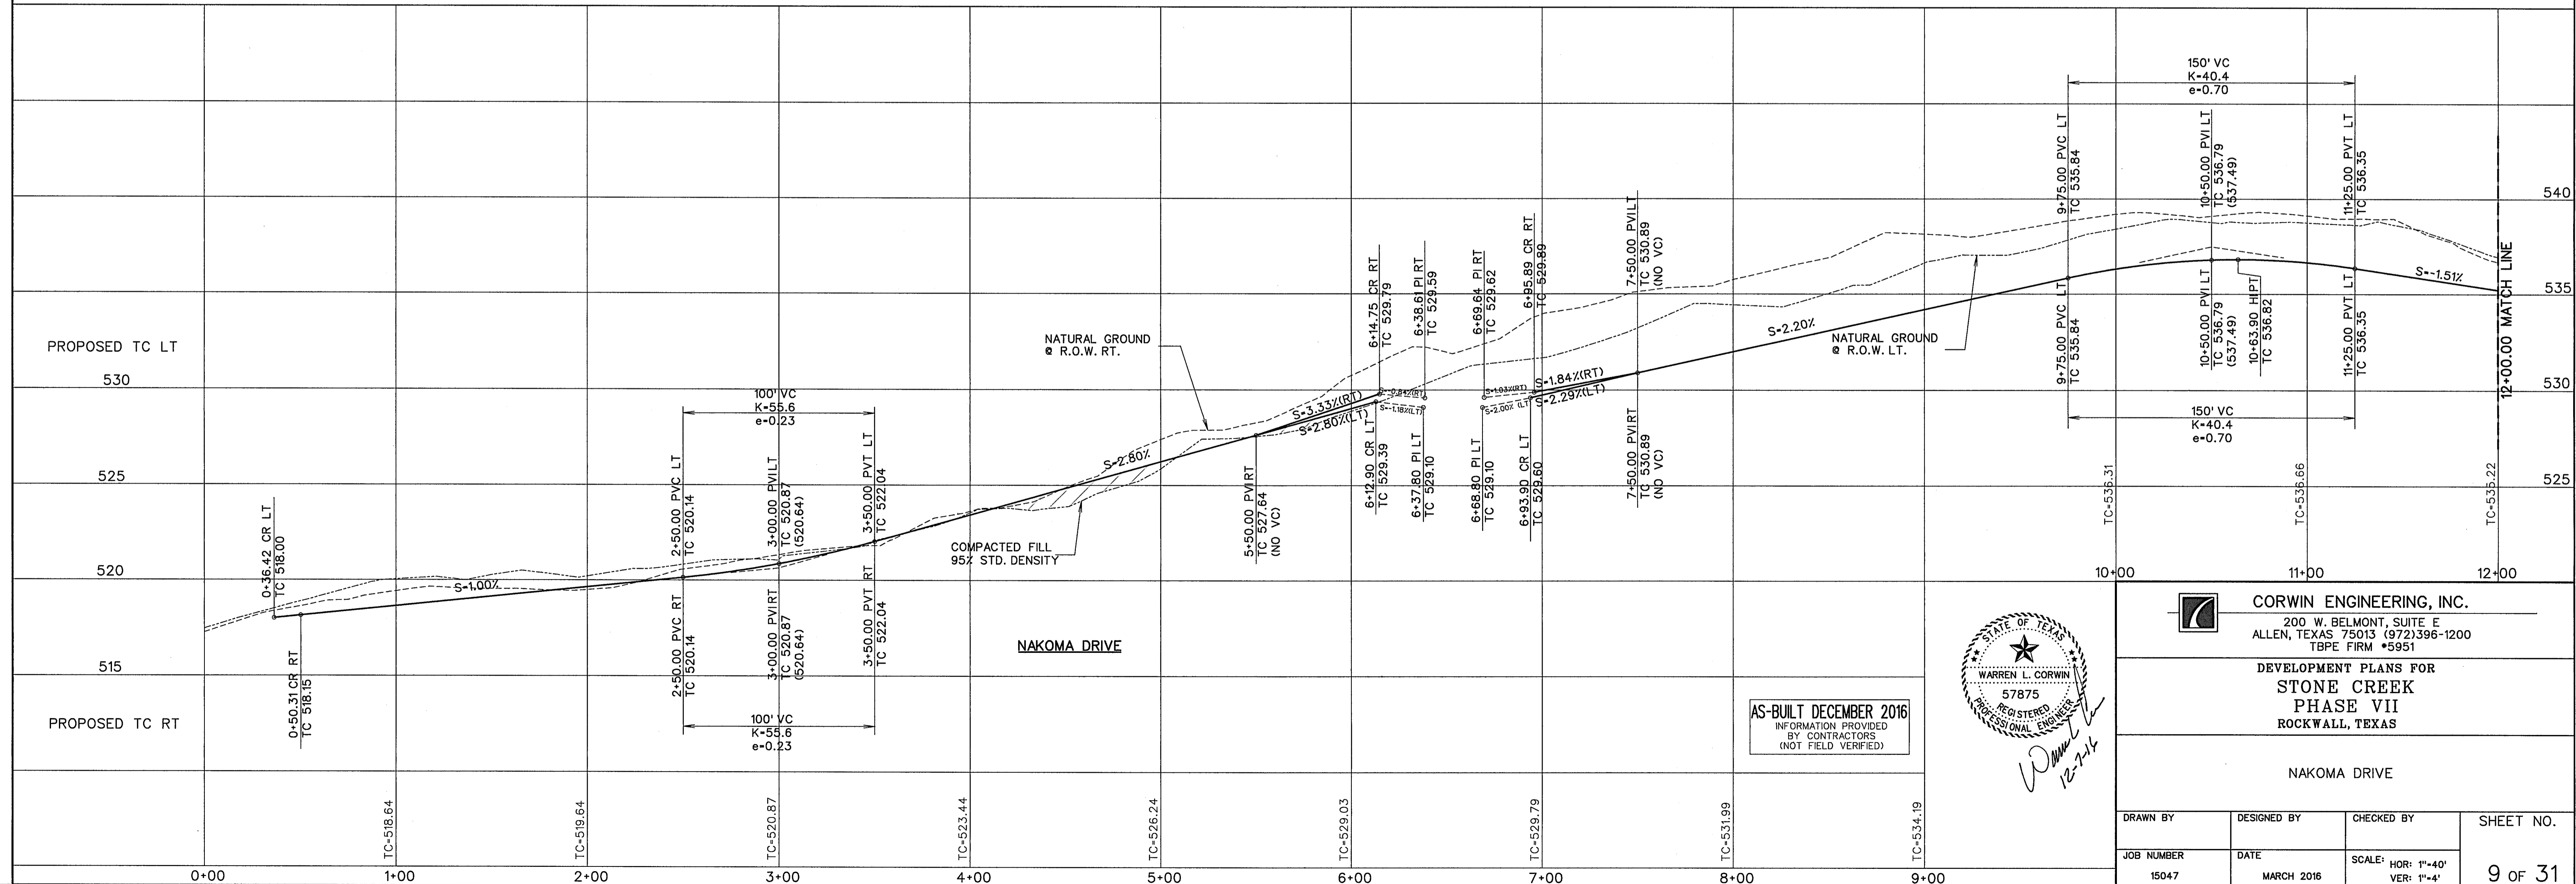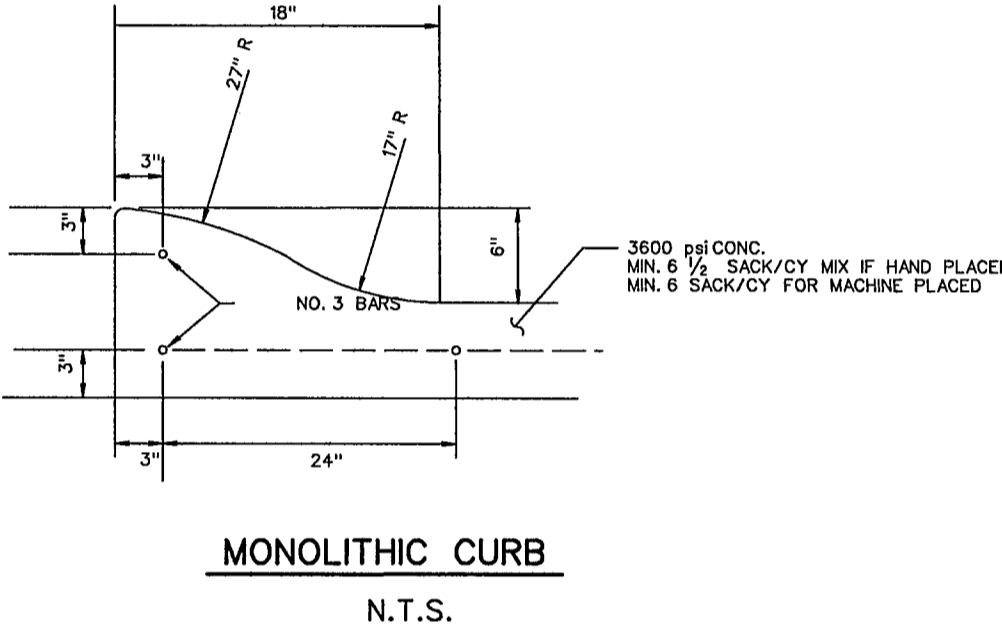

AS-BUILT DECEMBER 2016
INFORMATION PROVIDED
BY CONTRACTORS
(NOT FIELD VERIFIED)

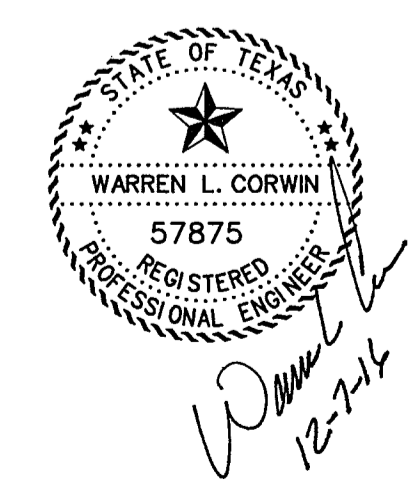



CORWIN ENGINEERING, INC.
200 W. BELMONT, SUITE E
ALLEN, TEXAS 75013 (972)396-1200
TBPE FIRM #5951

DEVELOPMENT PLANS FOR
STONE CREEK
PHASE VII
ROCKWALL, TEXAS

NAKOMA DRIVE


DRAWN BY	DESIGNED BY	CHECKED BY	SHEET NO. 9 of 31
JOB NUMBER 15047	DATE MARCH 2016	SCALE: HOR: 1"=40' VER: 1"=4'	

SCALE: 1" = 40'

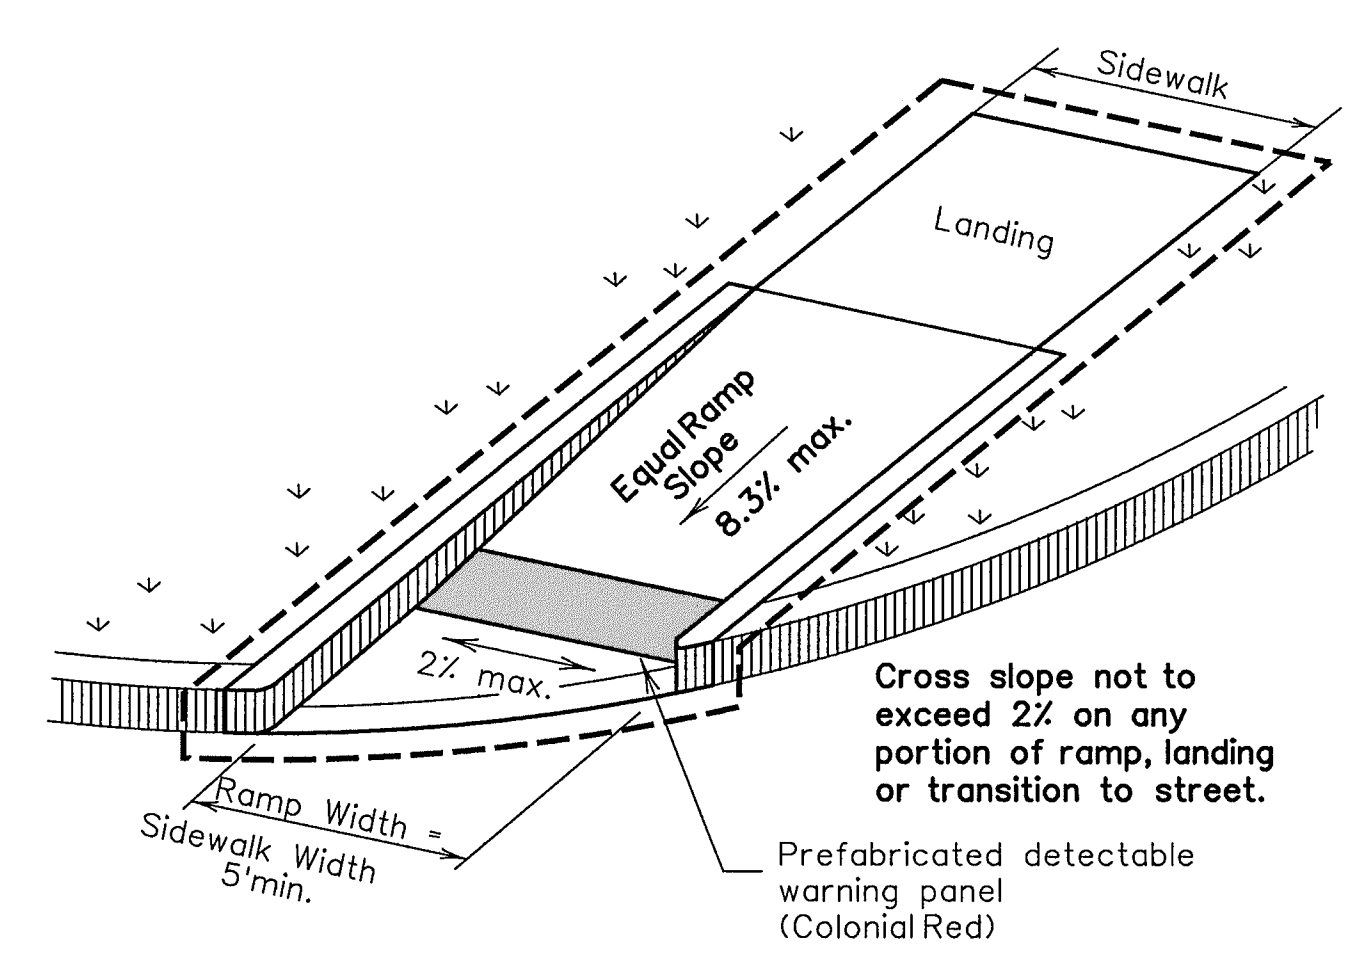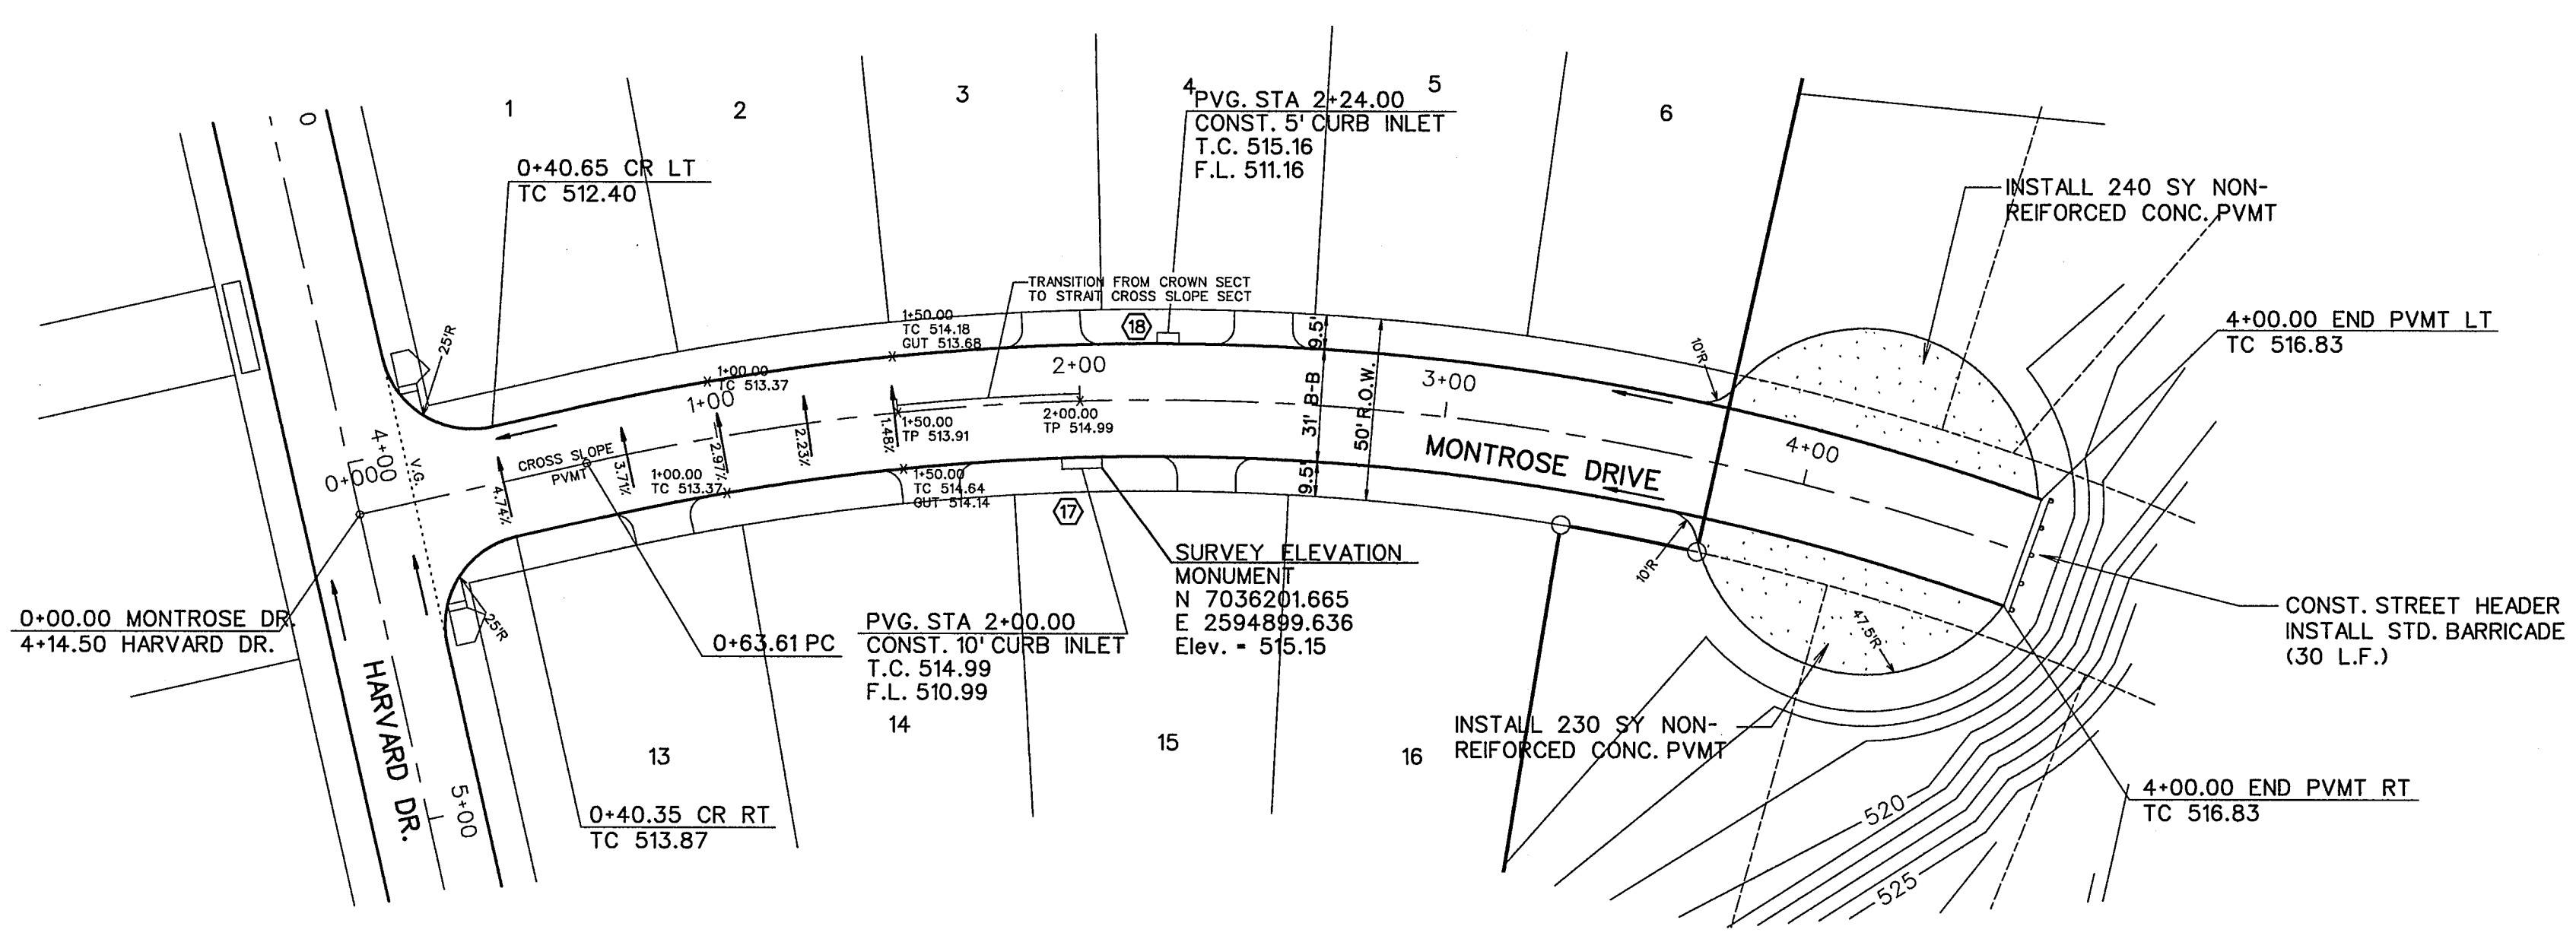




(Sidewalk set back from curb)

BARRIER FREE RAMPS
TXDOT PED 12-A TYPE 7

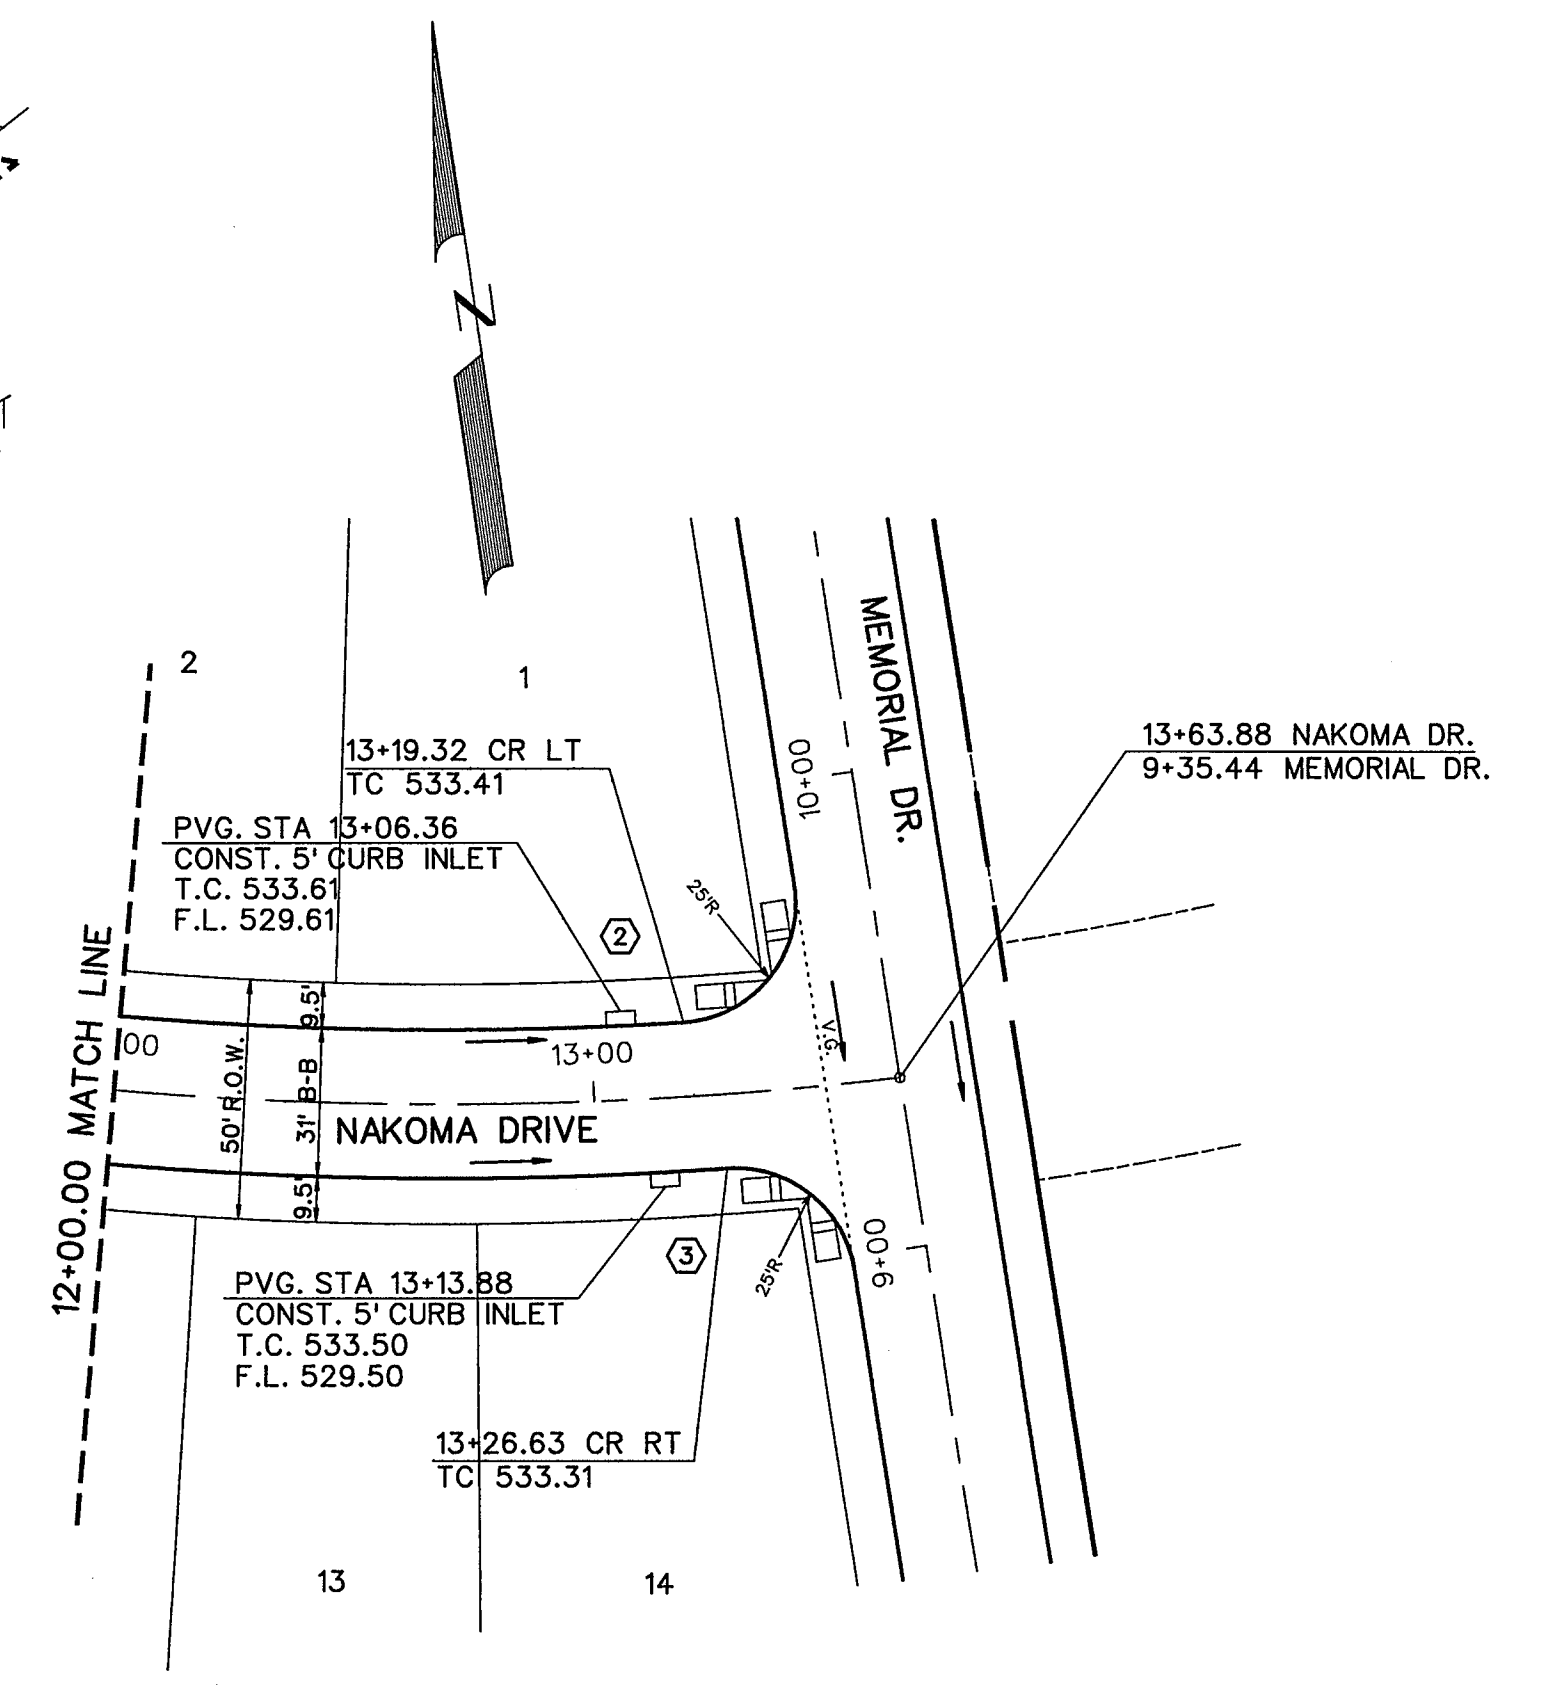

BENCHMARK:
CITY OF ROCKWALL SURVEY MONUMENT ON AN INLET
AT THE NORTHWEST CORNER OF FEATHERSTONE DR. AND
HARVARD DR.
ELEV. = 525.31

NOTE:
INSTALL BARRIER FREE RAMPS
TXDOT PED 12-A TYPE 7
(SEE SHEET *10)

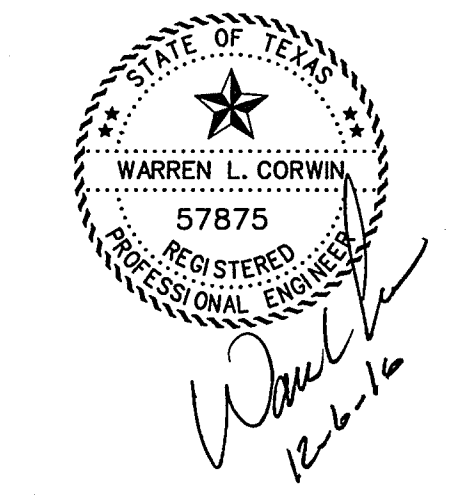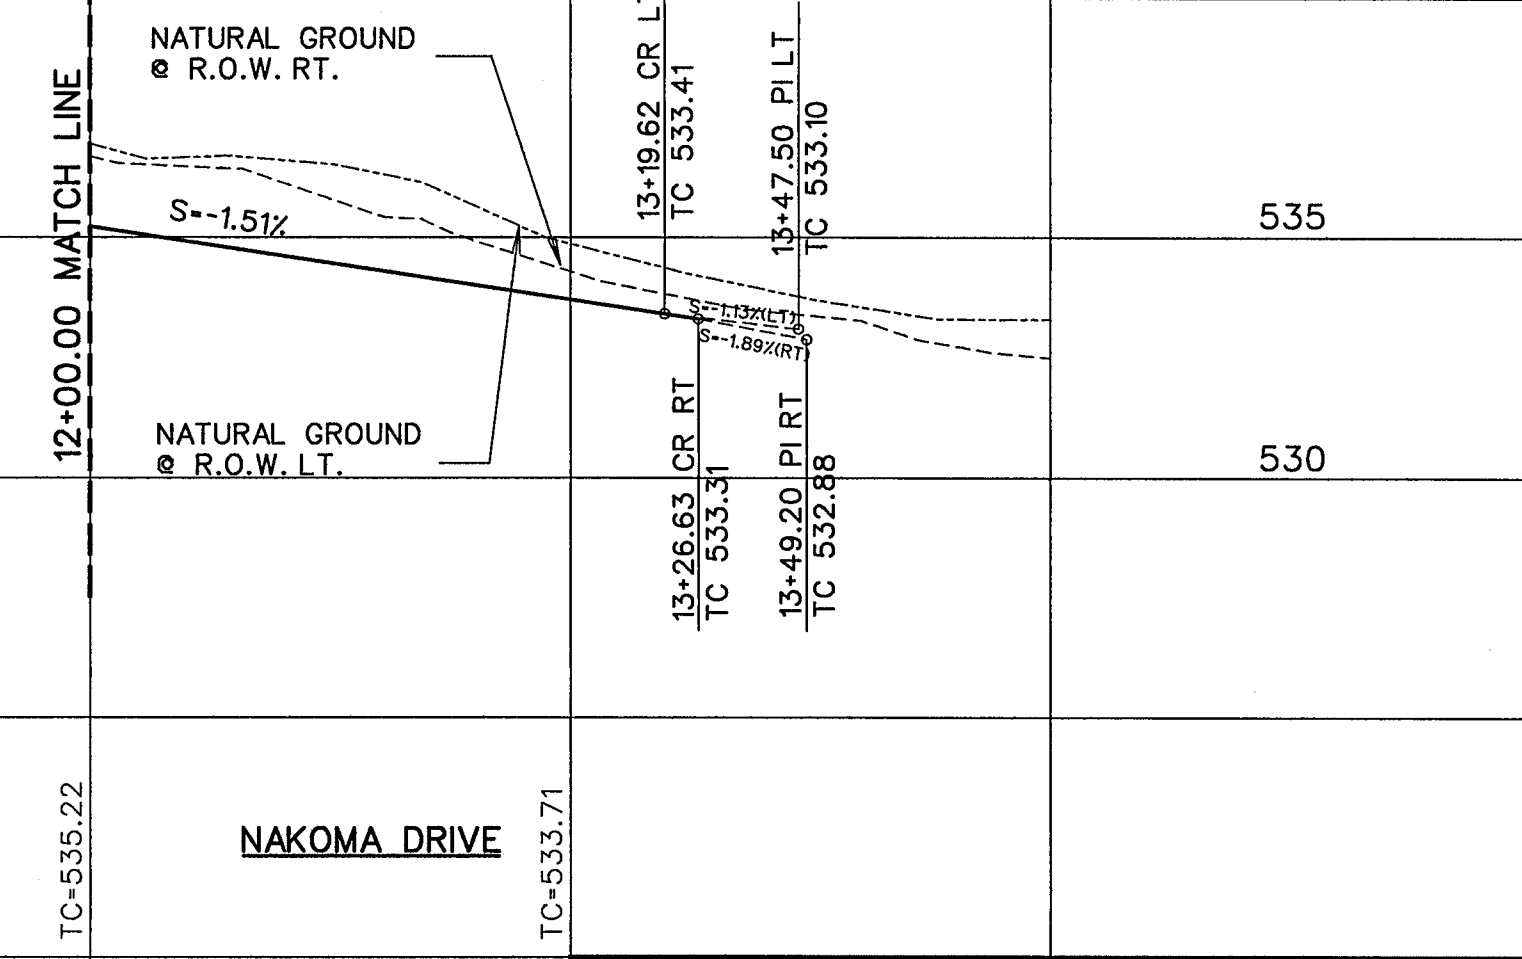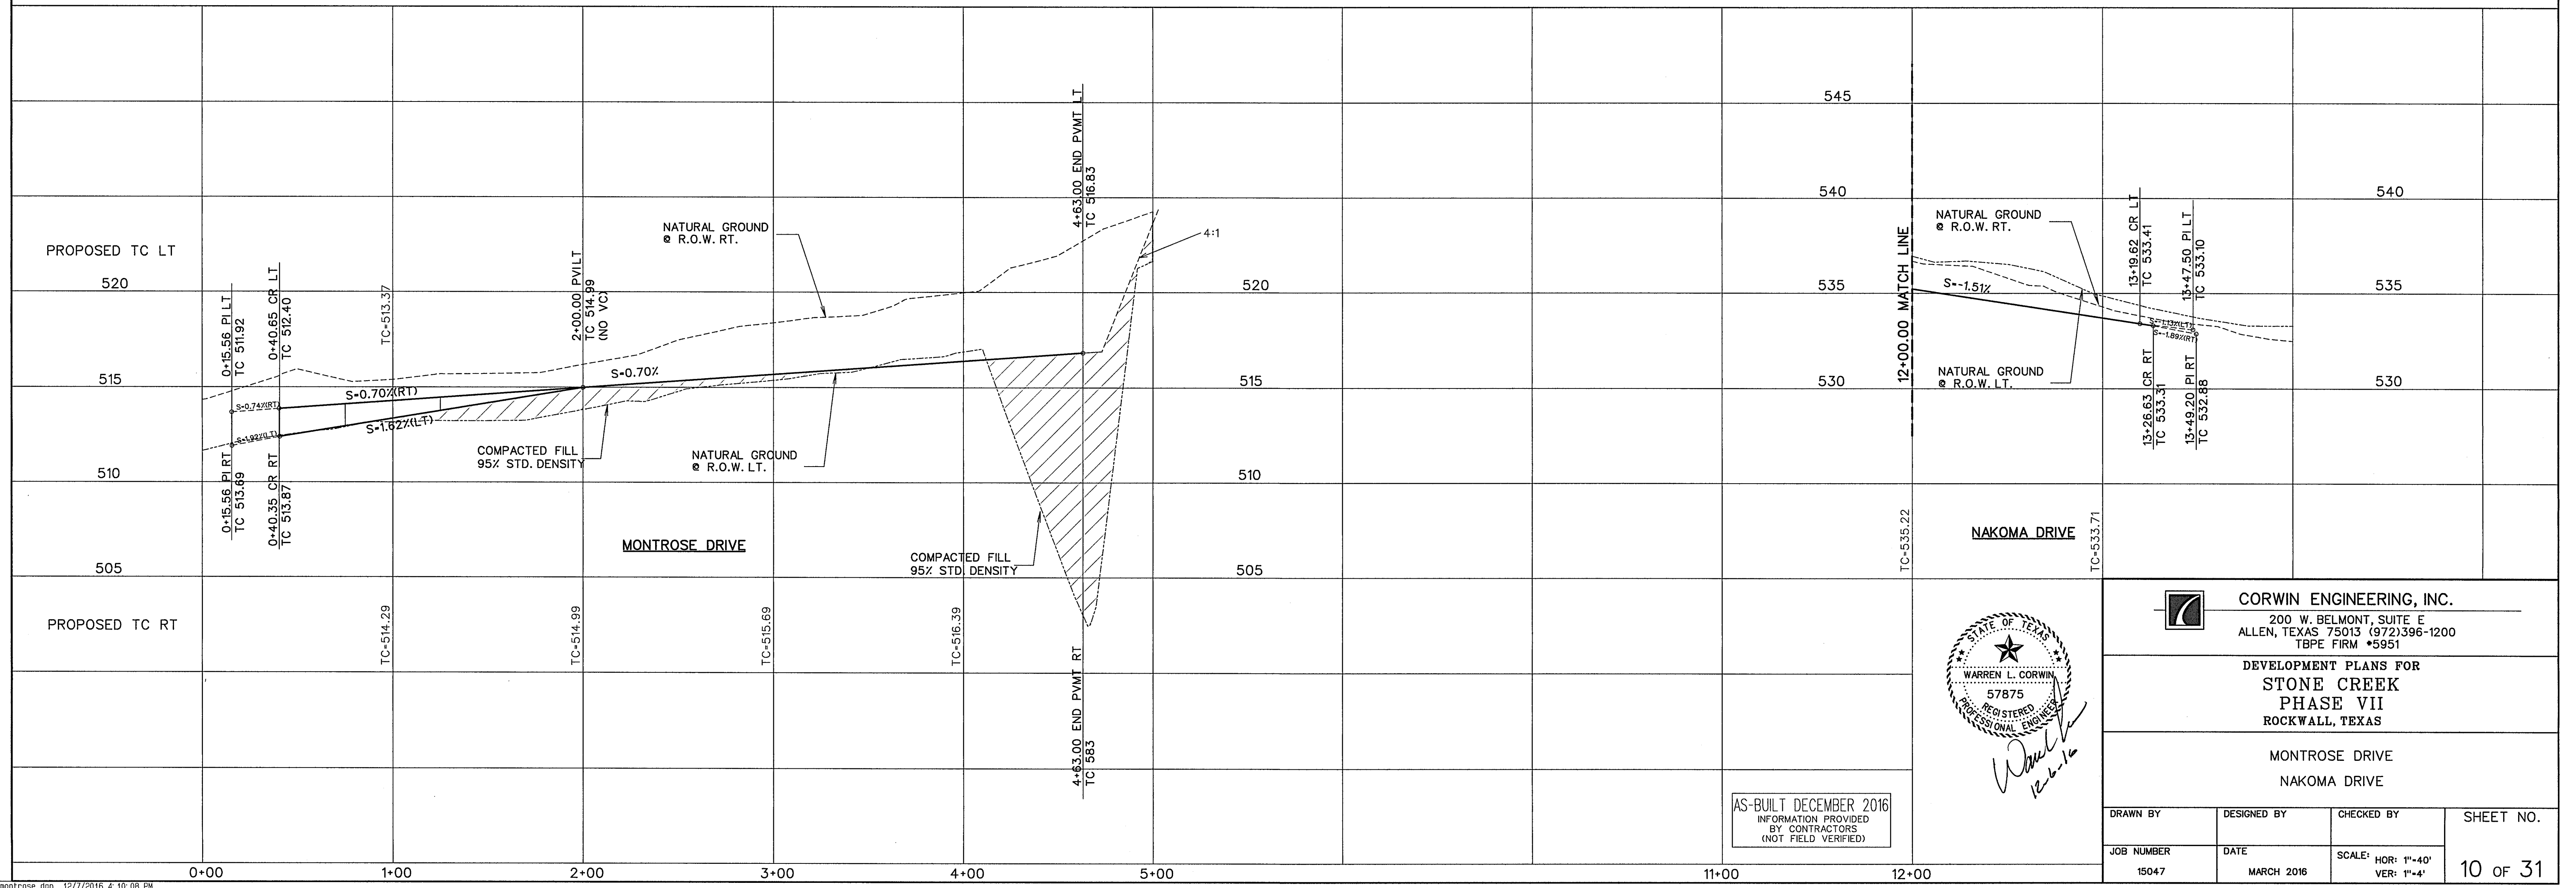



CORWIN ENGINEERING, INC.
200 W. BELMONT, SUITE E
ALLEN, TEXAS 75013 (972)396-1200
TBPE FIRM #5951

DEVELOPMENT PLANS FOR
STONE CREEK
PHASE VII
ROCKWALL, TEXAS





MONTROSE DRIVE
NAKOMA DRIVE

AS-BUILT DECEMBER 2016
INFORMATION PROVIDED
BY CONTRACTORS
(NOT FIELD VERIFIED)

DRAWN BY	DESIGNED BY	CHECKED BY	SHEET NO.
JOB NUMBER	DATE	SCALE: HOR: 1"=40' VER: 1"=4'	10 OF 31
15047	MARCH 2016		

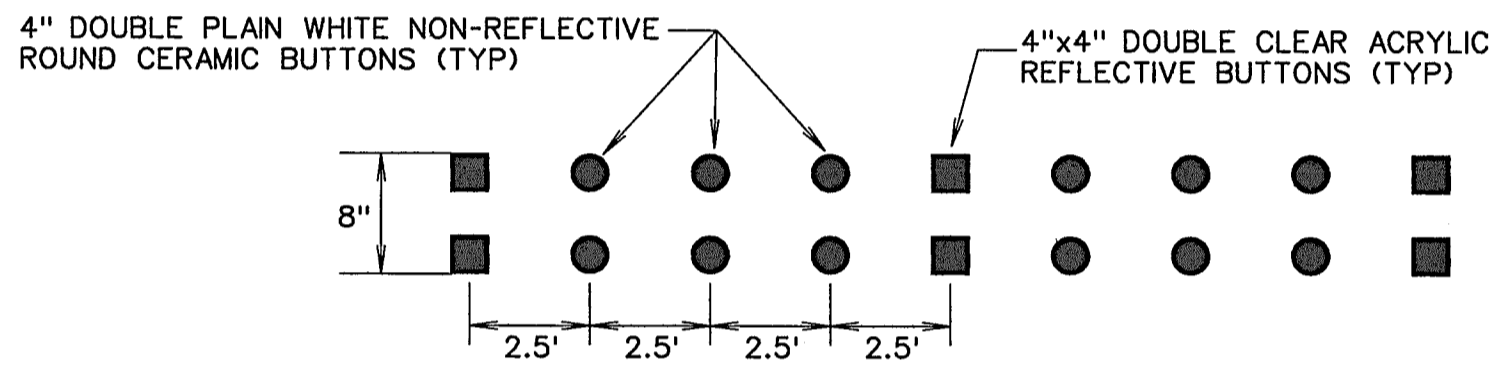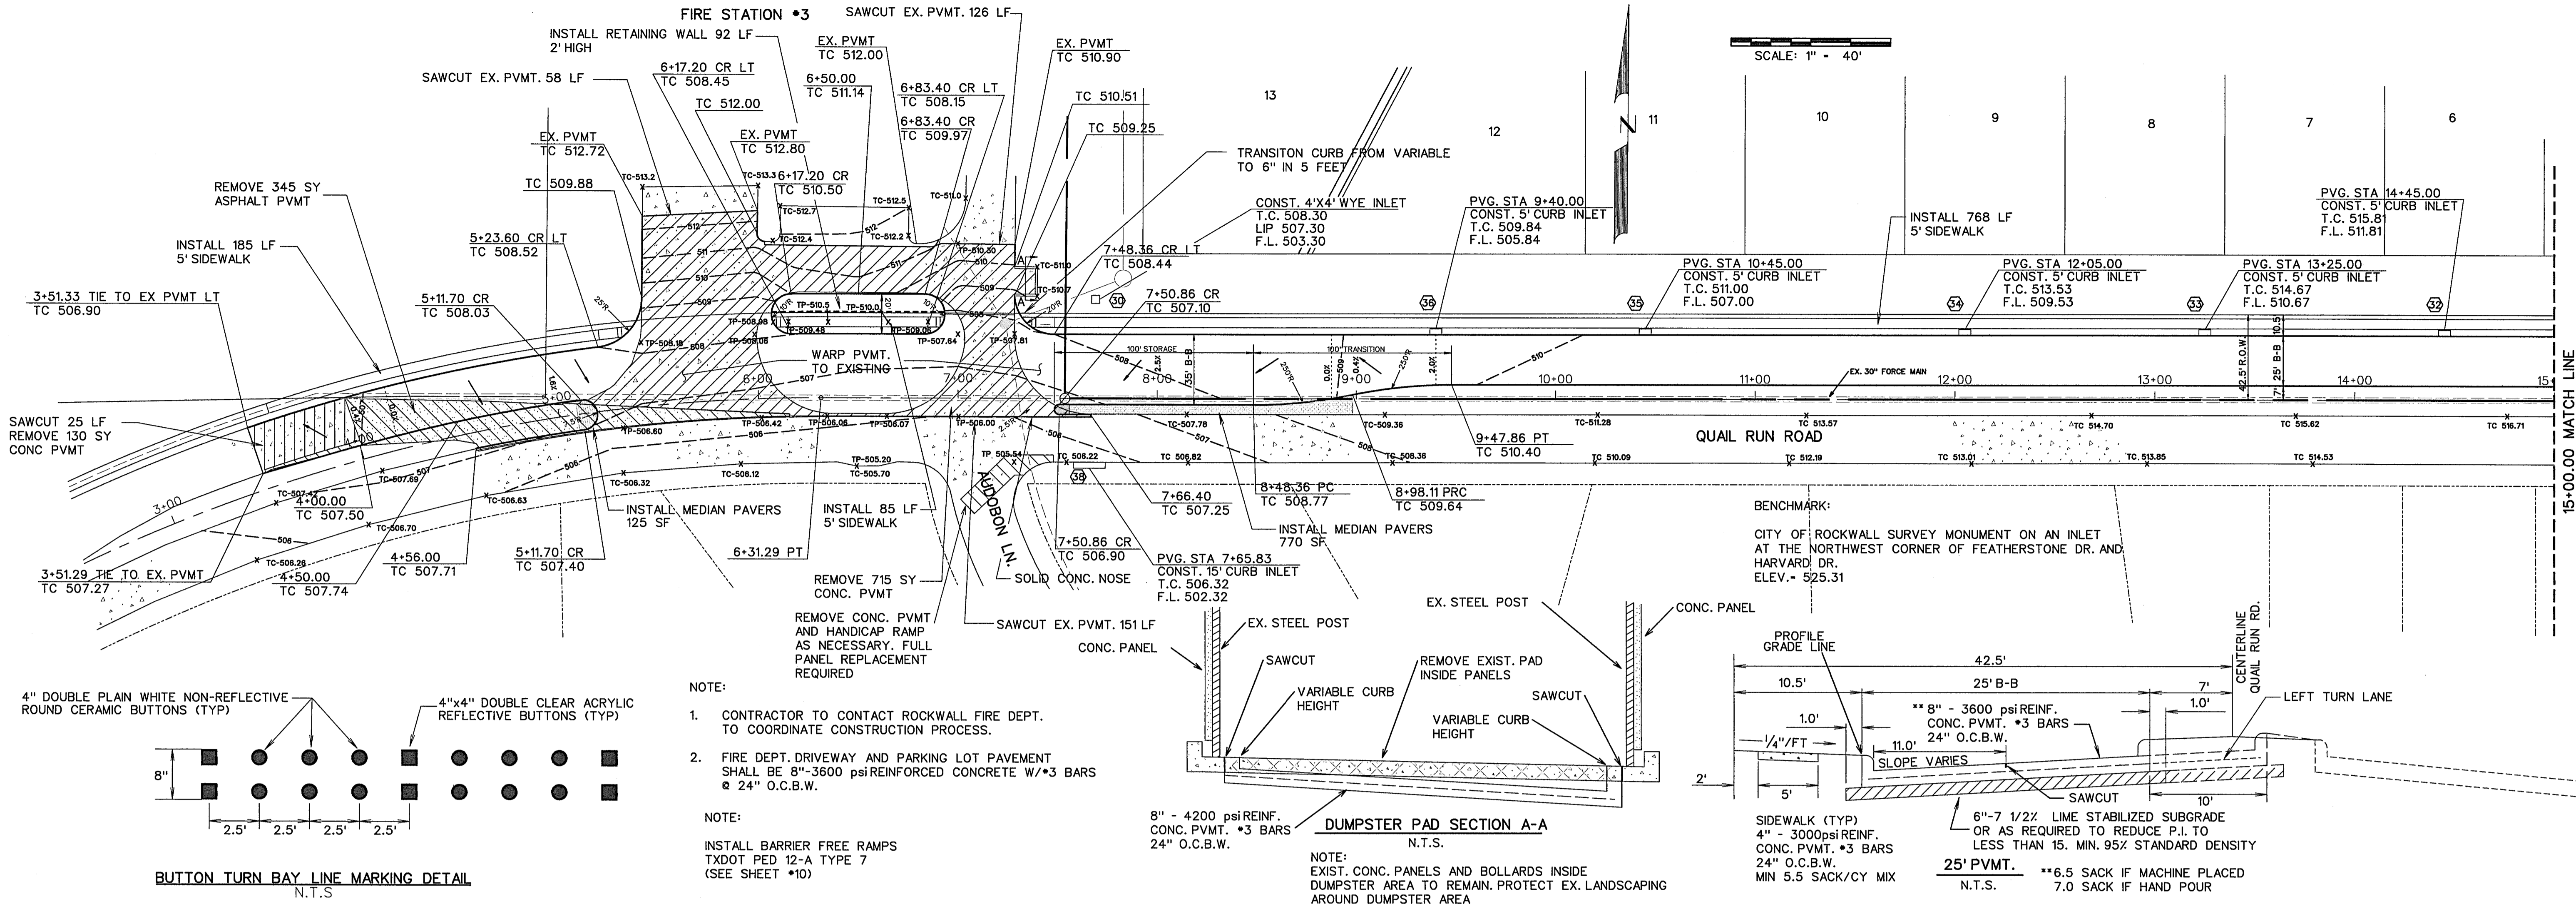

- NOTE:
- CONTRACTOR TO CONTACT ROCKWALL FIRE DEPT. TO COORDINATE CONSTRUCTION PROCESS.
 - FIRE DEPT. DRIVEWAY AND PARKING LOT PAVEMENT SHALL BE 8" - 3600 PSI REINFORCED CONCRETE W/ #3 BARS @ 24" O.C.B.W.
- NOTE:
- INSTALL BARRIER FREE RAMPS TXDOT PED 12-A TYPE 7 (SEE SHEET #10)

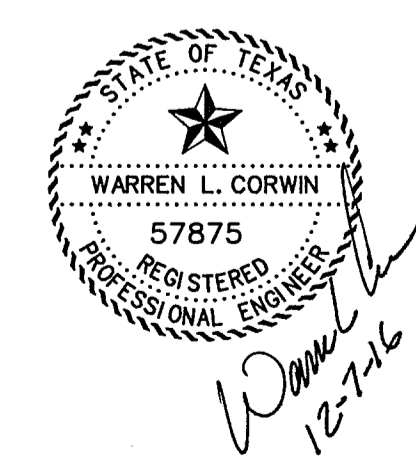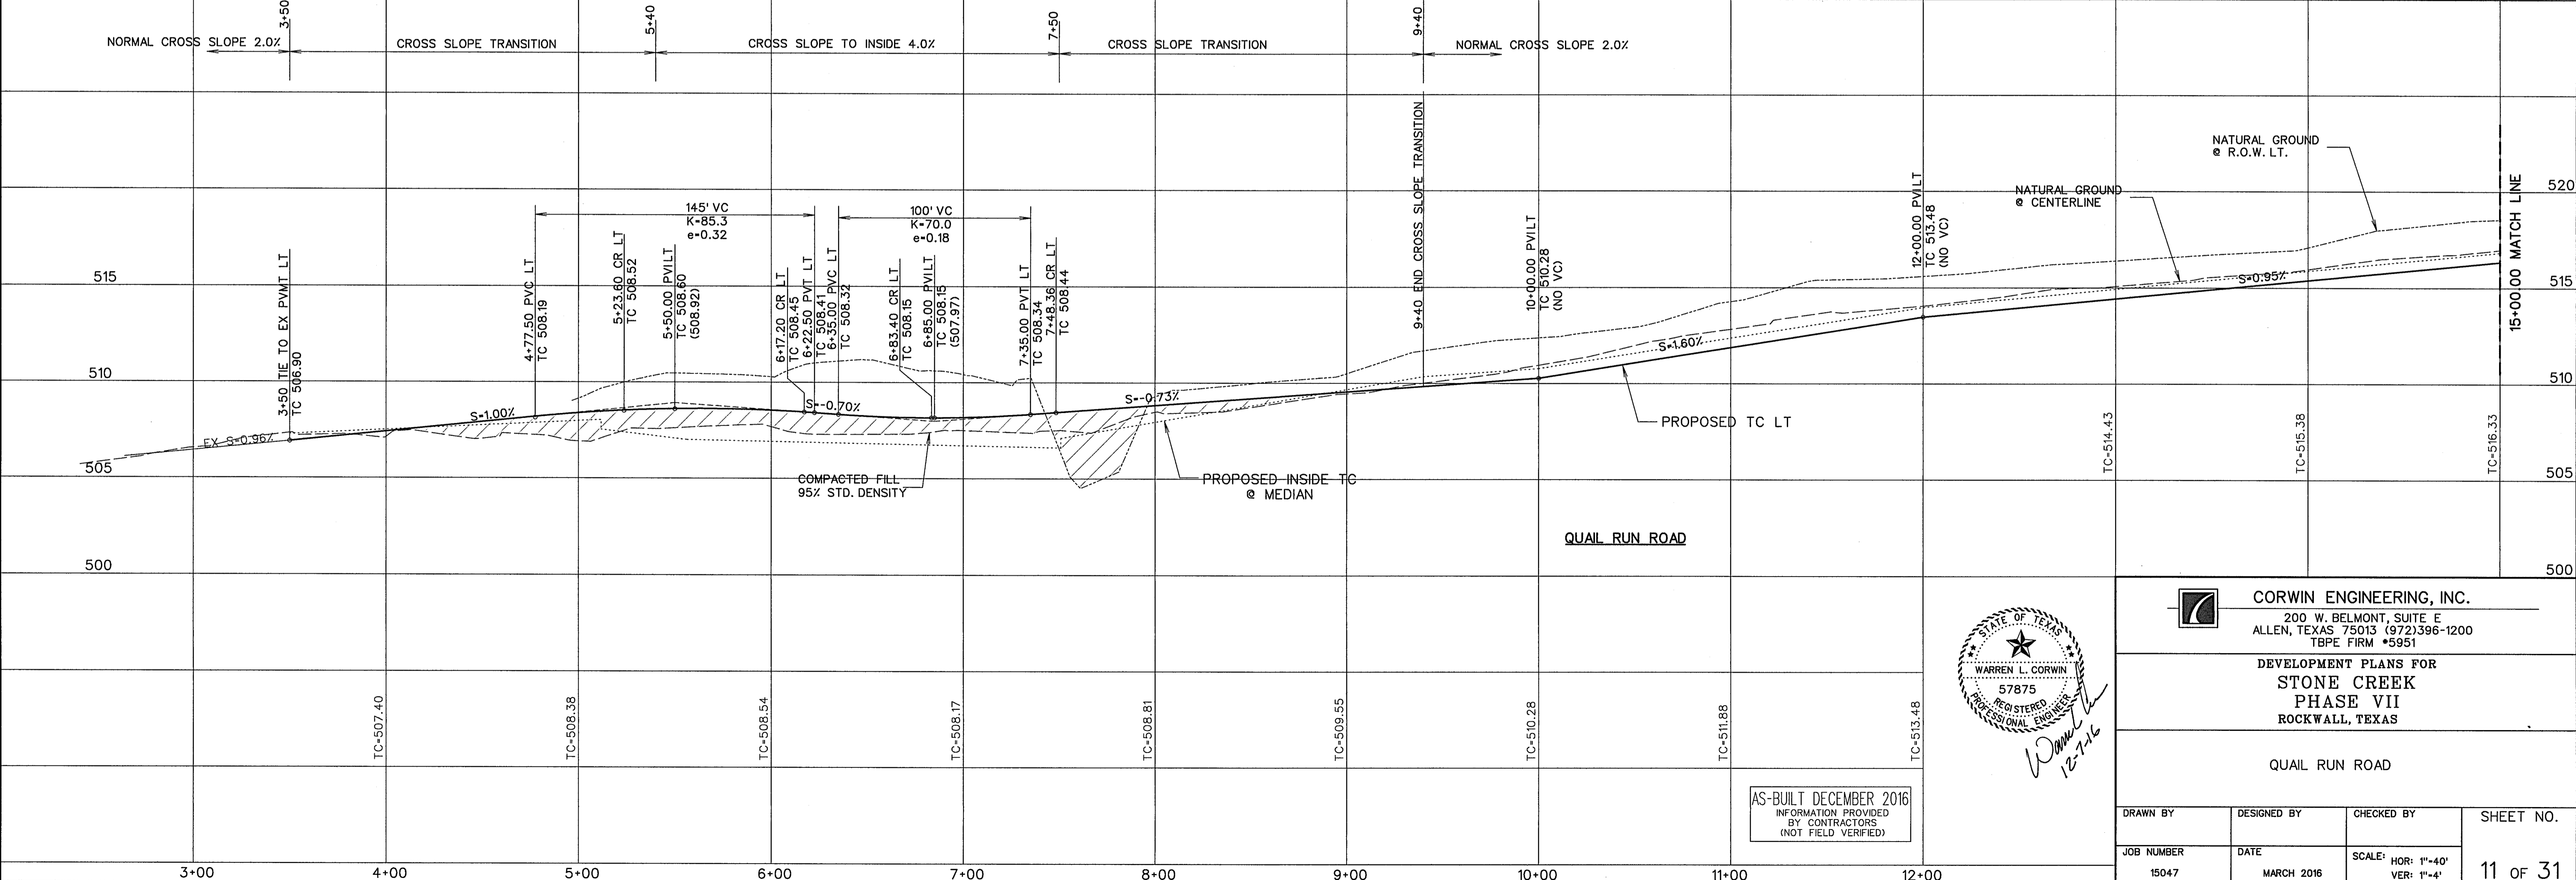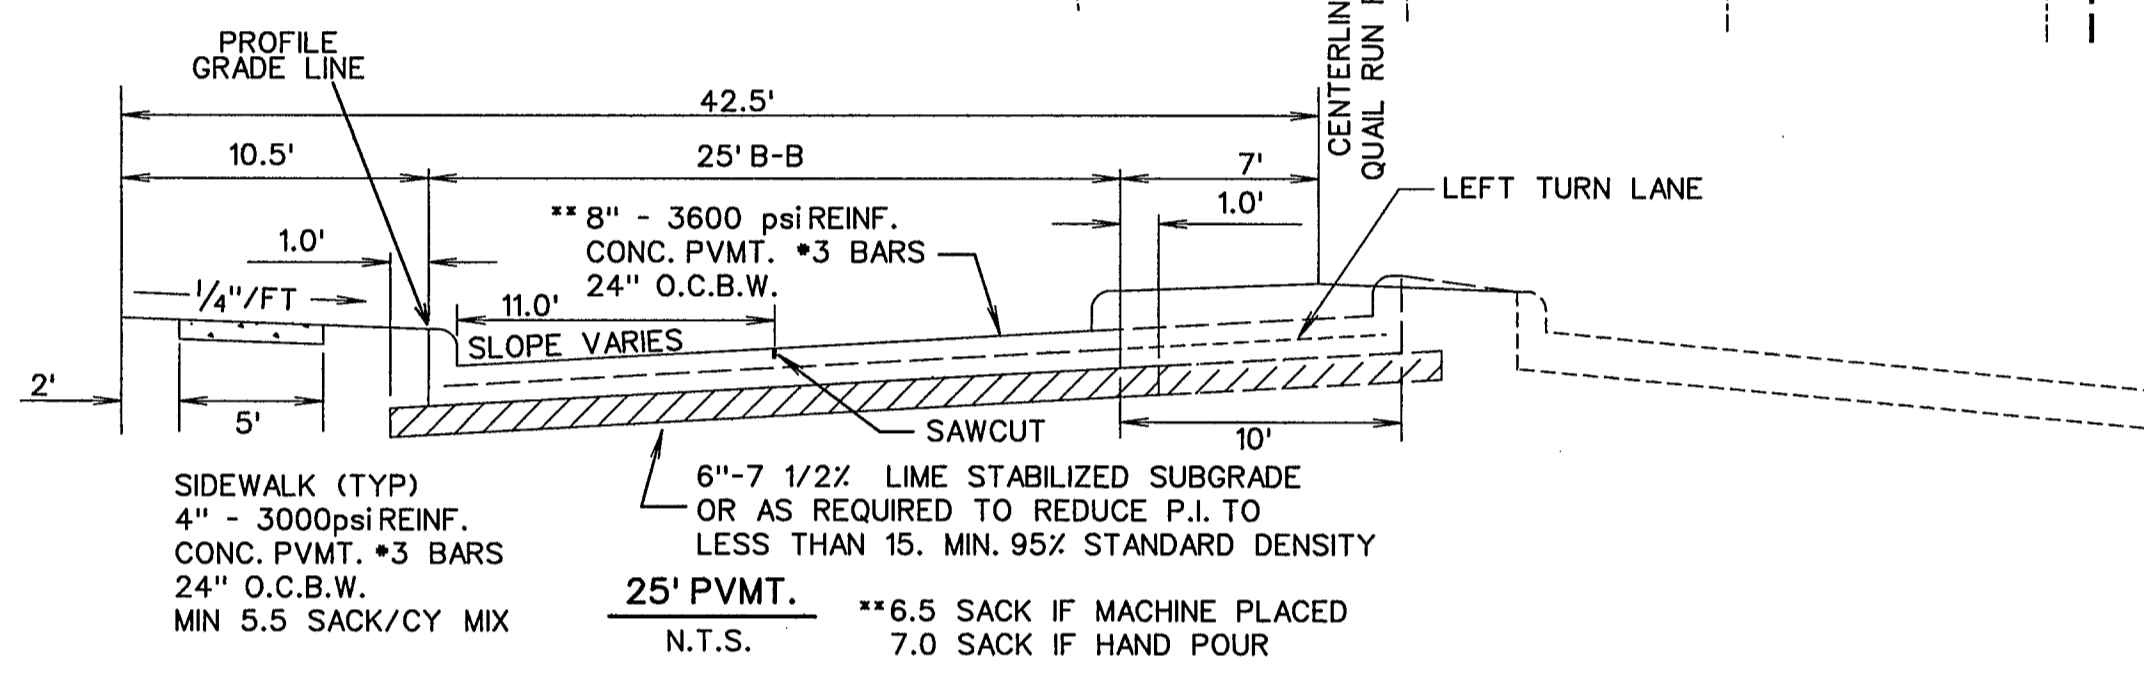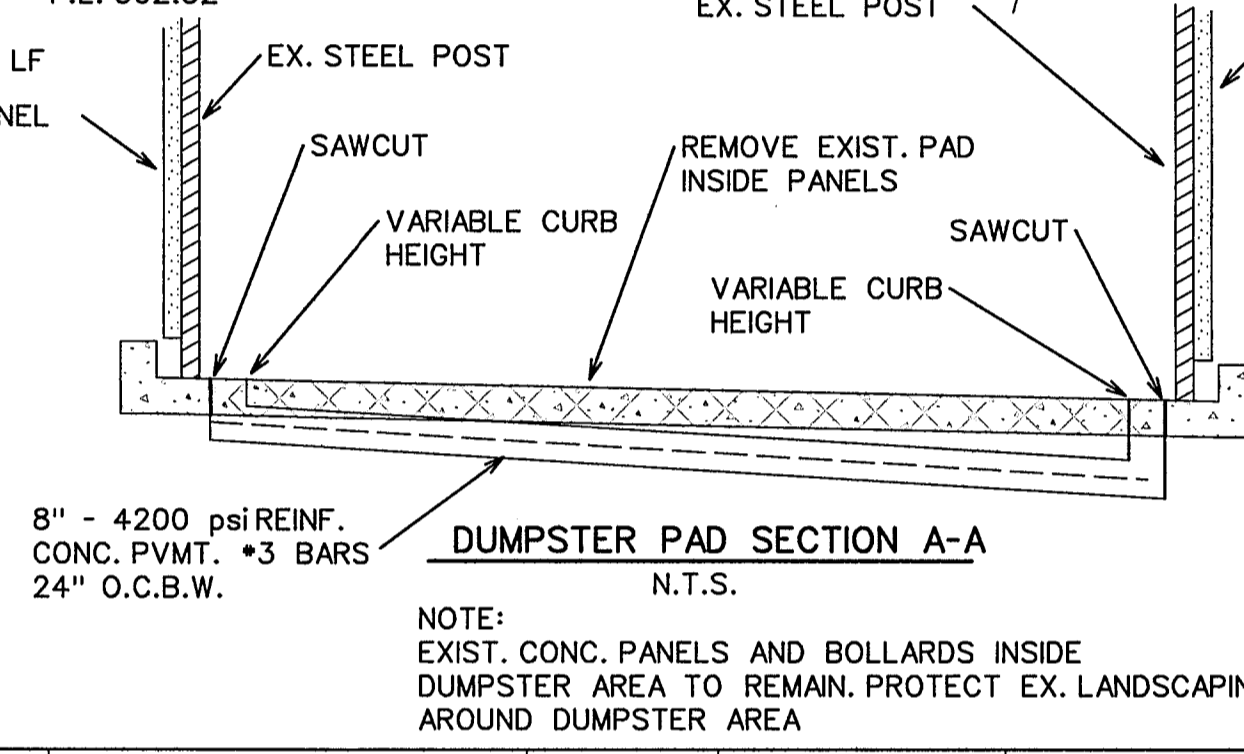


CORWIN ENGINEERING, INC.
 200 W. BELMONT, SUITE E
 ALLEN, TEXAS 75013 (972)396-1200
 TBPE FIRM #5951

DEVELOPMENT PLANS FOR
STONE CREEK
 PHASE VII
 ROCKWALL, TEXAS





QUAIL RUN ROAD

DRAWN BY	DESIGNED BY	CHECKED BY	SHEET NO.
JOB NUMBER	DATE	SCALE: HOR: 1"=40' VER: 1"=4'	11 OF 31
15047	MARCH 2016		



AS-BUILT DECEMBER 2016
 INFORMATION PROVIDED
 BY CONTRACTORS
 (NOT FIELD VERIFIED)

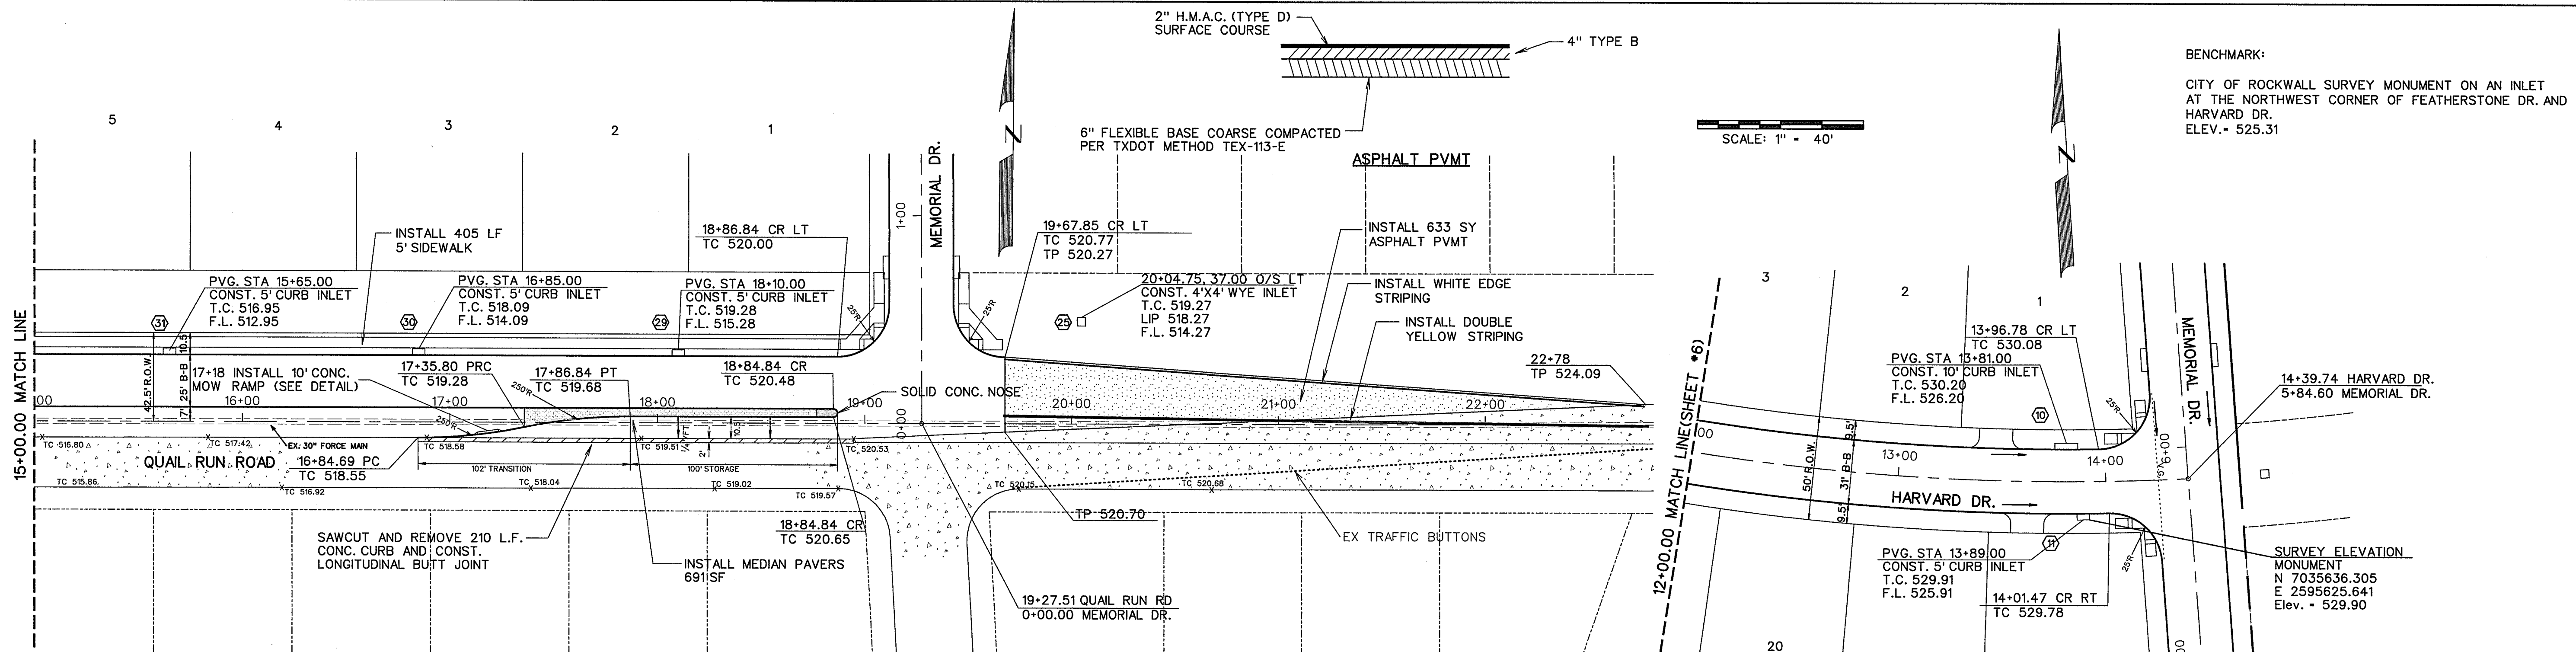

BENCHMARK:
 CITY OF ROCKWALL SURVEY MONUMENT ON AN INLET
 AT THE NORTHWEST CORNER OF FEATHERSTONE DR. AND
 HARVARD DR.
 ELEV. = 525.31

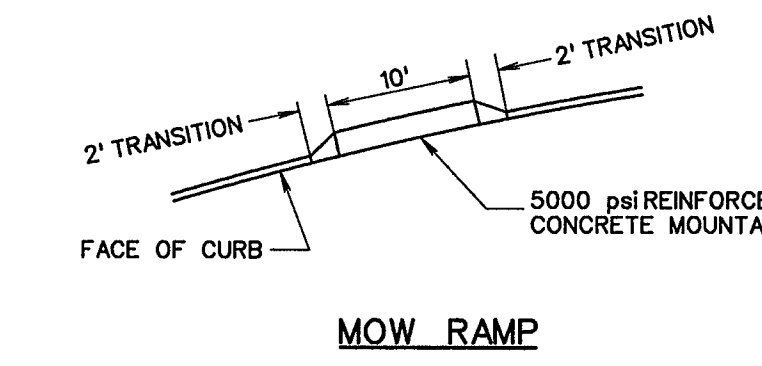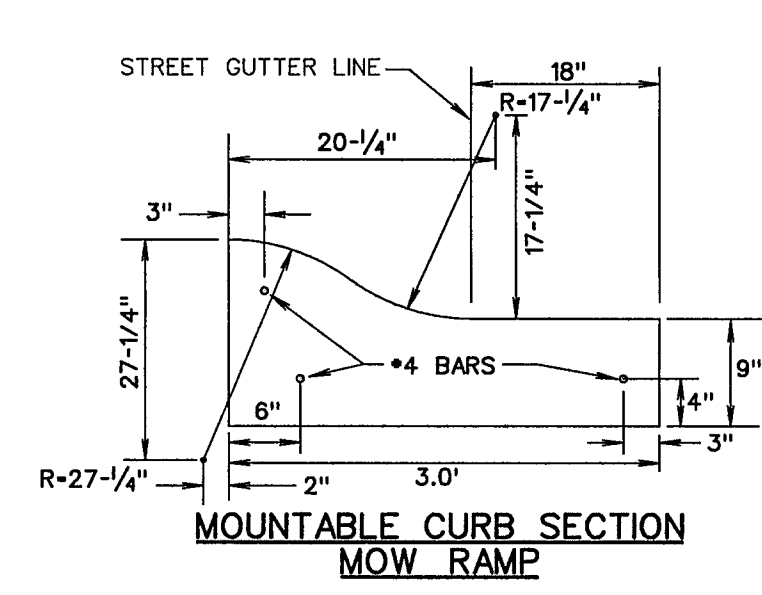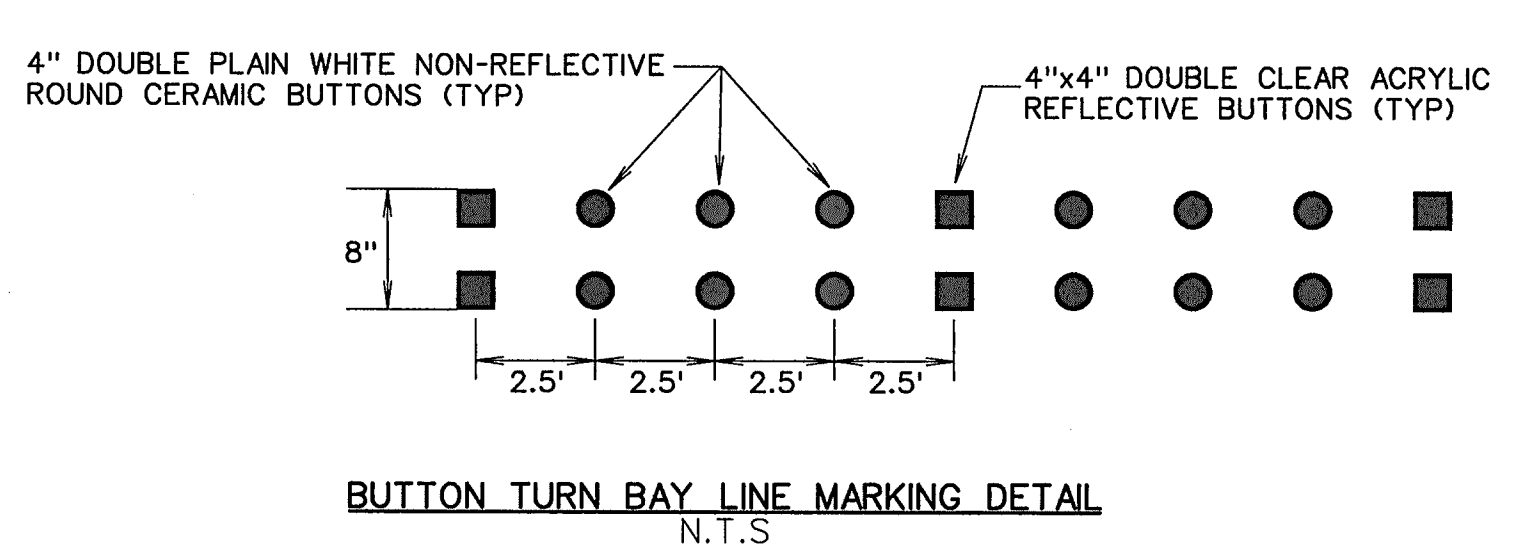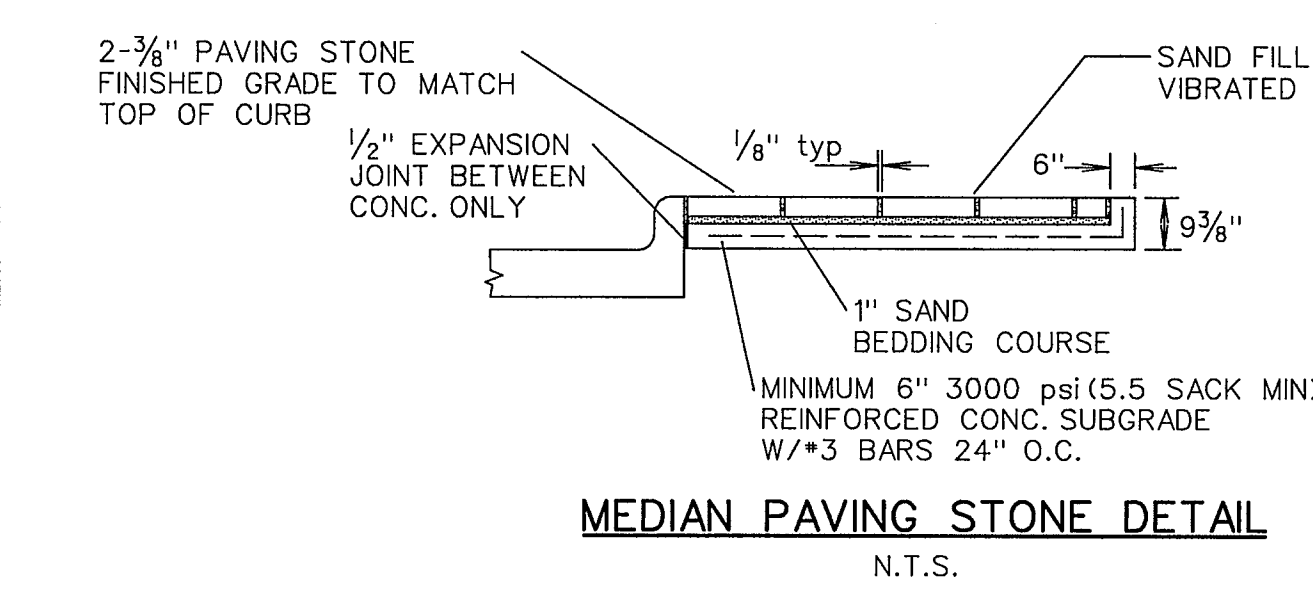

NOTE:
 INSTALL BARRIER FREE RAMPS
 TXDOT PED 12-A TYPE 7
 (SEE SHEET *10)

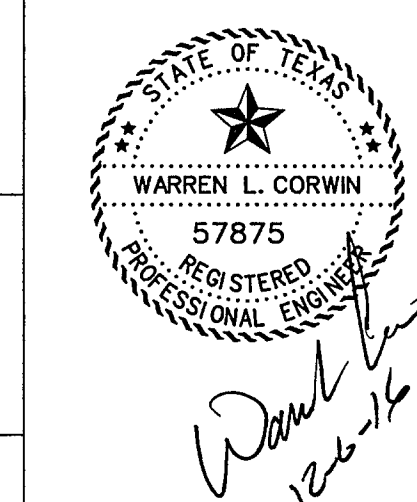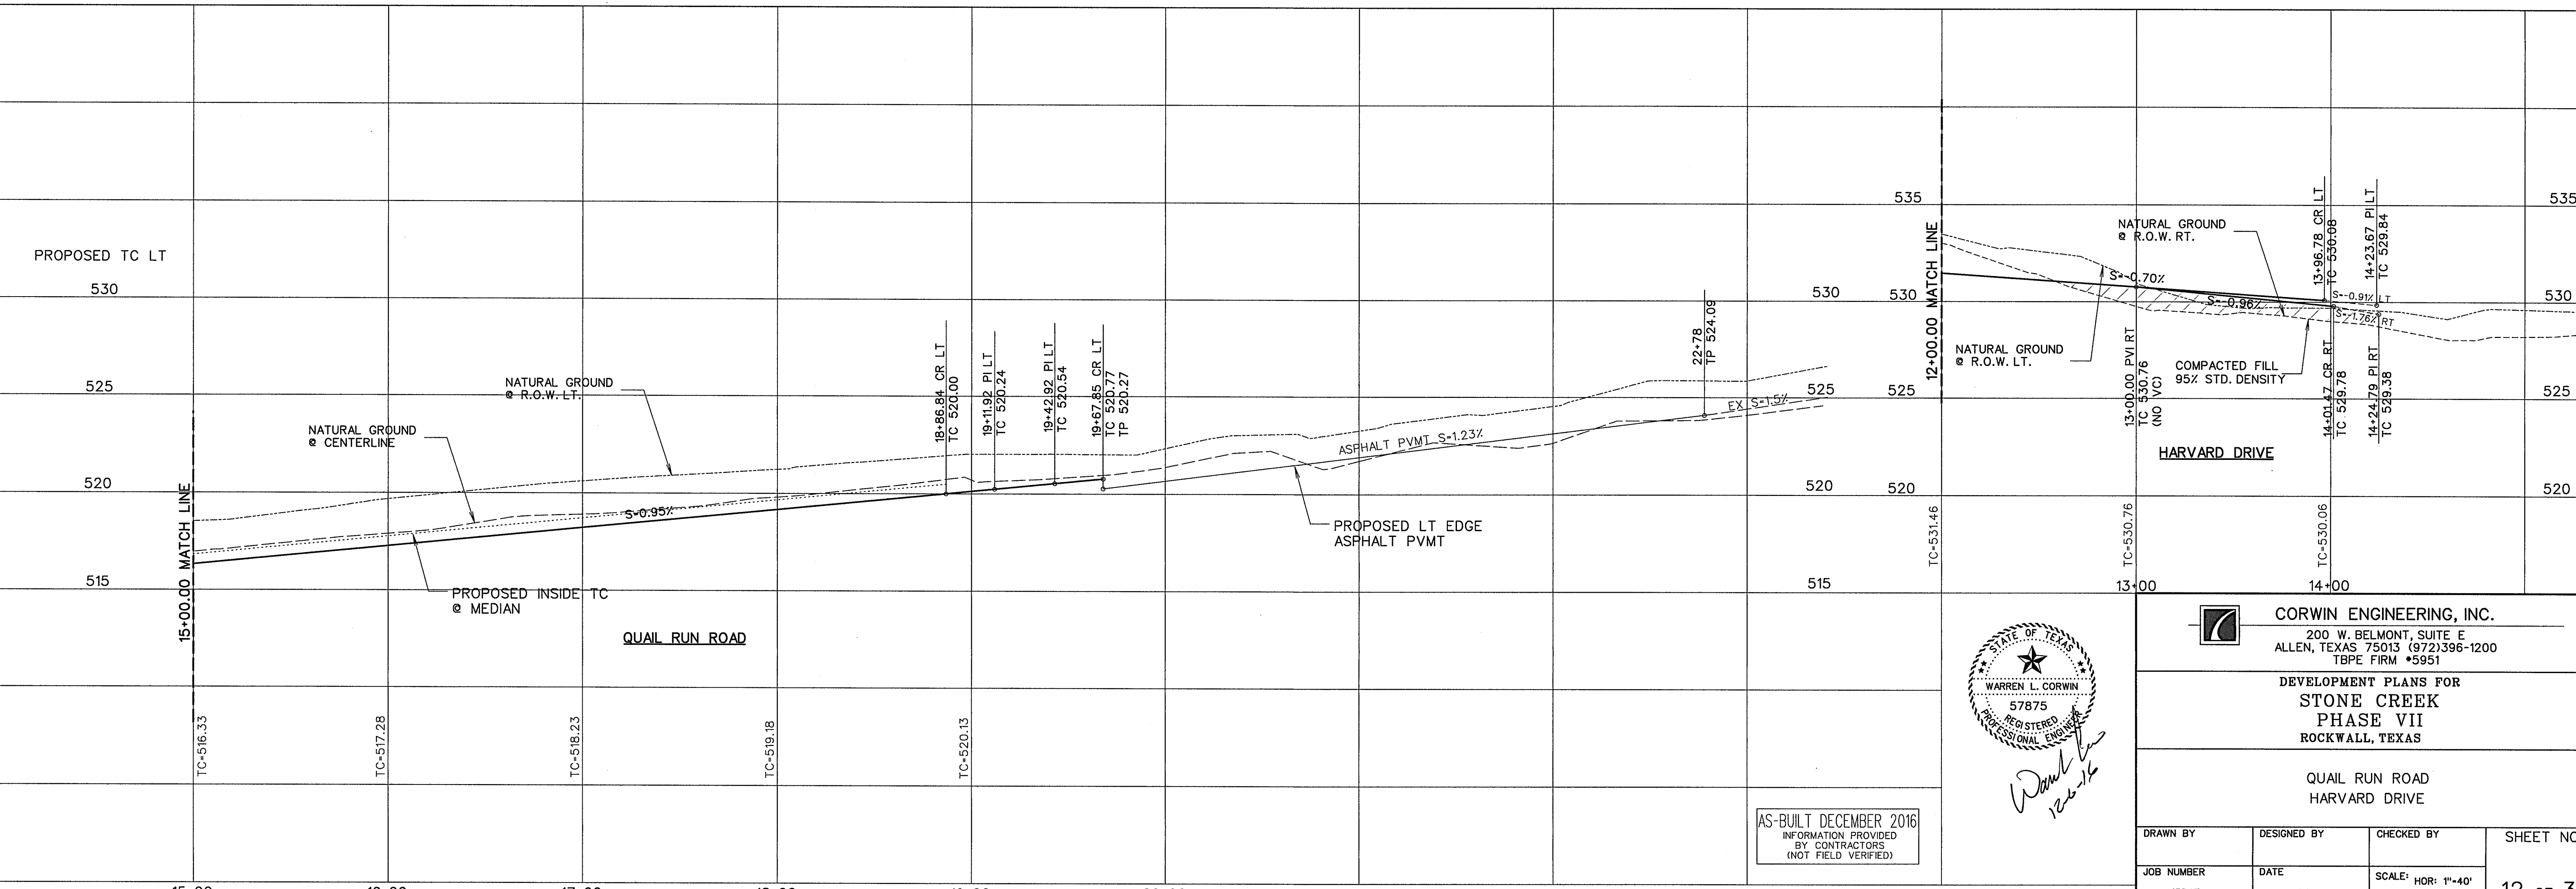


CORWIN ENGINEERING, INC.
 200 W. BELMONT, SUITE E
 ALLEN, TEXAS 75013 (972)396-1200
 TBPE FIRM #5951

**DEVELOPMENT PLANS FOR
 STONE CREEK
 PHASE VII
 ROCKWALL, TEXAS**


**QUAIL RUN ROAD
 HARVARD DRIVE**

AS-BUILT DECEMBER 2016
 INFORMATION PROVIDED
 BY CONTRACTORS
 (NOT FIELD VERIFIED)


DRAWN BY	DESIGNED BY	CHECKED BY	SHEET NO.
JOB NUMBER	DATE	SCALE: HOR: 1"=40' VER: 1"=4"	12 OF 31
15047	MARCH 2016		

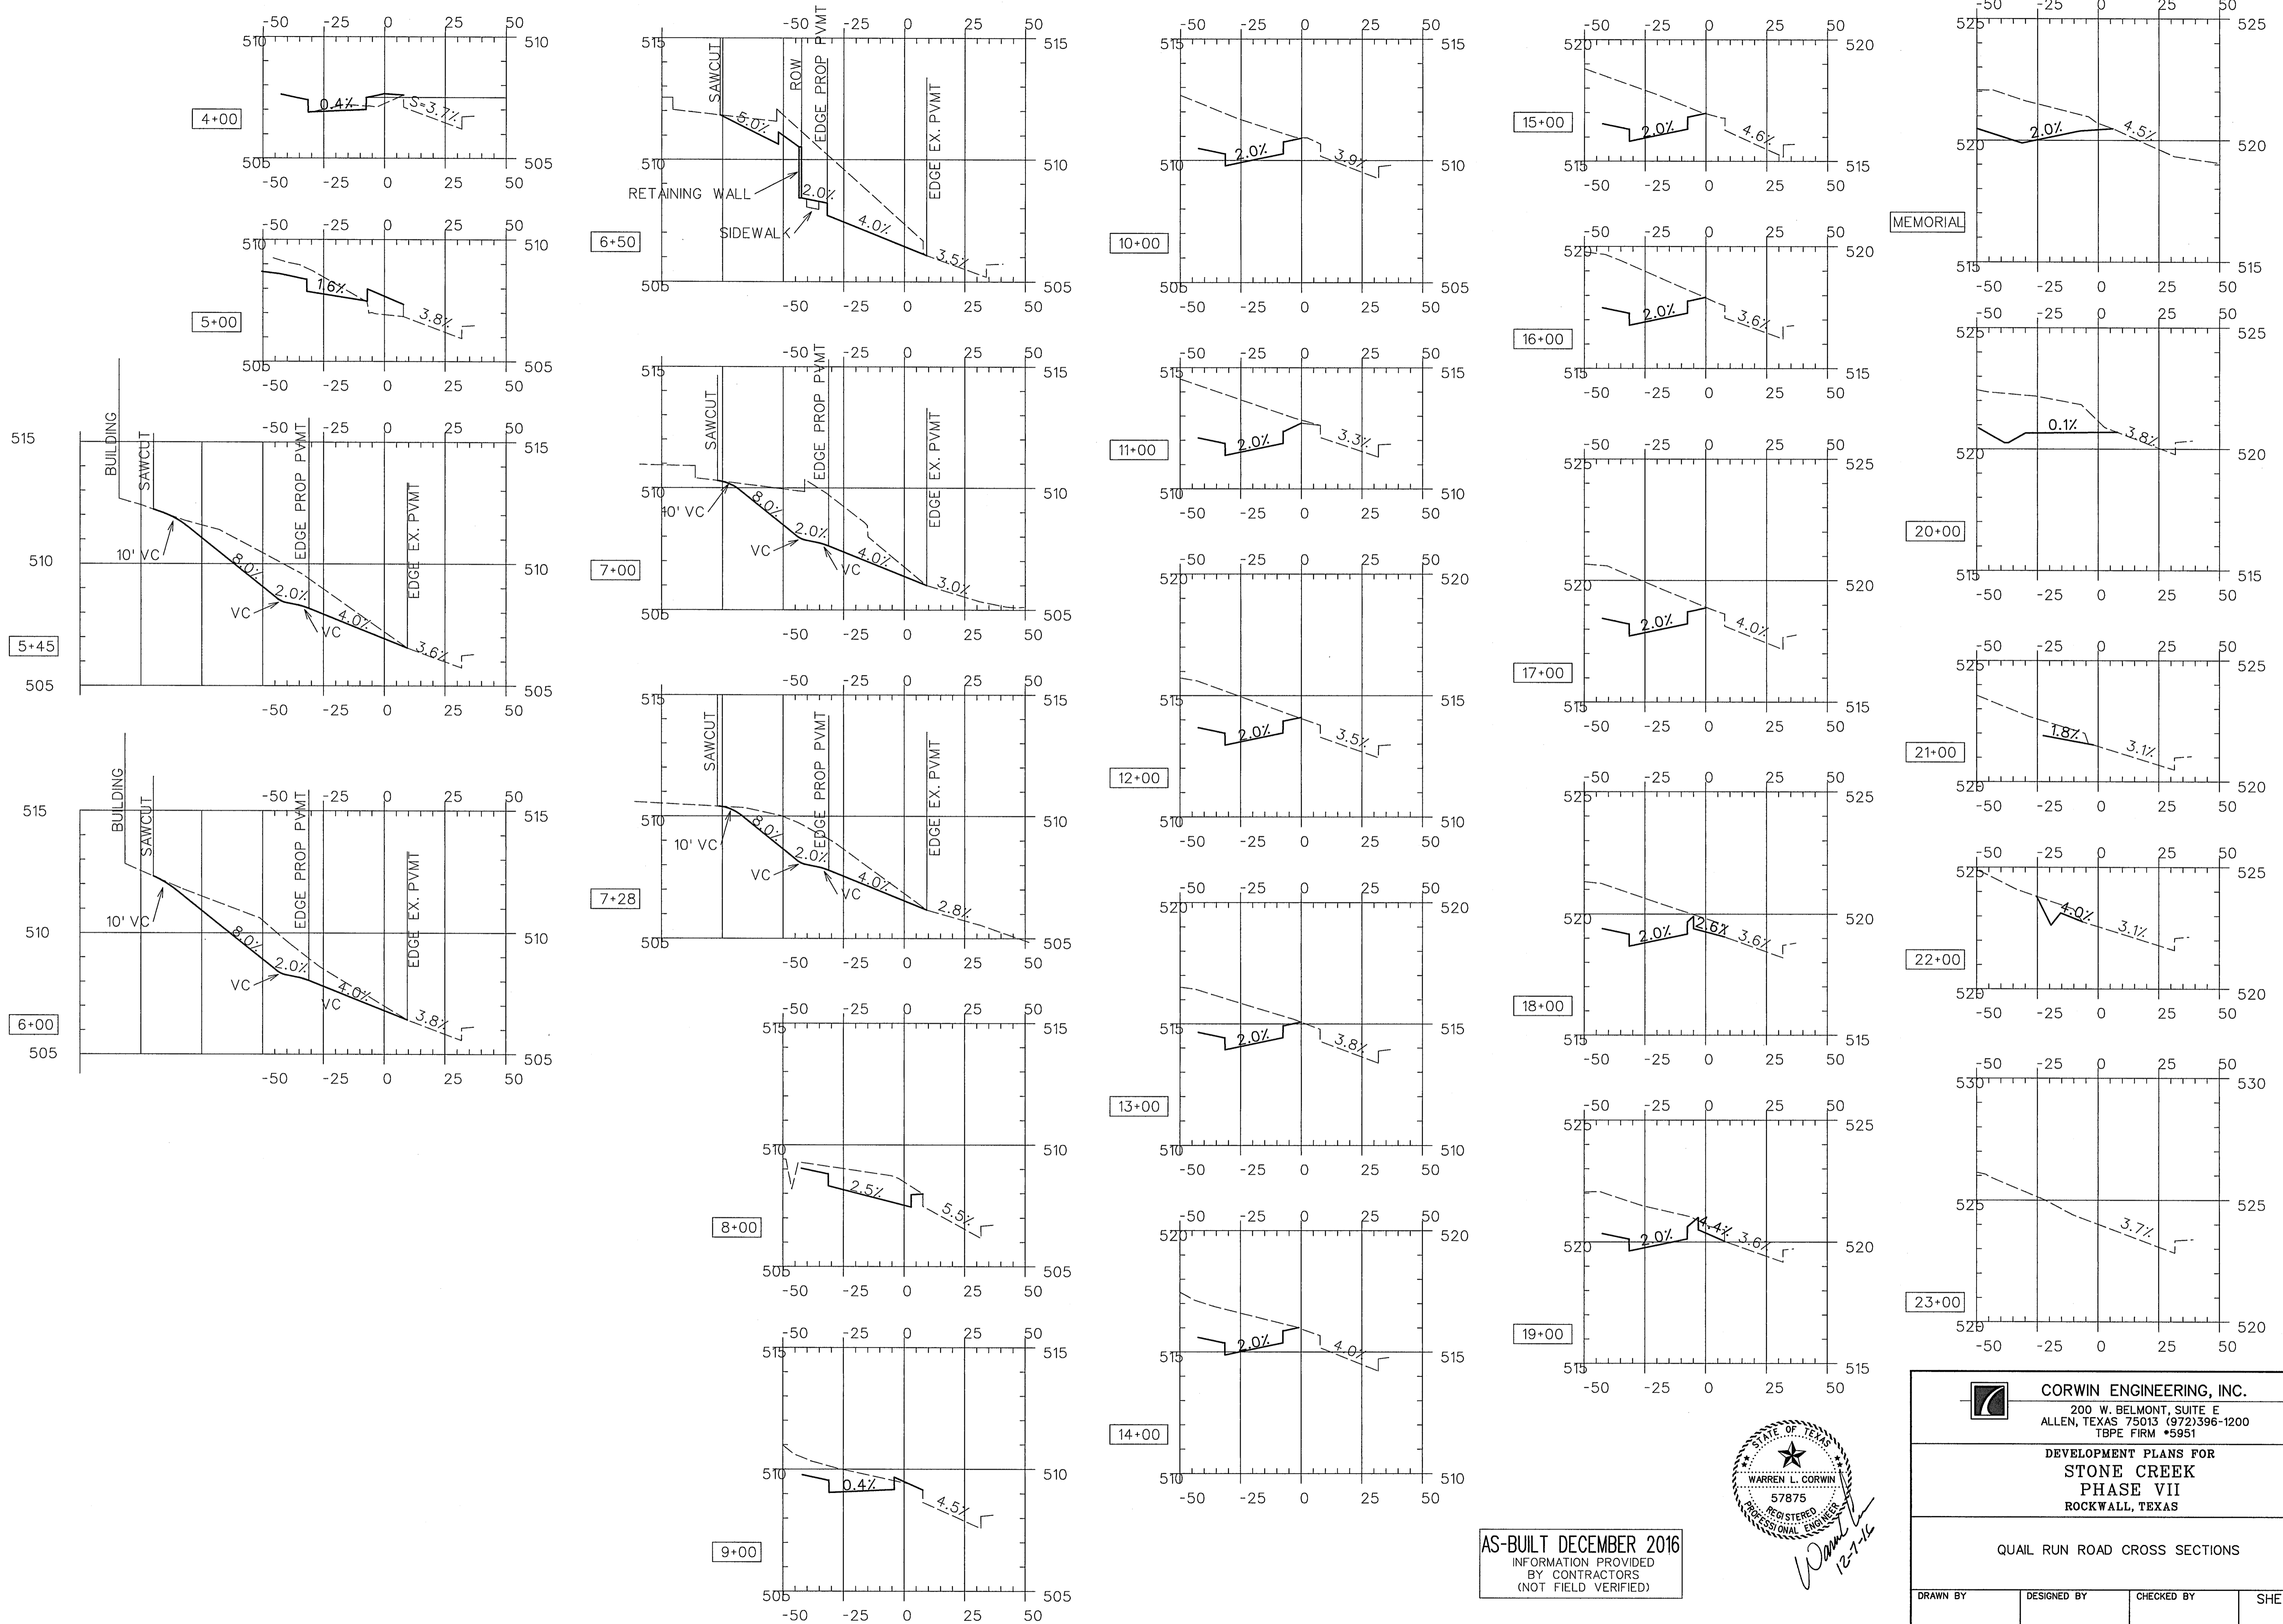

AS-BUILT DECEMBER 2016
 INFORMATION PROVIDED
 BY CONTRACTORS
 (NOT FIELD VERIFIED)

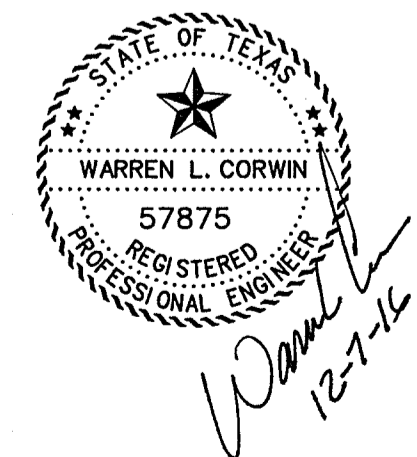

<p>CORWIN ENGINEERING, INC. 200 W. BELMONT, SUITE E ALLEN, TEXAS 75013 (972)396-1200 TBPE FIRM #5951</p>			
<p>DEVELOPMENT PLANS FOR STONE CREEK PHASE VII ROCKWALL, TEXAS</p>			
<p>QUAIL RUN ROAD CROSS SECTIONS</p>			
DRAWN BY	DESIGNED BY	CHECKED BY	SHEET NO.
JOB NUMBER 15047	DATE MARCH 2016	SCALE: HOR: 1"=30' VER: 1"=3'	12B of 31

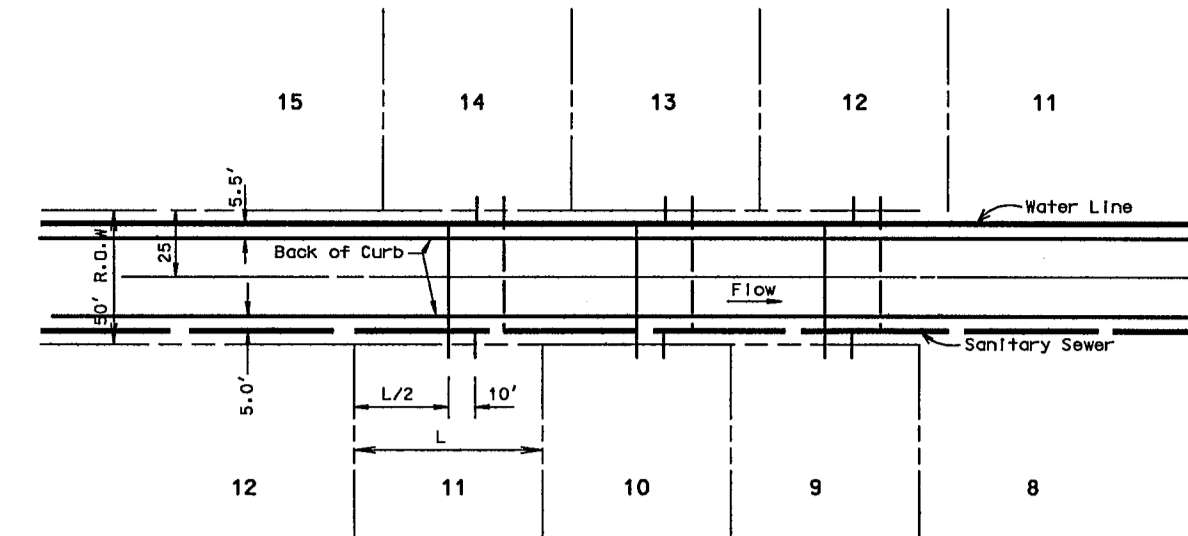

TYPICAL WATER & SEWER SERVICE LAYOUT
N.T.S.

SCALE: 1" = 100'

CURVE TABLE

CURVE NO.	DELTA	RADIUS	LENGTH	TANGENT
1.	28°17'39"	679.00'	335.31'	171.15'
2.	69°15'19"	329.00'	397.67'	227.20'
3.	14°15'23"	821.00'	205.00'	103.04'
4.	08°33'46"	1171.00'	175.00'	87.66'
5.	22°59'48"	1171.00'	470.00'	238.21'
6.	24°39'13"	250.00'	107.57'	54.63'
7.	07°27'46"	644.00'	83.88'	42.00'
8.	07°27'05"	1531.00'	199.11'	99.69'


NOTE:
 ALL WATER LINES TO BE CLASS 200 PIPE DR-14 C-900.
 ALL SANITARY SEWER PIPE TO BE SDR 35 FOR 5'-10' DEEP AND SDR 26 FOR 10' AND GREATER.
 INSTALL BLUE "EMS" DISK ON WATER LINE AT EVERY 250' AND CHANGE IN DIRECTION, VALVE, AND SERVICE.
 INSTALL GREEN "EMS" DISK ON SANITARY SEWER LINE EVERY 250' AND AT EVERY CHANGE IN DIRECTION, MANHOLE, CLEANOUT, AND SERVICE.
 ALL MANHOLES TO BE RAVEN EPOXY LINED AND SEALED OR APPROVED EQUAL TO BE SPARK AND PRESSURE TESTED.

SERVICE SCHEDULE		
TYPE	SIZE	NO.
SANITARY	4"	80
WATER	1"	80
IRRIGATION	1 1/2"	3

- LEGEND**
- PROP. WATER LINE
 - PROP. FIRE HYDRANT AND VALVE
 - PROP. GATE VALVE
 - PROP. FLUSH VALVE
 - EXIST. WATER LINE
 - EXIST. FIRE HYDRANT AND VALVE
 - PROP. SANITARY SEWER
 - PROP. MANHOLE
 - PROP. CLEANOUT
 - EXIST. SANITARY SEWER
 - EXIST. MANHOLE
 - PROP. STORM SEWER
 - PROP. CURB INLETS
 - PROP. CONC. HEADWALL

BENCHMARK:
 CITY OF ROCKWALL SURVEY MONUMENT ON AN INLET AT THE NORTHWEST CORNER OF FEATHERSTONE DR. AND HARVARD DR.
 ELEV. = 525.31

AS-BUILT DECEMBER 2016
 INFORMATION PROVIDED BY CONTRACTORS (NOT FIELD VERIFIED)

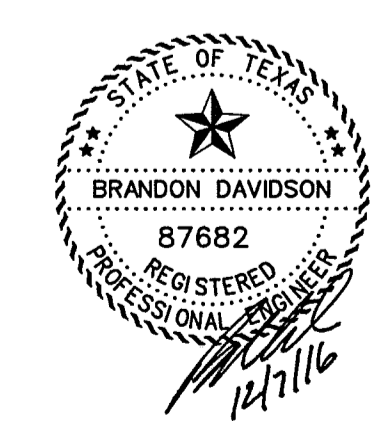


CORWIN ENGINEERING, INC.
 200 W. BELMONT, SUITE E
 ALLEN, TEXAS 75013 (972) 396-1200
 TBPE FIRM #5951

DEVELOPMENT PLANS FOR
STONE CREEK PHASE VII
 ROCKWALL, TEXAS

WATER AND SANITARY SEWER PLAN

DRAWN BY	DESIGNED BY	CHECKED BY	SHEET NO.
JOB NUMBER	DATE	SCALE:	13 of 31
15047	MARCH 2016	1"=100'	

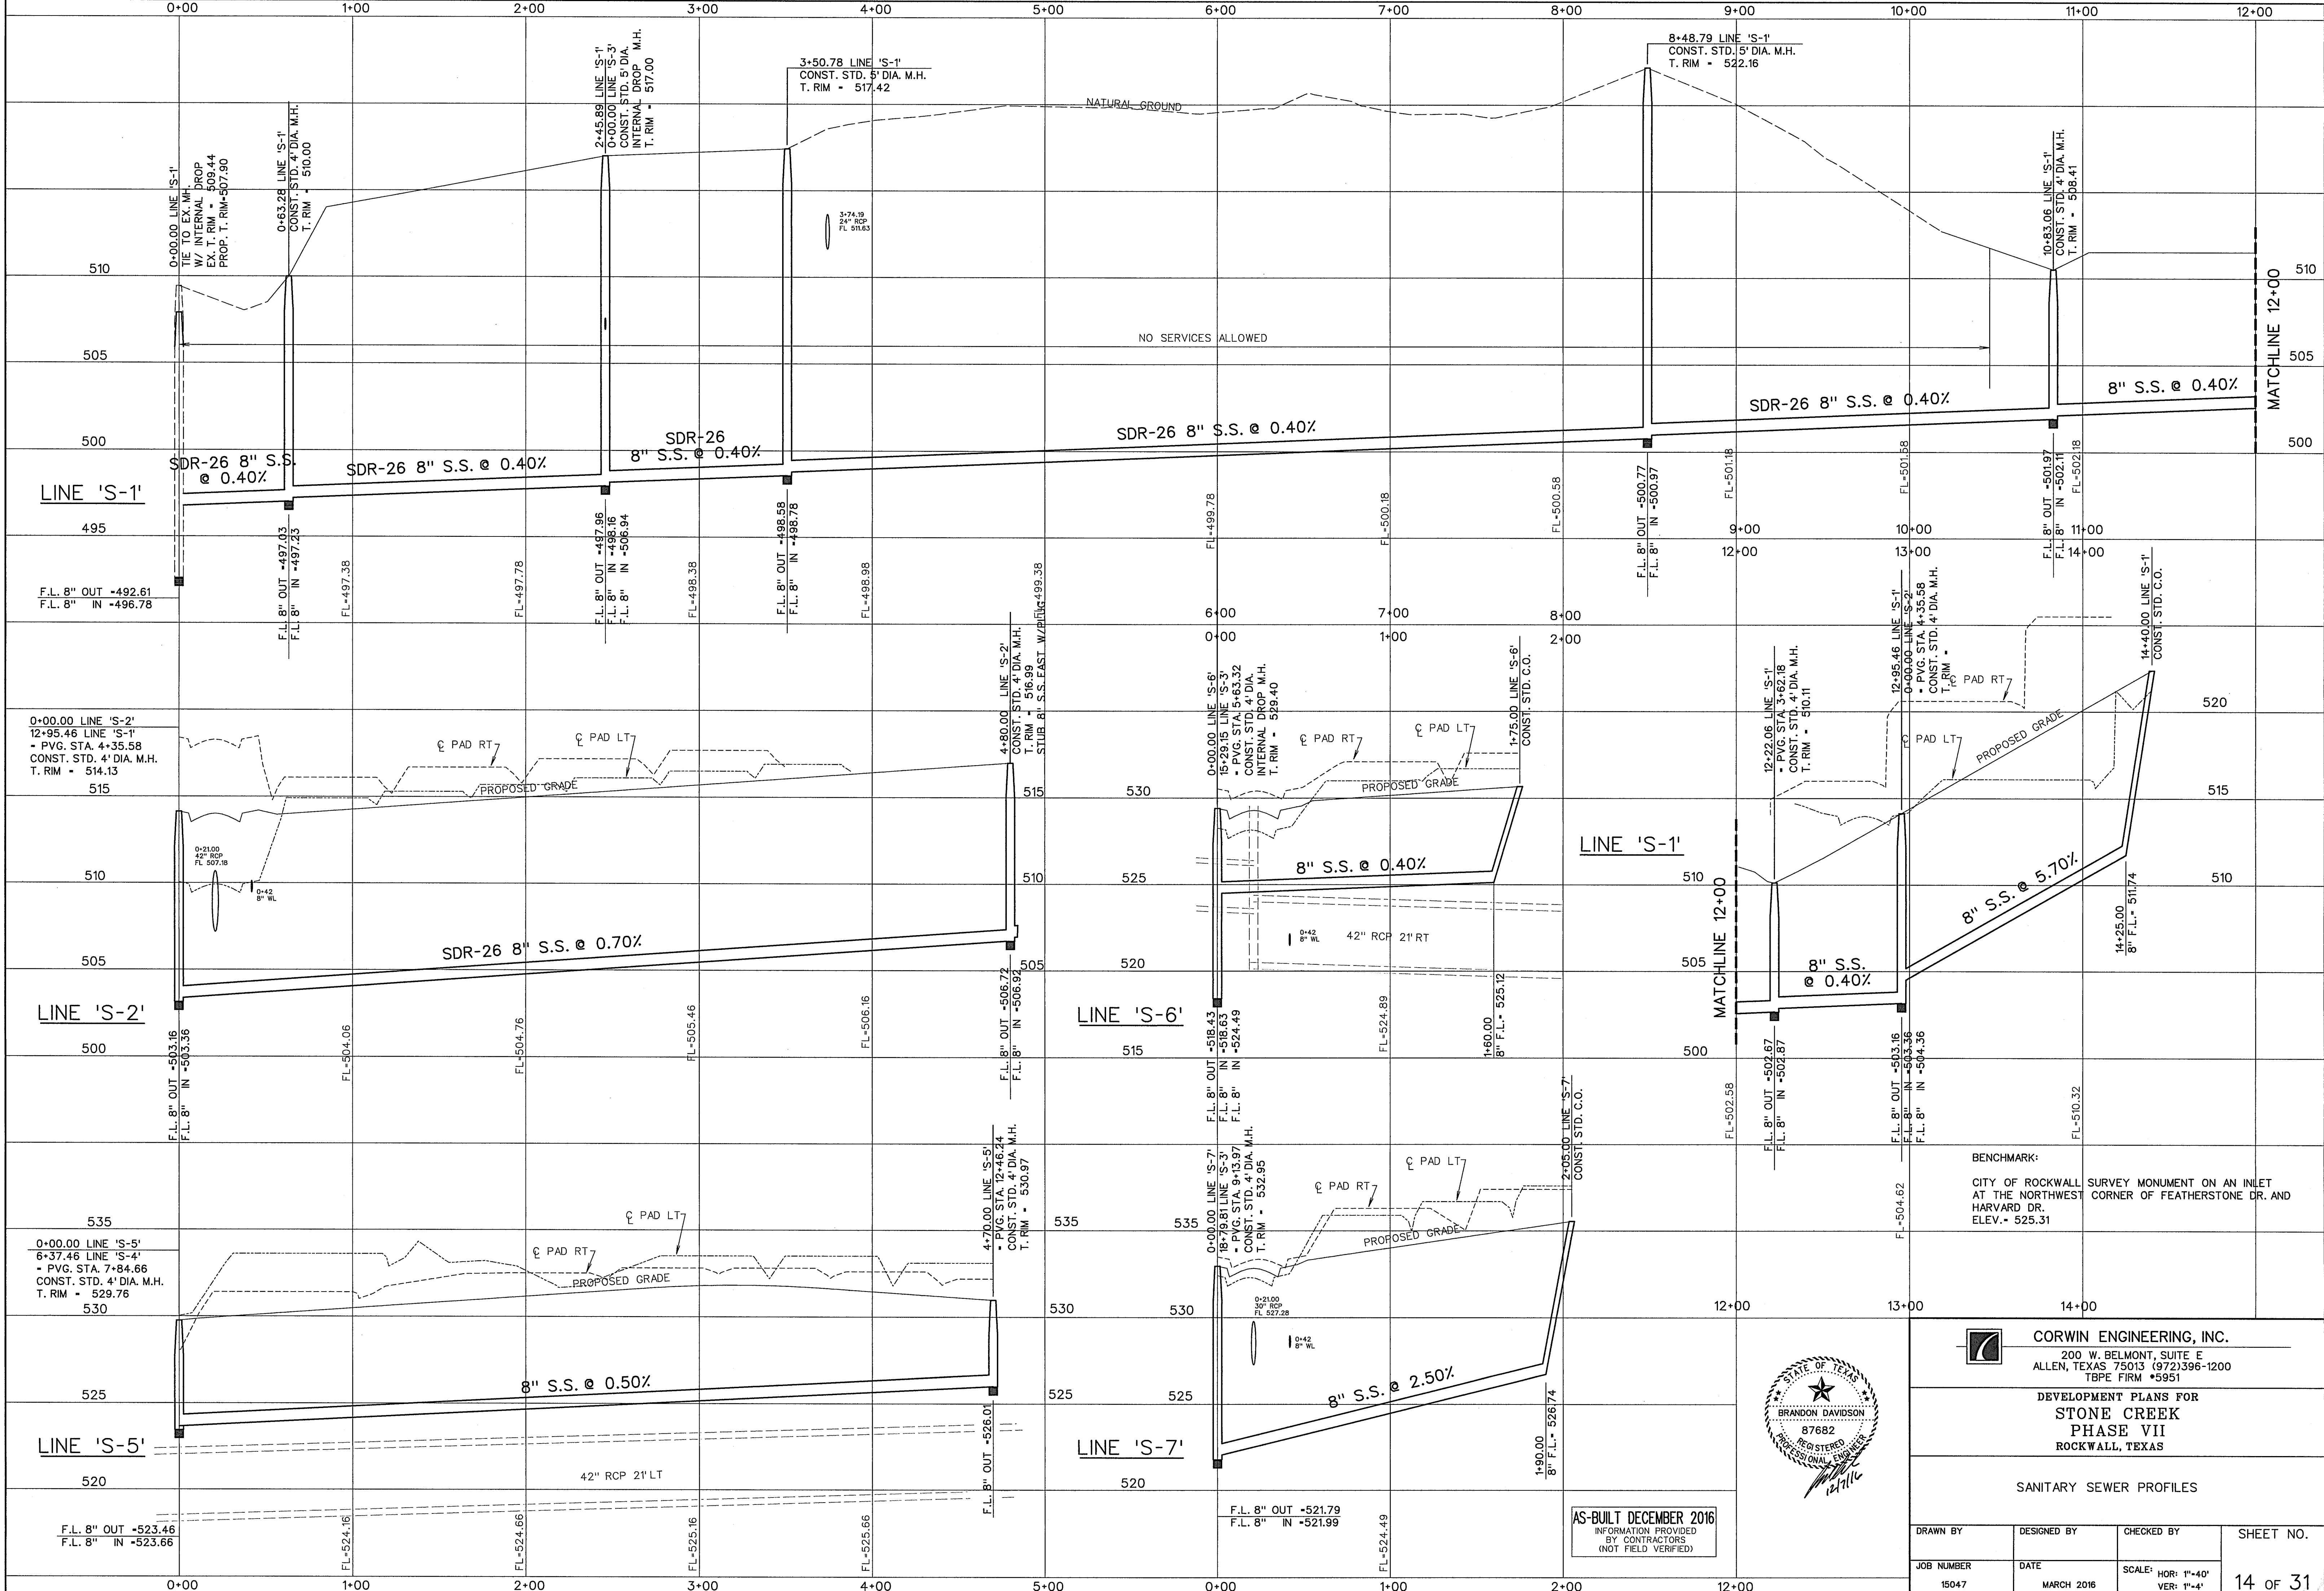


CORWIN ENGINEERING, INC.
 200 W. BELMONT, SUITE E
 ALLEN, TEXAS 75013 (972)396-1200
 TBPE FIRM #5951

DEVELOPMENT PLANS FOR
**STONE CREEK
 PHASE VII**
 ROCKWALL, TEXAS

SANITARY SEWER PROFILES


AS-BUILT DECEMBER 2016
 INFORMATION PROVIDED
 BY CONTRACTORS
 (NOT FIELD VERIFIED)

DRAWN BY	DESIGNED BY	CHECKED BY	SHEET NO.
JOB NUMBER	DATE	SCALE: HOR: 1"=40' VER: 1"=4'	14 OF 31
15047	MARCH 2016		

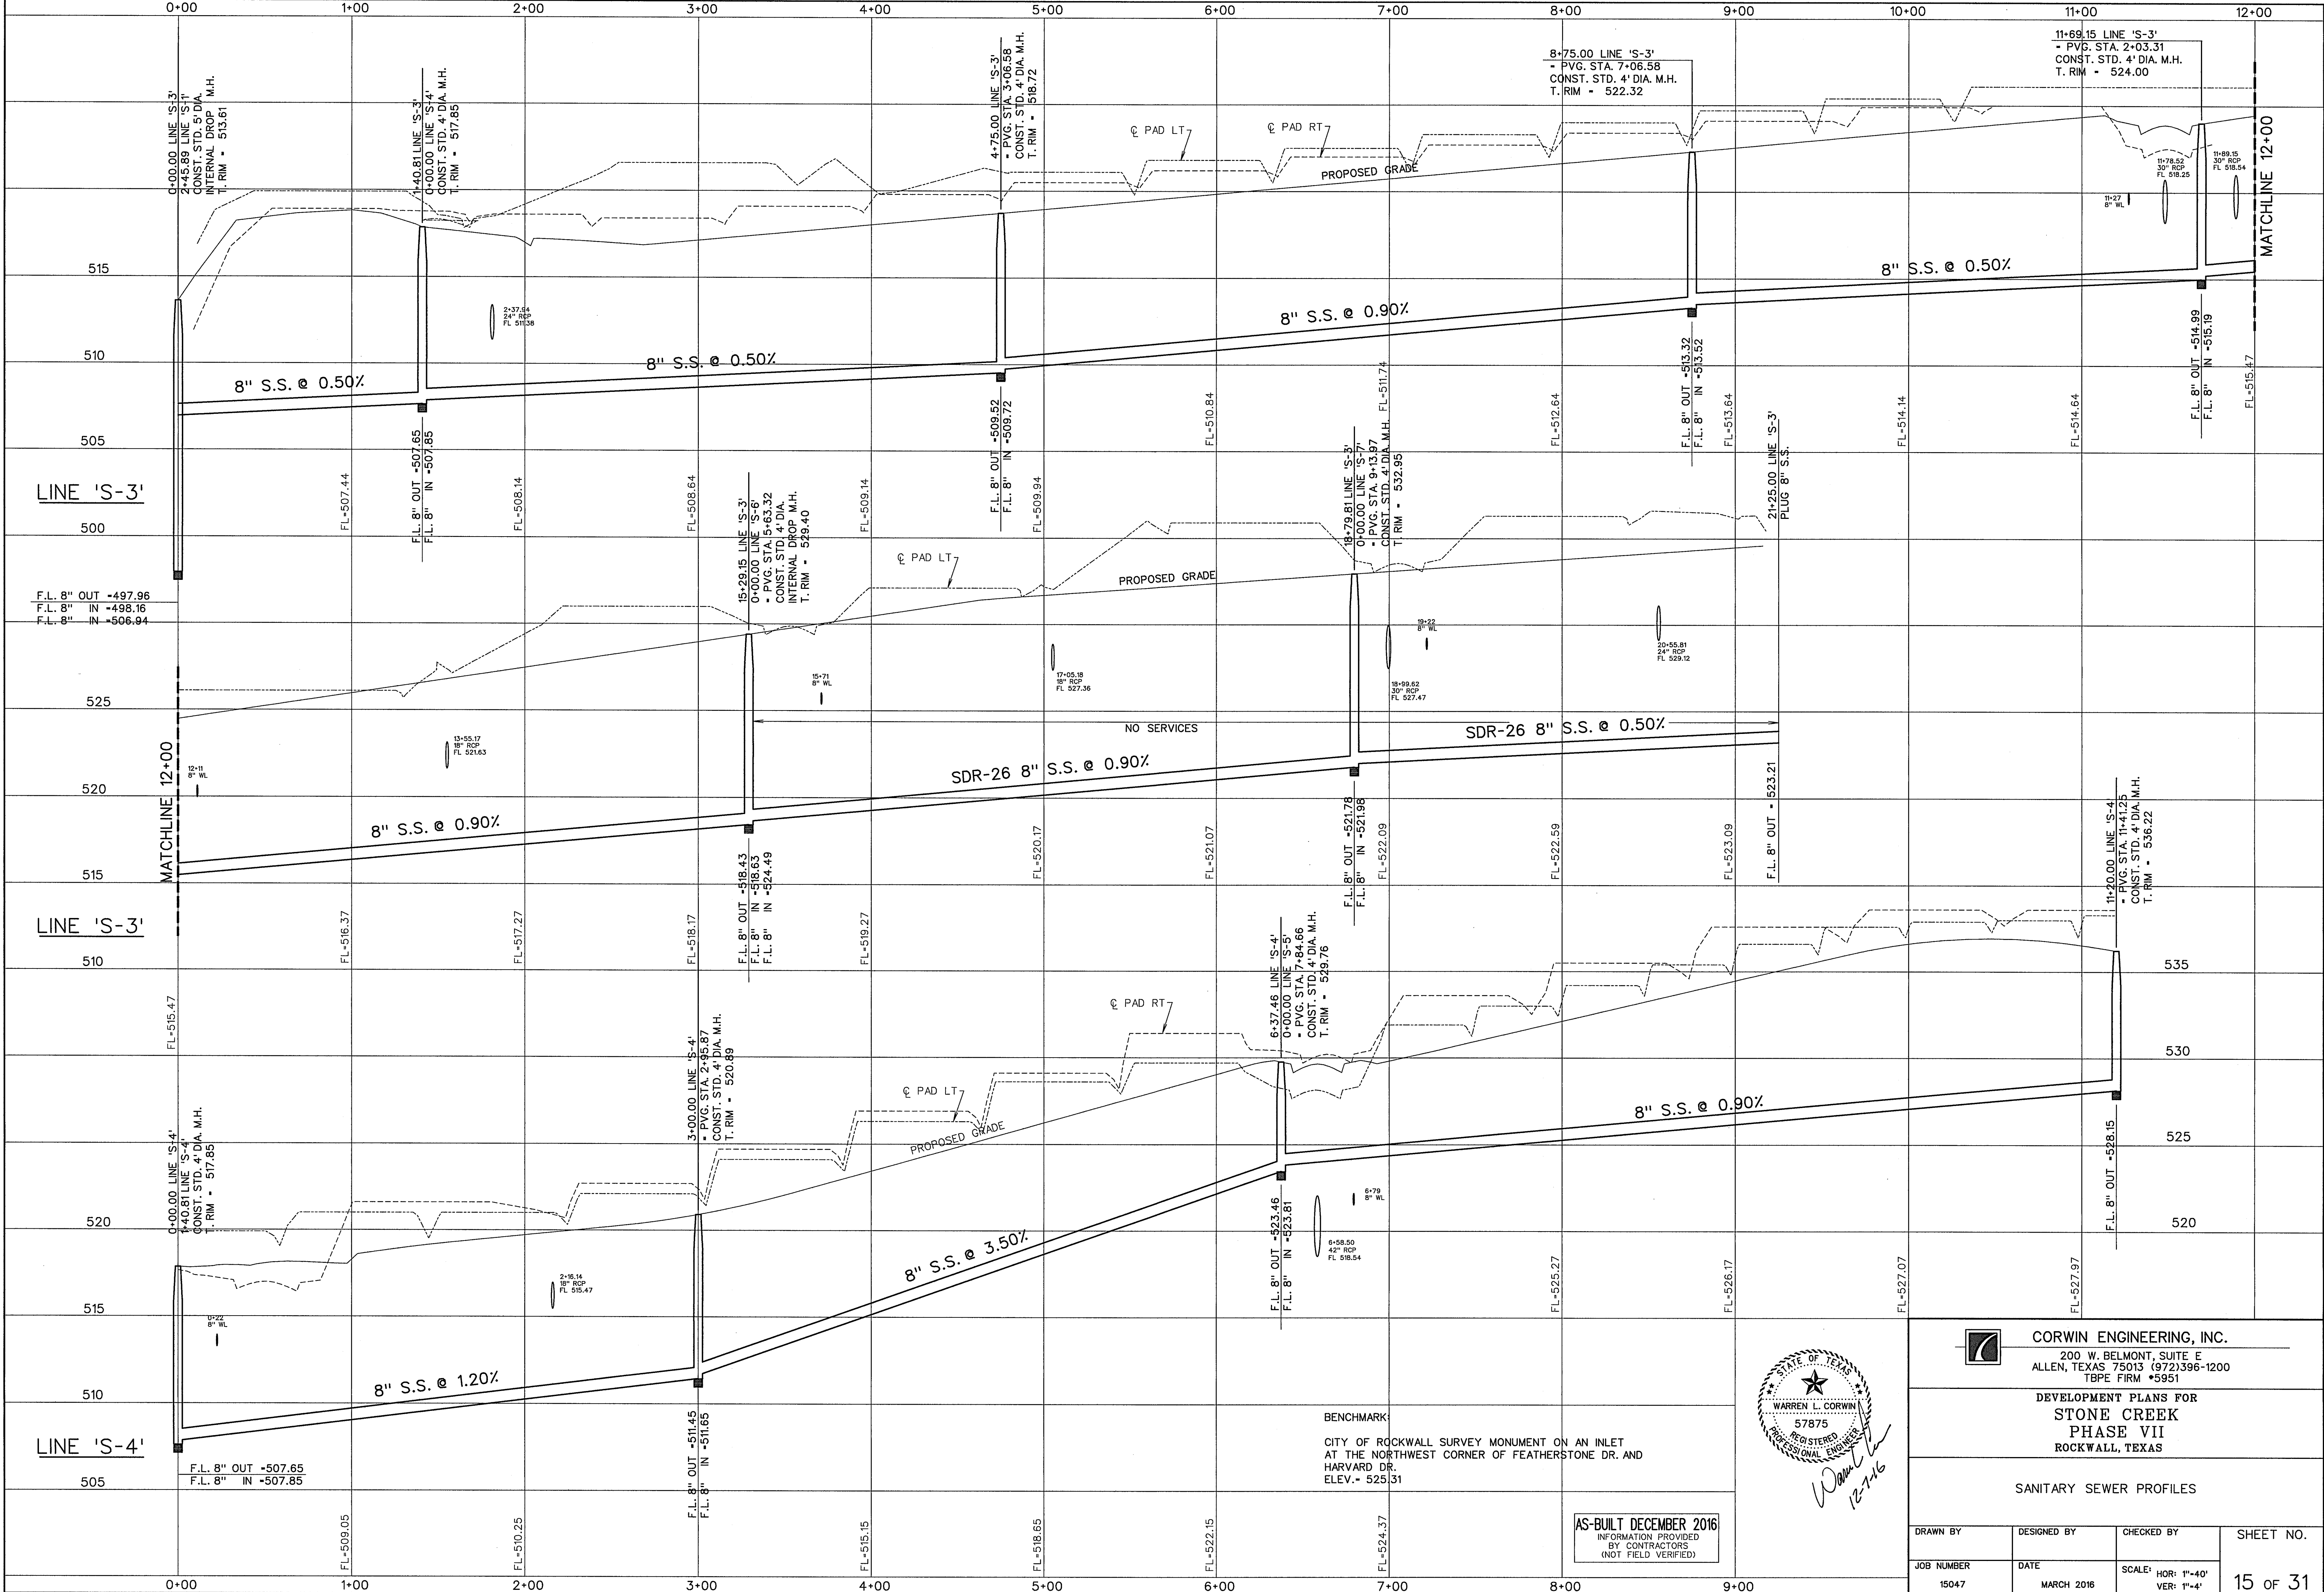

BENCHMARK
 CITY OF ROCKWALL SURVEY MONUMENT ON AN INLET
 AT THE NORTHWEST CORNER OF FEATHERSTONE DR. AND
 HARVARD DR.
 ELEV. - 525.31

AS-BUILT DECEMBER 2016
 INFORMATION PROVIDED
 BY CONTRACTORS
 (NOT FIELD VERIFIED)

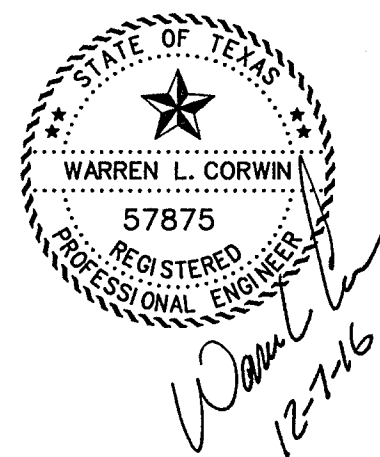




CORWIN ENGINEERING, INC.
 200 W. BELMONT, SUITE E
 ALLEN, TEXAS 75013 (972)396-1200
 TBPE FIRM #5951

DEVELOPMENT PLANS FOR
STONE CREEK
 PHASE VII
 ROCKWALL, TEXAS



SANITARY SEWER PROFILES

DRAWN BY	DESIGNED BY	CHECKED BY	SHEET NO.
JOB NUMBER	DATE	SCALE: HOR: 1"=40' VER: 1"=4'	15 of 31
15047	MARCH 2016		

CURVE DATA			
CURVE NO.	①	②	③
Δ	11° 58' 51"	• ' "	• ' "
R	150.00'	'	'
T	15.74'	'	'
L	31.37'	'	'

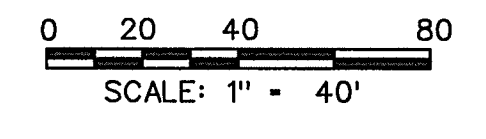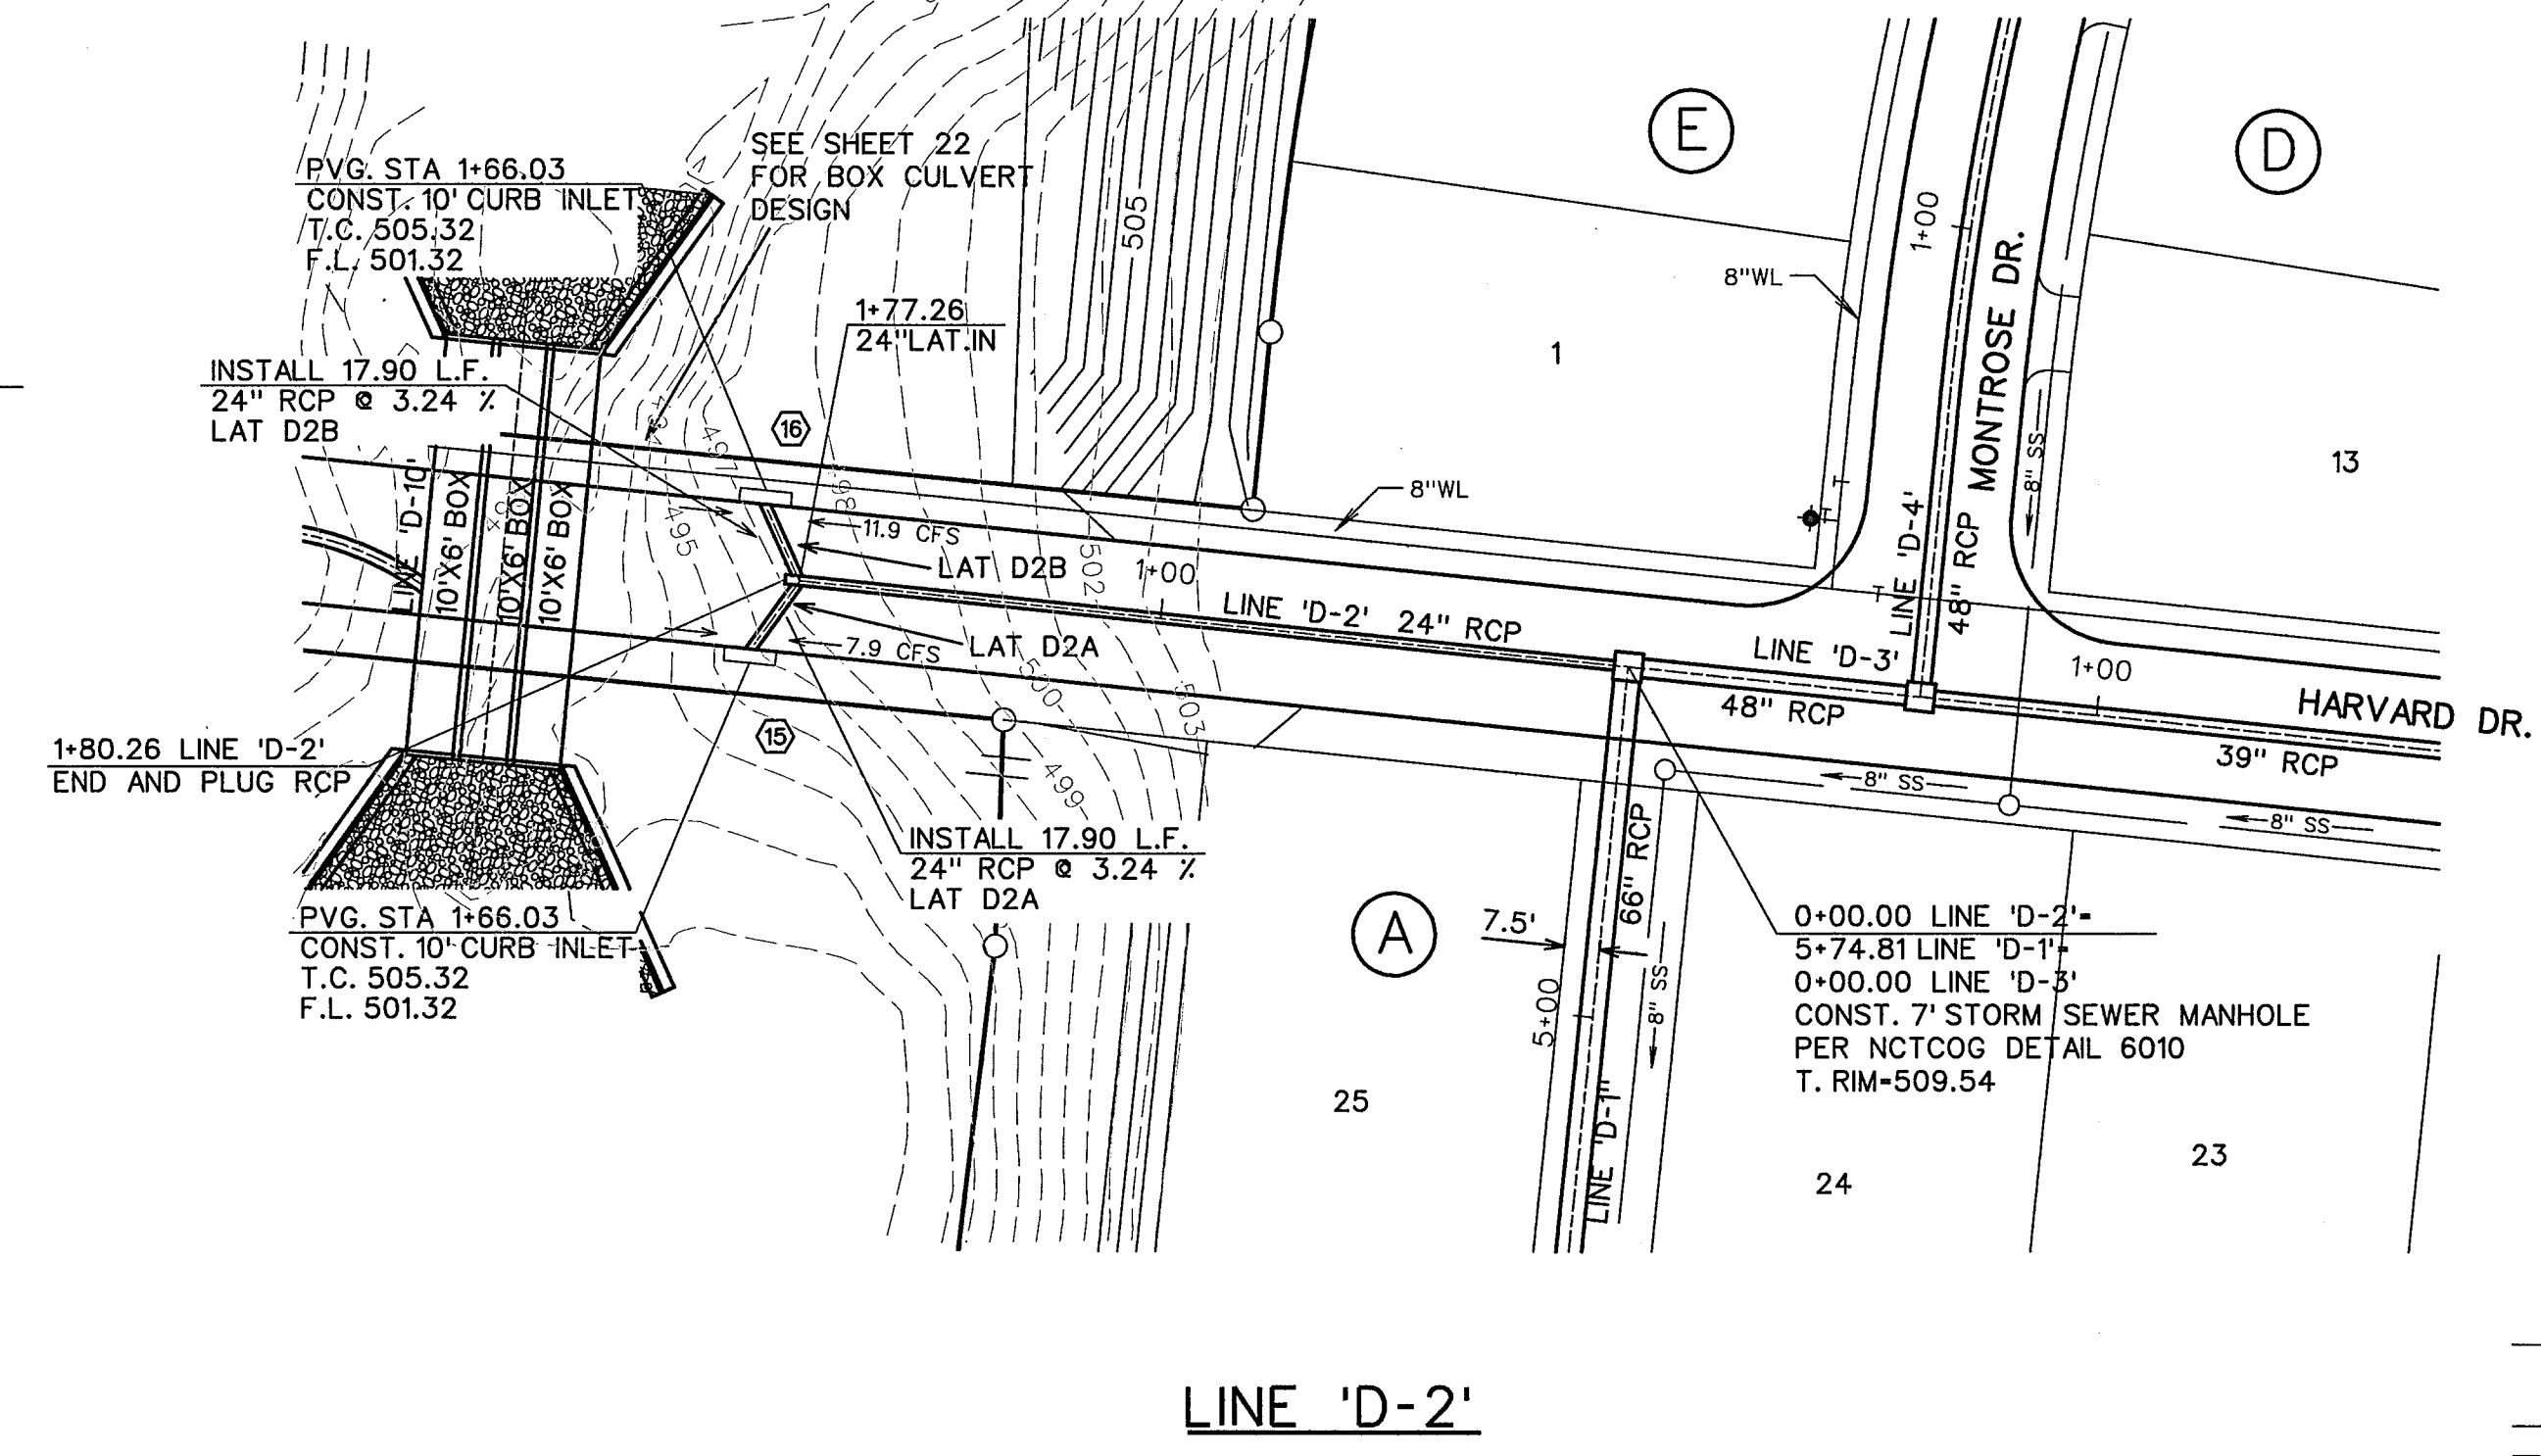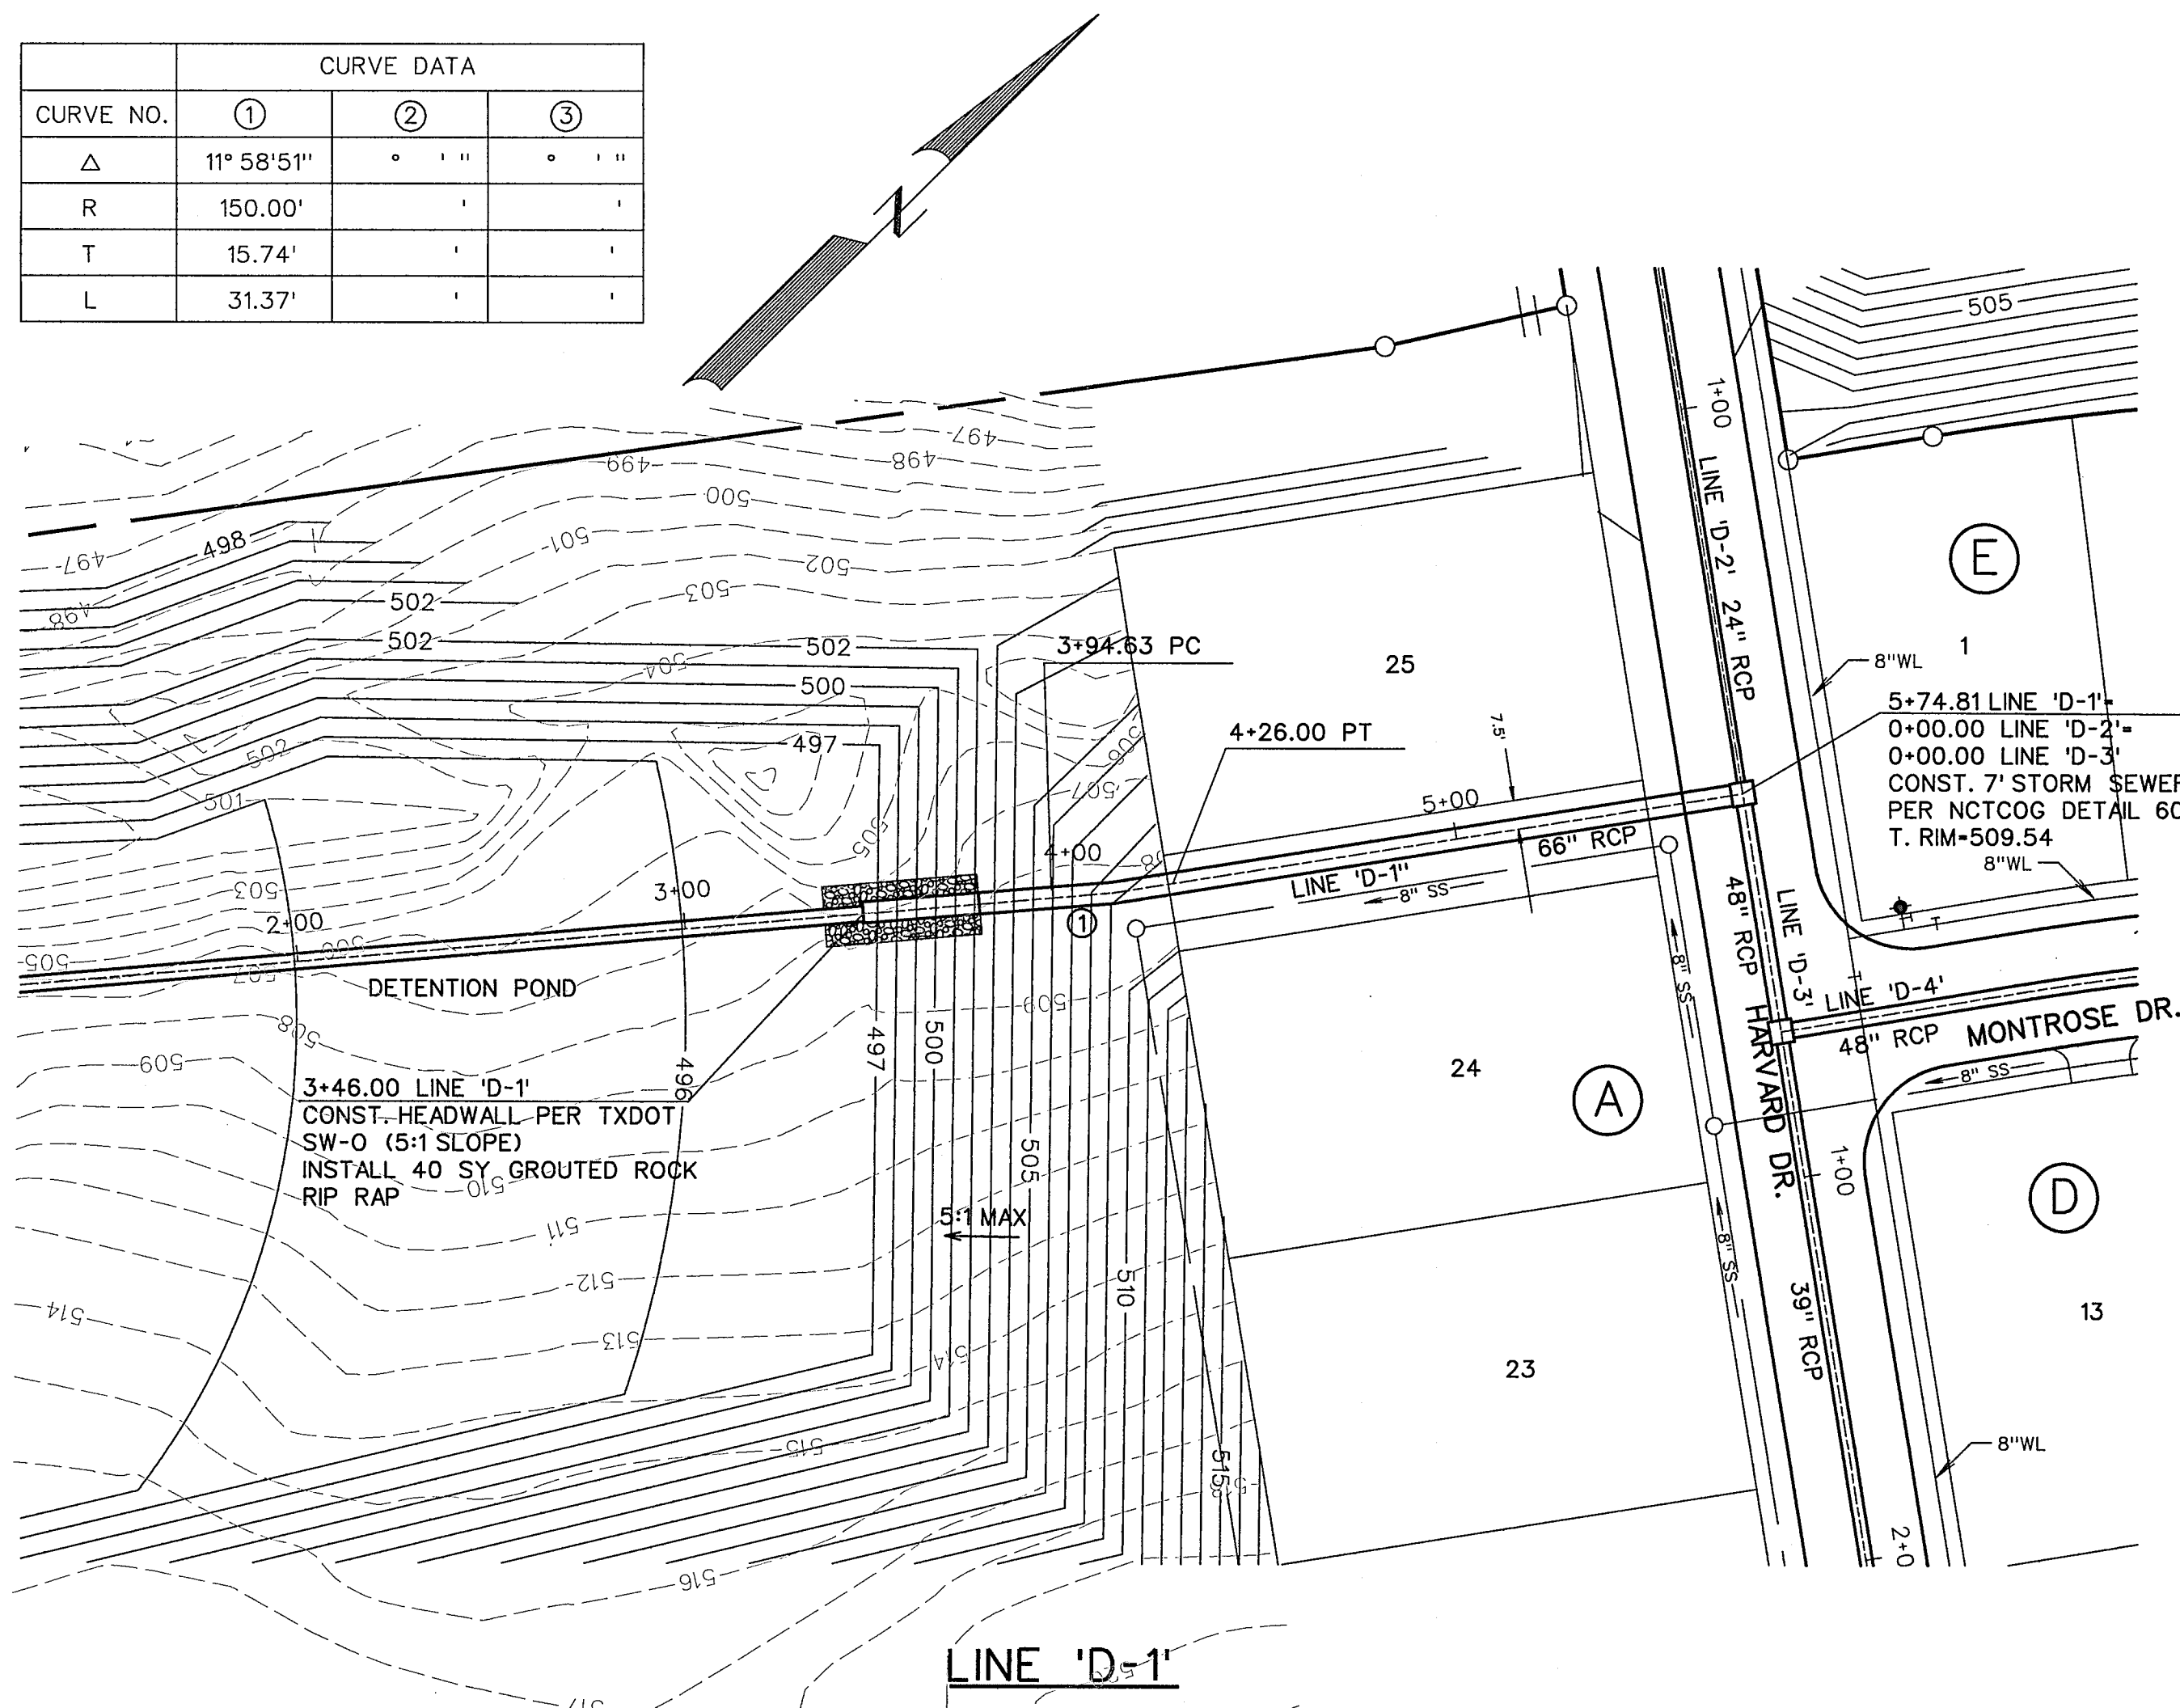

- LEGEND**
- (B) - BLOCK LABEL
 - (10) - INLET NUMBER
 - (1) - CURVE NUMBER
 - - SANITARY SEWER
 - ⊕ - WATER
 - ▬ - PROPOSED STORM SEWER
 - ▨ - EXISTING STORM SEWER

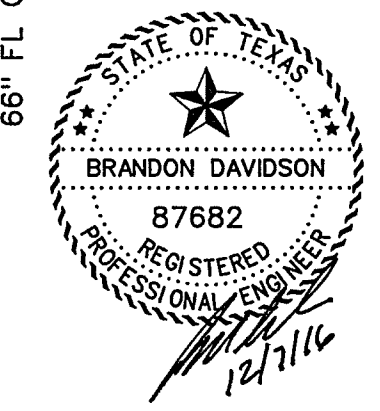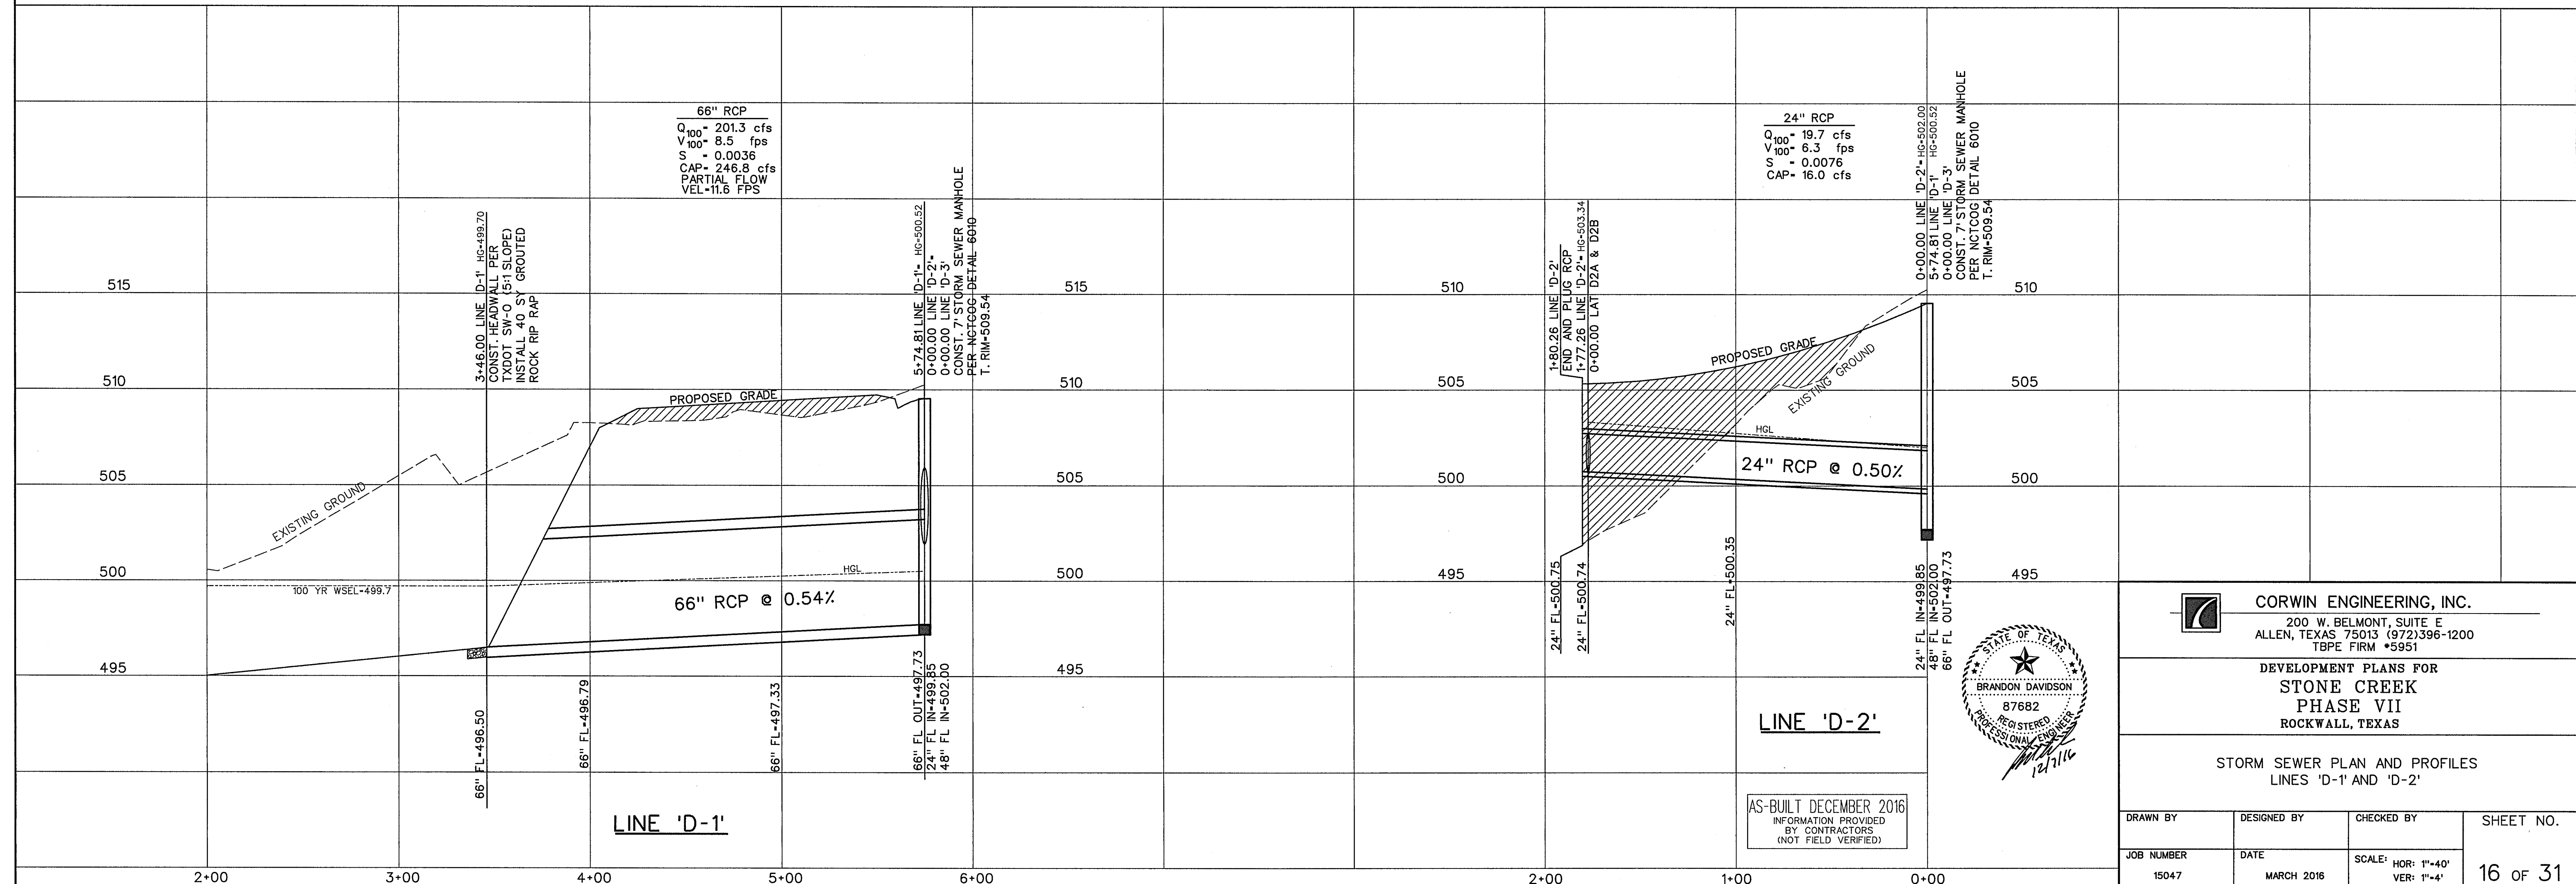

CORWIN ENGINEERING, INC.
 200 W. BELMONT, SUITE E
 ALLEN, TEXAS 75013 (972)396-1200
 TBPE FIRM #5951

DEVELOPMENT PLANS FOR
STONE CREEK
 PHASE VII
 ROCKWALL, TEXAS


STORM SEWER PLAN AND PROFILES
 LINES 'D-1' AND 'D-2'

AS-BUILT DECEMBER 2016
 INFORMATION PROVIDED
 BY CONTRACTORS
 (NOT FIELD VERIFIED)



DRAWN BY	DESIGNED BY	CHECKED BY	SHEET NO.
JOB NUMBER	DATE	SCALE: HOR: 1"=40' VER: 1"=4'	16 OF 31
15047	MARCH 2016		

CURVE DATA		
CURVE NO.	①	②
Δ	35° 11'17"	01° 44'38"
R	1150.00'	1150.00'
T	364.67'	35.00'
L	706.27'	17.50'

0 20 40 80
SCALE: 1" = 40'

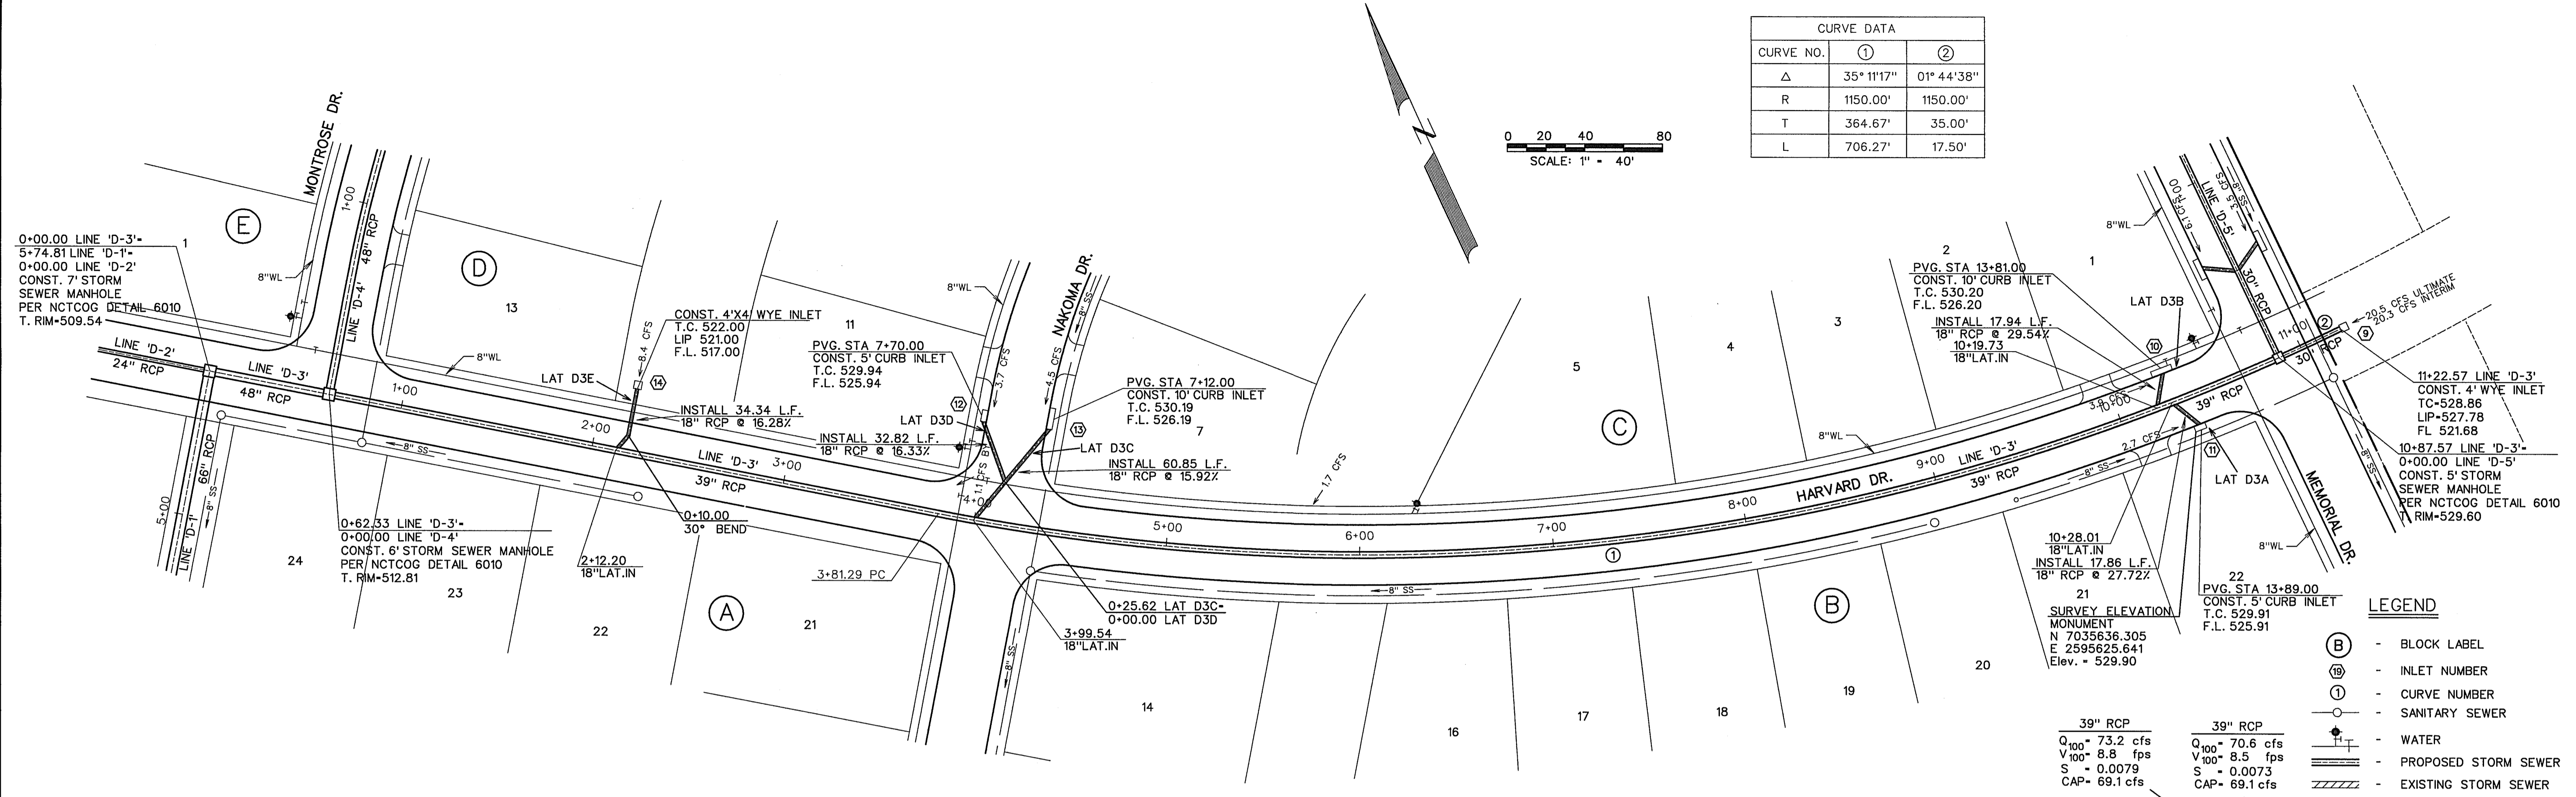

- LEGEND**
- (B) - BLOCK LABEL
 - (10) - INLET NUMBER
 - (C) - CURVE NUMBER
 - - SANITARY SEWER
 - - WATER
 - - PROPOSED STORM SEWER
 - /// - EXISTING STORM SEWER

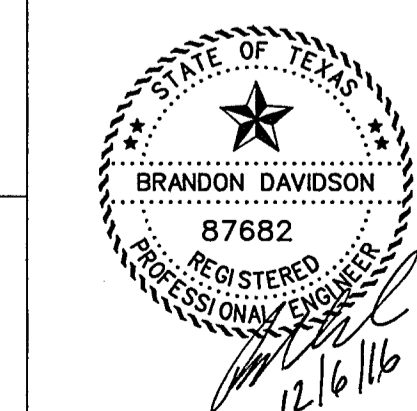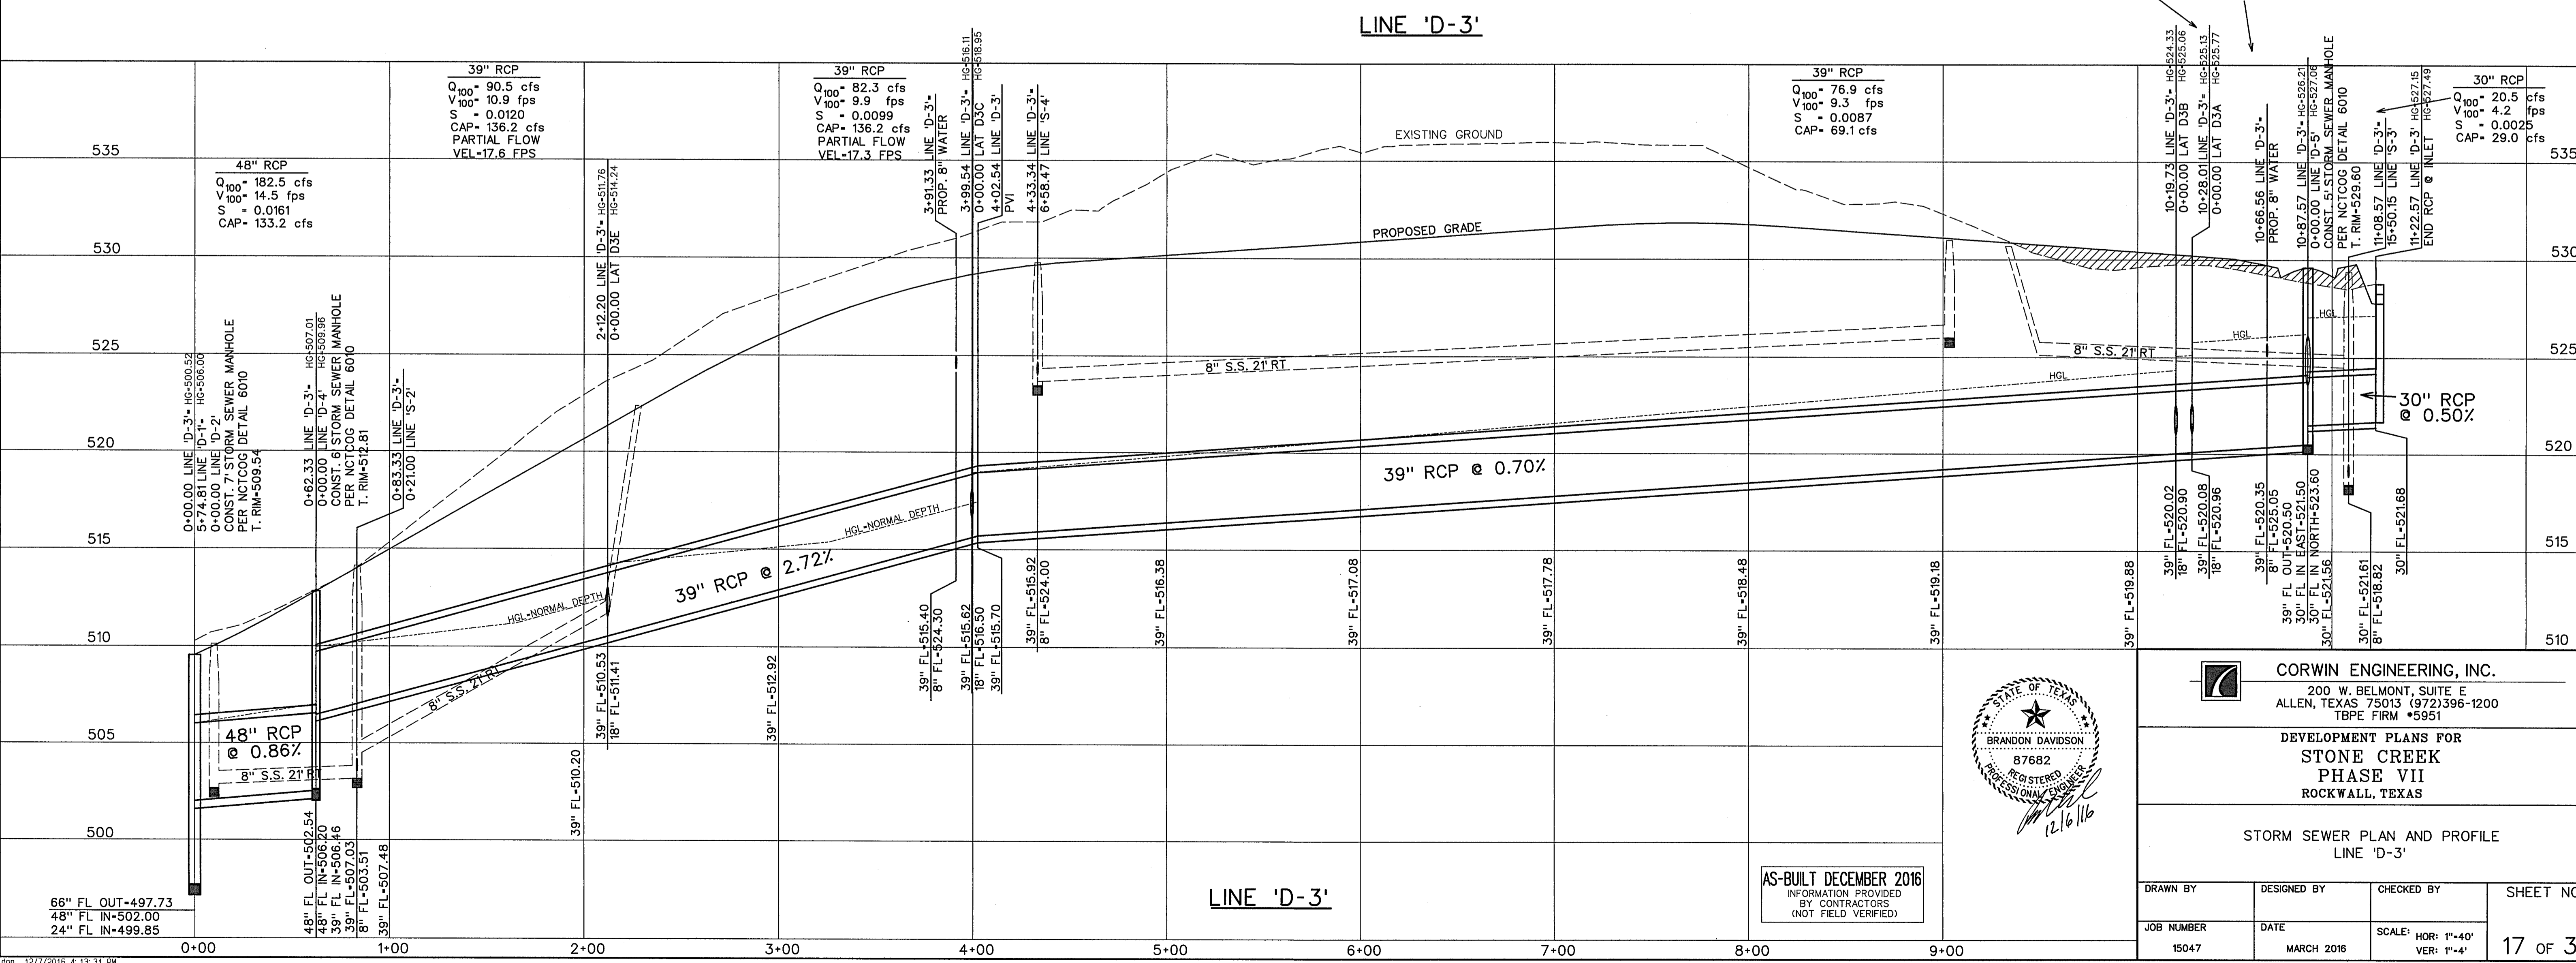

CORWIN ENGINEERING, INC.
200 W. BELMONT, SUITE E
ALLEN, TEXAS 75013 (972) 396-1200
TBPE FIRM #5951

**DEVELOPMENT PLANS FOR
STONE CREEK
PHASE VII
ROCKWALL, TEXAS**




**STORM SEWER PLAN AND PROFILE
LINE 'D-3'**

DRAWN BY	DESIGNED BY	CHECKED BY	SHEET NO.
JOB NUMBER	DATE	SCALE: HOR: 1"=40' VER: 1"=4'	17 OF 31

AS-BUILT DECEMBER 2016
INFORMATION PROVIDED
BY CONTRACTORS
(NOT FIELD VERIFIED)

CURVE DATA	
CURVE NO.	①
Δ	35° 18' 35"
R	700.00'
T	222.79'
L	431.39'


0 20 40 80
SCALE: 1" = 40'

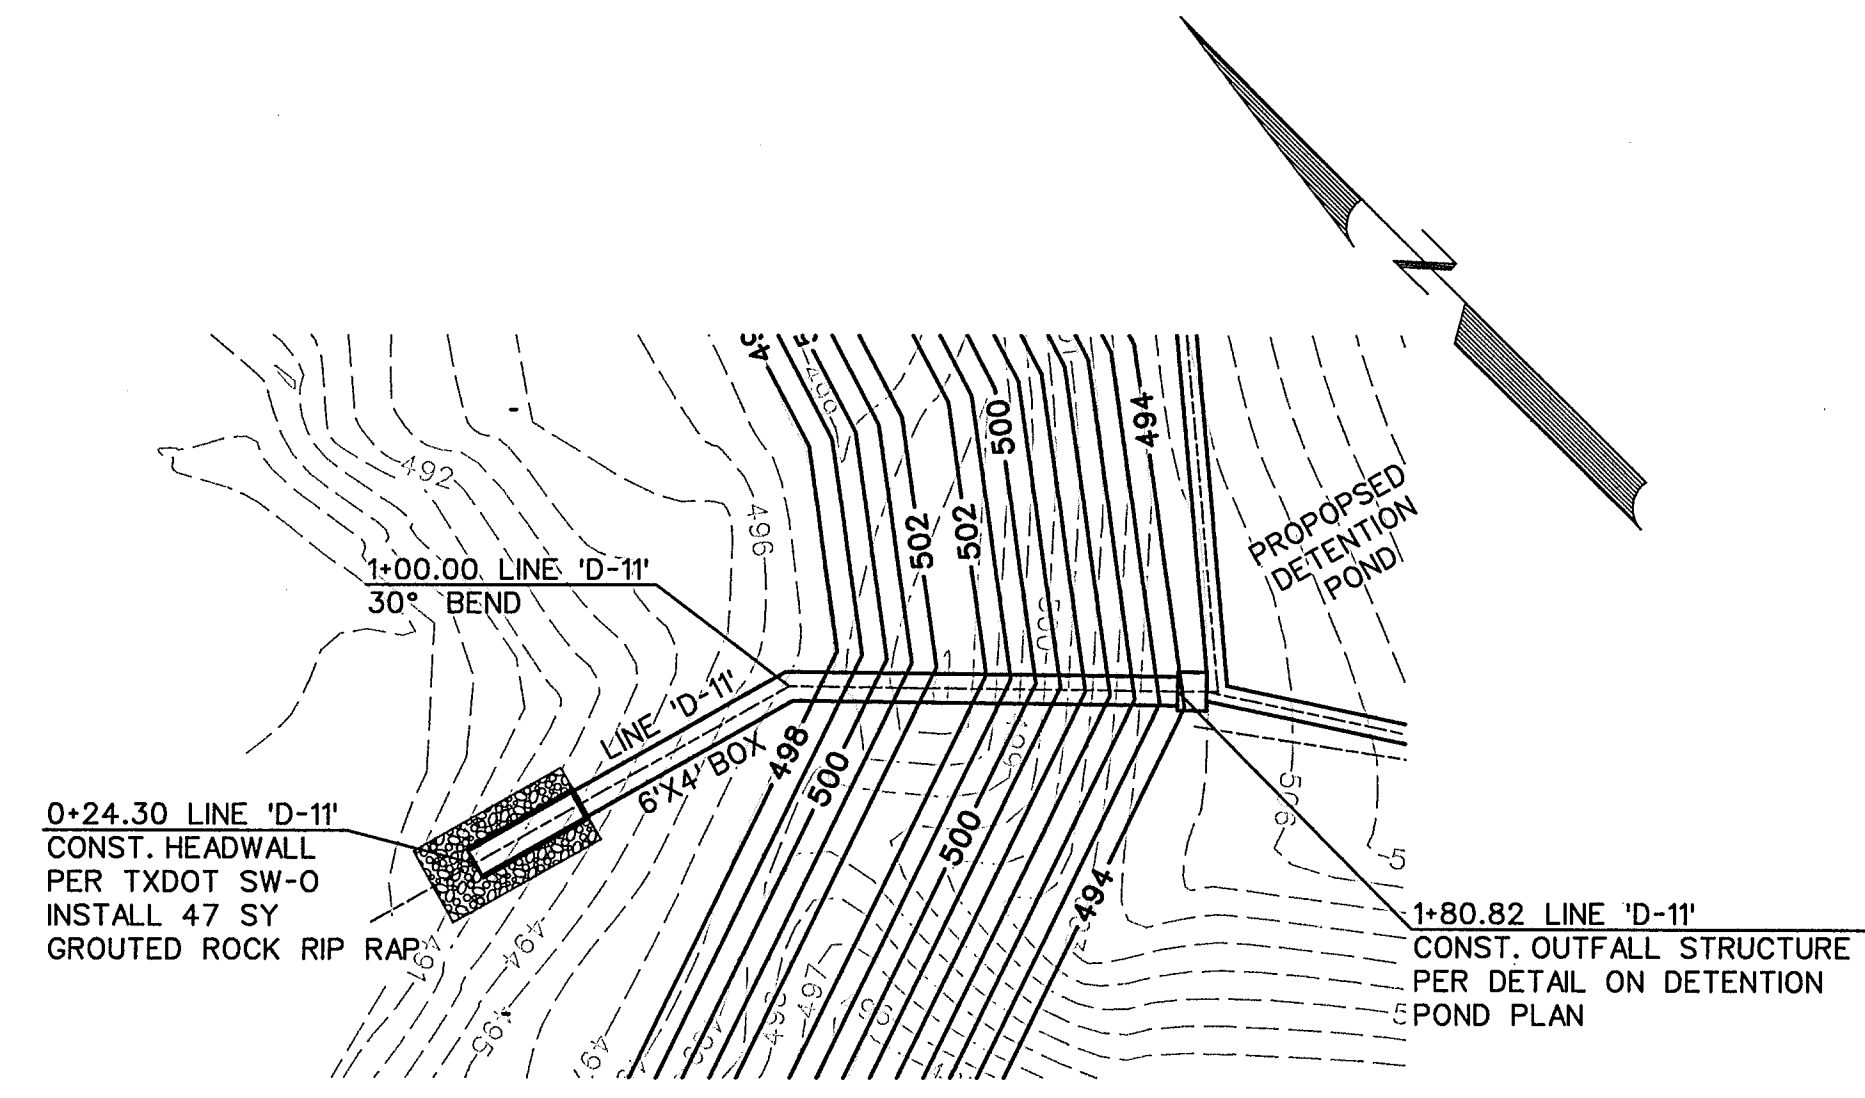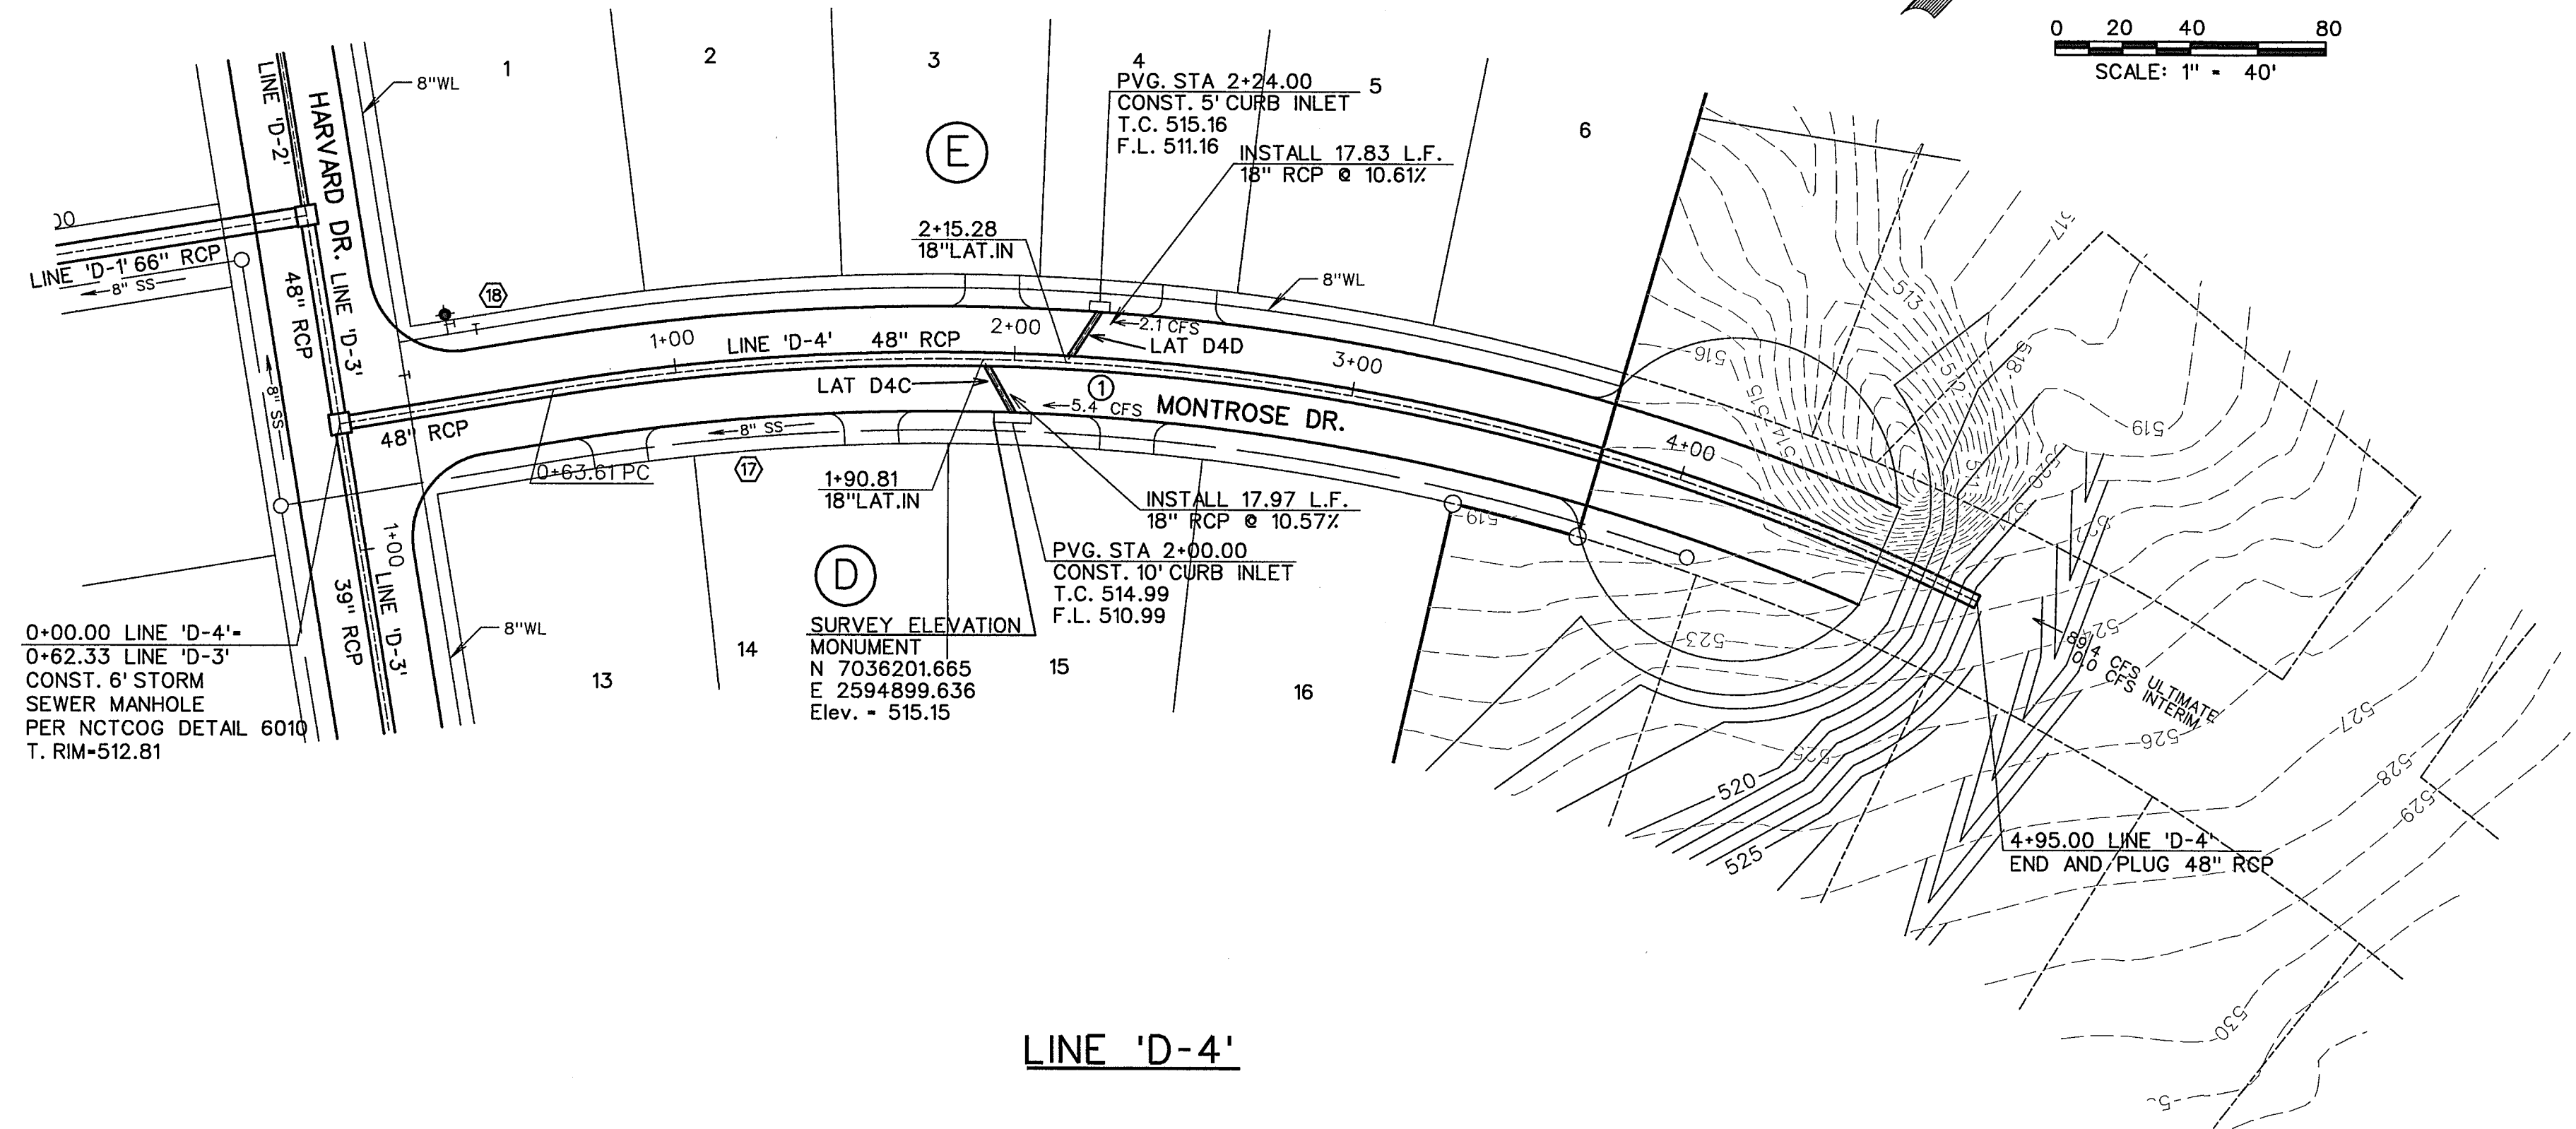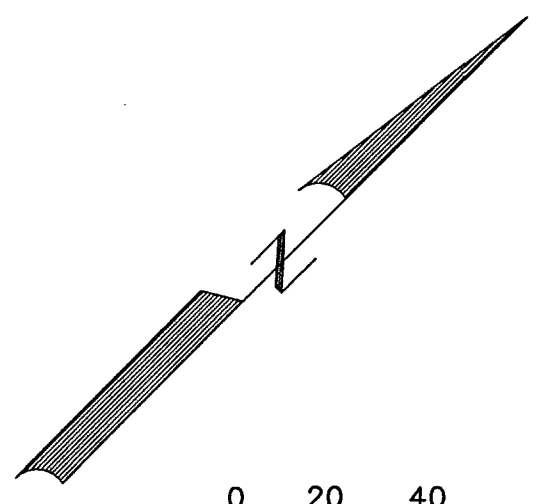

- LEGEND**
- Ⓟ - BLOCK LABEL
 - Ⓢ - INLET NUMBER
 - ① - CURVE NUMBER
 - - SANITARY SEWER
 - ⊕ - WATER
 - ▬ - PROPOSED STORM SEWER
 - ▬▬▬ - EXISTING STORM SEWER

LINE 'D-4'

LINE 'D-11'

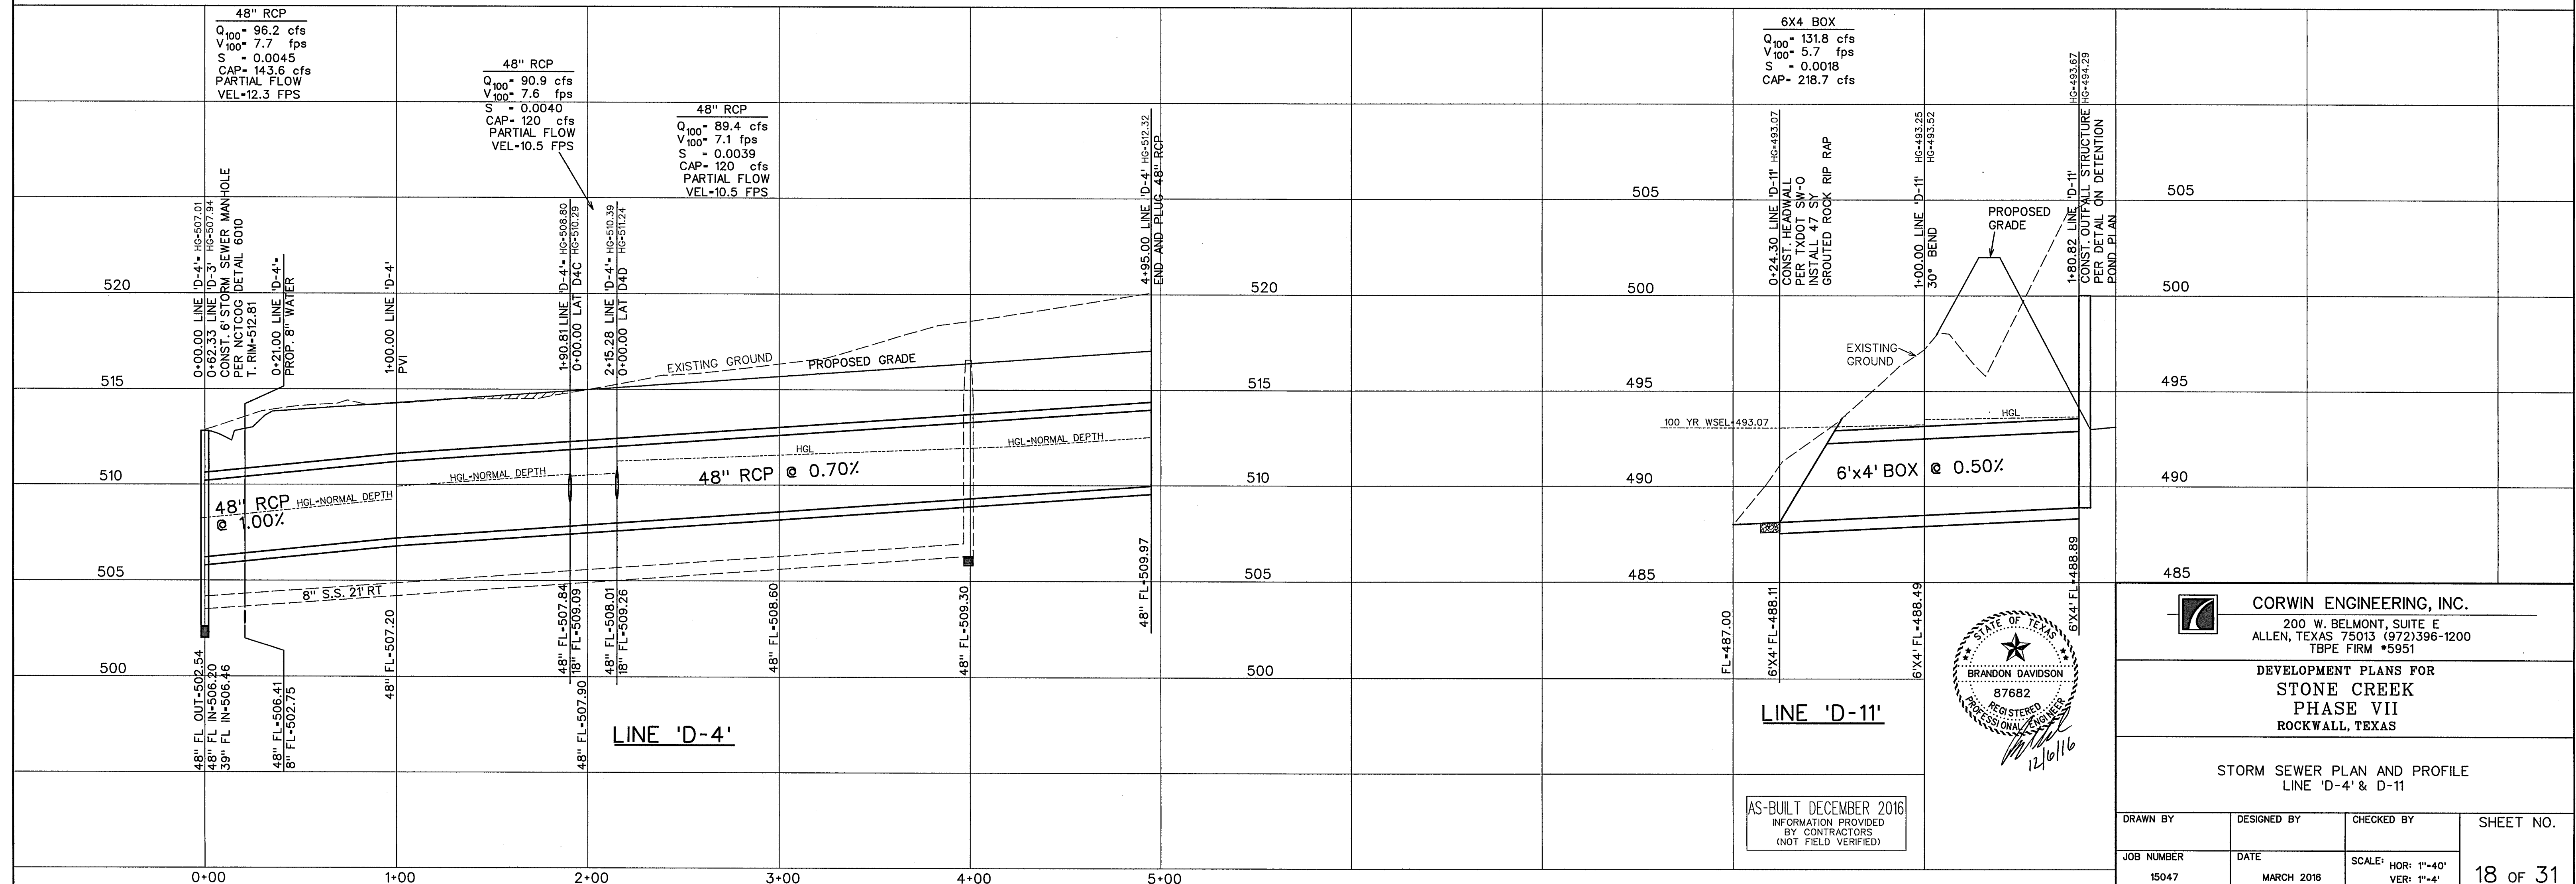

LINE 'D-4'

LINE 'D-11'

AS-BUILT DECEMBER 2016
INFORMATION PROVIDED
BY CONTRACTORS
(NOT FIELD VERIFIED)





CORWIN ENGINEERING, INC.
200 W. BELMONT, SUITE E
ALLEN, TEXAS 75013 (972)396-1200
TBPE FIRM #5951

DEVELOPMENT PLANS FOR
**STONE CREEK
PHASE VII**
ROCKWALL, TEXAS


STORM SEWER PLAN AND PROFILE
LINE 'D-4' & D-11

DRAWN BY	DESIGNED BY	CHECKED BY	SHEET NO.
JOB NUMBER	DATE	SCALE: HOR: 1"=40' VER: 1"=4'	18 OF 31
15047	MARCH 2016		

CURVE DATA			
CURVE NO.	①	②	③
Δ	61° 55' 29"	30° 27' 45"	" "
R	65.00'	65.00'	" "
T	39.00'	17.70'	" "
L	70.25'	34.56'	" "

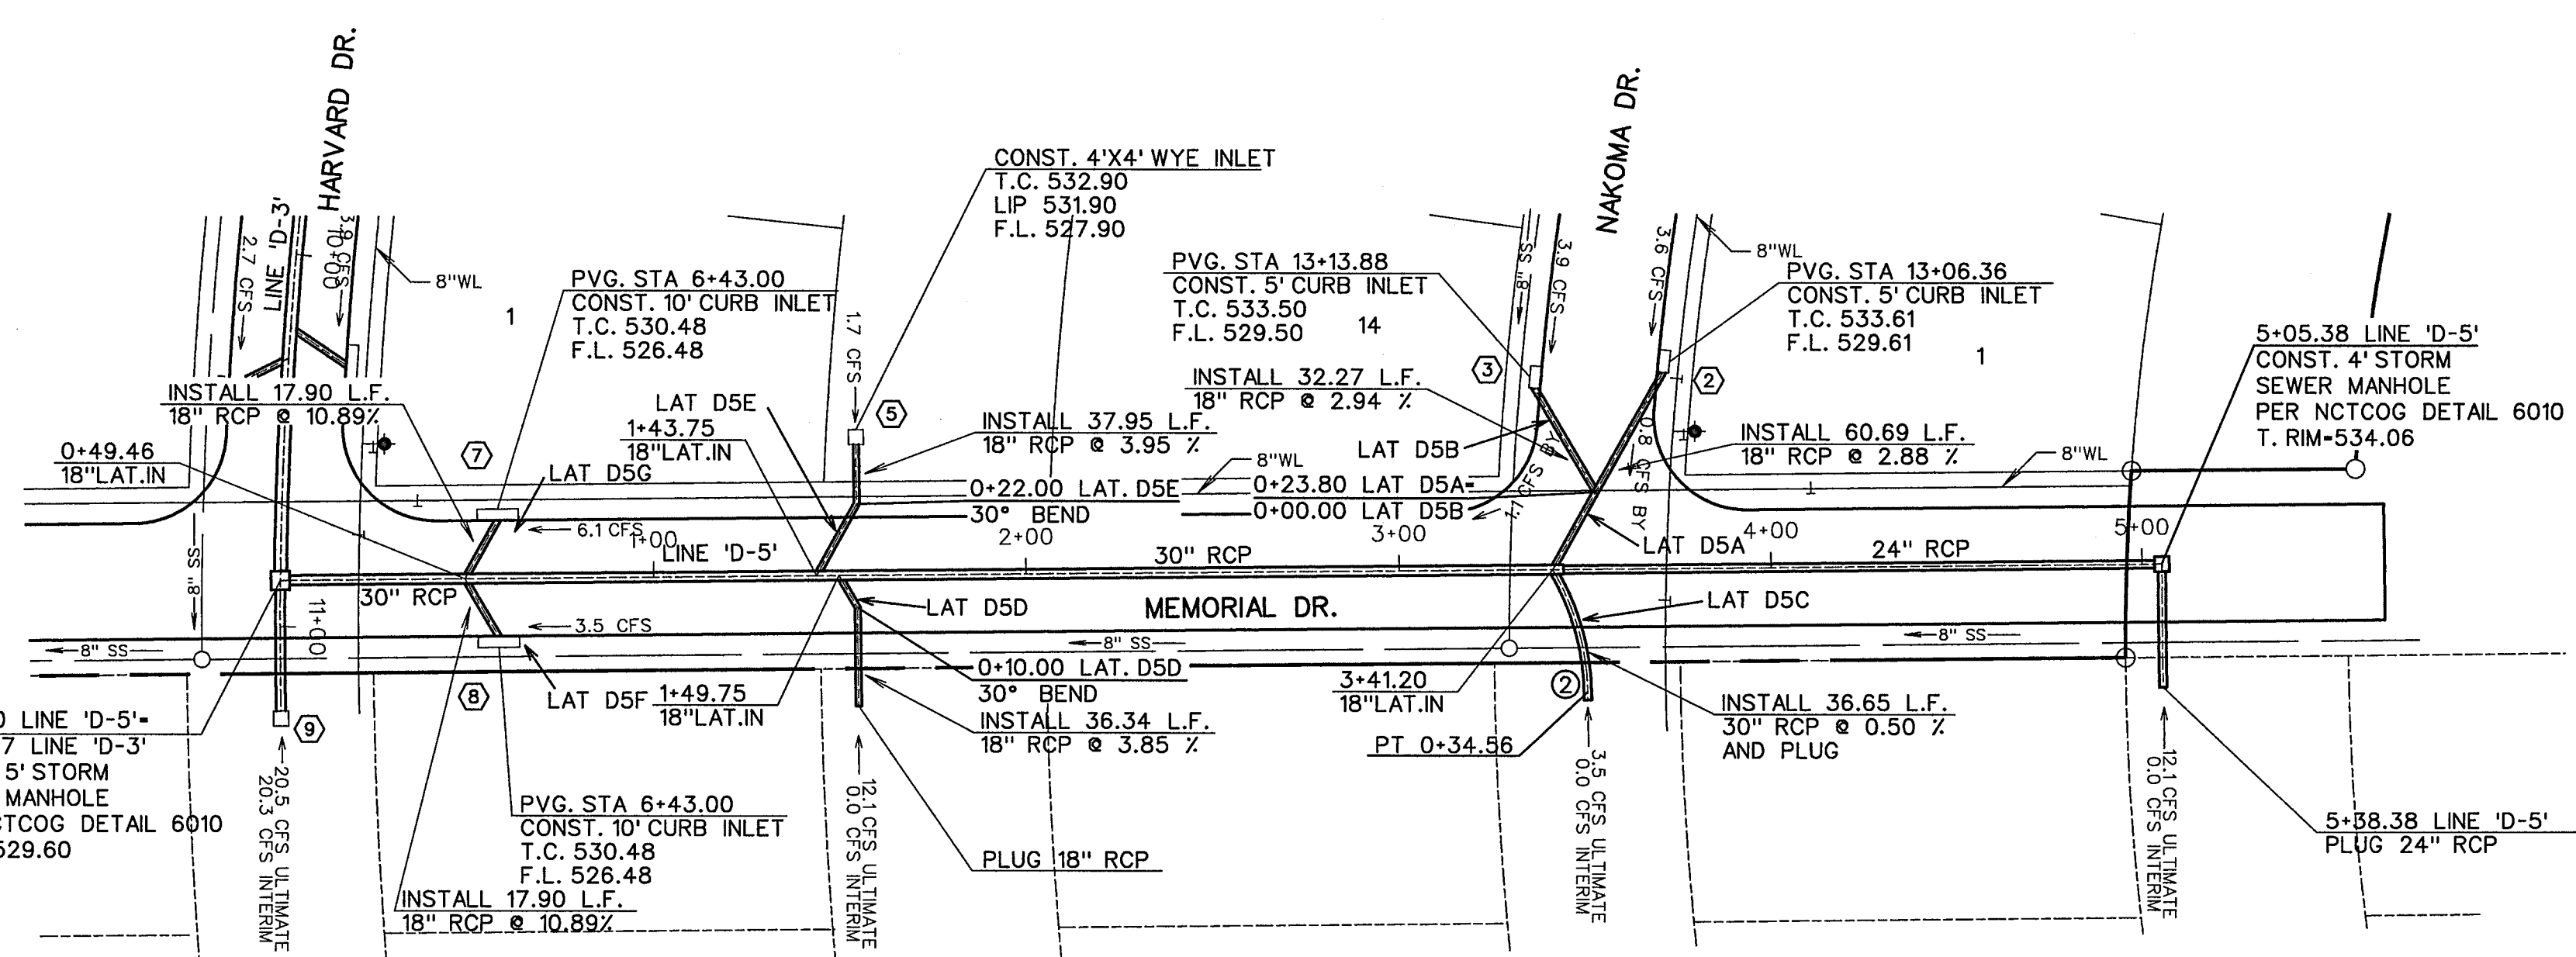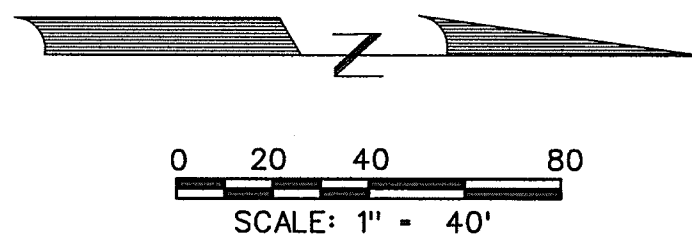


LINE 'D-5'

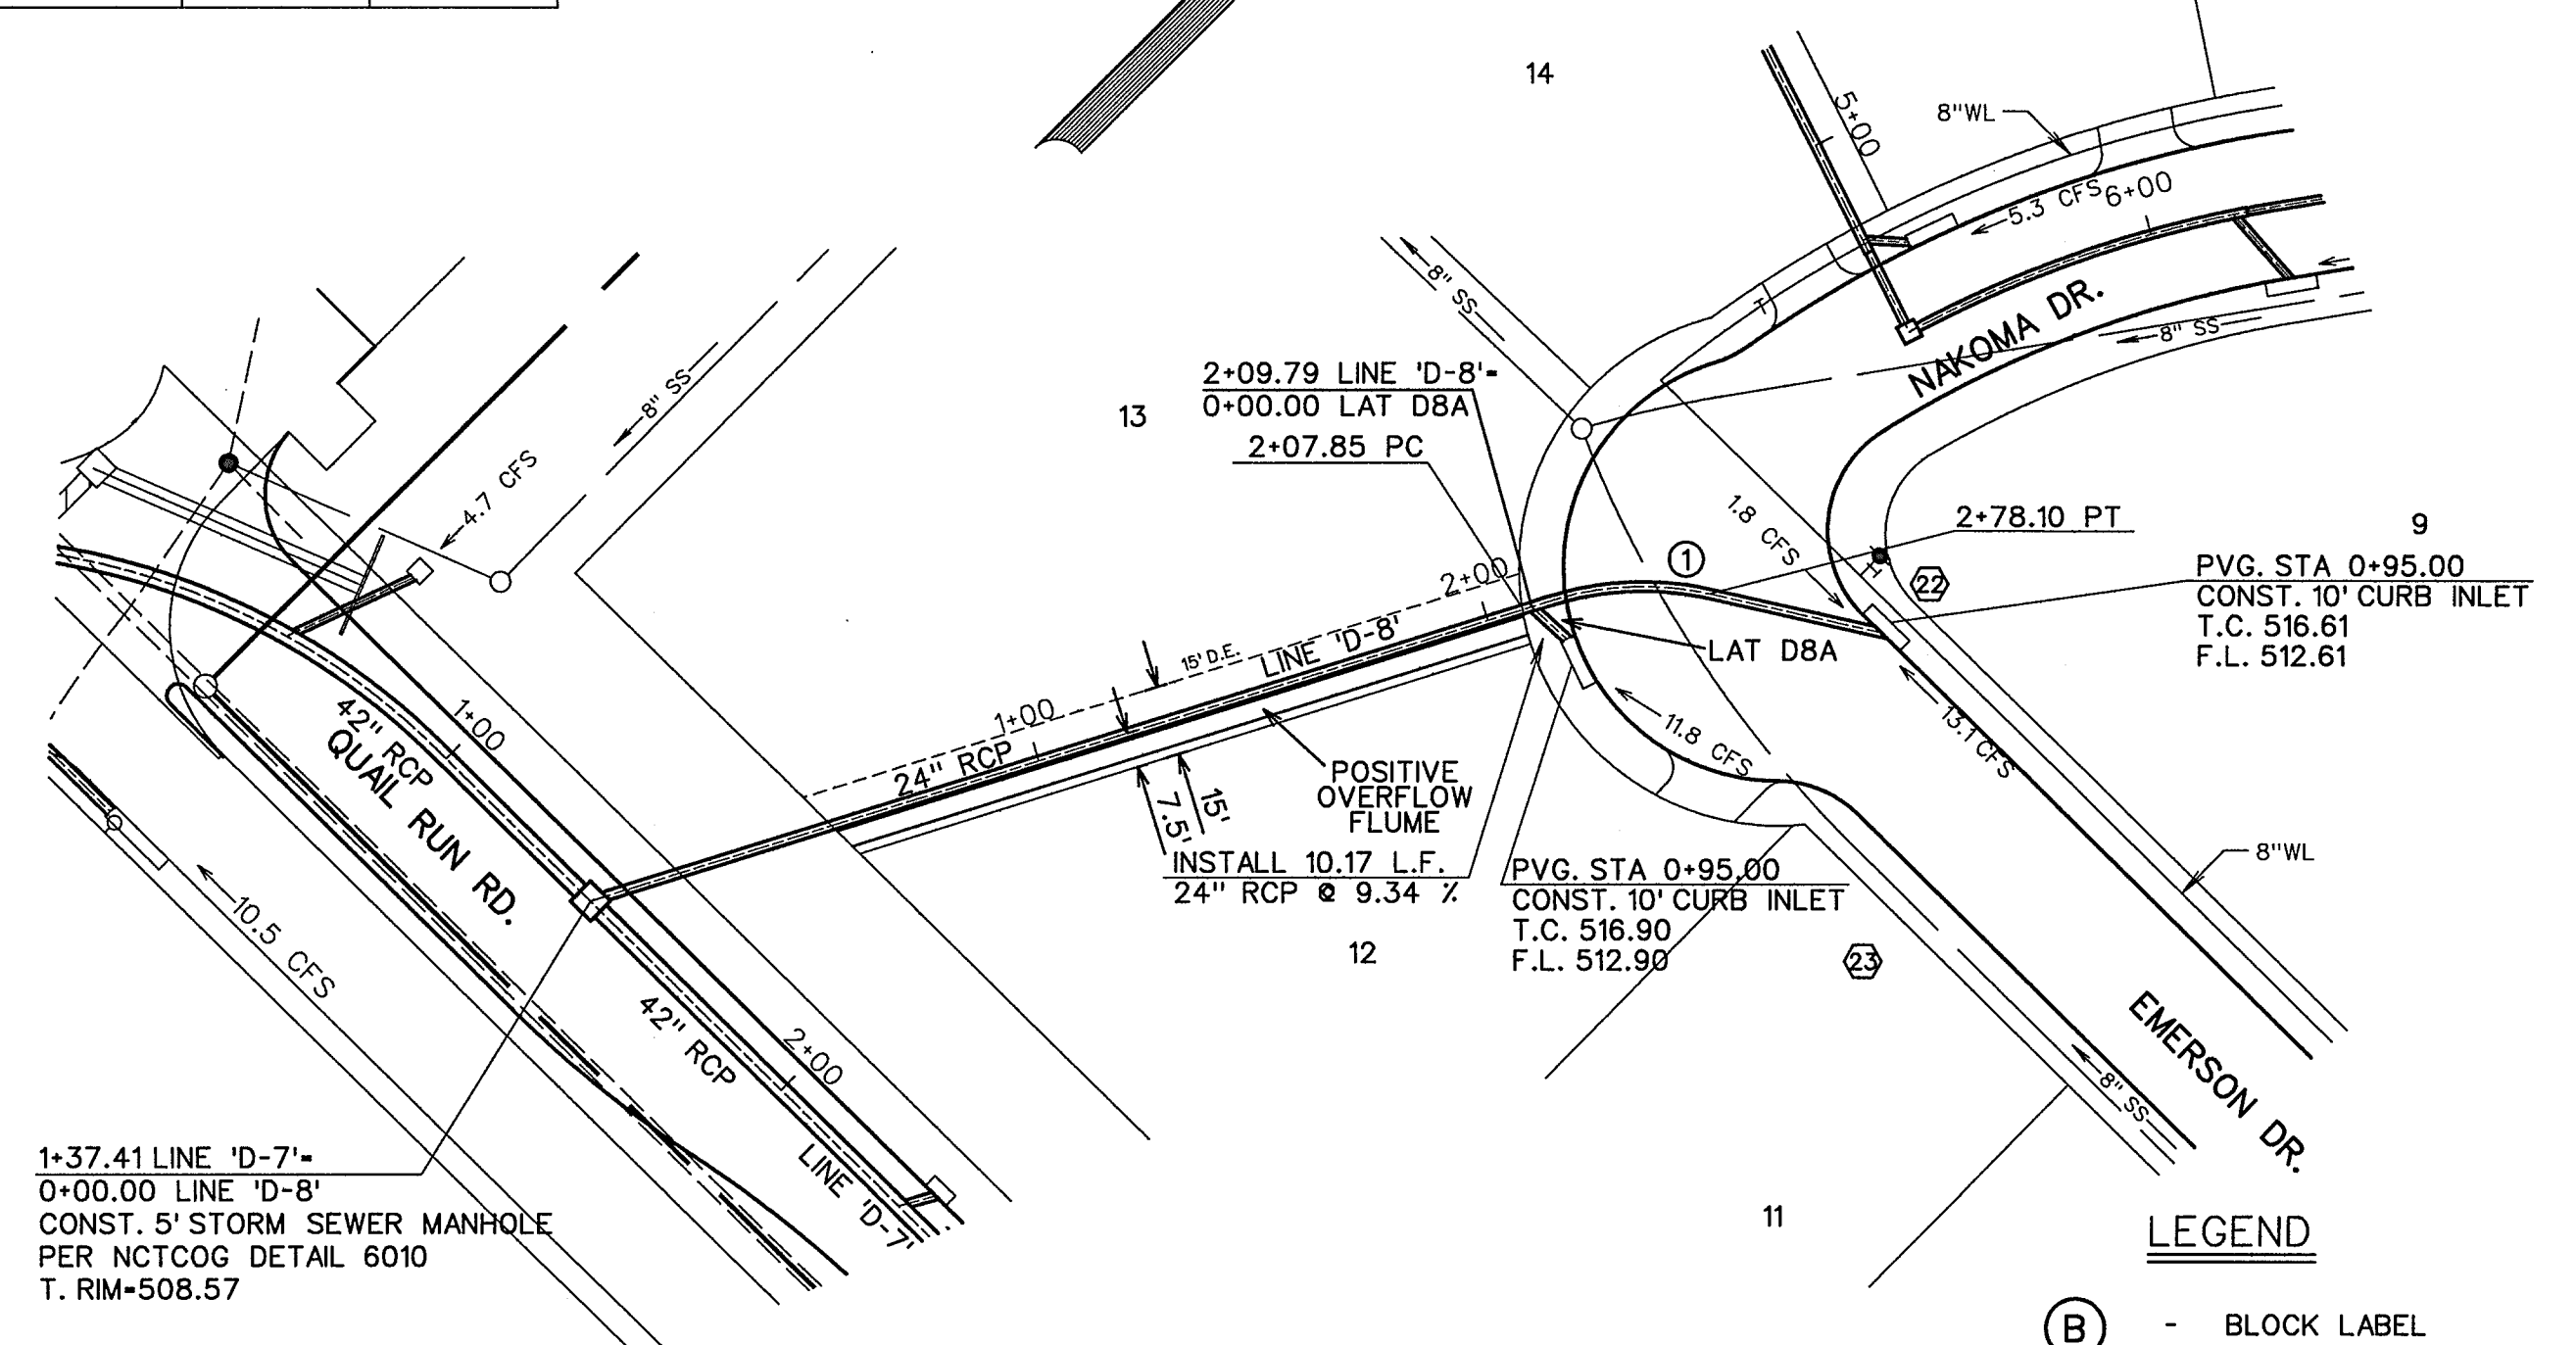

LINE 'D-8'


- LEGEND**
- (B) - BLOCK LABEL
 - (IN) - INLET NUMBER
 - (C) - CURVE NUMBER
 - - SANITARY SEWER
 - ⊕ - WATER
 - ▬ - PROPOSED STORM SEWER
 - ▨ - EXISTING STORM SEWER

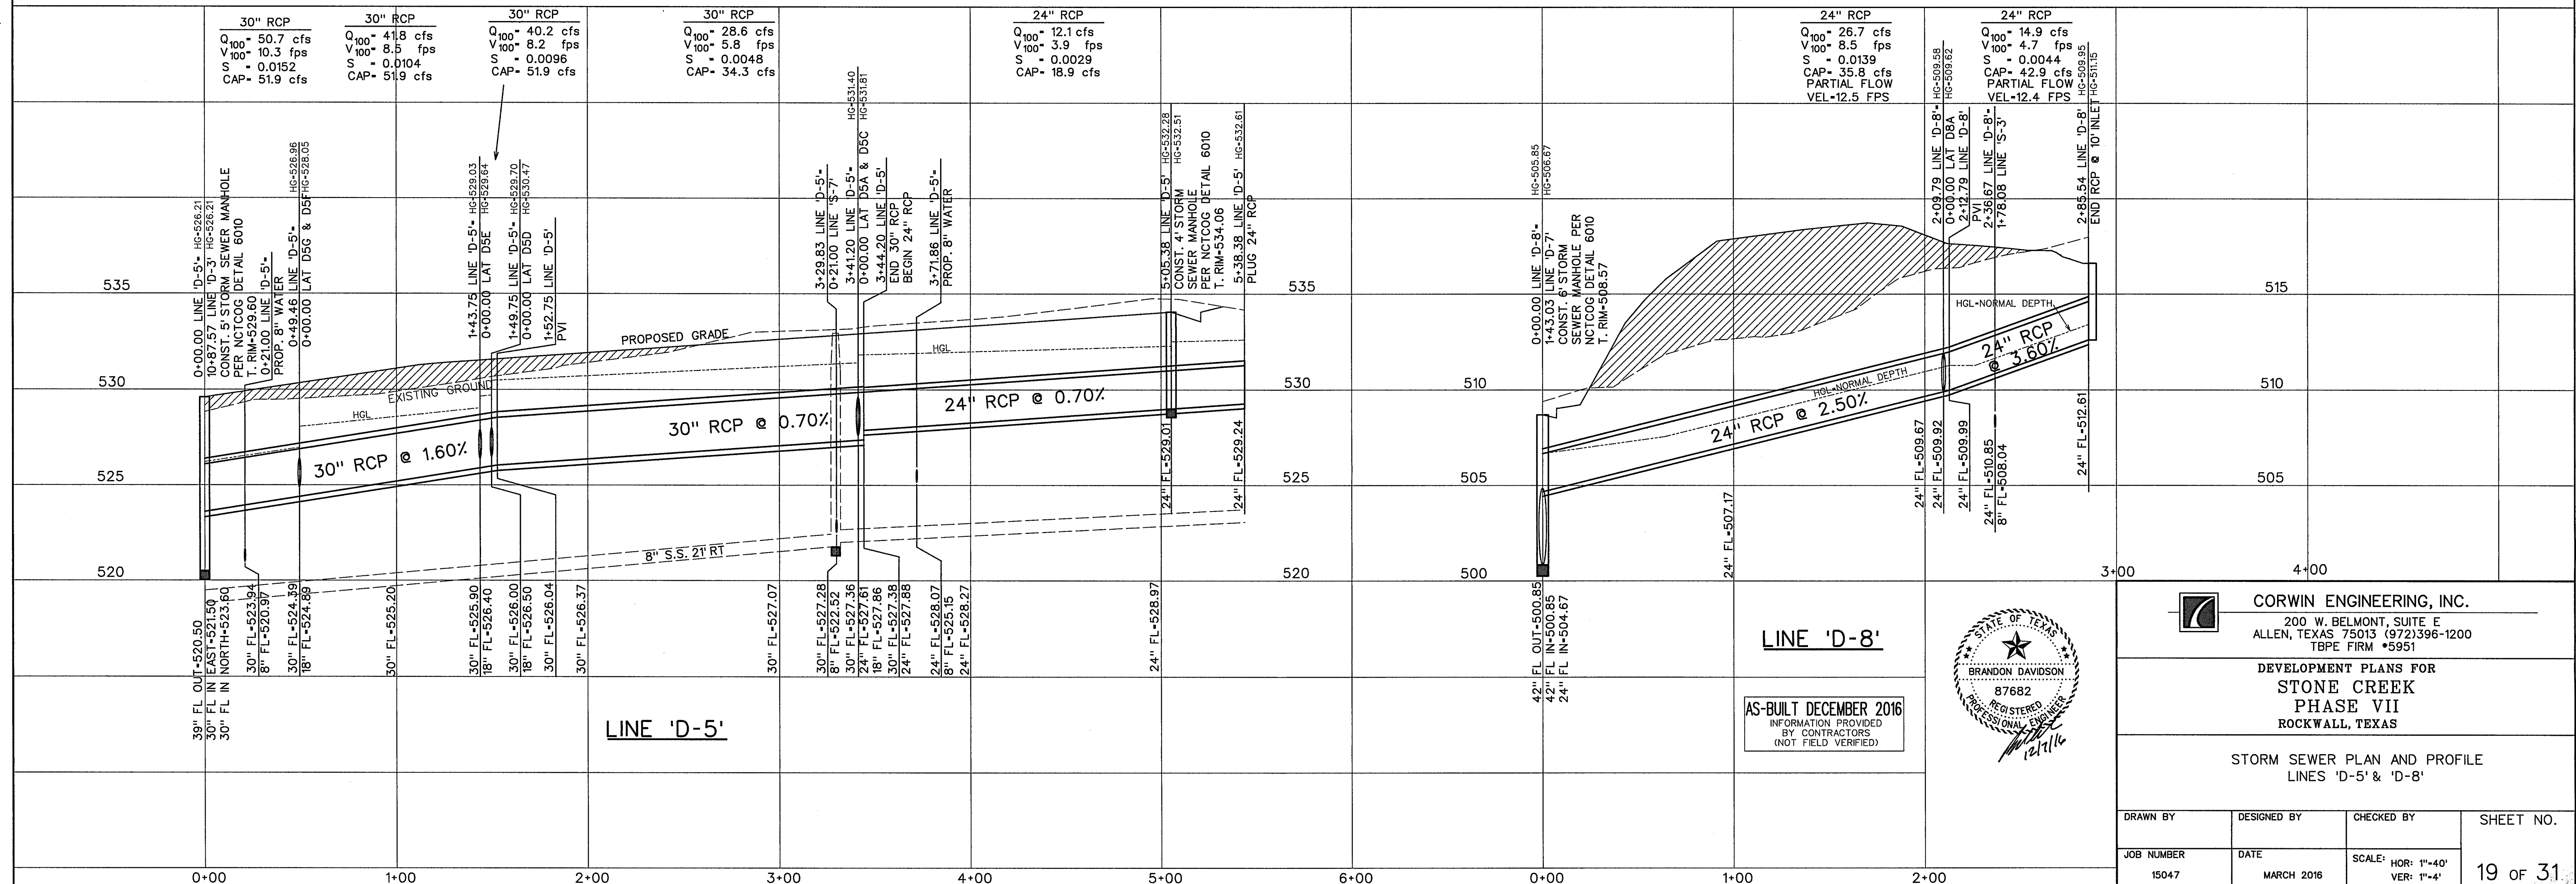

LINE 'D-5'

LINE 'D-8'

AS-BUILT DECEMBER 2016
INFORMATION PROVIDED
BY CONTRACTORS
(NOT FIELD VERIFIED)

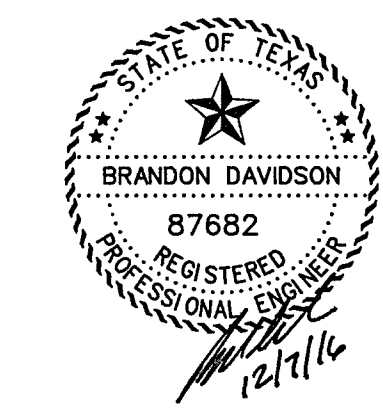


CORWIN ENGINEERING, INC.
200 W. BELMONT, SUITE E
ALLEN, TEXAS 75013 (972) 396-1200
TBPE FIRM #5951


DEVELOPMENT PLANS FOR
STONE CREEK
PHASE VII
ROCKWALL, TEXAS

STORM SEWER PLAN AND PROFILE
LINES 'D-5' & 'D-8'

DRAWN BY	DESIGNED BY	CHECKED BY	SHEET NO.
JOB NUMBER	DATE	SCALE: HOR: 1"=40' VER: 1"=4'	19 of 31
15047	MARCH 2016		

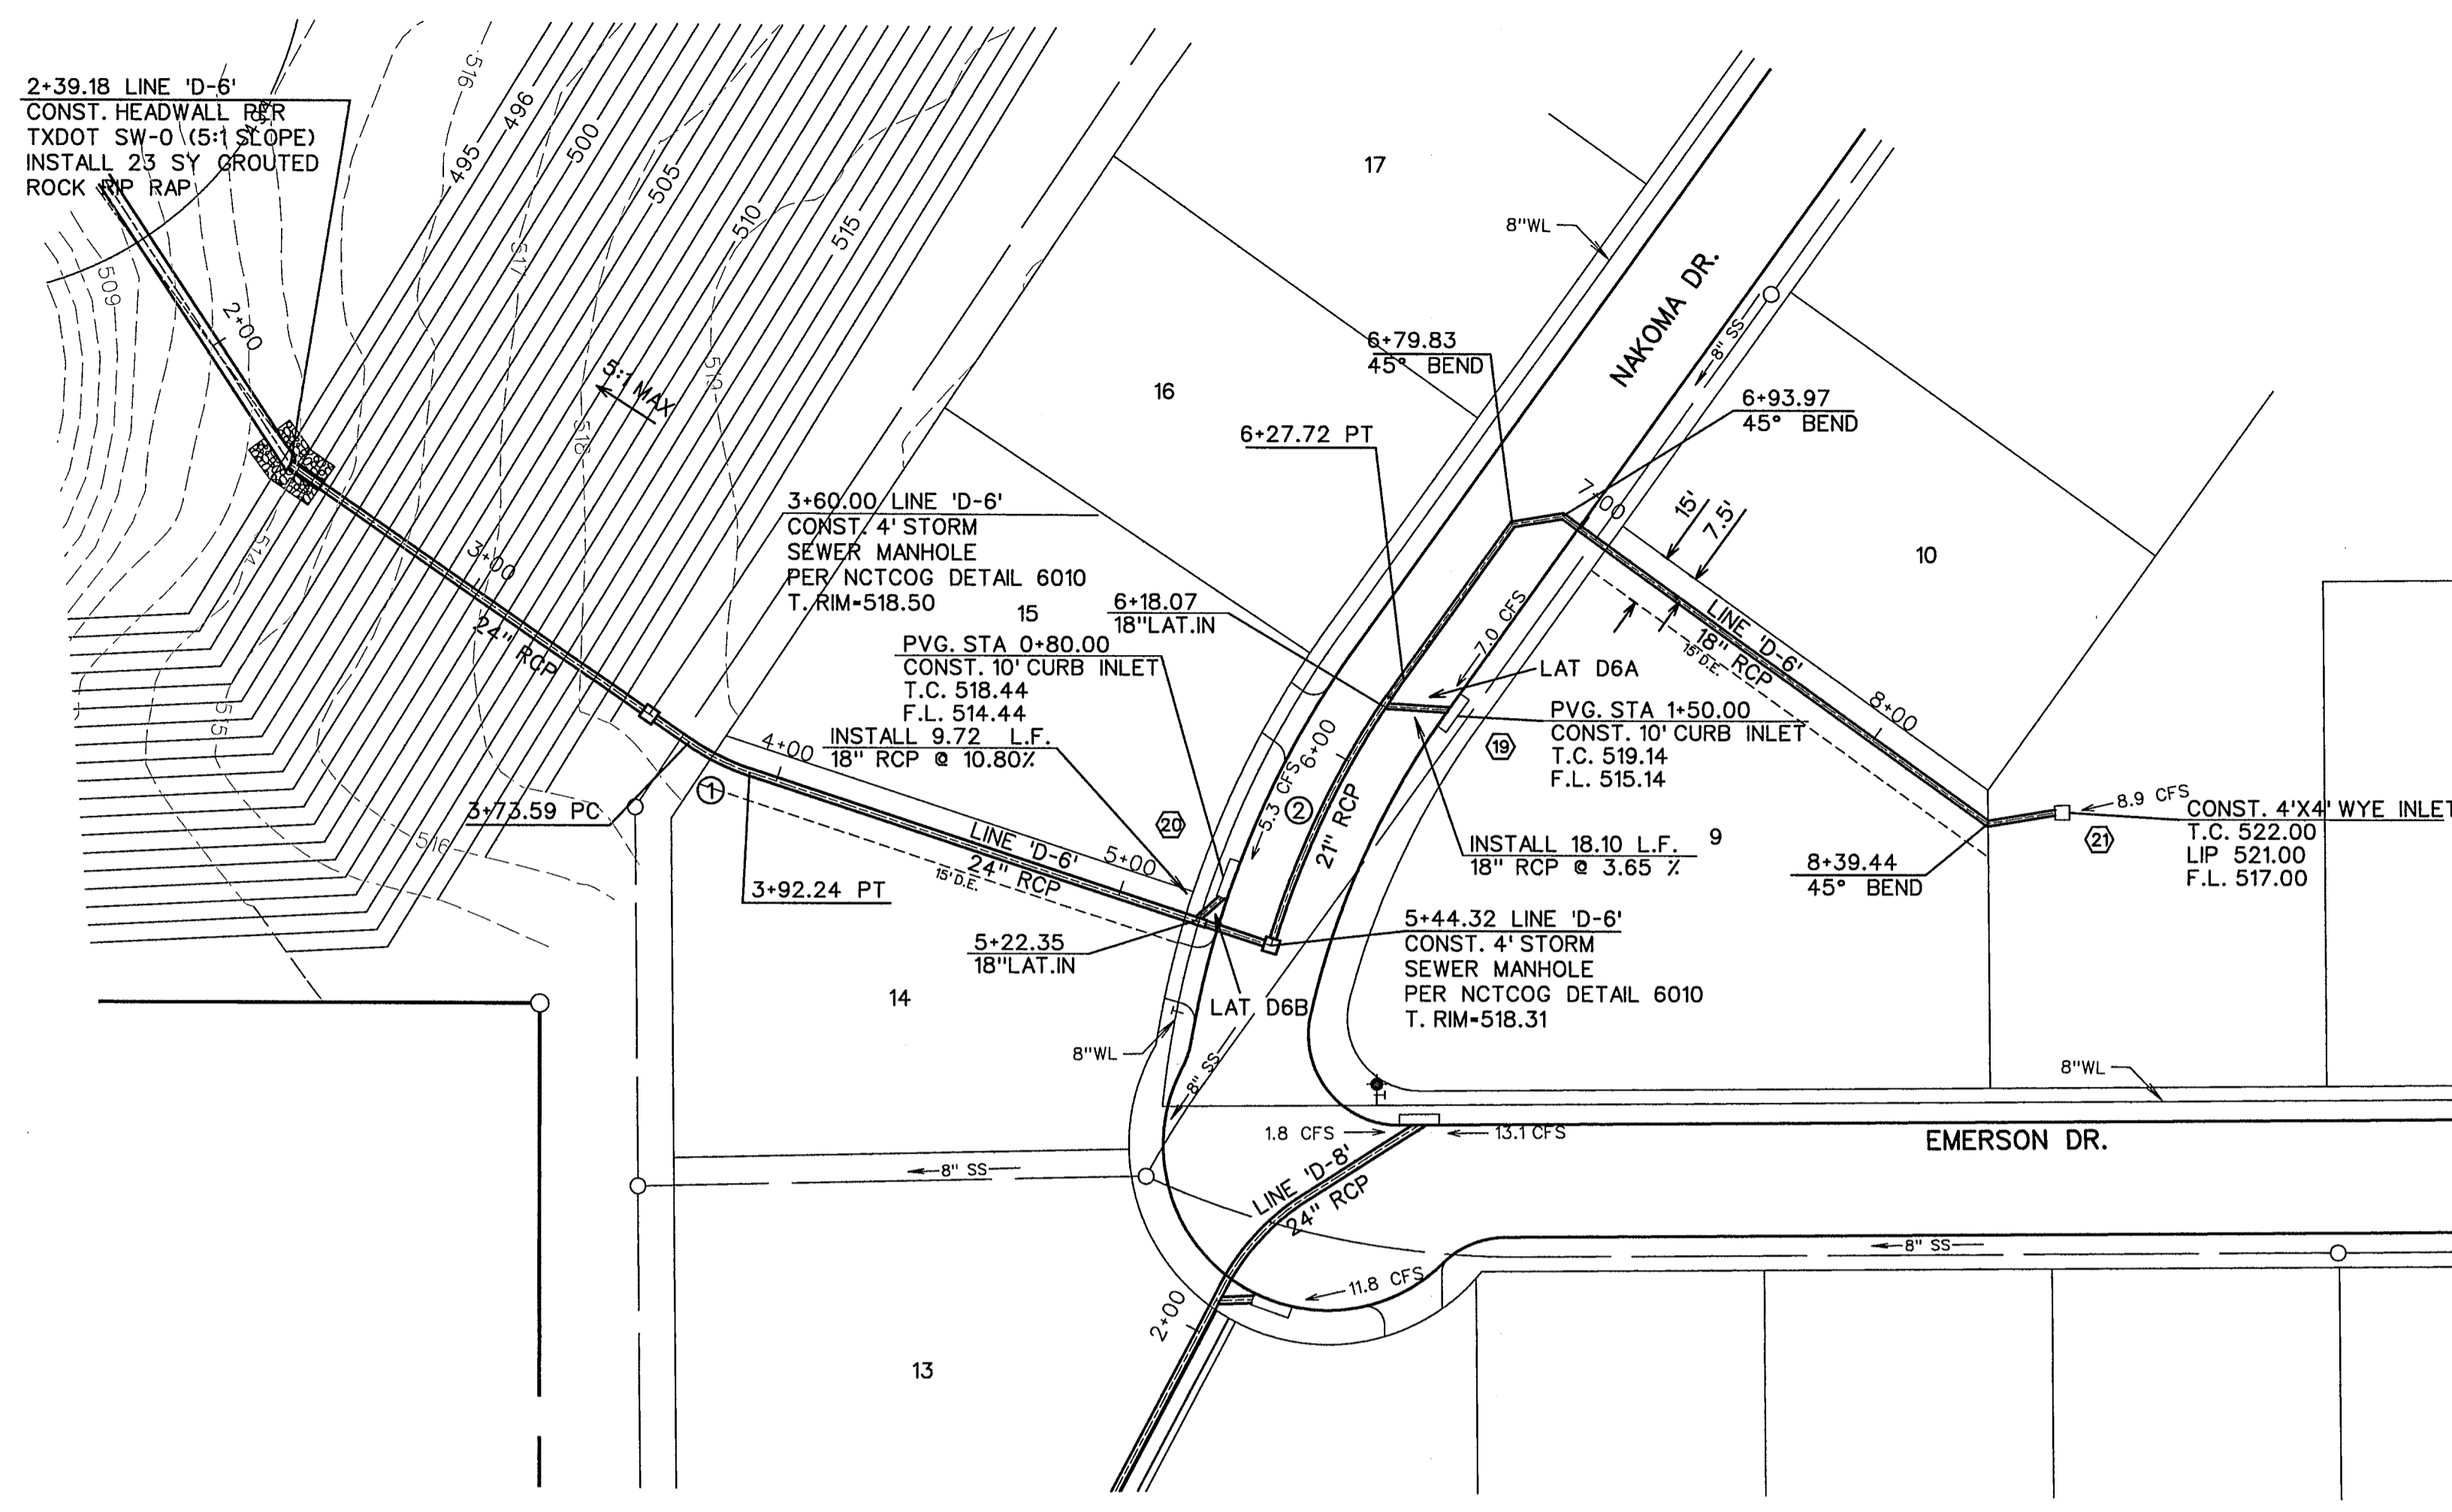


CURVE DATA			
CURVE NO.	①	②	③
Δ	16° 26' 23"	19° 06' 46"	29° 39' 00"
R	65.00'	250.00'	65.00'
T	9.39'	42.09'	17.20'
L	18.65'	83.39'	33.64'

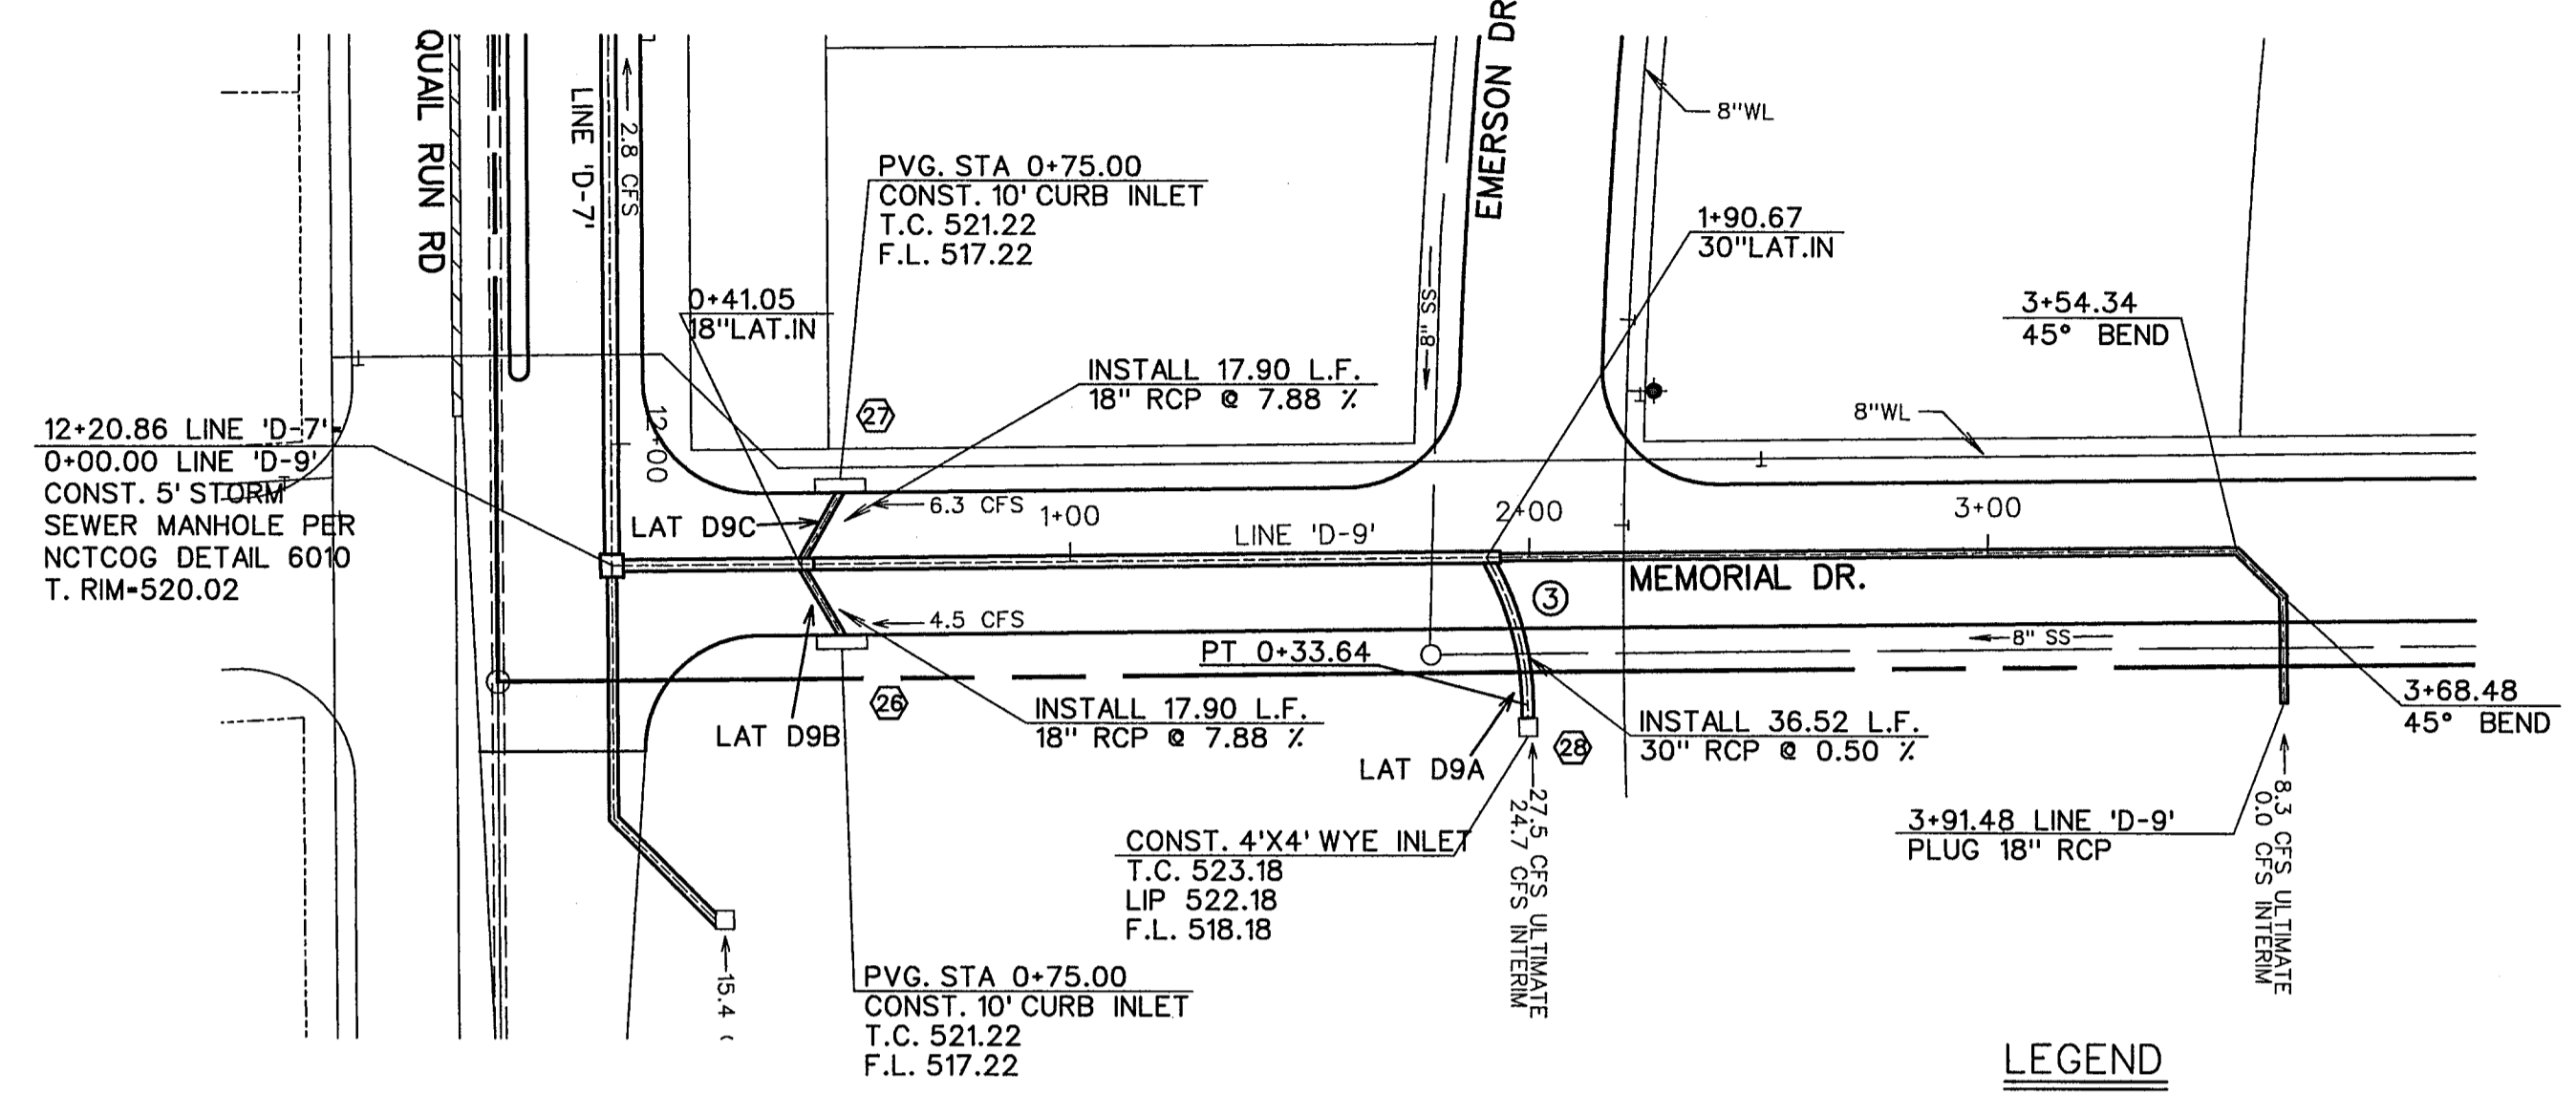

- LEGEND**
- ⊙ - BLOCK LABEL
 - ⊕ - INLET NUMBER
 - ① - CURVE NUMBER
 - - SANITARY SEWER
 - ⊕ - WATER
 - ▬ - PROPOSED STORM SEWER
 - ▨ - EXISTING STORM SEWER

LINE 'D-6'

LINE 'D-9'

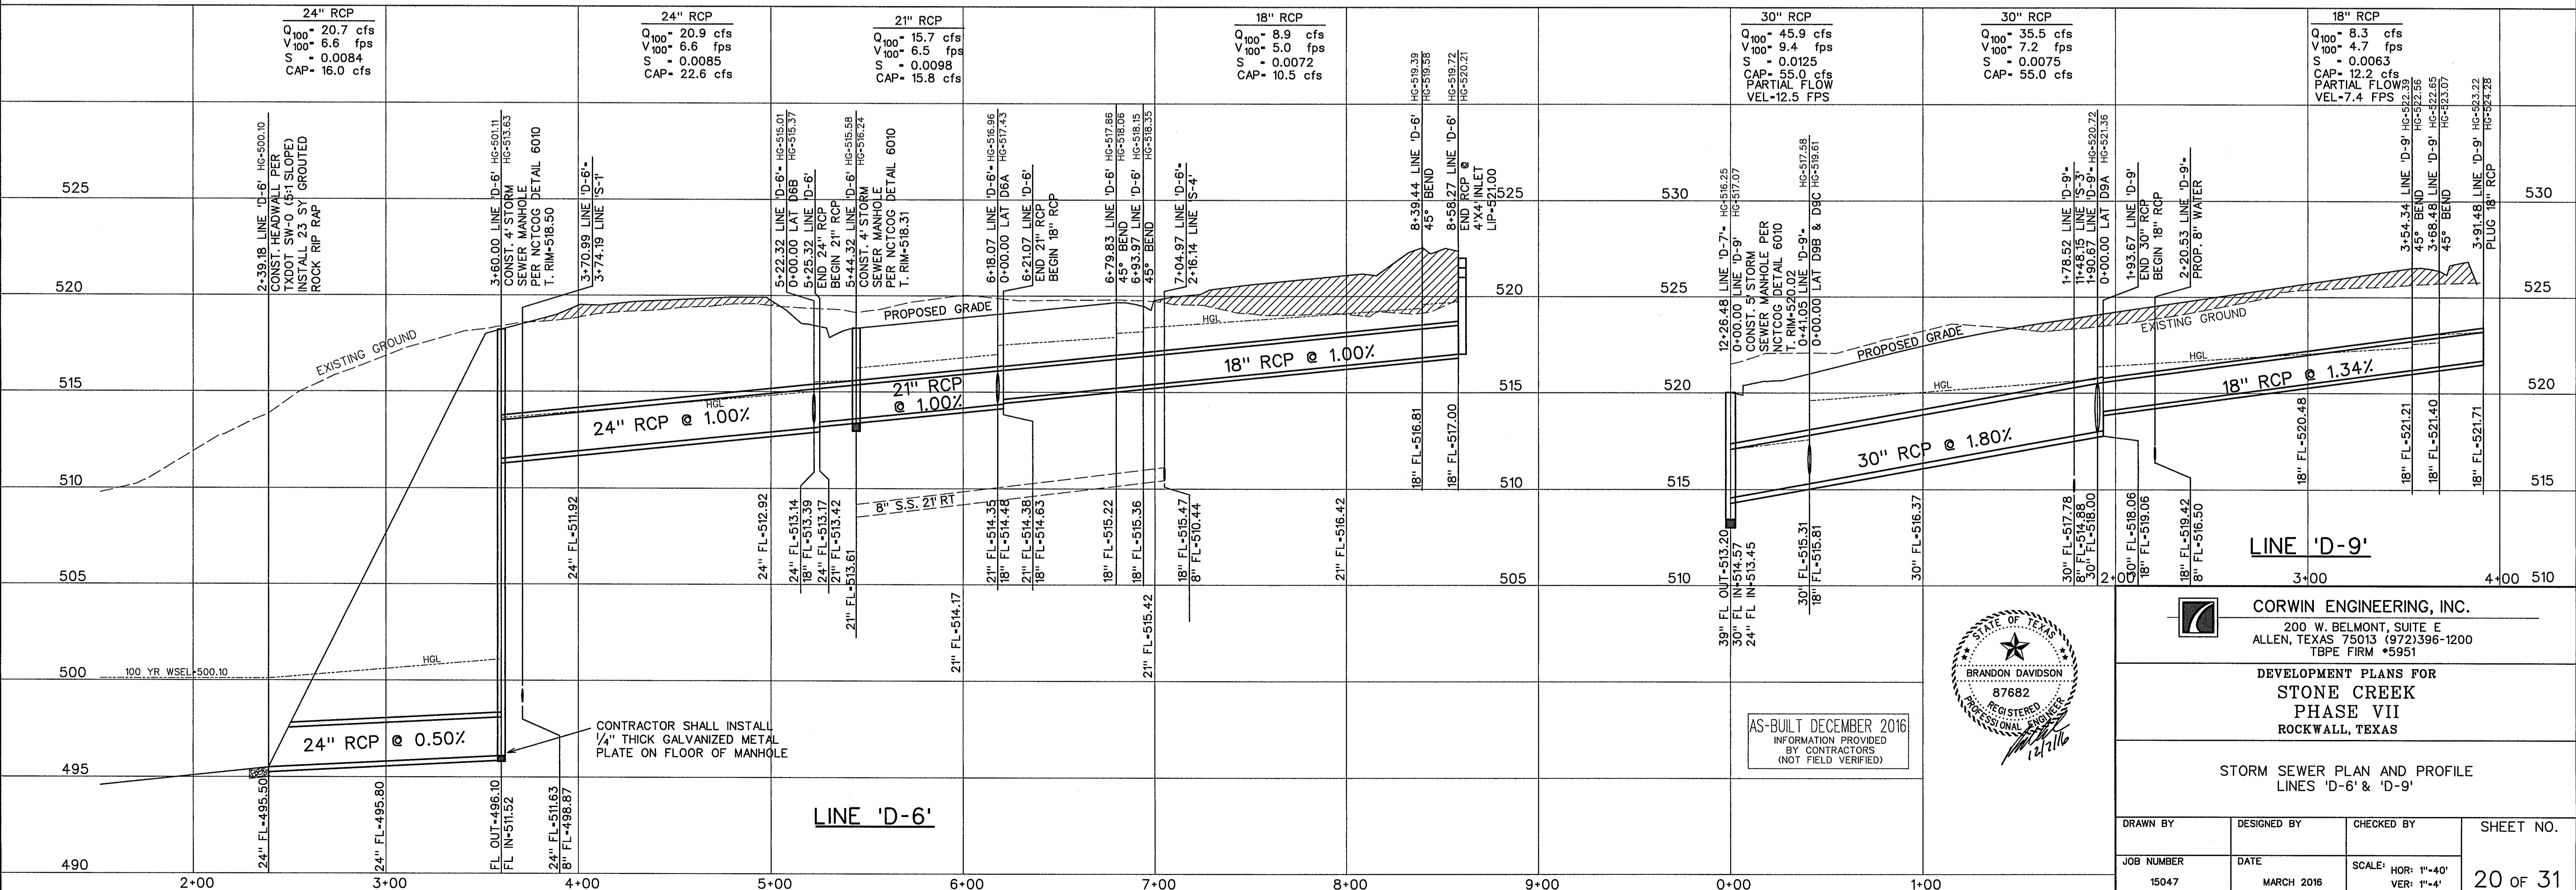

AS-BUILT DECEMBER 2016
INFORMATION PROVIDED BY CONTRACTORS (NOT FIELD VERIFIED)





CORWIN ENGINEERING, INC.
200 W. BELMONT, SUITE E
ALLEN, TEXAS 75013 (972)396-1200
TBPE FIRM #5951

**DEVELOPMENT PLANS FOR
STONE CREEK
PHASE VII
ROCKWALL, TEXAS**

**STORM SEWER PLAN AND PROFILE
LINES 'D-6' & 'D-9'**

DRAWN BY	DESIGNED BY	CHECKED BY	SHEET NO.
JOB NUMBER	DATE	SCALE: HOR: 1"=40' VER: 1"=4"	20 of 31


CURVE DATA	
CURVE NO.	①
Δ	30° 47' 21"
R	150.00'
T	41.30'
L	80.60'

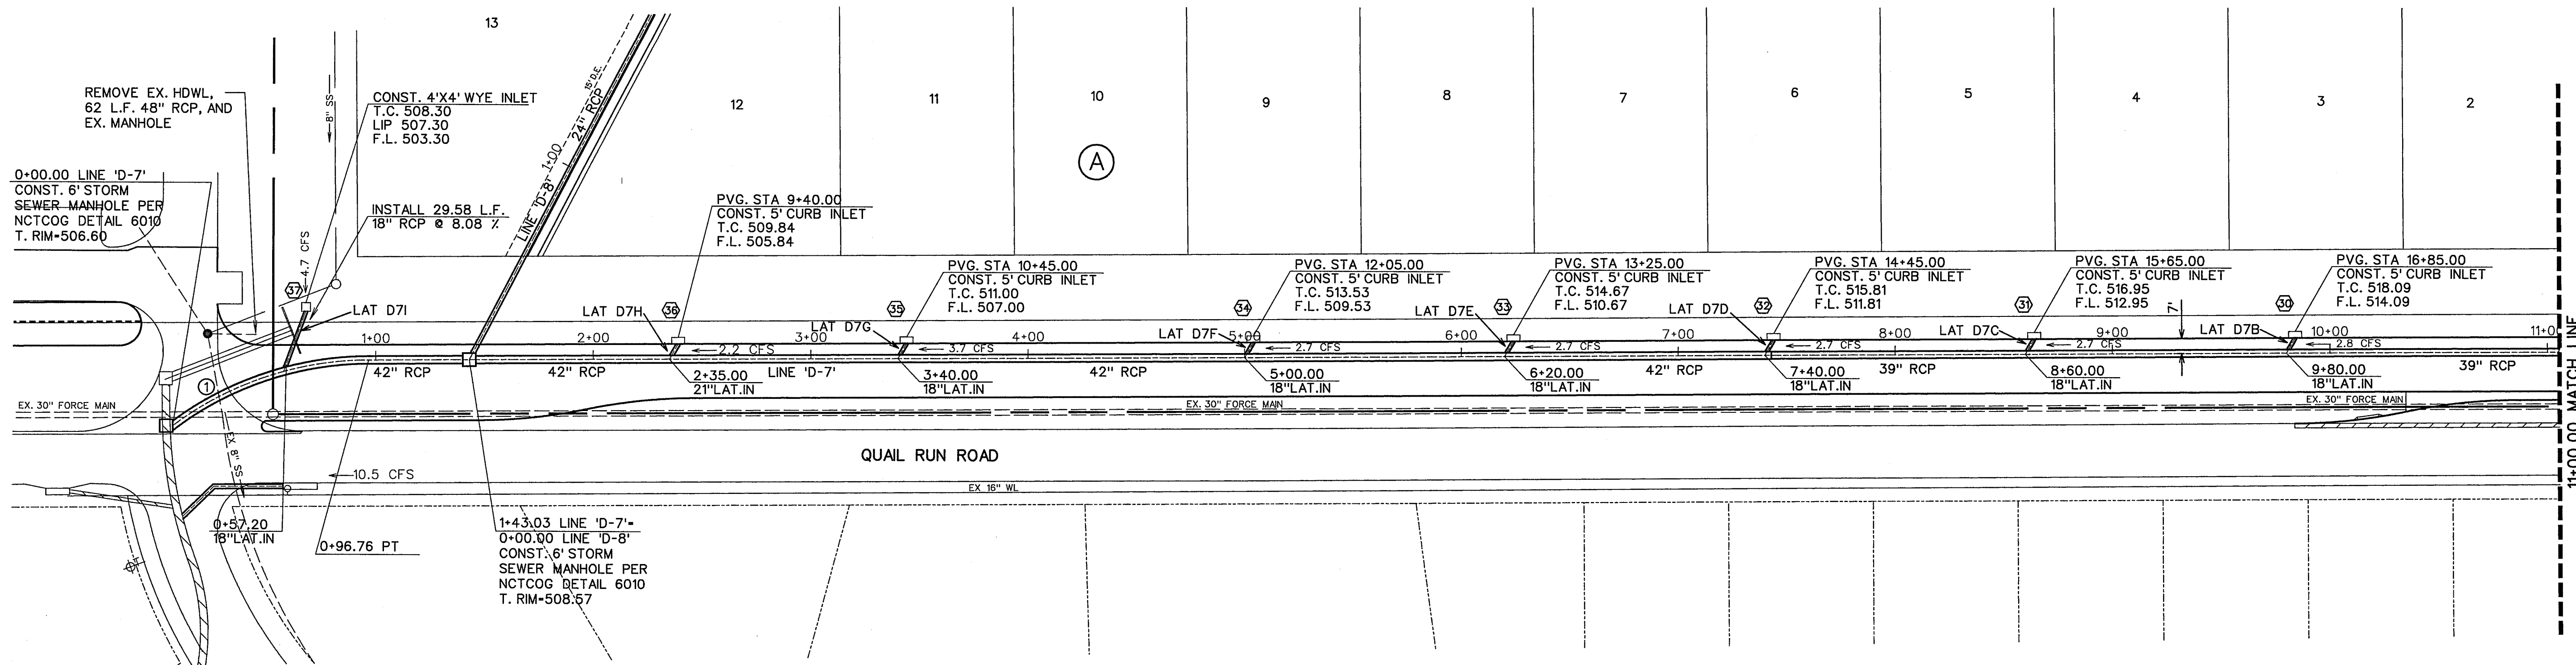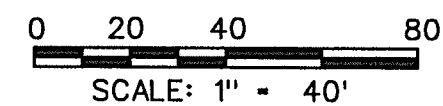

LINE 'D-7'

LEGEND

- Ⓚ - BLOCK LABEL
- Ⓜ - INLET NUMBER
- ① - CURVE NUMBER
- - SANITARY SEWER
- ⊕ - WATER
- ▬ - PROPOSED STORM SEWER
- ▬▬▬ - EXISTING STORM SEWER

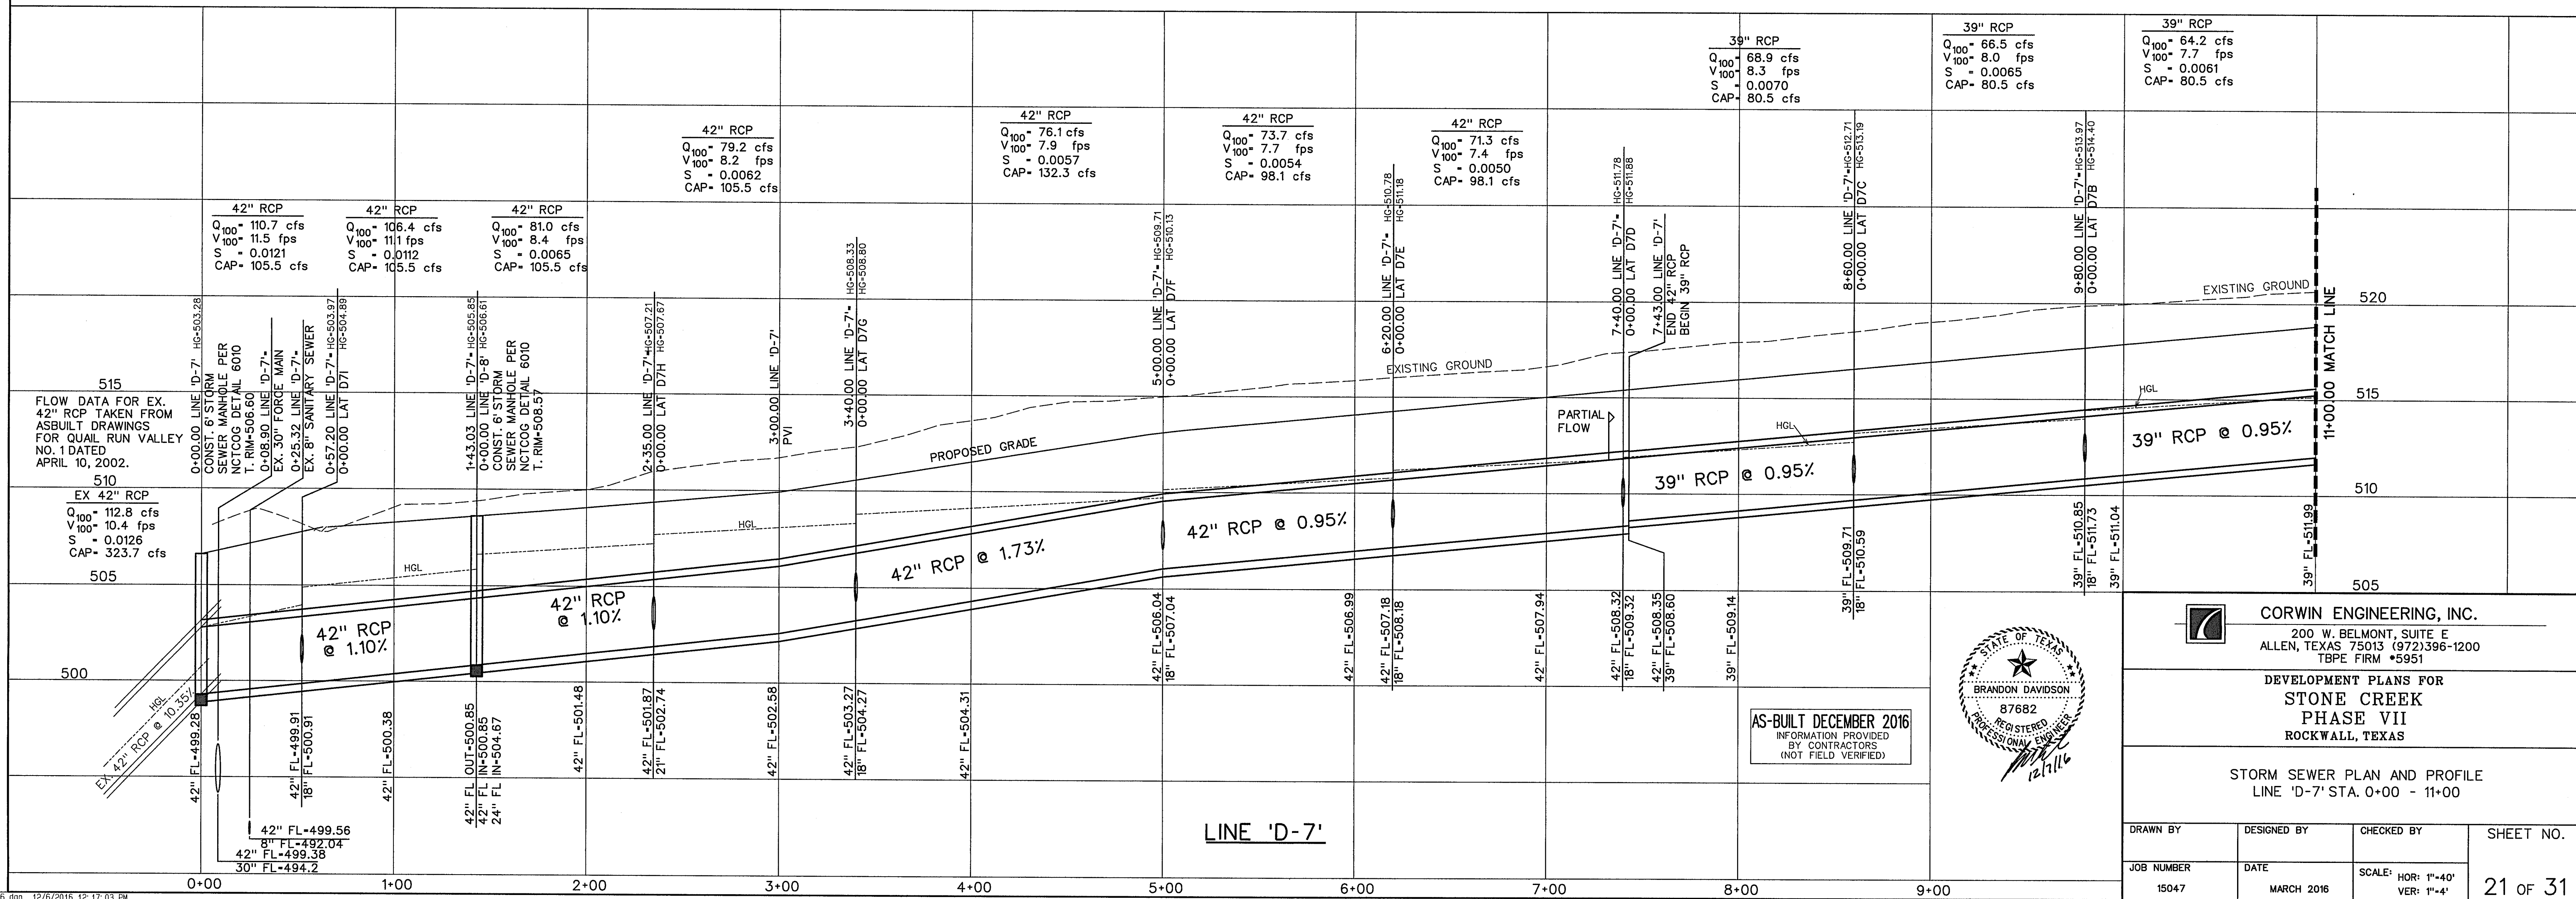

LINE 'D-7'

AS-BUILT DECEMBER 2016
INFORMATION PROVIDED
BY CONTRACTORS
(NOT FIELD VERIFIED)




CORWIN ENGINEERING, INC.
200 W. BELMONT, SUITE E
ALLEN, TEXAS 75013 (972)396-1200
TBP E FIRM #5951

DEVELOPMENT PLANS FOR
STONE CREEK
PHASE VII
ROCKWALL, TEXAS

STORM SEWER PLAN AND PROFILE
LINE 'D-7' STA. 0+00 - 11+00


DRAWN BY	DESIGNED BY	CHECKED BY	SHEET NO.
JOB NUMBER	DATE	SCALE: HOR: 1"=40' VER: 1"=4'	21 OF 31
15047	MARCH 2016		

STORM SEWER CURVE DATA	
CURVE NO.	①
Δ	30° 00' 00"
R	65.00'
T	17.42'
L	34.03'

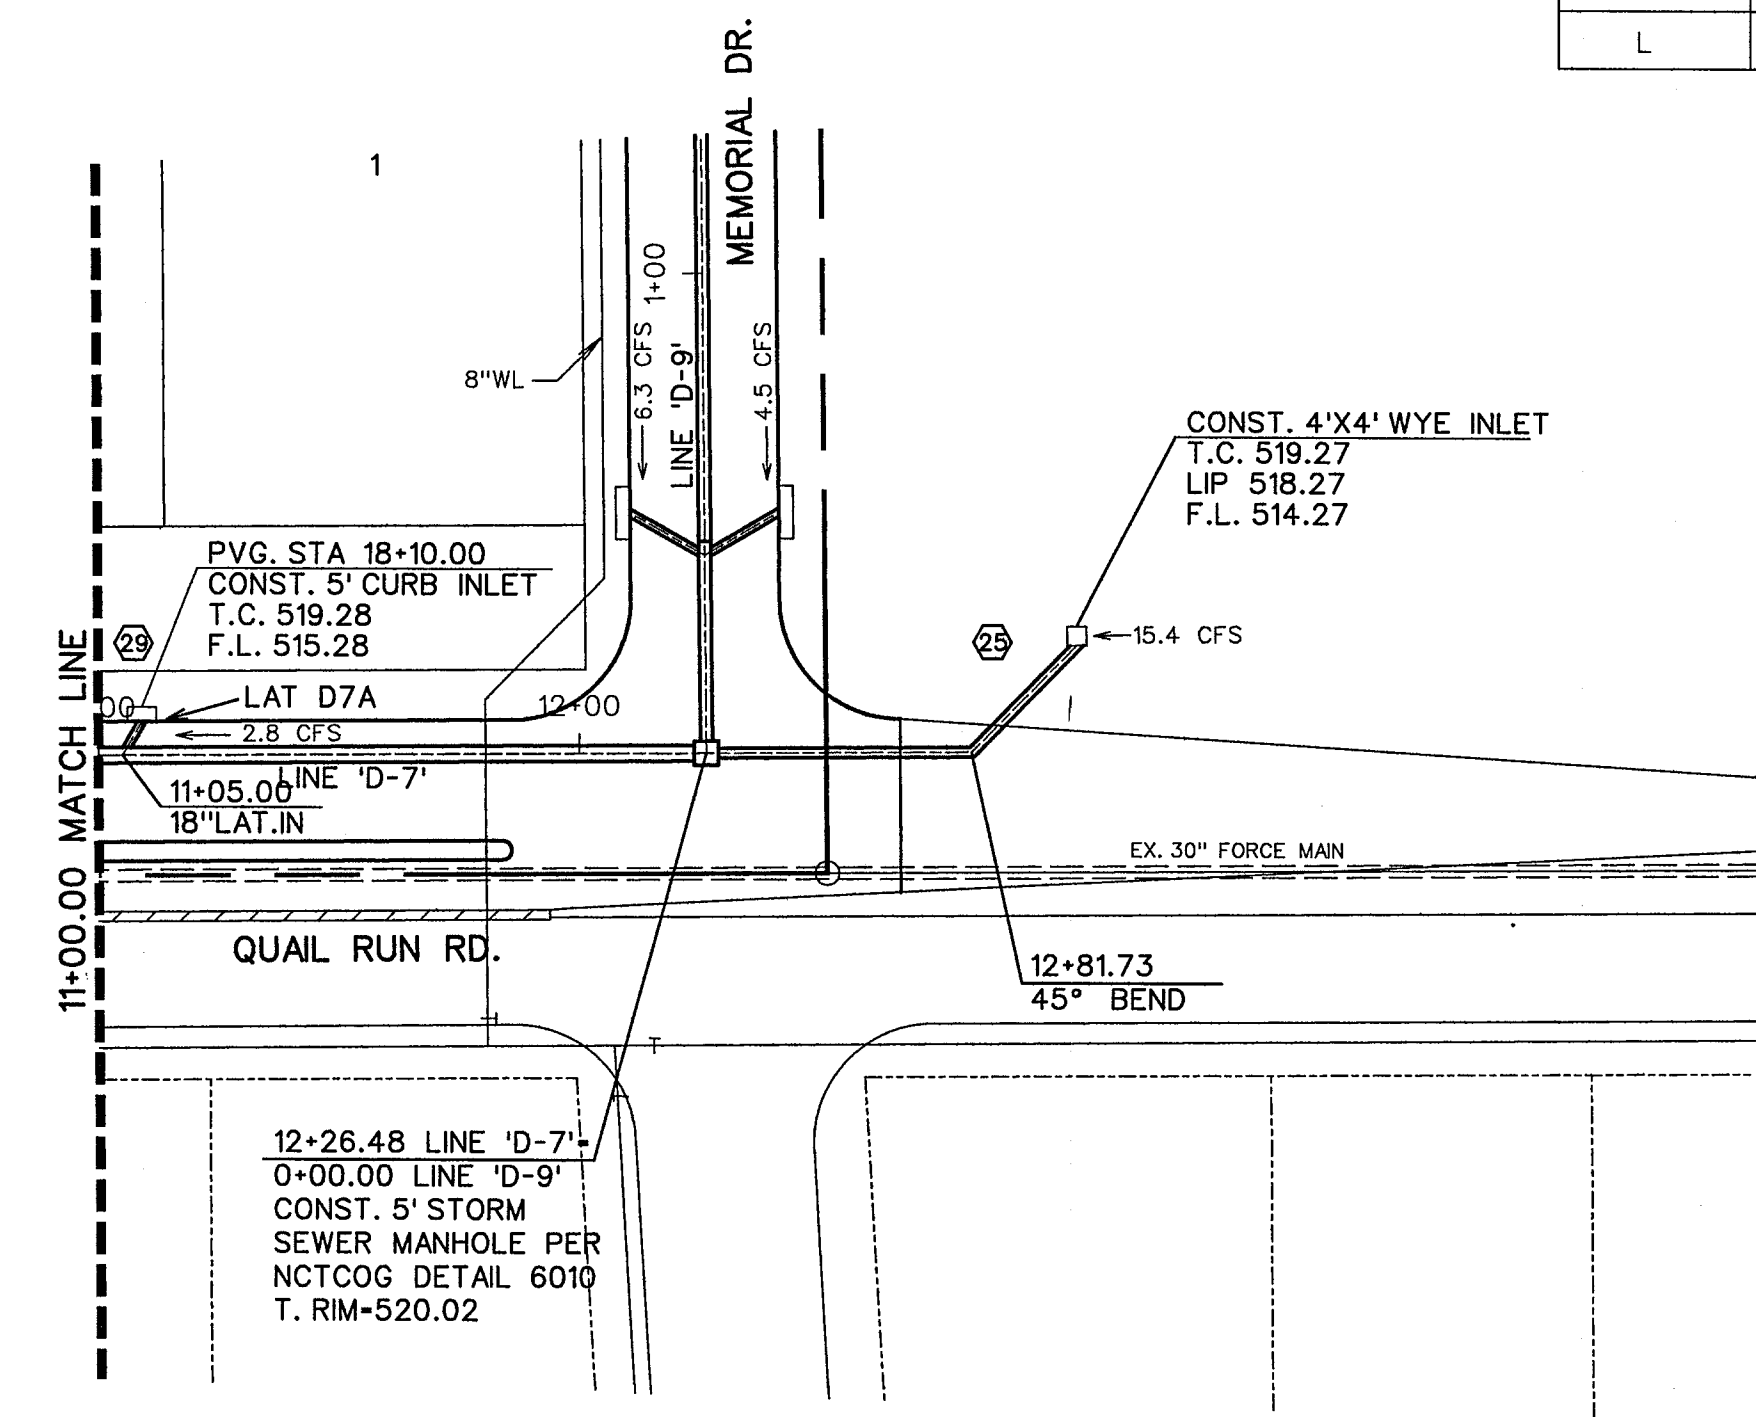


LINE 'D-7'

36" RCP
 Q₁₀₀ = 57.6 cfs
 V₁₀₀ = 8.1 fps
 S = 0.0074
 CAP = 81.7 cfs
 PARTIAL FLOW
 VEL = 12.5 FPS

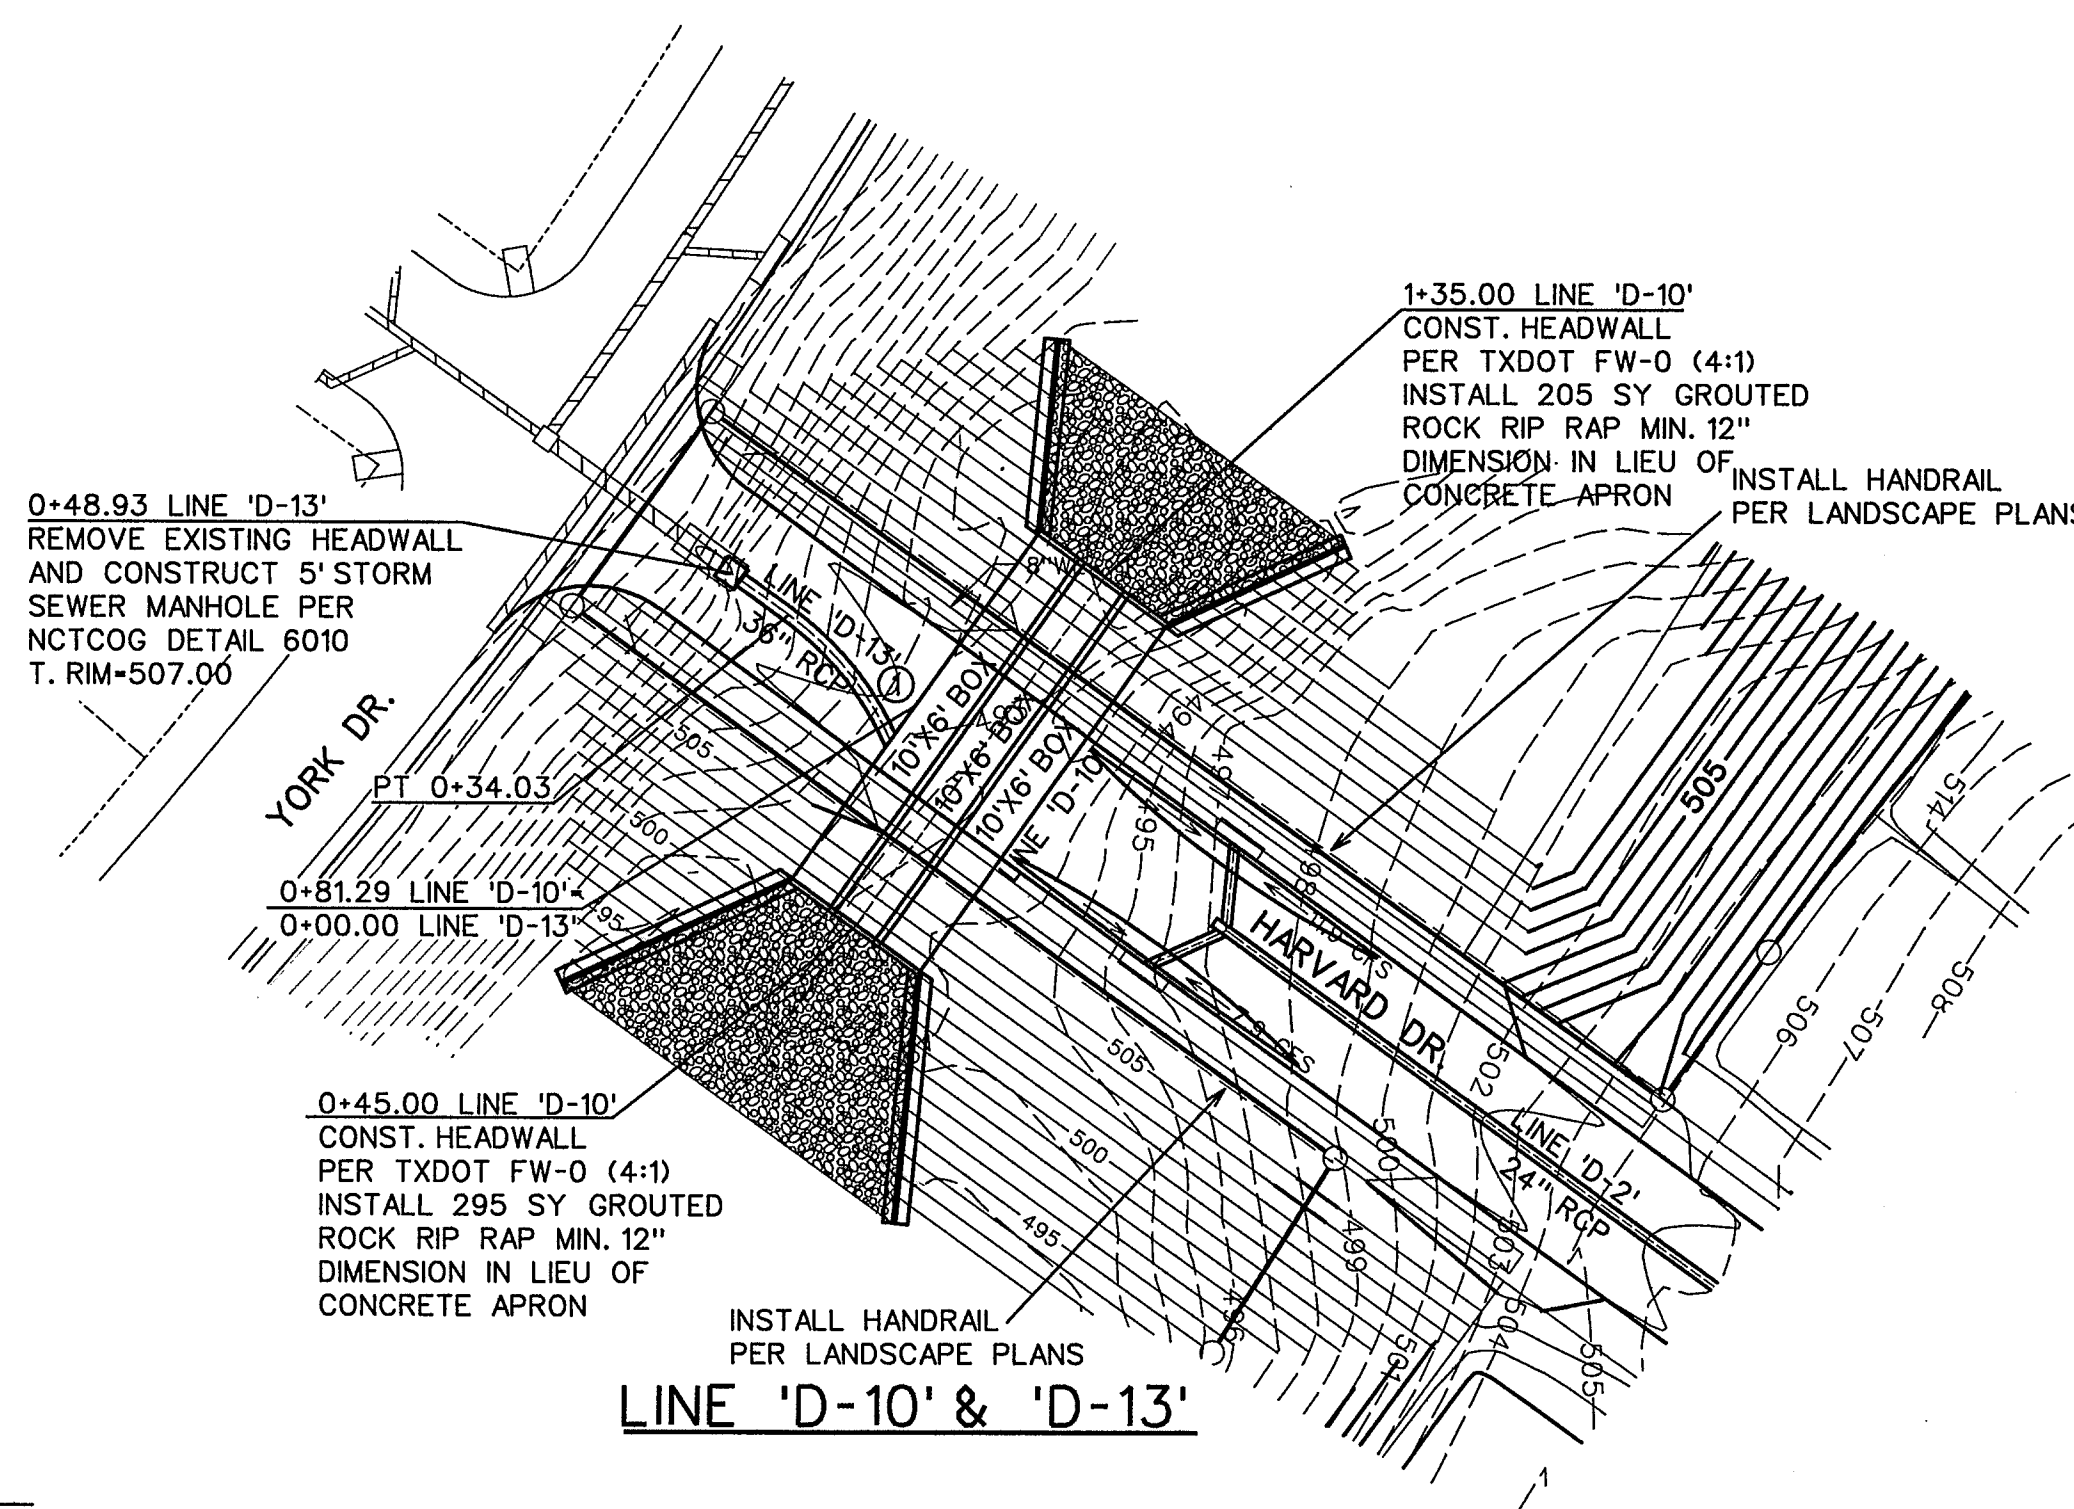

LINE 'D-10' & 'D-13'


3-10X6 BOX
 Q₁₀₀ = 458.9 cfs
 V₁₀₀ = 4.0 fps
 S = 0.0006

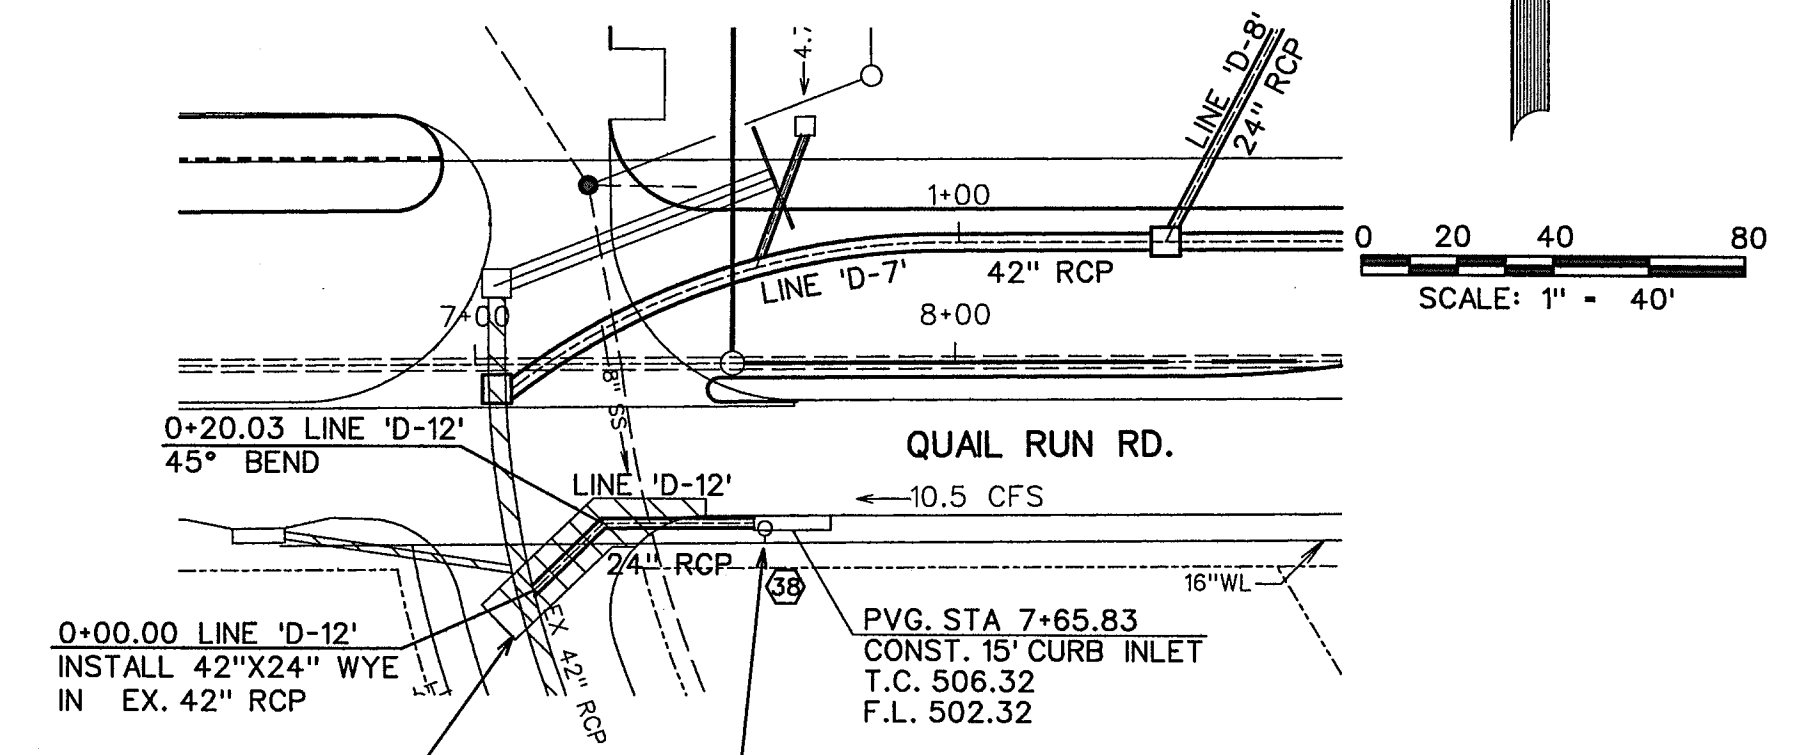

LINE 'D-12'

24" RCP
 Q₁₀₀ = 10.5 cfs
 V₁₀₀ = 3.3 fps
 S = 0.0022
 CAP = 77.6 cfs
 PARTIAL FLOW
 VEL = 17.3 FPS

- LEGEND
- Ⓟ - BLOCK LABEL
 - Ⓜ - INLET NUMBER
 - ① - CURVE NUMBER
 - - SANITARY SEWER
 - - WATER
 - — — - PROPOSED STORM SEWER
 - — — - EXISTING STORM SEWER

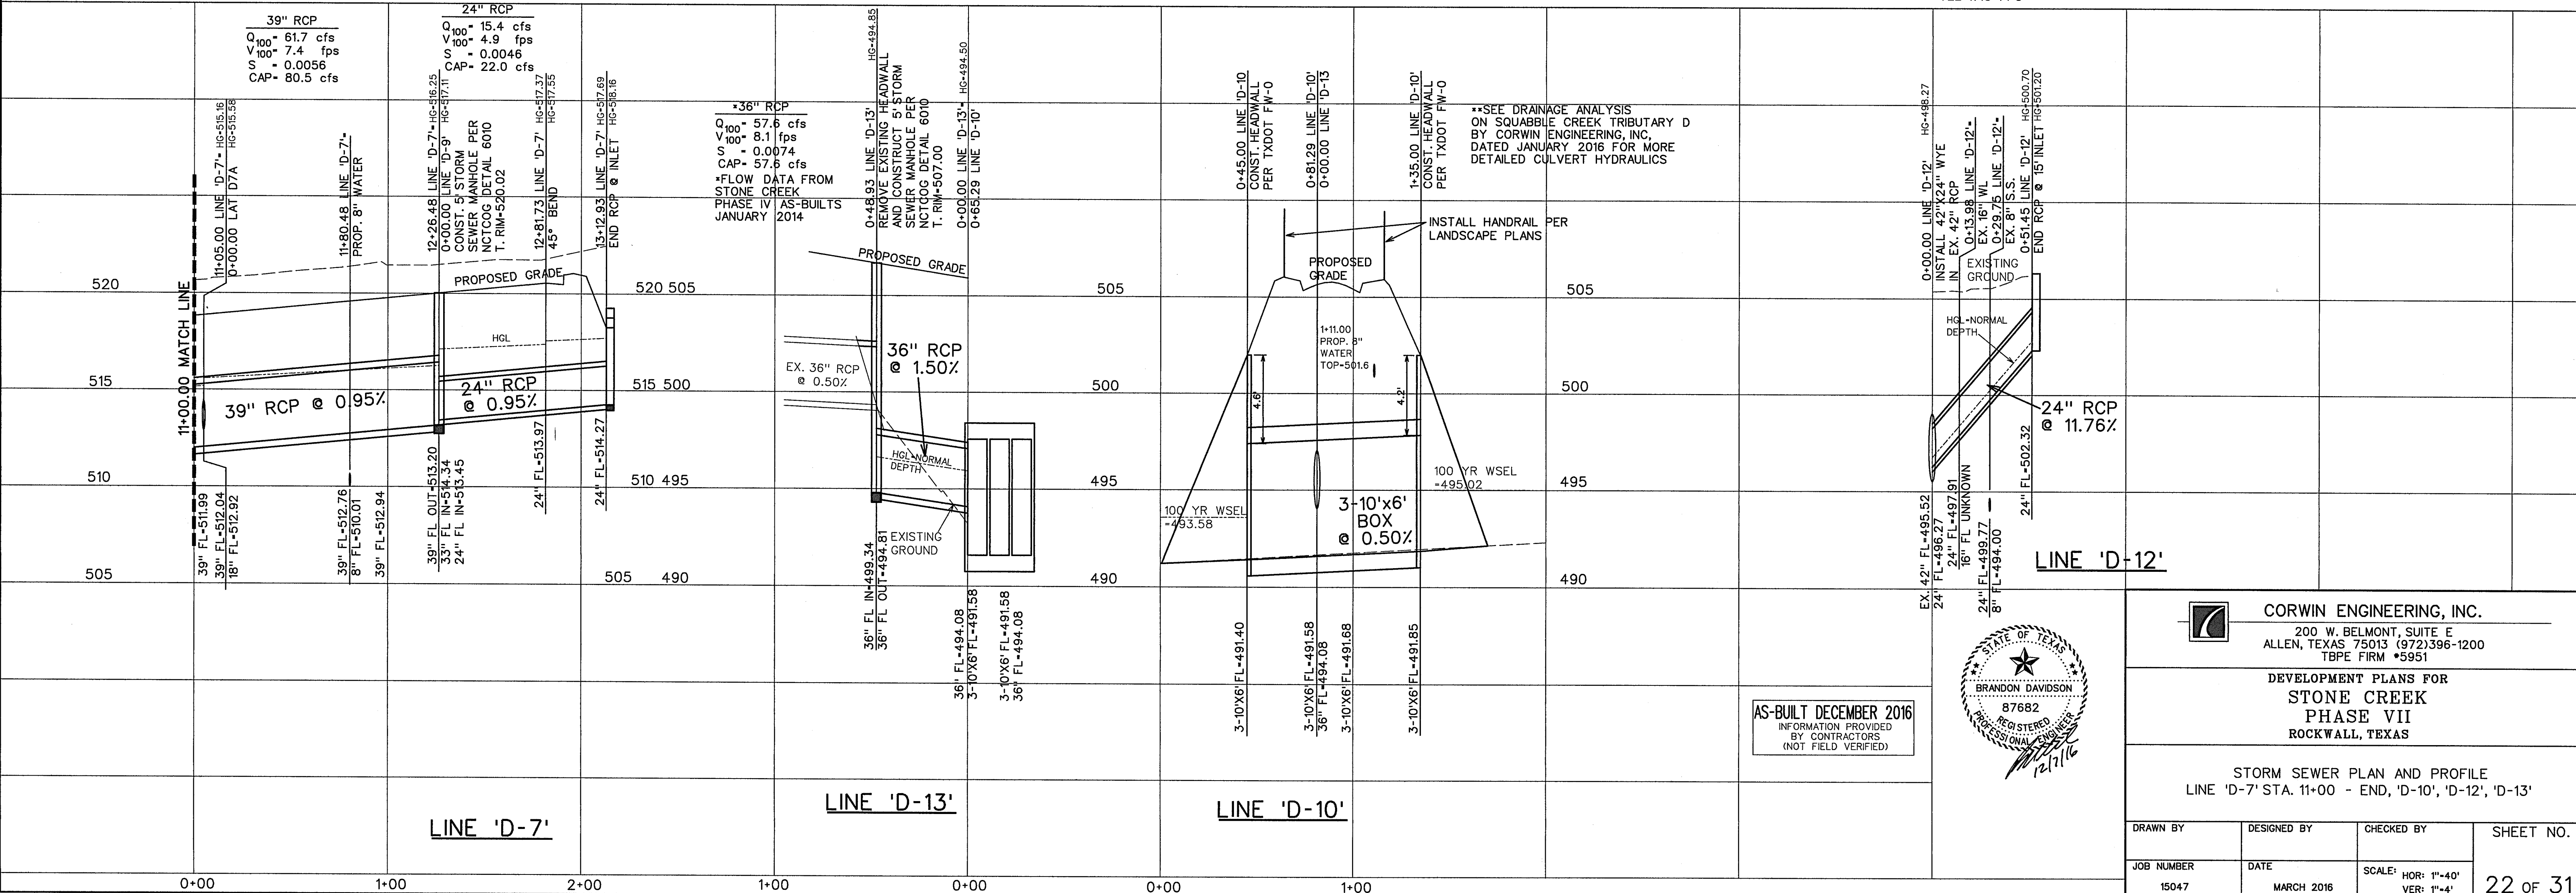

LINE 'D-7'

LINE 'D-13'

LINE 'D-10'

LINE 'D-12'

AS-BUILT DECEMBER 2016
 INFORMATION PROVIDED
 BY CONTRACTORS
 (NOT FIELD VERIFIED)




CORWIN ENGINEERING, INC.
 200 W. BELMONT, SUITE E
 ALLEN, TEXAS 75013 (972) 396-1200
 TBPE FIRM #5951


DEVELOPMENT PLANS FOR
 STONE CREEK
 PHASE VII
 ROCKWALL, TEXAS

STORM SEWER PLAN AND PROFILE
 LINE 'D-7' STA. 11+00 - END, 'D-10', 'D-12', 'D-13'

DRAWN BY	DESIGNED BY	CHECKED BY	SHEET NO.
JOB NUMBER	DATE	SCALE: HOR: 1"=40' VER: 1"=4'	22 OF 31
15047	MARCH 2016		

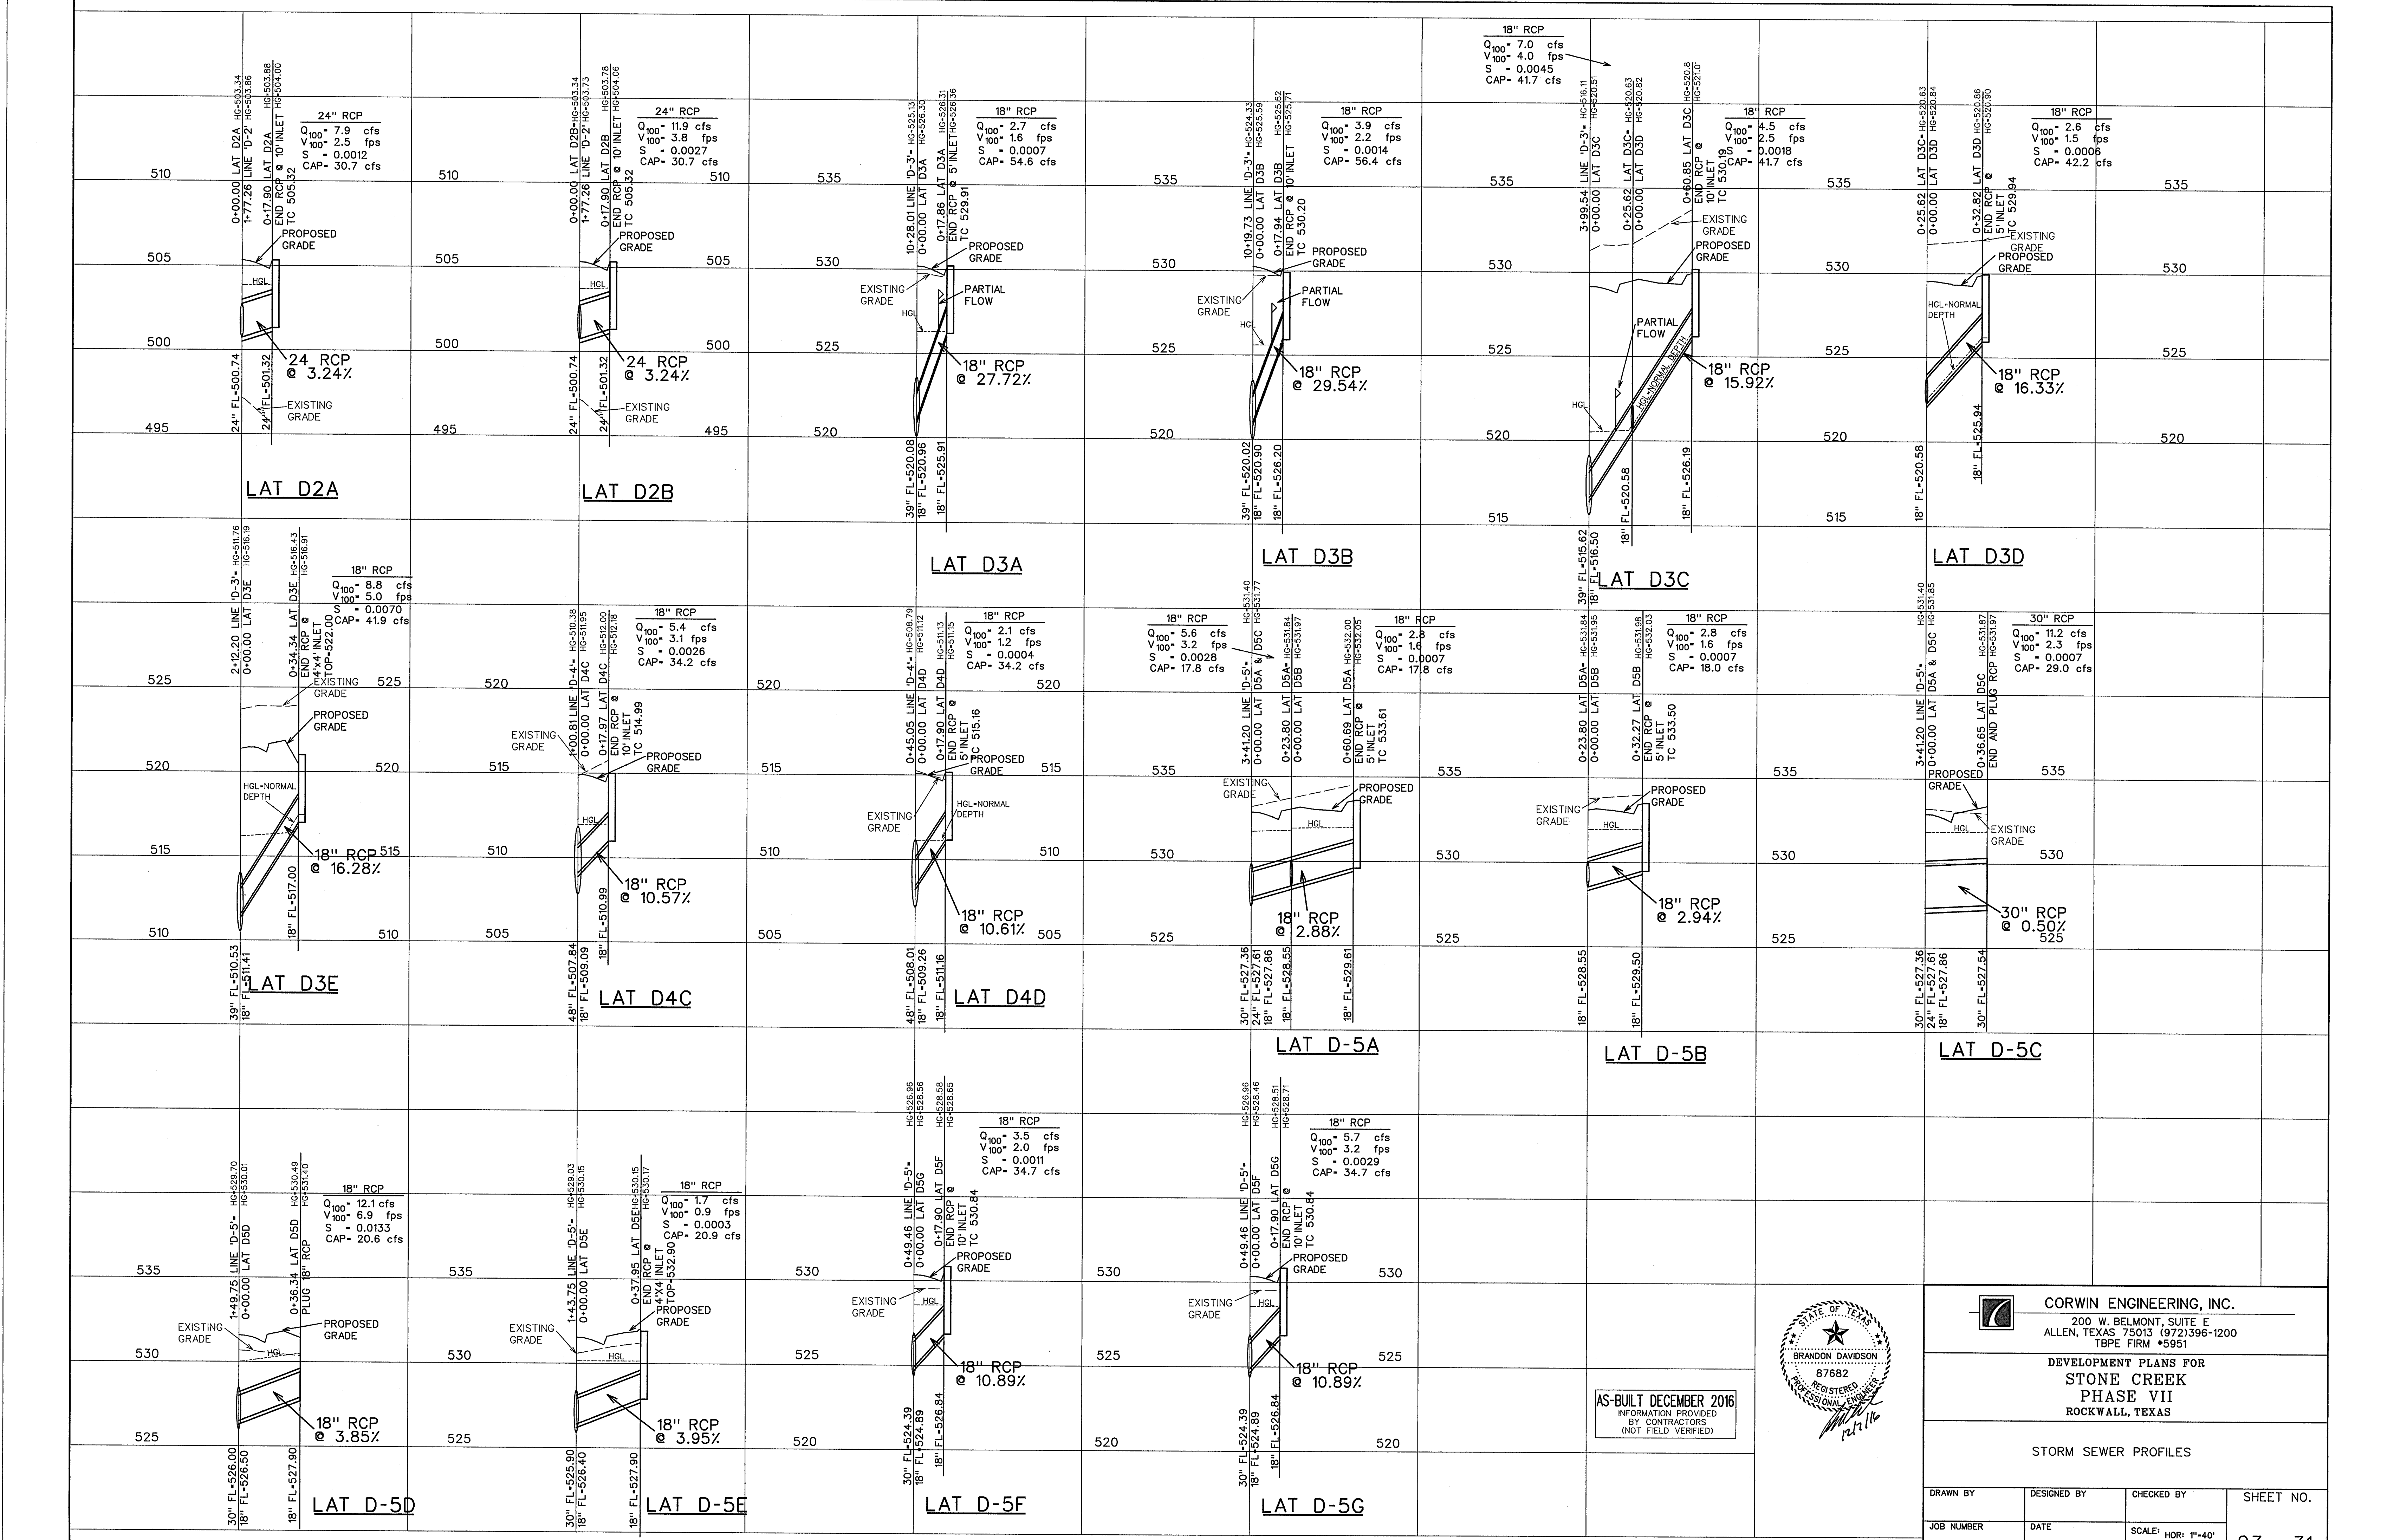

AS-BUILT DECEMBER 2016
 INFORMATION PROVIDED
 BY CONTRACTORS
 (NOT FIELD VERIFIED)

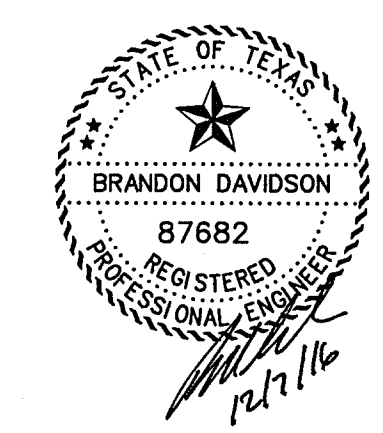


CORWIN ENGINEERING, INC.
 200 W. BELMONT, SUITE E
 ALLEN, TEXAS 75013 (972)396-1200
 TBPE FIRM #5951

DEVELOPMENT PLANS FOR
STONE CREEK
 PHASE VII
 ROCKWALL, TEXAS

STORM SEWER PROFILES

DRAWN BY	DESIGNED BY	CHECKED BY	SHEET NO.
JOB NUMBER	DATE	SCALE: HOR: 1"=40' VER: 1"=4'	23 OF 31
15047	MARCH 2016		

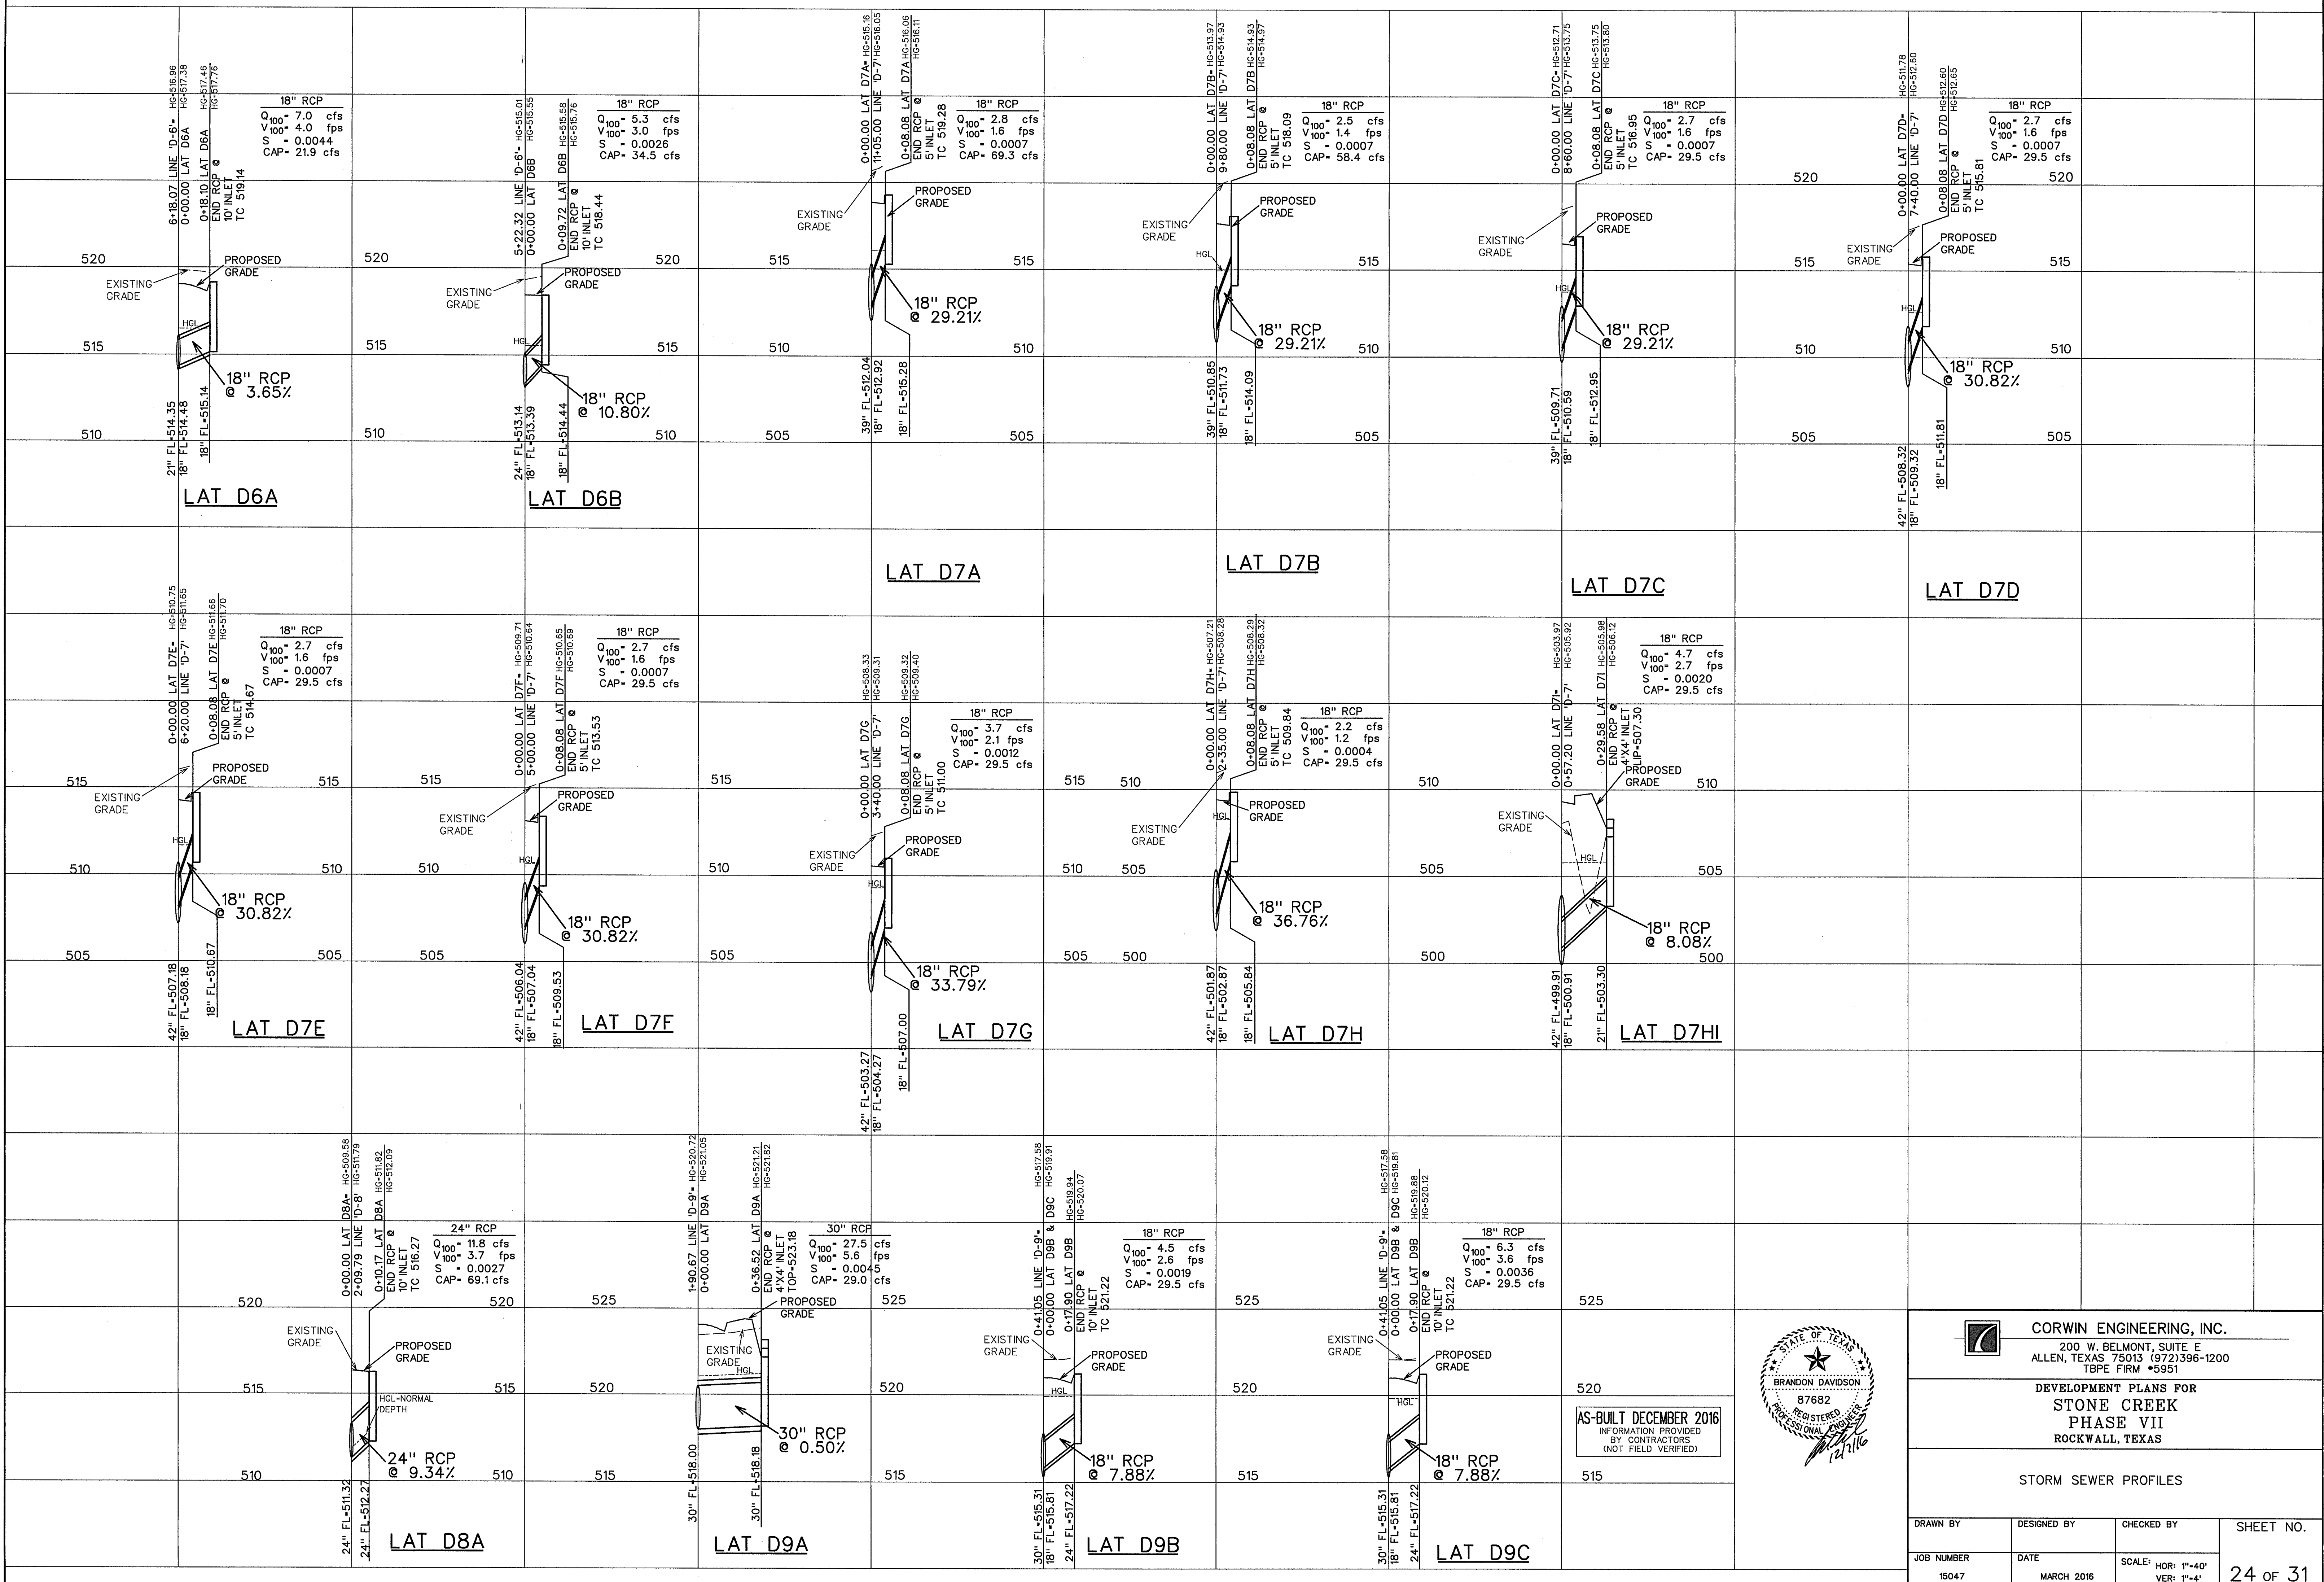

AS-BUILT DECEMBER 2016
 INFORMATION PROVIDED
 BY CONTRACTORS
 (NOT FIELD VERIFIED)

CORWIN ENGINEERING, INC.
 200 W. BELMONT, SUITE E
 ALLEN, TEXAS 75013 (972)396-1200
 TBPE FIRM #5951


DEVELOPMENT PLANS FOR
**STONE CREEK
 PHASE VII**
 ROCKWALL, TEXAS

STORM SEWER PROFILES



DRAWN BY	DESIGNED BY	CHECKED BY	SHEET NO.
JOB NUMBER	DATE	SCALE: HOR: 1"=40' VER: 1"=4'	24 OF 31
15047	MARCH 2016		

Reservoir 2 Stage Discharge Calculations

Stage (ft)	Storage (ac-ft)	Weir Flow			Orifice Flow			Weir Length (L)	Head (H)	Release (cfs)	Orifice Flow			Total Release (cfs)	
		Weir Length (L)	Head (H)	Release (cfs)	Area (sf)	Head (H)	Release (cfs)				Area (sf)	Head (H)	Release (cfs)		
493.00	0.00	Weir	2.36	0.00	0.0	N/A	28	0.00	0.0	N/A			0.0		
493.25	0.06	Weir	2.36	0.25	1.0	N/A	28	0.00	0.0	N/A			1.0		
493.50	0.11	Weir	2.36	0.50	2.8	N/A	28	0.00	0.0	N/A			2.8		
493.75	0.17	Weir	2.36	0.75	5.1	N/A	28	0.00	0.0	N/A			5.1		
494.00	0.22	Weir	2.36	1.00	7.8	N/A	28	0.00	0.0	N/A			7.8		
494.25	0.48	Weir	2.36	1.25	11.0	N/A	28	0.00	0.0	N/A			11.0		
494.50	0.74	Weir	2.36	1.50	14.4	N/A	28	0.00	0.0	N/A			14.4		
494.75	1.00	Weir	2.36	1.75	18.2	N/A	28	0.00	0.0	N/A			18.2		
495.00	1.26	Orifice	2.36	2.00	22.2	N/A	28	0.00	0.0	N/A			22.2		
495.25	1.77	Orifice	2.36	2.25	26.5	N/A	28	0.00	0.0	N/A			26.5		
495.50	2.27	Orifice	2.36	2.50	31.0	N/A	28	0.00	0.0	N/A			31.0		
495.75	2.78	Orifice	2.36	2.75	35.8	N/A	28	0.00	0.0	N/A			35.8		
496.00	3.28	Orifice	N/A			7.0686	1.50	41.7	Weir	28	0.00	0.0	N/A		
496.25	3.92	Orifice	N/A			7.0686	1.75	45.0	Weir	28	0.00	0.0	N/A		
496.50	4.57	Orifice	N/A			7.0686	2.00	48.1	Weir	28	0.00	0.0	N/A		
496.75	5.21	Orifice	N/A			7.0686	2.25	51.1	Weir	28	0.00	0.0	N/A		
497.00	5.86	Orifice	N/A			7.0686	2.50	53.8	Weir	28	0.00	0.0	N/A		
497.25	6.57	Orifice	N/A			7.0686	2.75	56.4	Weir	28	0.00	0.0	N/A		
497.50	7.28	Orifice	N/A			7.0686	3.00	59.0	Weir	28	0.00	0.0	N/A		
497.75	7.99	Orifice	N/A			7.0686	3.25	61.4	Weir	28	0.00	0.0	N/A		
498.00	8.70	Orifice	N/A			7.0686	3.50	63.7	Weir	28	0.00	0.0	N/A		
498.25	9.31	Orifice	N/A			7.0686	3.70	65.5	Weir	28	0.00	0.0	N/A		
498.50	9.46	Orifice	N/A			7.0686	3.75	65.9	Weir	28	0.00	0.0	N/A		
498.75	10.23	Orifice	N/A			7.0686	4.00	68.1	Weir	28	0.00	0.0	N/A		
499.00	10.99	Orifice	N/A			7.0686	4.25	70.2	Weir	28	0.00	0.0	N/A		
499.25	11.75	Orifice	N/A			7.0686	4.50	72.2	Weir	28	0.00	0.0	N/A		
499.50	12.56	Orifice	N/A			7.0686	4.75	74.2	Weir	28	0.25	11.7	N/A		
499.75	13.37	Orifice	N/A			7.0686	4.80	74.6	Weir	28	0.30	15.3	N/A		
500.00	14.01	Orifice	N/A			7.0686	5.00	76.1	Weir	28	0.50	33.0	N/A		
500.25	14.98	Orifice	N/A			7.0686	5.25	77.6	Weir	28	0.70	54.6	N/A		
500.50	15.84	Orifice	N/A			7.0686	5.50	79.8	Orifice	N/A		28	0.50	95.3	175.2
500.75	16.70	Orifice	N/A			7.0686	5.75	81.6	Orifice	N/A		28	0.75	116.8	198.4
501.00	17.56	Orifice	N/A			7.0686	6.00	83.4	Orifice	N/A		28	1.00	134.8	218.2
501.00	18.42	Orifice	N/A			7.0686	6.25	85.1	Orifice	N/A		28	1.25	150.7	235.8
501.00	18.42	Orifice	N/A			7.0686	6.50	86.8	Orifice	N/A		28	1.50	165.1	251.9

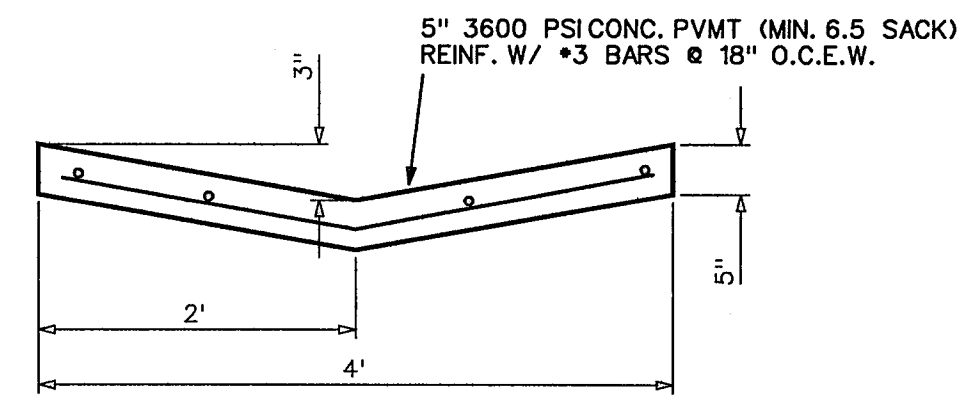

SCALE: 1" = 40'

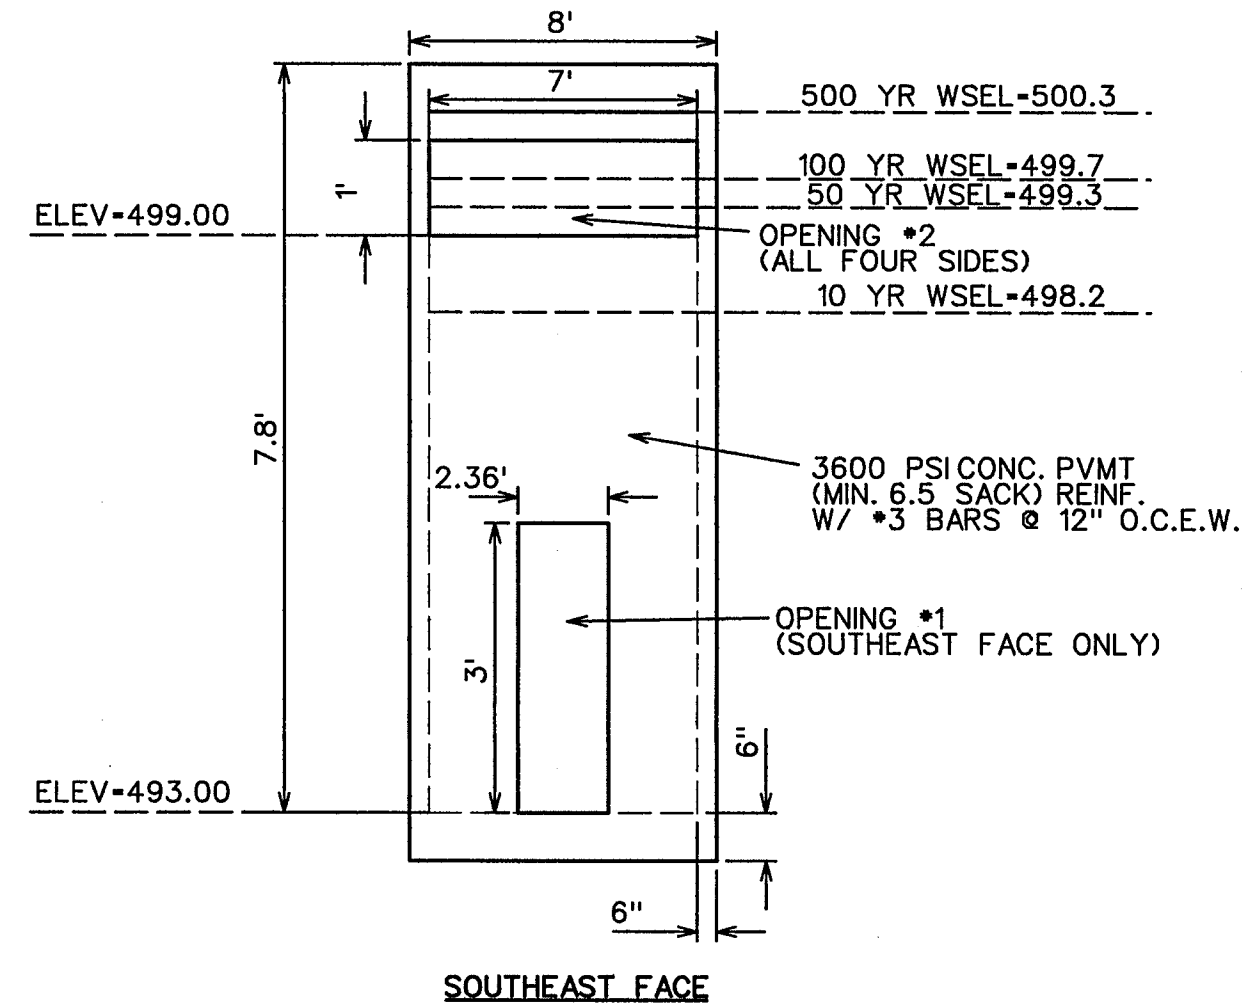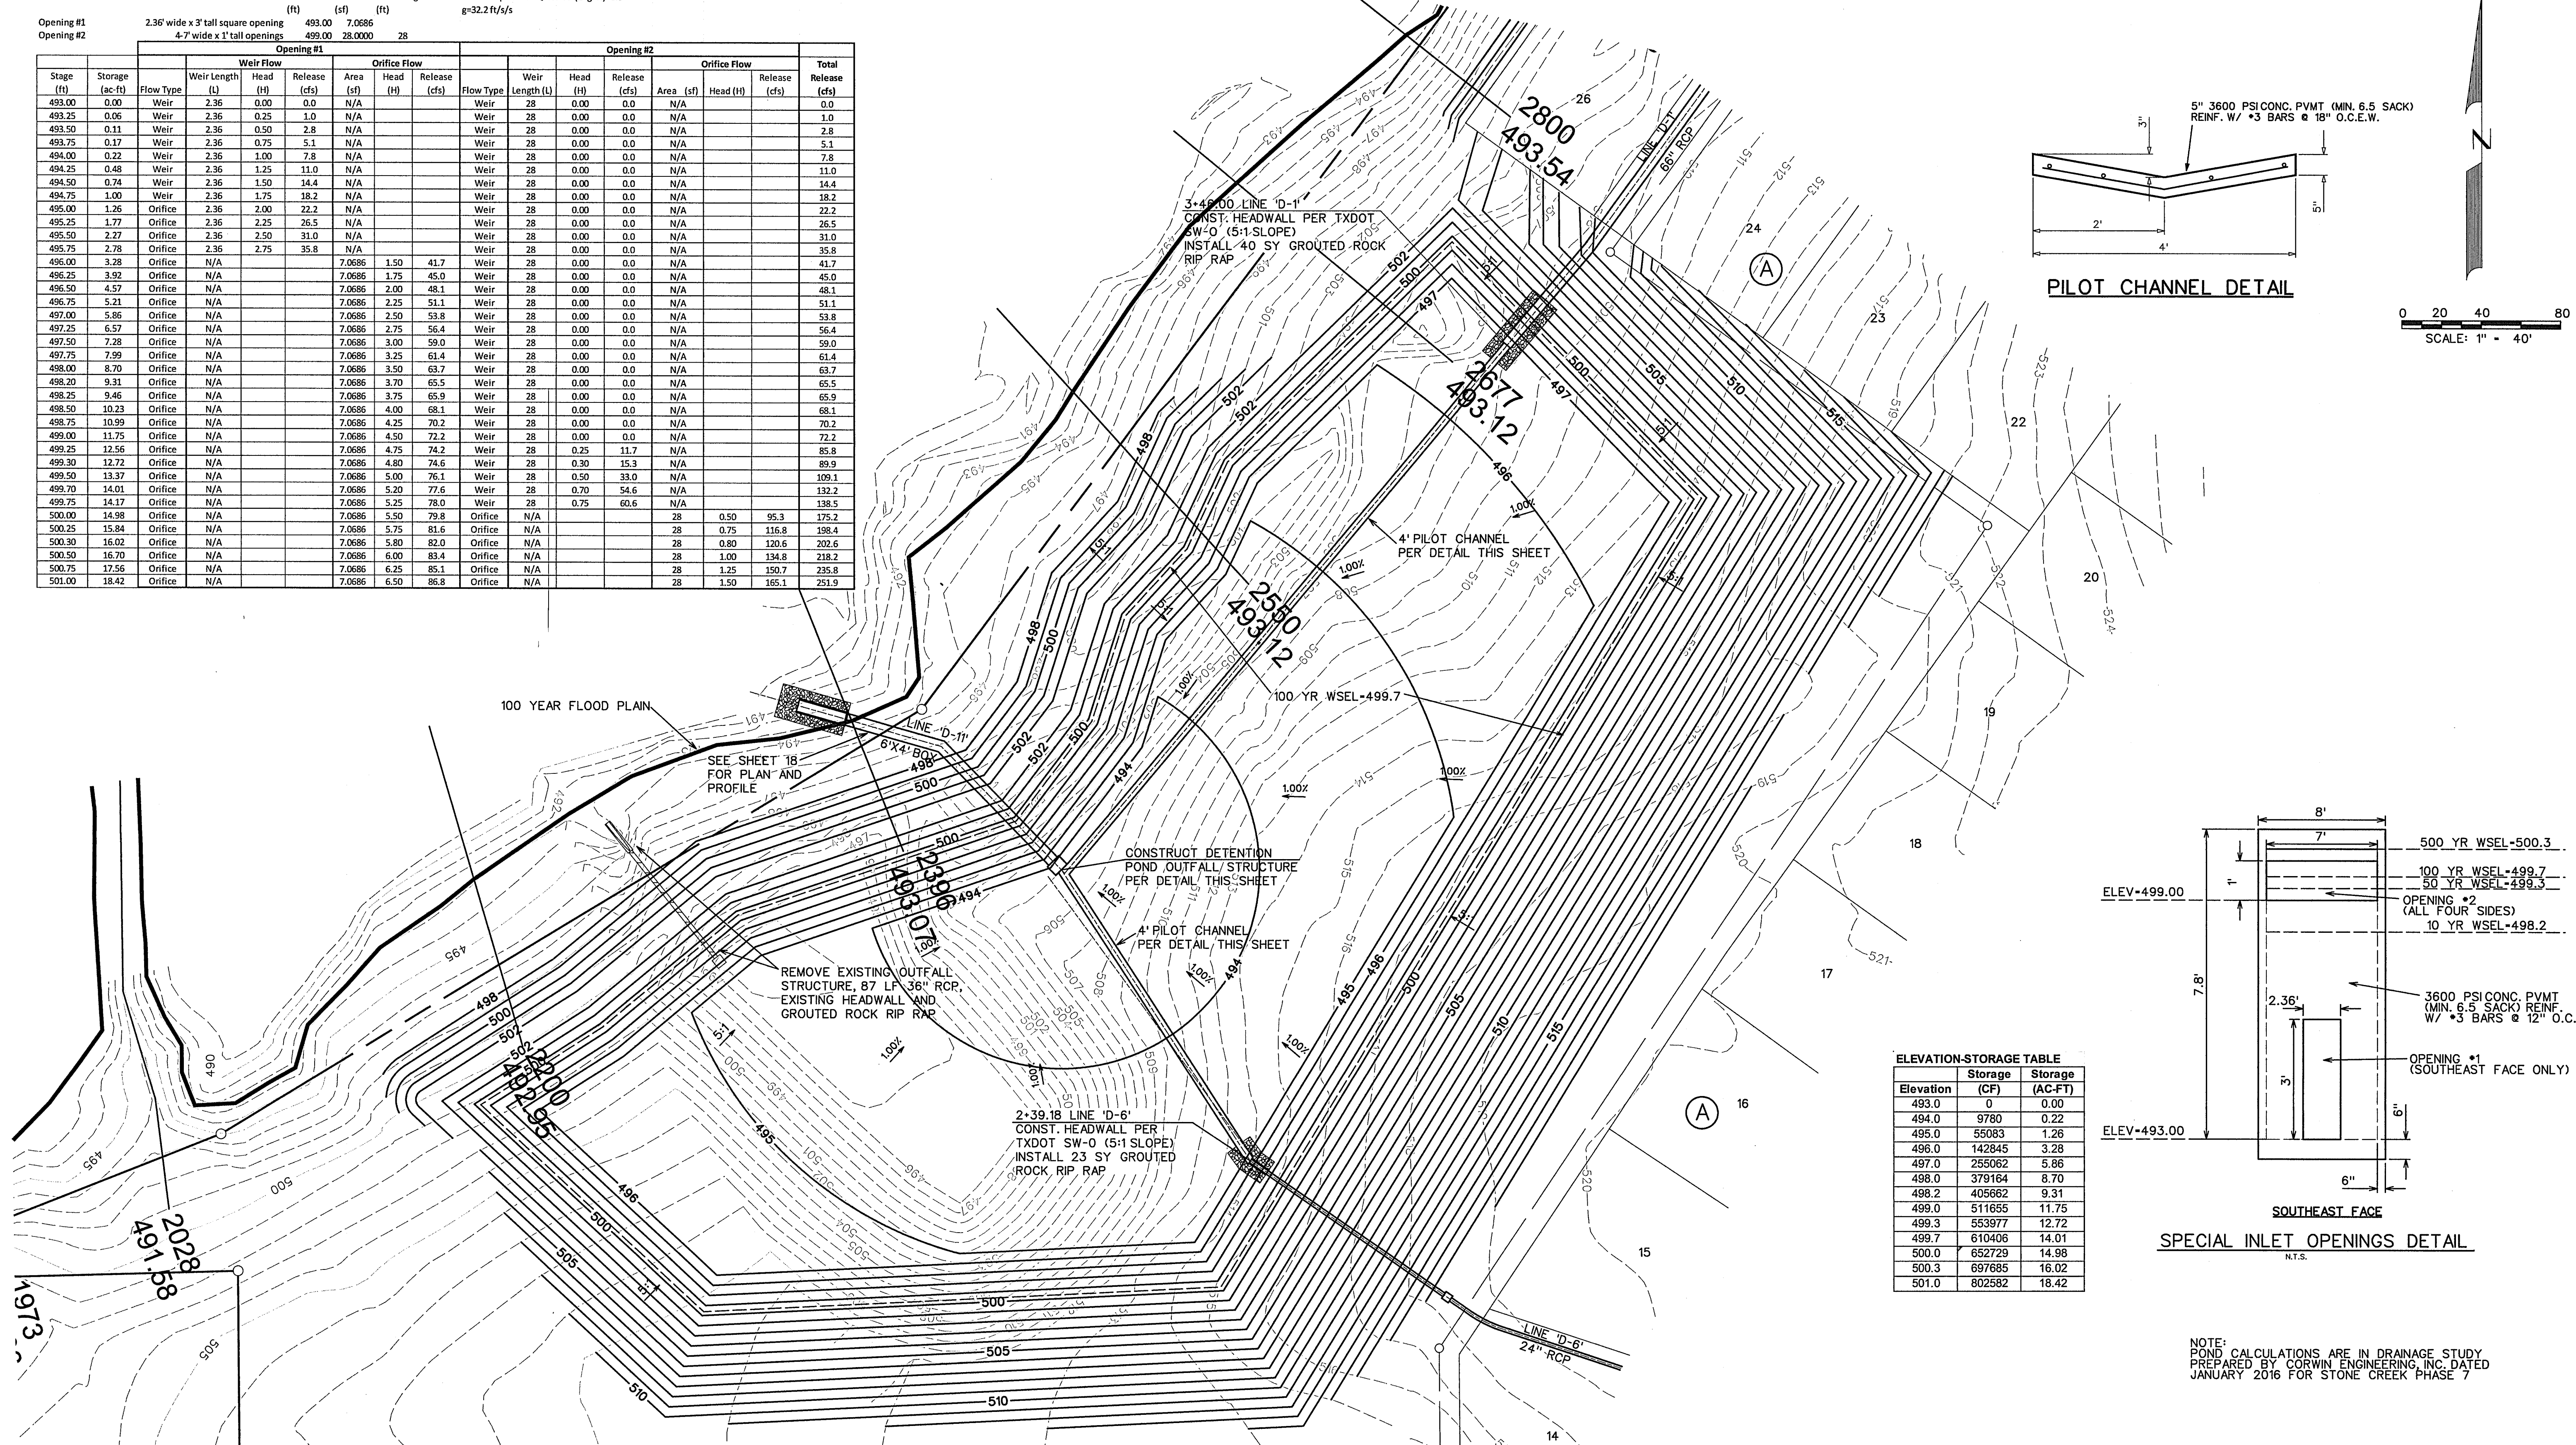

ELEVATION-STORAGE TABLE

Elevation	Storage (CF)	Storage (AC-FT)
493.0	0	0.00
494.0	9780	0.22
495.0	55083	1.26
496.0	142845	3.28
497.0	255062	5.86
498.0	379164	8.70
498.2	405662	9.31
499.0	511655	11.75
499.3	553977	12.72
499.7	610406	14.01
500.0	652729	14.98
500.3	687685	16.02
501.0	802582	18.42

NOTE: POND CALCULATIONS ARE IN DRAINAGE STUDY PREPARED BY CORWIN ENGINEERING, INC. DATED JANUARY 2016 FOR STONE CREEK PHASE 7

AS-BUILT DECEMBER 2016
INFORMATION PROVIDED BY CONTRACTORS (NOT FIELD VERIFIED)




CORWIN ENGINEERING, INC.
200 W. BELMONT, SUITE E
ALLEN, TEXAS 75013 (972)396-1200
TBPE FIRM #5951

DEVELOPMENT PLANS FOR
STONE CREEK PHASE VII
ROCKWALL, TEXAS

DETENTION POND PLAN

DRAWN BY	DESIGNED BY	CHECKED BY	SHEET NO.
JOB NUMBER	DATE	SCALE: HOR: 1"=40' VER: 1"=4'	25 of 31

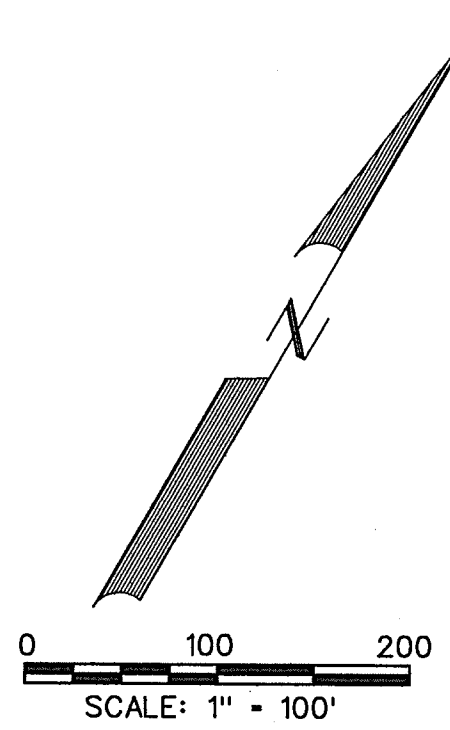

100 YEAR FLOOD PLAN FULLY DEVELOPED IN CULVERT

LIMITS OF 100 YEAR FLOOD PLAN PER LOMR CASE NUMBER 14-06-0263P FOR FEMA FIRM PANEL 48397C0030L, EFFECTIVE DATE SEPTEMBER 3, 2014

LIMITS OF 100 YEAR FLOOD PLAN PER LOMR CASE NUMBER 14-06-0263P FOR FEMA FIRM PANEL 48397C0030L, EFFECTIVE DATE SEPTEMBER 3, 2014

PROPOSED LIMITS OF 100 YEAR FLOOD PLAN
 LIMITS OF 100 YEAR FLOOD PLAN PER LOMR CASE NUMBER 14-06-0263P FOR FEMA FIRM PANEL 48397C0030L, EFFECTIVE DATE SEPTEMBER 3, 2014



AS-BUILT DECEMBER 2016
 INFORMATION PROVIDED BY CONTRACTORS (NOT FIELD VERIFIED)

NOTES:
 1. CROSS SECTION ELEVATION DATA WAS OBTAINED BY A TOPOGRAPHIC SURVEY OF THE SITE PERFORMED BY HINE-THOMPSON LAND SURVEYING IN OCTOBER 2012 AND ELEVATIONS ARE TIED TO CITY OF ROCKWALL CONTROL MONUMENTS 10 AND 16 WHICH ARE BASED ON NAVD 88

FULLY DEVELOPED CONDITIONS 100-Year HEC RAS RESULTS

River Sta	Q Total (cfs)	Min Ch El (ft)	W.S. Elev (ft)	Crit W.S. (ft)	E.G. Elev (ft)	E.G. Slope (ft/ft)	Vel Chnl (ft/s)	Flow Area (sq ft)	Top Width (ft)
4830	455.6	519.35	521.20	521.20	521.74	0.02	5.92	77.60	77.07
4587	455.6	513.00	519.73	519.73	519.74	0.00	0.92	540.85	138.25
4437	393.8	513.00	519.73	513.68	519.73	0.00	0.36	1108.56	220.29
4338									
4291	393.8	510.40	513.13	513.13	513.51	0.03	5.53	92.42	112.77
4188	393.8	508.32	511.13	510.89	511.28	0.02	3.86	131.88	130.27
3967	393.8	501.10	505.64	505.54	506.12	0.03	6.23	81.91	71.62
3831	393.8	498.10	503.32	503.52	503.52	0.01	3.75	112.13	55.22
3669	393.8	496.18	501.87	502.02	502.02	0.01	3.53	133.78	71.01
3525	393.8	495.50	500.12	500.50	500.50	0.02	5.06	82.02	39.97
3310	395.2	492.48	498.20	498.33	498.33	0.01	2.94	134.35	48.27
3134	395.2	491.51	496.42	495.52	496.75	0.01	4.98	93.37	49.61
2997	458.9	492.00	495.02	493.58	495.23	0.01	3.65	125.71	84.24
2957									
2917	458.9	491.30	493.58	493.58	494.26	0.05	6.91	72.34	73.13
2800	458.9	490.60	493.54	493.57	493.57	0.00	1.44	330.12	145.97
2677	458.9	490.30	493.12	493.26	493.26	0.01	3.71	167.40	118.58
2550	458.9	489.63	493.12	493.14	493.14	0.00	1.29	424.70	160.63
2396	478.4	489.63	493.07	493.00	493.00	0.00	1.96	247.98	88.30
2200	478.4	489.63	492.95	493.01	493.01	0.00	1.96	247.98	88.30
2028	478.4	487.50	491.58	491.52	492.57	0.05	7.39	59.95	28.07
1973	478.4	488.58	492.06	492.07	492.07	0.00	0.49	983.28	292.42
1917	478.4	489.00	491.74	491.74	492.03	0.04	6.50	137.16	243.22
1716	478.4	478.80	480.59	480.69	480.69	0.01	2.56	190.34	141.50
1622	433.0	476.05	480.45	480.47	480.47	0.00	1.46	361.78	135.01
1538	433.0	474.84	480.41	480.43	480.43	0.00	1.05	503.41	153.85
1422	433.0	471.64	480.39	480.40	480.40	0.00	0.97	627.42	156.40
1284	433.0	471.53	480.38	480.39	480.39	0.00	0.59	1038.33	235.64
1202	438.0	470.45	480.38	474.00	480.38	0.00	0.58	1269.35	292.21
1119.5									

EXISTING CONDITIONS 100-Year HEC RAS RESULTS

River Sta	Q Total (cfs)	Min Ch El (ft)	W.S. Elev (ft)	Crit W.S. (ft)	E.G. Elev (ft)	E.G. Slope (ft/ft)	Vel Chnl (ft/s)	Flow Area (sq ft)	Top Width (ft)
4830	428.8	519.35	521.15	521.15	521.68	0.02	5.84	73.74	75.26
4587	428.8	513.00	519.73	519.74	519.74	0.00	0.86	540.77	138.23
4437	390.4	513.00	519.73	513.68	519.73	0.00	0.35	1108.31	220.27
4338									
4291	390.4	510.40	513.12	513.12	513.50	0.03	5.52	91.84	112.62
4188	347.7	508.32	511.31	510.99	511.52	0.02	4.42	156.06	133.57
3967	347.7	501.10	506.05	506.46	506.46	0.03	6.19	121.07	97.77
3831	347.7	498.10	503.77	504.02	504.02	0.01	4.29	138.02	61.01
3669	347.7	496.18	502.39	502.56	502.56	0.01	3.73	171.72	76.22
3525	347.7	494.80	500.69	501.03	501.03	0.02	5.16	127.32	62.80
3310	347.7	492.48	498.89	499.05	499.05	0.01	3.24	170.55	56.24
3134	347.7	491.51	496.55	497.08	497.08	0.03	6.19	102.22	51.89
2997	345.5	491.25	495.22	495.35	495.35	0.01	3.14	190.17	84.83
2917	345.5	491.50	494.25	494.57	494.57	0.02	5.10	126.66	80.77
2800	345.5	490.60	494.22	494.25	494.25	0.00	1.31	433.16	154.87
2677	345.5	490.30	494.03	494.10	494.10	0.00	2.53	284.05	137.73
2550	345.5	489.63	494.02	494.04	494.04	0.00	1.17	578.82	180.89
2396	345.5	489.63	494.00	494.02	494.02	0.00	1.13	594.51	243.55
2200	345.5	489.63	493.95	493.98	493.98	0.00	1.48	463.80	268.33
2028	345.5	489.63	493.23	493.23	493.77	0.03	7.02	110.41	102.54
1973	345.5	488.58	491.95	491.95	491.95	0.02	5.57	179.31	290.75
1917	345.5	488.58	491.62	491.62	491.62	0.00	1.80	317.35	163.90
1716	345.5	478.80	481.42	481.46	481.46	0.00	1.16	492.36	151.42
1622	463.4	476.05	481.36	481.37	481.37	0.00	0.88	656.10	175.33
1538	463.4	474.84	481.34	481.35	481.35	0.00	0.88	656.10	175.33
1422	463.4	471.64	481.33	481.33	481.33	0.00	0.84	780.49	170.17
1284	463.4	471.53	481.32	481.32	481.32	0.00	0.52	1269.59	256.87
1202	469.7	470.45	481.32	474.08	481.32	0.00	0.50	1552.52	310.40
1119.5									

CORWIN ENGINEERING, INC.
 200 W. BELMONT, SUITE E
 ALLEN, TEXAS 75013 (972)396-1200
 TBPE FIRM #5951

DEVELOPMENT PLANS FOR
 STONE CREEK
 PHASE VII
 ROCKWALL, TEXAS

FLOOD PLAIN WORKMAP

DRAWN BY	DESIGNED BY	CHECKED BY	SHEET NO.
JOB NUMBER	DATE	SCALE	26 OF 31
15047	MARCH 2016	1"=100'	

SCALE: 1" = 50'



NOTE:
RETAINING WALLS 3' IN HEIGHT AND OVER NEED AN ENGINEERED SEALED PLAN. (PLANS TO BE SUBMITTED PRIOR TO ENGINEERING APPROVAL)

Note:
Each lot will need a detailed grading plan with building permit submittal. This is a general grading plan for site work only.


LEGEND

SPOT ELEVATION	706.2
EXIST. CONTOUR	— 700 —
PROP. CONTOUR	— 704 —
RETAINING WALL	-----

BENCHMARK:
CITY OF ROCKWALL SURVEY MONUMENT ON AN INLET AT THE NORTHWEST CORNER OF FEATHERSTONE DR. AND HARVARD DR. ELEV. = 525.31

DRIVEWAY LOCATION SO MAXIMUM 14% SLOPE OR UNDER IS MAINTAINED, OR AS TO AVOID INLET OR MIN. DISTANCE FROM INTERSECTION (DRIVEWAY MAY BE PLACED AT ALTERNATE LOCATION WITH USE OF A DROP GARAGE AS LONG AS MAXIMUM SLOPE IS 14% OR UNDER)


- NOTES:**
1. Finish Floor Elevation to be 0.70 Feet above Finished Pad.(FP)
 2. Additional Erosion Control to be installed in Parkways as determined by the City Inspector.
 3. Finished Pad Elevations are within ± 0.3 Feet.
 4. All fill compacted to min 95% std. density using sheeps foot roller.
 5. All portions of the wall to be on one lot. Do not install on property line or in easements or right of way.

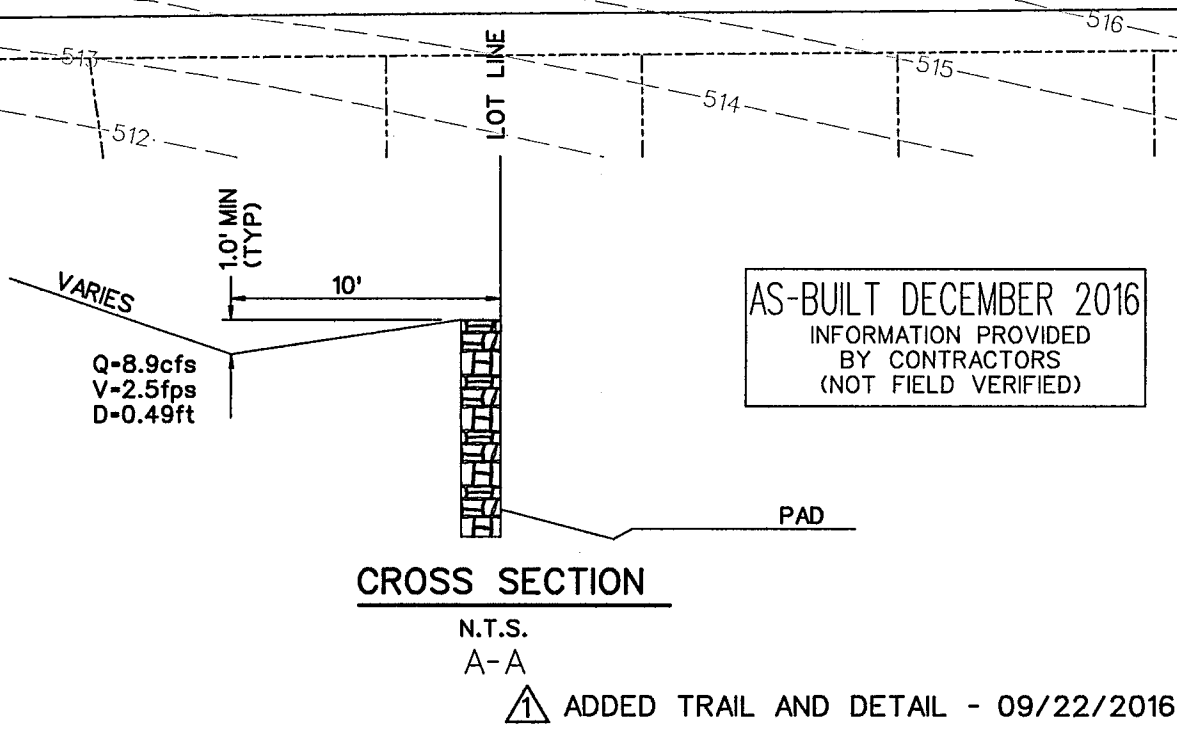


CORWIN ENGINEERING, INC.
200 W. BELMONT, SUITE E
ALLEN, TEXAS 75013 (972)396-1200
TBPE FIRM #5951

**DEVELOPMENT PLANS FOR
STONE CREEK
PHASE VII
ROCKWALL, TEXAS**

GRADING PLAN

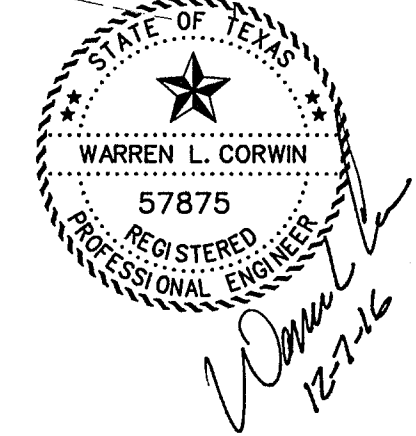


DRAWN BY	DESIGNED BY	CHECKED BY	SHEET NO.
JOB NUMBER	DATE	SCALE:	27 OF 31
15047	MARCH 2016	1"=50'	

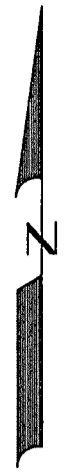

SCALE: 1" = 50'

CROSS SECTION
N.T.S.
B-B

CROSS SECTION
N.T.S.
C-C

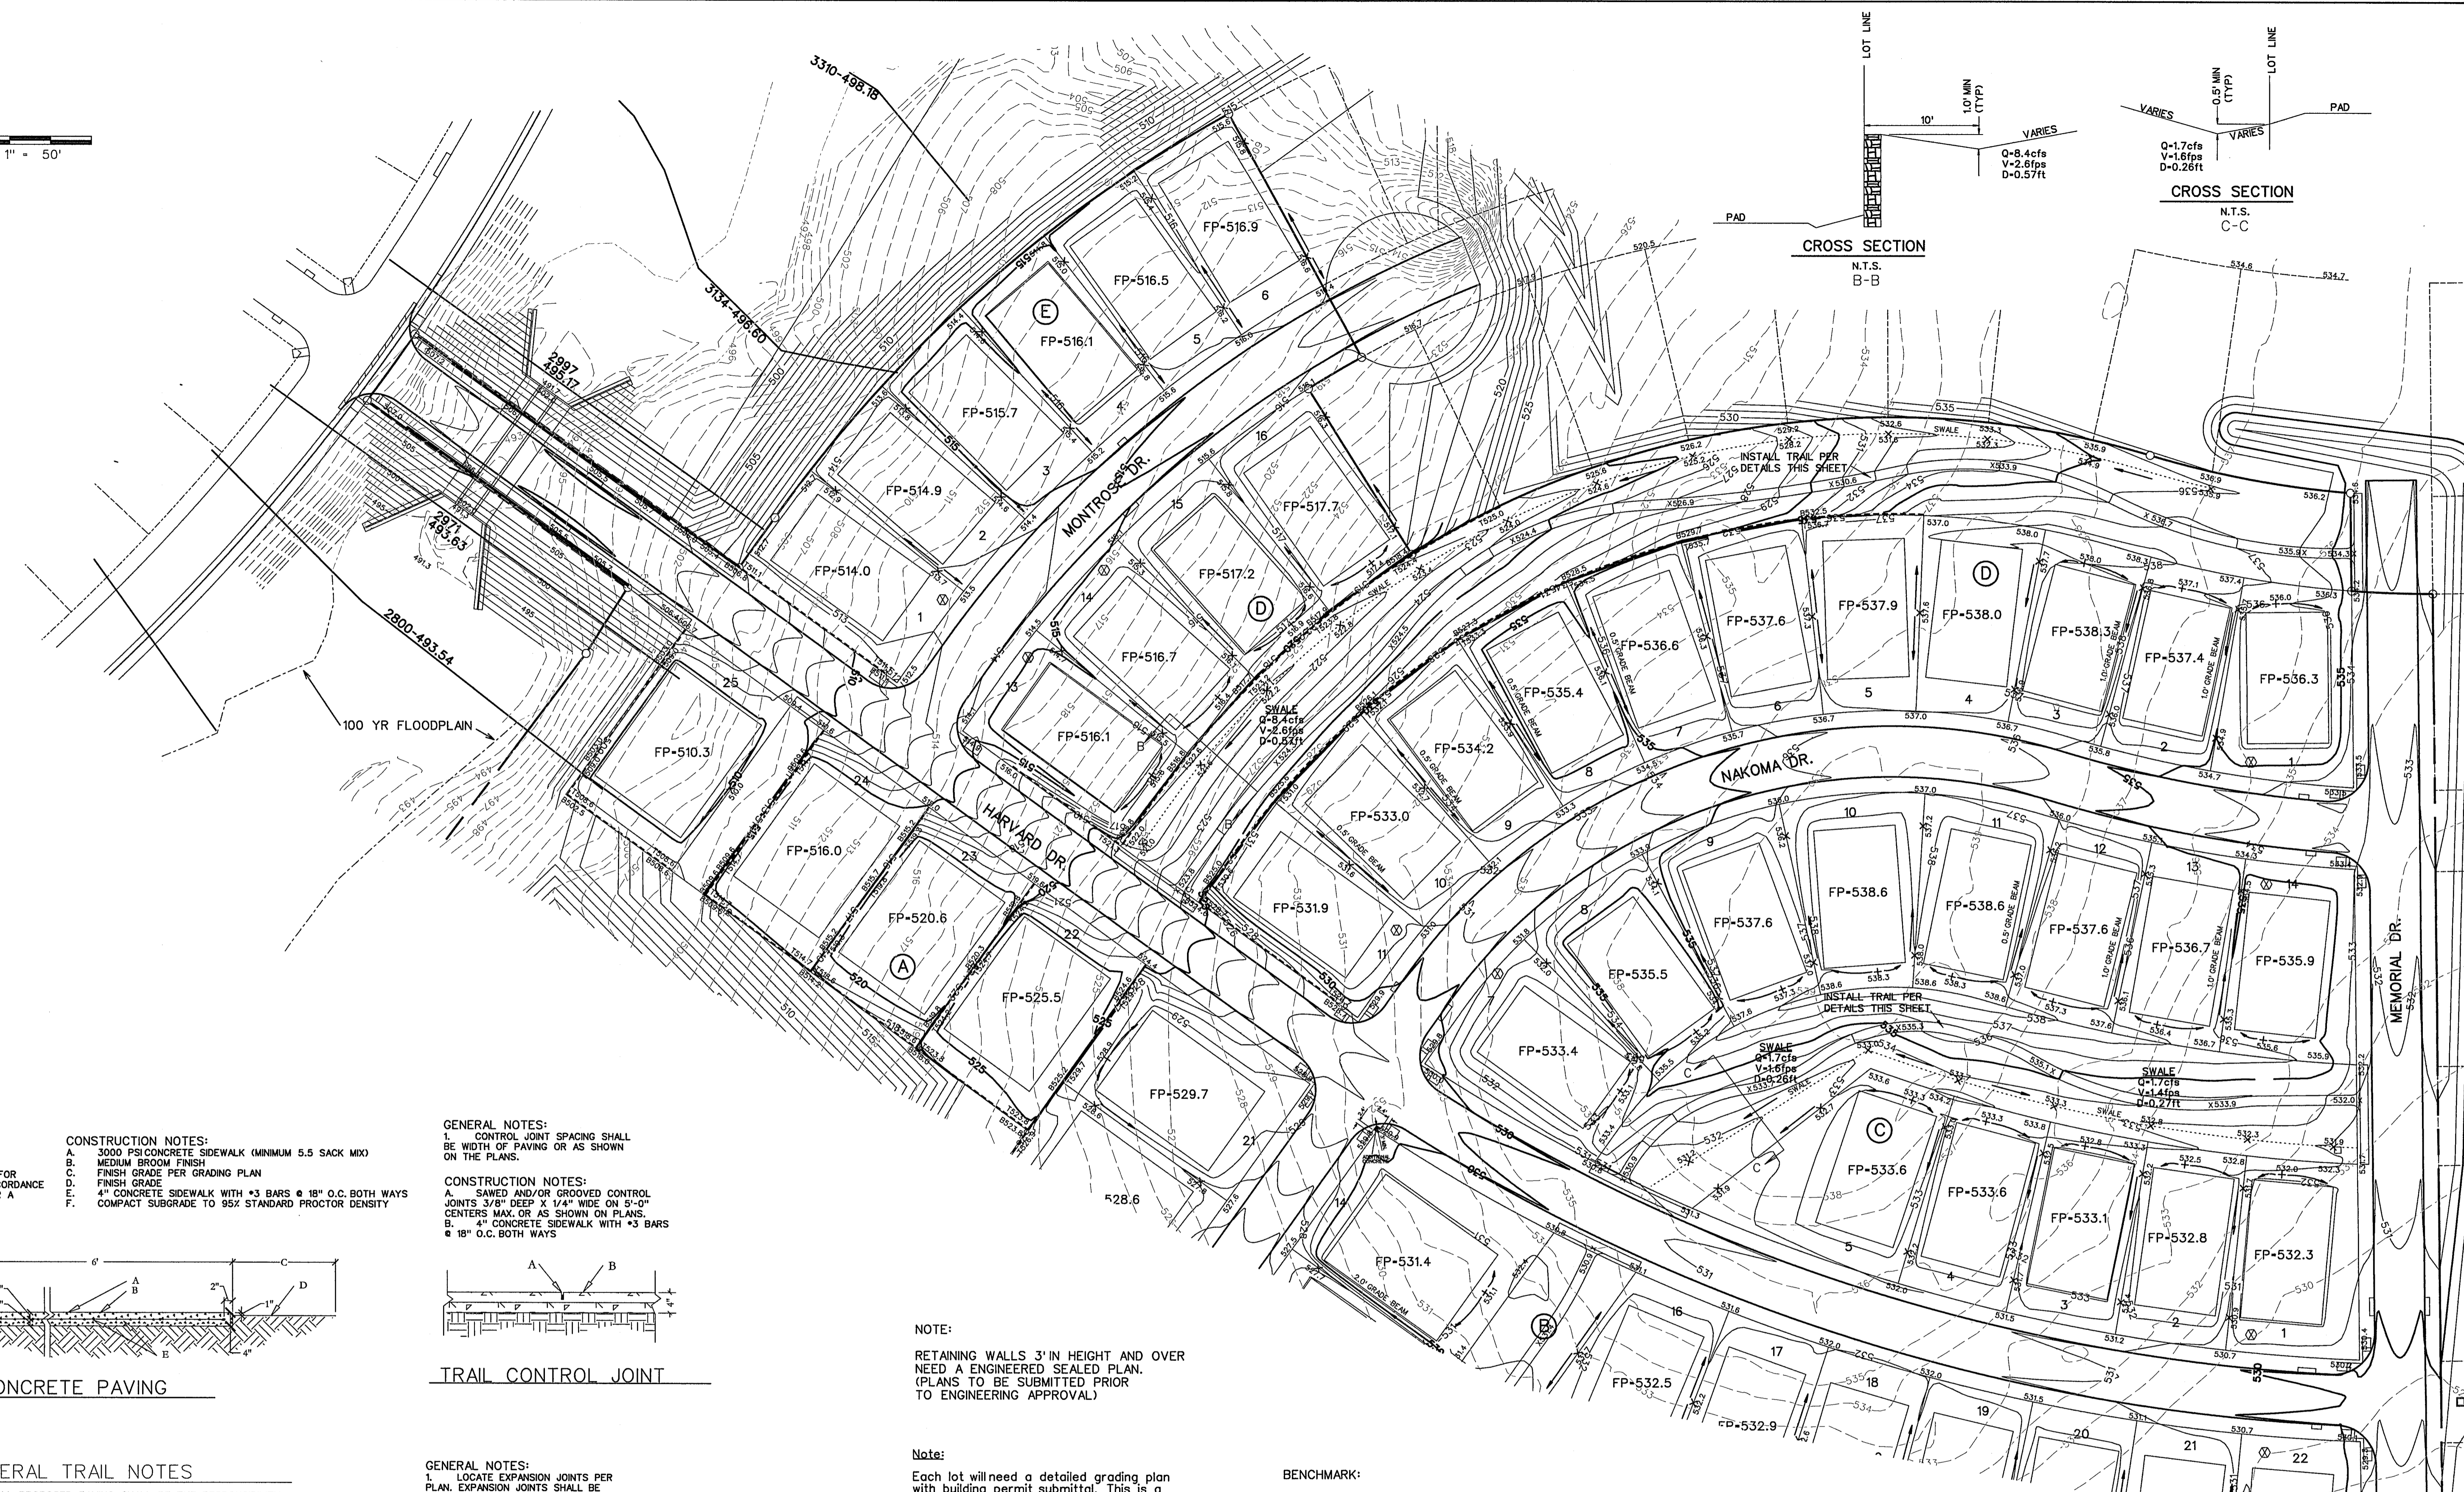

- GENERAL NOTES:**
- PAVING TO HAVE A MAXIMUM 2% CROSS SLOPE AS SHOWN.
 - THE MATERIALS AND WORKMANSHIP FOR CONCRETE PAVING SHALL BE IN ACCORDANCE WITH N.C.T.C.O.G. SPECIFICATIONS OR A MODIFIED BY THE CITY.

- CONSTRUCTION NOTES:**
- 3000 PSI CONCRETE SIDEWALK (MINIMUM 5.5 SACK MIX)
 - MEDIUM BROOM FINISH
 - FINISH GRADE PER GRADING PLAN
 - FINISH GRADE
 - 4" CONCRETE SIDEWALK WITH #3 BARS @ 18" O.C. BOTH WAYS
 - COMPACT SUBGRADE TO 95% STANDARD PROCTOR DENSITY

- GENERAL NOTES:**
- CONTROL JOINT SPACING SHALL BE WIDTH OF PAVING OR AS SHOWN ON THE PLANS.
- CONSTRUCTION NOTES:**
- SAWED AND/OR GROOVED CONTROL JOINTS 3/8" DEEP X 1/4" WIDE ON 5'-0" CENTERS MAX. OR AS SHOWN ON PLANS.
 - 4" CONCRETE SIDEWALK WITH #3 BARS @ 18" O.C. BOTH WAYS

NOTE:

RETAINING WALLS 3' IN HEIGHT AND OVER NEED AN ENGINEERED SEALED PLAN. (PLANS TO BE SUBMITTED PRIOR TO ENGINEERING APPROVAL)

Note:

Each lot will need a detailed grading plan with building permit submittal. This is a general grading plan for site work only.

- LEGEND**
- SPOT ELEVATION 708.2
 - EXIST. CONTOUR — 700 —
 - PROP. CONTOUR — 704 —
 - RETAINING WALL - - - - -



⊗ DRIVEWAY LOCATION SO MAXIMUM 14% SLOPE OR UNDER IS MAINTAINED, OR AS TO AVOID INLET OR MIN. DISTANCE FROM INTERSECTION (DRIVEWAY MAY BE PLACED AT ALTERNATE LOCATION WITH USE OF A DROP GARAGE AS LONG AS MAXIMUM SLOPE IS 14% OR UNDER)

BENCHMARK:


CITY OF ROCKWALL SURVEY MONUMENT ON AN INLET AT THE NORTHWEST CORNER OF FEATHERSTONE DR. AND HARVARD DR. ELEV. - 525.31

- NOTES:**
- Finish Floor Elevation to be 0.70 Feet above Finished Pad.(FP)
 - Additional Erosion Control to be installed in Parkways as determined by the City Inspector.
 - Finished Pad Elevations are within ± 0.3 Feet.
 - All fill compacted to min 95% std. density using sheeps foot roller.
 - All portions of the wall to be on one lot. Do not install on property line or in easements or right of way.

AS-BUILT DECEMBER 2016
INFORMATION PROVIDED BY CONTRACTORS (NOT FIELD VERIFIED)

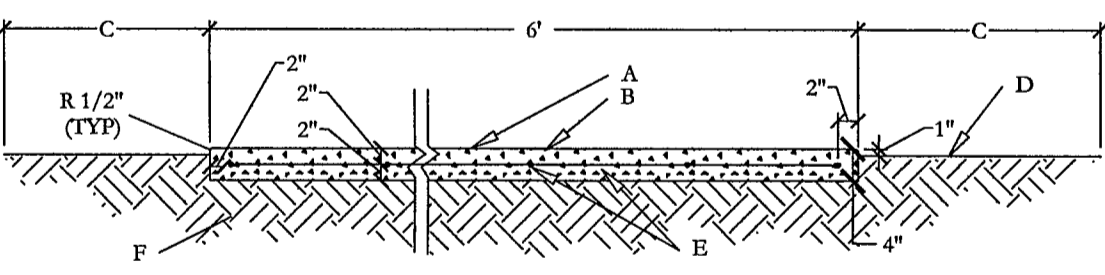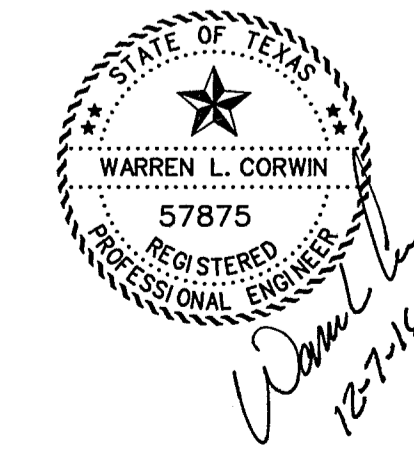


TRAIL CONCRETE PAVING

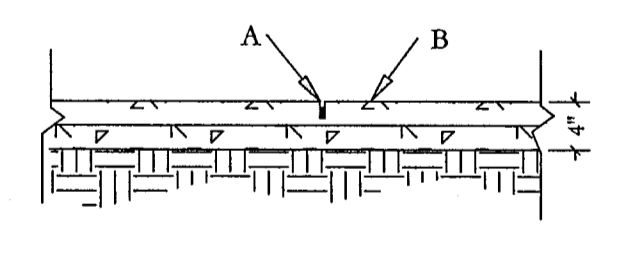

TRAIL CONTROL JOINT

GENERAL TRAIL NOTES

- THE LAYOUT OF ALL PROPOSED PAVING SHALL BE THE RESPONSIBILITY OF THE CONTRACTOR AND SHALL BE REVIEWED BY THE OWNER'S REPRESENTATIVE PRIOR TO CONSTRUCTION.
- ALL PAVING CONSTRUCTION SHALL BE IN ACCORDANCE WITH THE CONSTRUCTION DETAILS SHOWN HEREIN.
- THE SUB GRADE BENEATH ALL PAVING SHALL BE COMPACTED TO 95% STANDARD PROCTOR DENSITY.
- THE EDGES OF ALL FINISHED PAVING AND PLAYGROUND EDGES SHALL BE SMOOTH, GRACEFUL, CURVILINEAR OR STRAIGHTFORMS WITH NO INTERRUPTIONS SUCH AS CHORDS, WAVES, JOCS, OR MISSED TANGENTS. ANY PAVEMENT WITH SUCH INTERRUPTIONS SHALL BE SUBJECT TO REPLACEMENT AT NO COST TO THE OWNER.
- CONCRETE SHALL NOT BE POURED UNTIL THE OWNER'S REPRESENTATIVE HAS INSPECTED THE FORMS AND REINFORCING. THE CONTRACTOR SHALL NOTIFY THE OWNER'S REPRESENTATIVE AT LEAST 48 HOURS IN ADVANCE OF ALL CONCRETE POURS.
- PROVIDE AN UNDERCUT HEADER WHEREVER PROPOSED CONCRETE PAVING IS TO ABUT EXISTING CONCRETE PAVING.
- ALL EXPOSED VERTICAL CONCRETE SURFACES SHALL HAVE A HAND RUBBED FINISH WITH NO HONEYCOMBS OR VOIDS.
- ALL CONSTRUCTION SHALL CONFORM WITH THE CITY OF ROCKWALL CONSTRUCTION STANDARDS AND DETAILS.

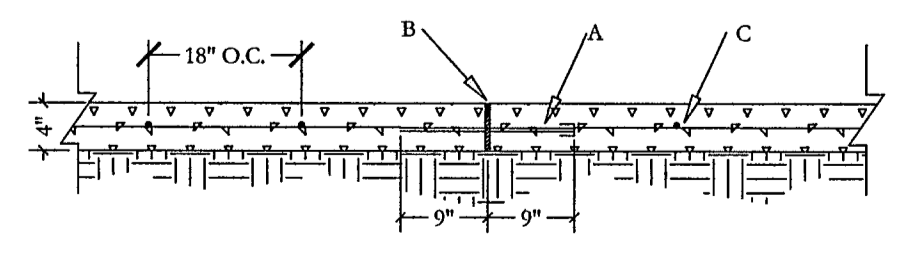


DOWELED EXPANSION JOINT

<p>CORWIN ENGINEERING, INC. 200 W. BELMONT, SUITE E ALLEN, TEXAS 75013 (972)396-1200 TBPE FIRM #5951</p>			
<p>DEVELOPMENT PLANS FOR STONE CREEK PHASE VII ROCKWALL, TEXAS</p>			
<p>GRADING PLAN</p>			
DRAWN BY	DESIGNED BY	CHECKED BY	SHEET NO.
JOB NUMBER	DATE	SCALE:	28 OF 31
15047	MARCH 2016	1"=50'	



SCALE: 1" = 50'

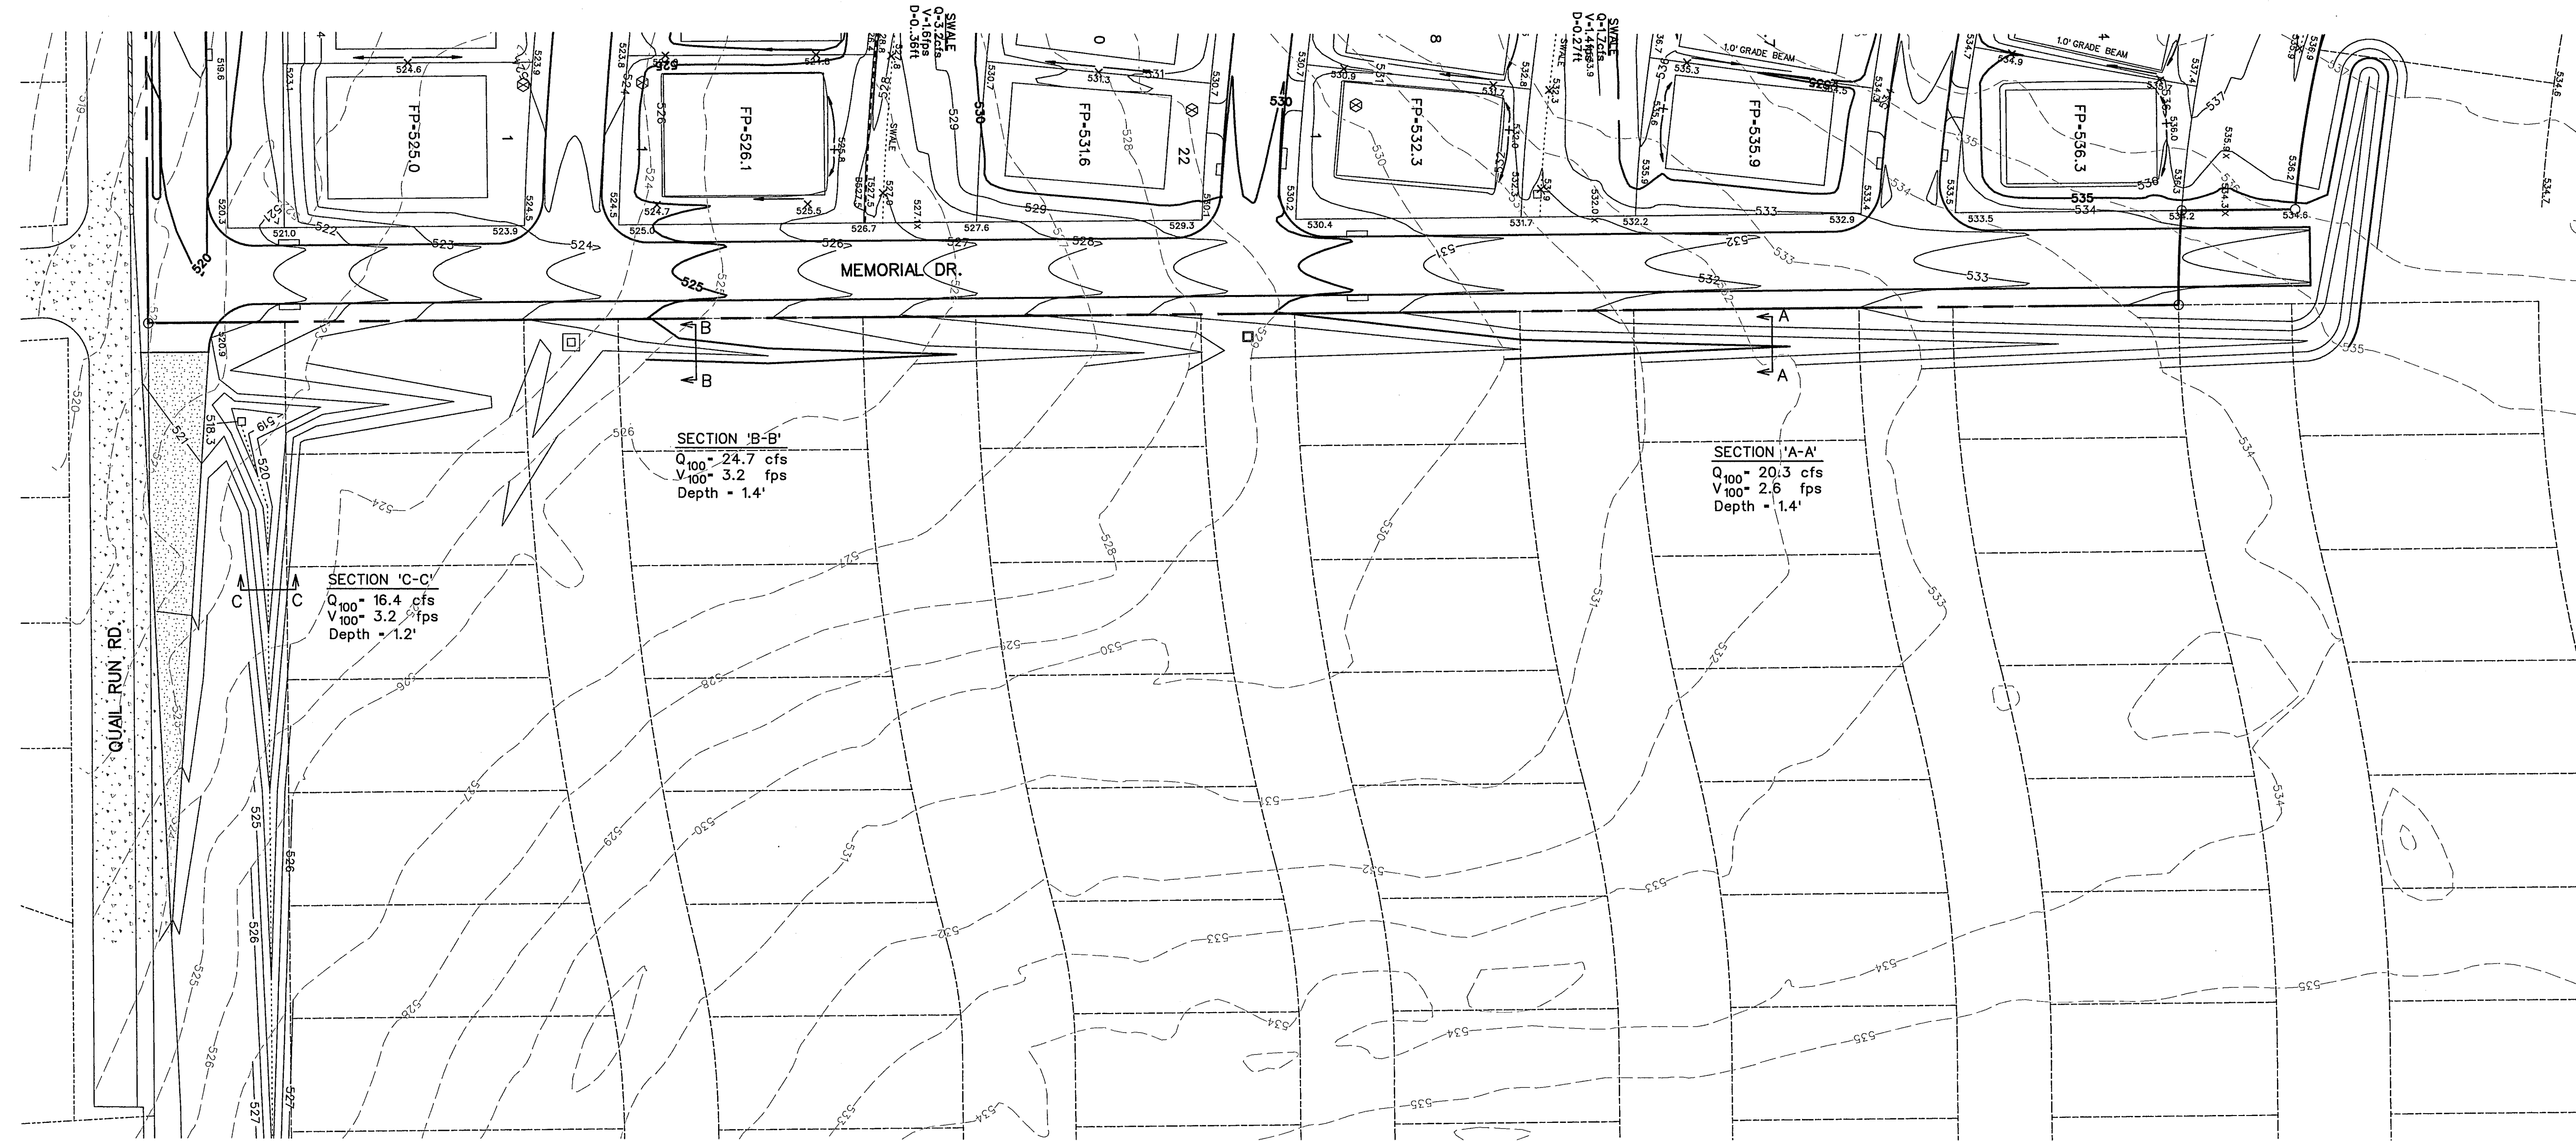

NOTE: RETAINING WALLS 3' IN HEIGHT AND OVER NEED AN ENGINEERED SEALED PLAN. (PLANS TO BE SUBMITTED PRIOR TO ENGINEERING APPROVAL)

Note: Each lot will need a detailed grading plan with building permit submittal. This is a general grading plan for site work only.

LEGEND

- SPOT ELEVATION 708.2
EXIST. CONTOUR -700-
PROP. CONTOUR -704-
RETAINING WALL - - - - -

BENCHMARK:

CITY OF ROCKWALL SURVEY MONUMENT ON AN INLET AT THE NORTHWEST CORNER OF FEATHERSTONE DR. AND HARVARD DR. ELEV.- 525.31

DRIVEWAY LOCATION SO MAXIMUM 14% SLOPE OR UNDER IS MAINTAINED, OR AS TO AVOID INLET OR MIN. DISTANCE FROM INTERSECTION (DRIVEWAY MAY BE PLACED AT ALTERNATE LOCATION WITH USE OF A DROP GARAGE AS LONG AS MAXIMUM SLOPE IS 14% OR UNDER)

NOTES:

- 1. Finish Floor Elevation to be 0.70 Feet above Finished Pad.(FP)
2. Additional Erosion Control to be installed in Parkways as determined by the City Inspector.
3. Finished Pad Elevations are within +/- 0.3 Feet.
4. All fill compacted to min 95% std. density using sheeps foot roller.
5. All portions of the wall to be on one lot. Do not install on property line or in easements or right of way.

AS-BUILT DECEMBER 2016
INFORMATION PROVIDED BY CONTRACTORS (NOT FIELD VERIFIED)



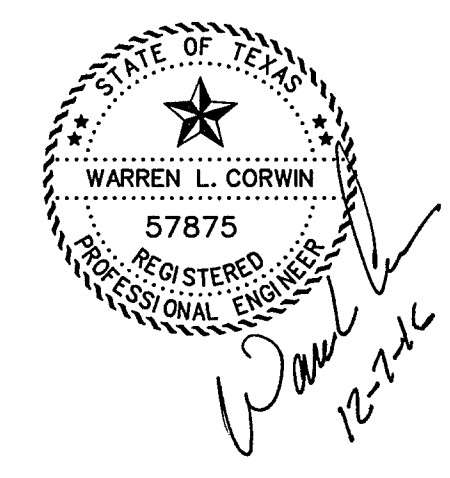


Table with project information including: CORWIN ENGINEERING, INC., DEVELOPMENT PLANS FOR STONE CREEK PHASE VII, GRADING PLAN, and a grid for DRAWN BY, DESIGNED BY, CHECKED BY, SHEET NO., JOB NUMBER, DATE, SCALE, and SHEET NO. (28B of 31).

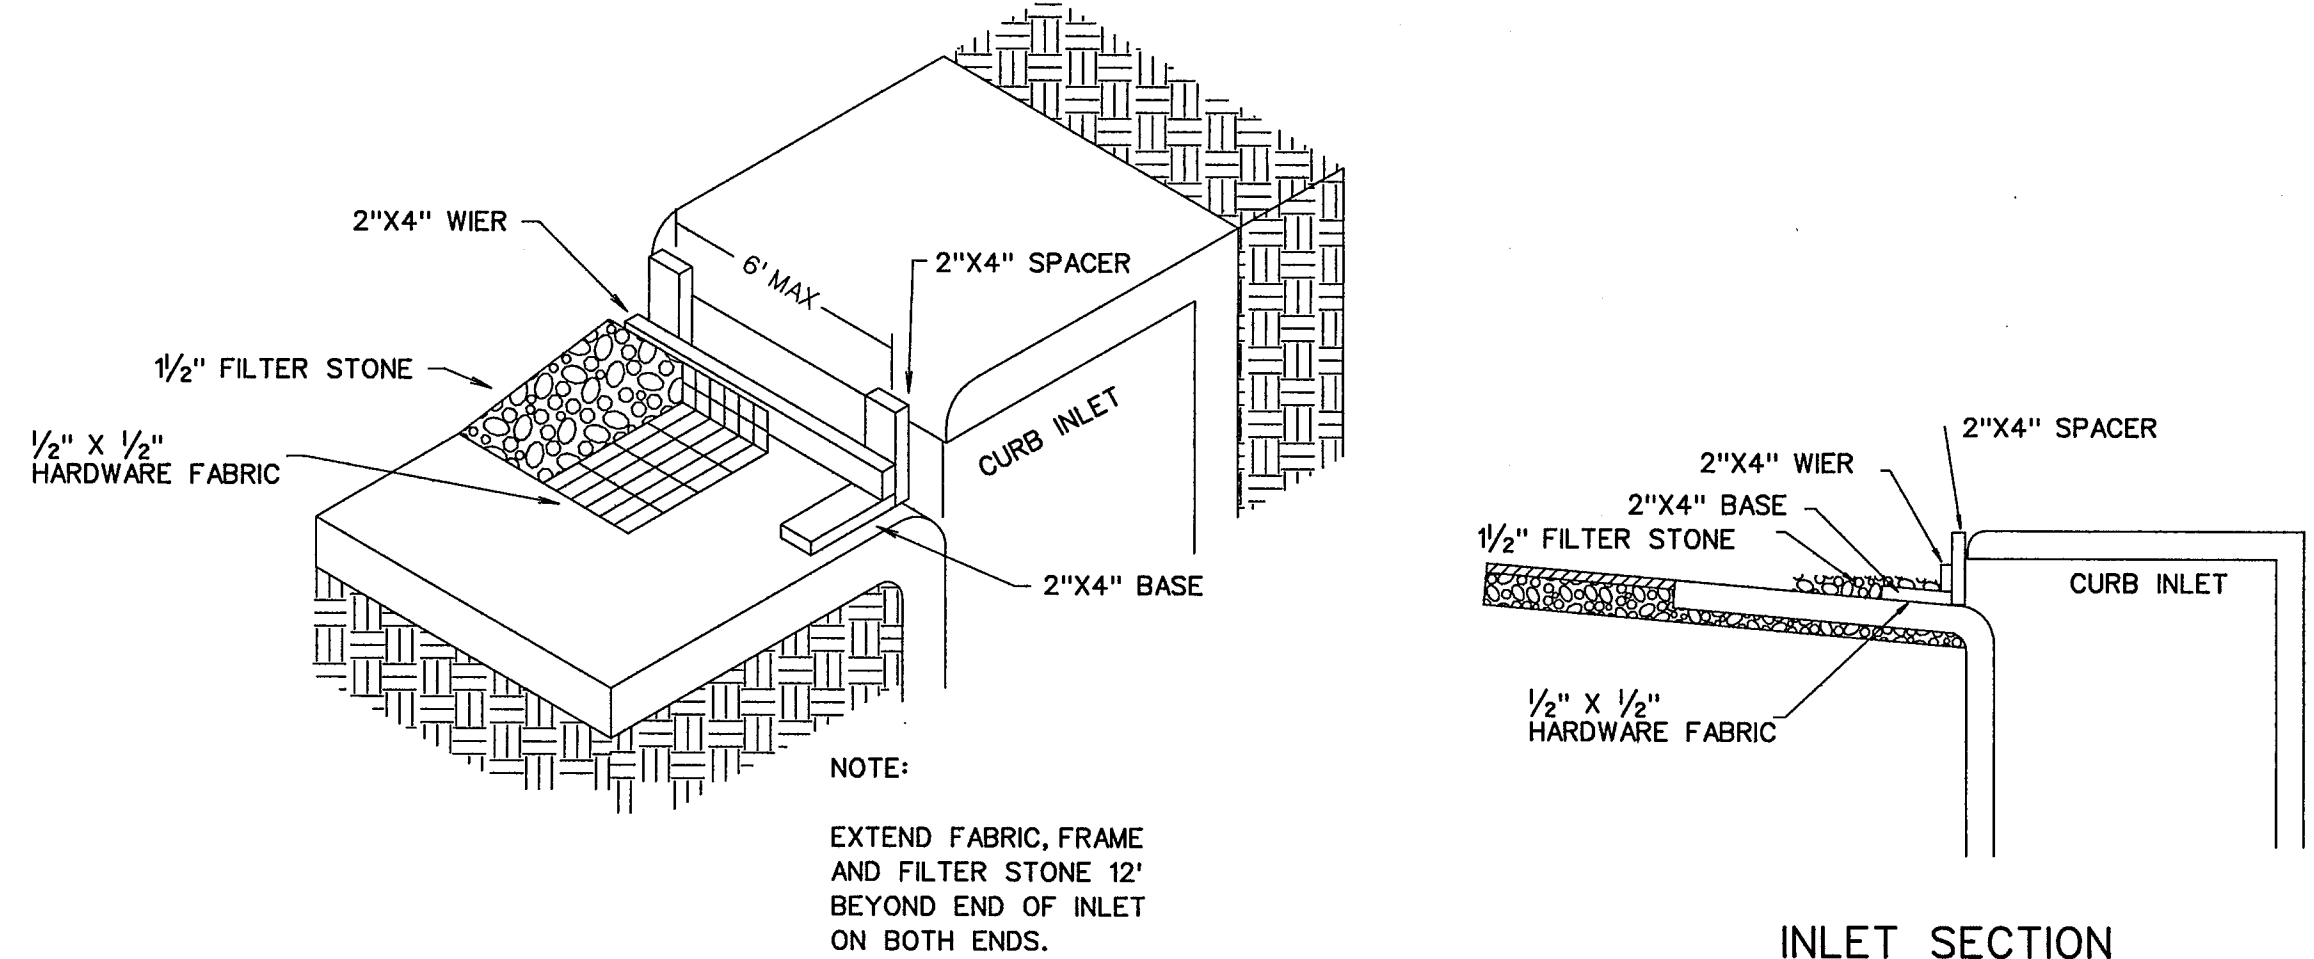



NOTE:
EXTEND FABRIC, FRAME AND FILTER STONE 12" BEYOND END OF INLET ON BOTH ENDS.

TYPE B CURB INLET PROTECTION

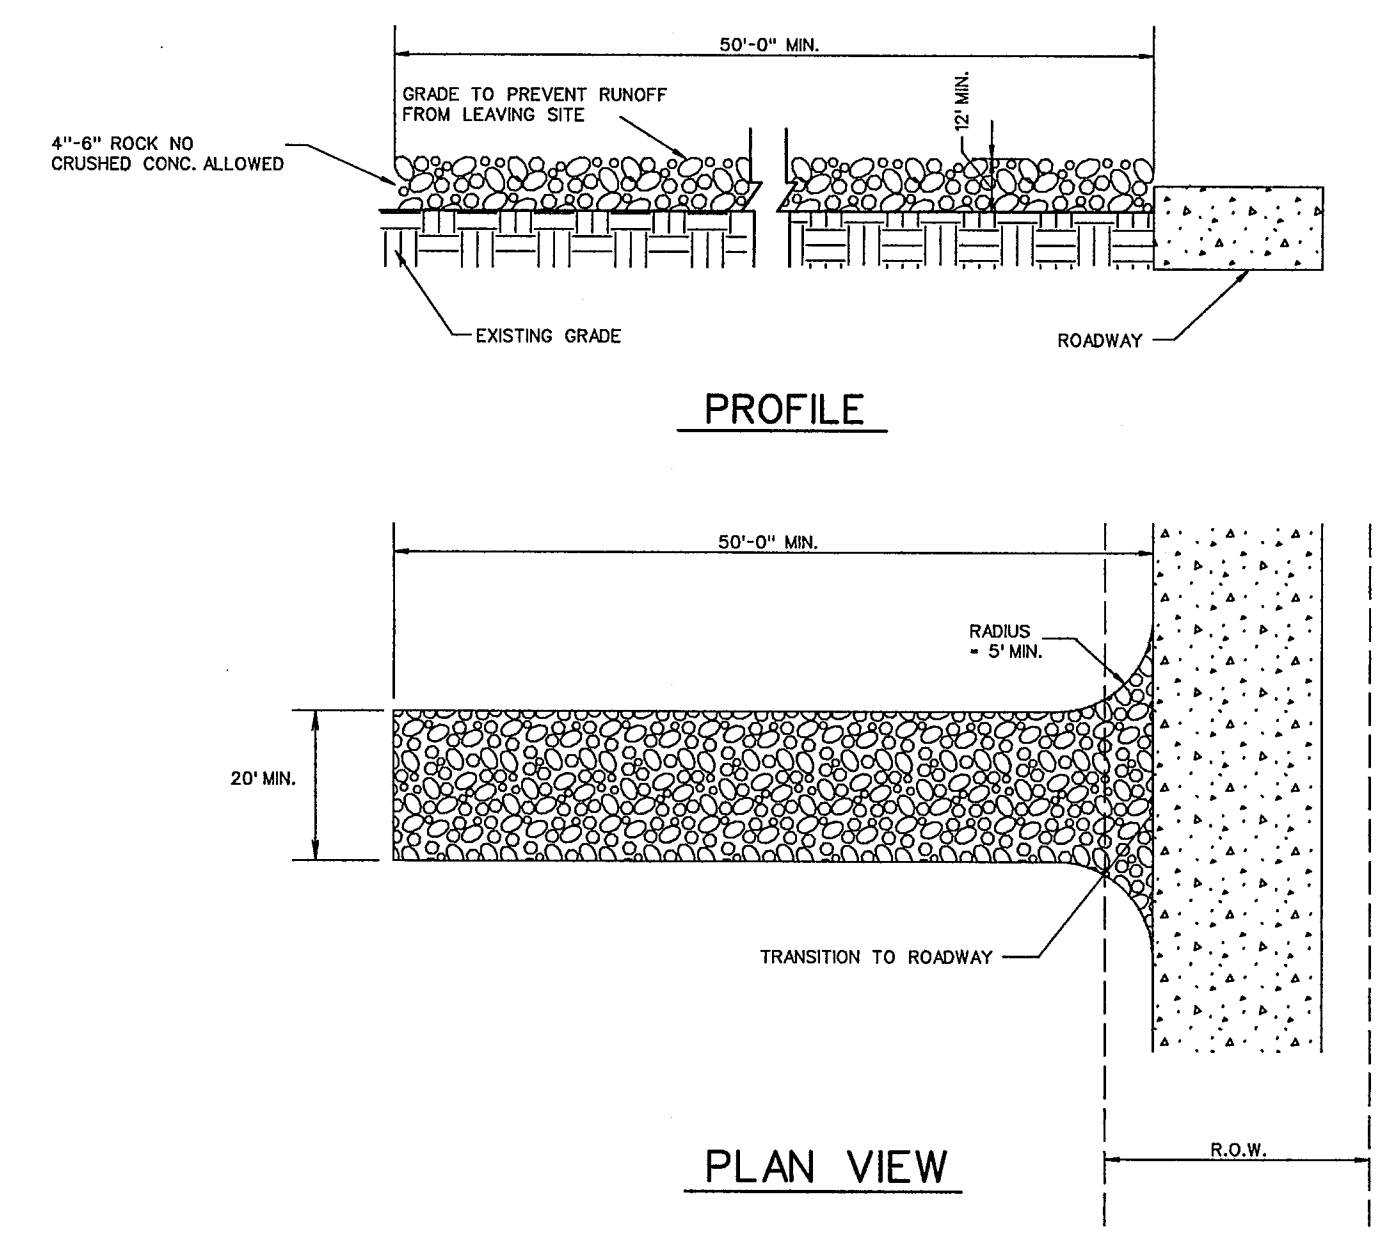

STABILIZED ENTRANCE DETAIL

- CONSTRUCTION SEQUENCE**
1. GRADING CONTRACTOR TO INSTALL TEMPORARY STABILIZED ENTRANCE.
 2. INSTALL SILT FENCE AS SHOWN, (TS-600 POLY FELT) PER C.O.G. SPECIFICATIONS.
 3. PERFORM GRADING AND UTILITY CONSTRUCTION.
 4. AFTER THE INLET BOTTOMS ARE CONSTRUCTED, THE INLETS SHALL BE FILLED WITH STONE AND COVERED WITH A FILTER FABRIC (TS-600 POLY FELT OR EQUIVALENT) BY UTILITY CONTRACTOR.
 5. PRIOR TO CITY RELEASING PAVING, SOD OR SEEDED CURLEX SHALL BE INSTALLED ON SIDES AND BOTTOM OF ALL DETENTION PONDS.
 6. AFTER PAVING AND COMPLETION OF INLETS, INLET FILTERS SHALL BE INSTALLED IN ALL INLETS AND MAINTAINED UNTIL RE-VEGETATION HAS BEEN COMPLETED BY PAVING CONTRACTOR.
 7. SILT FENCE SHALL REMAIN IN PLACE UNTIL RE-VEGETATION HAS BEEN COMPLETED.
 8. PAVING CONTRACTOR SHALL REMOVE TEMPORARY STABILIZED ENTRANCE.
 9. PRIOR TO CITY ACCEPTANCE THE PAVING CONTRACTOR SHALL BE RESPONSIBLE FOR REMOVING ANY MUD OR SILT WHICH COLLECTS ON THE EXISTING AND NEW PAVEMENT.
 10. PRIOR TO CITY ACCEPTANCE 75-80% OF ALL DISTURBED AREA SHALL HAVE A MIN. 1" TALL GRASS ESTABLISHED
 11. 75-80% OF ALL DISTURBED AREA TO HAVE 1" HIGH GRASS ESTABLISHED PRIOR TO ENGINEERING ACCEPTANCE.
 12. ALL BAR DITCHES TO BE ANCHORED, SEED & CURLEXED PRIOR TO ACCEPTANCE OF GRASS ISN'T ESTABLISHED.

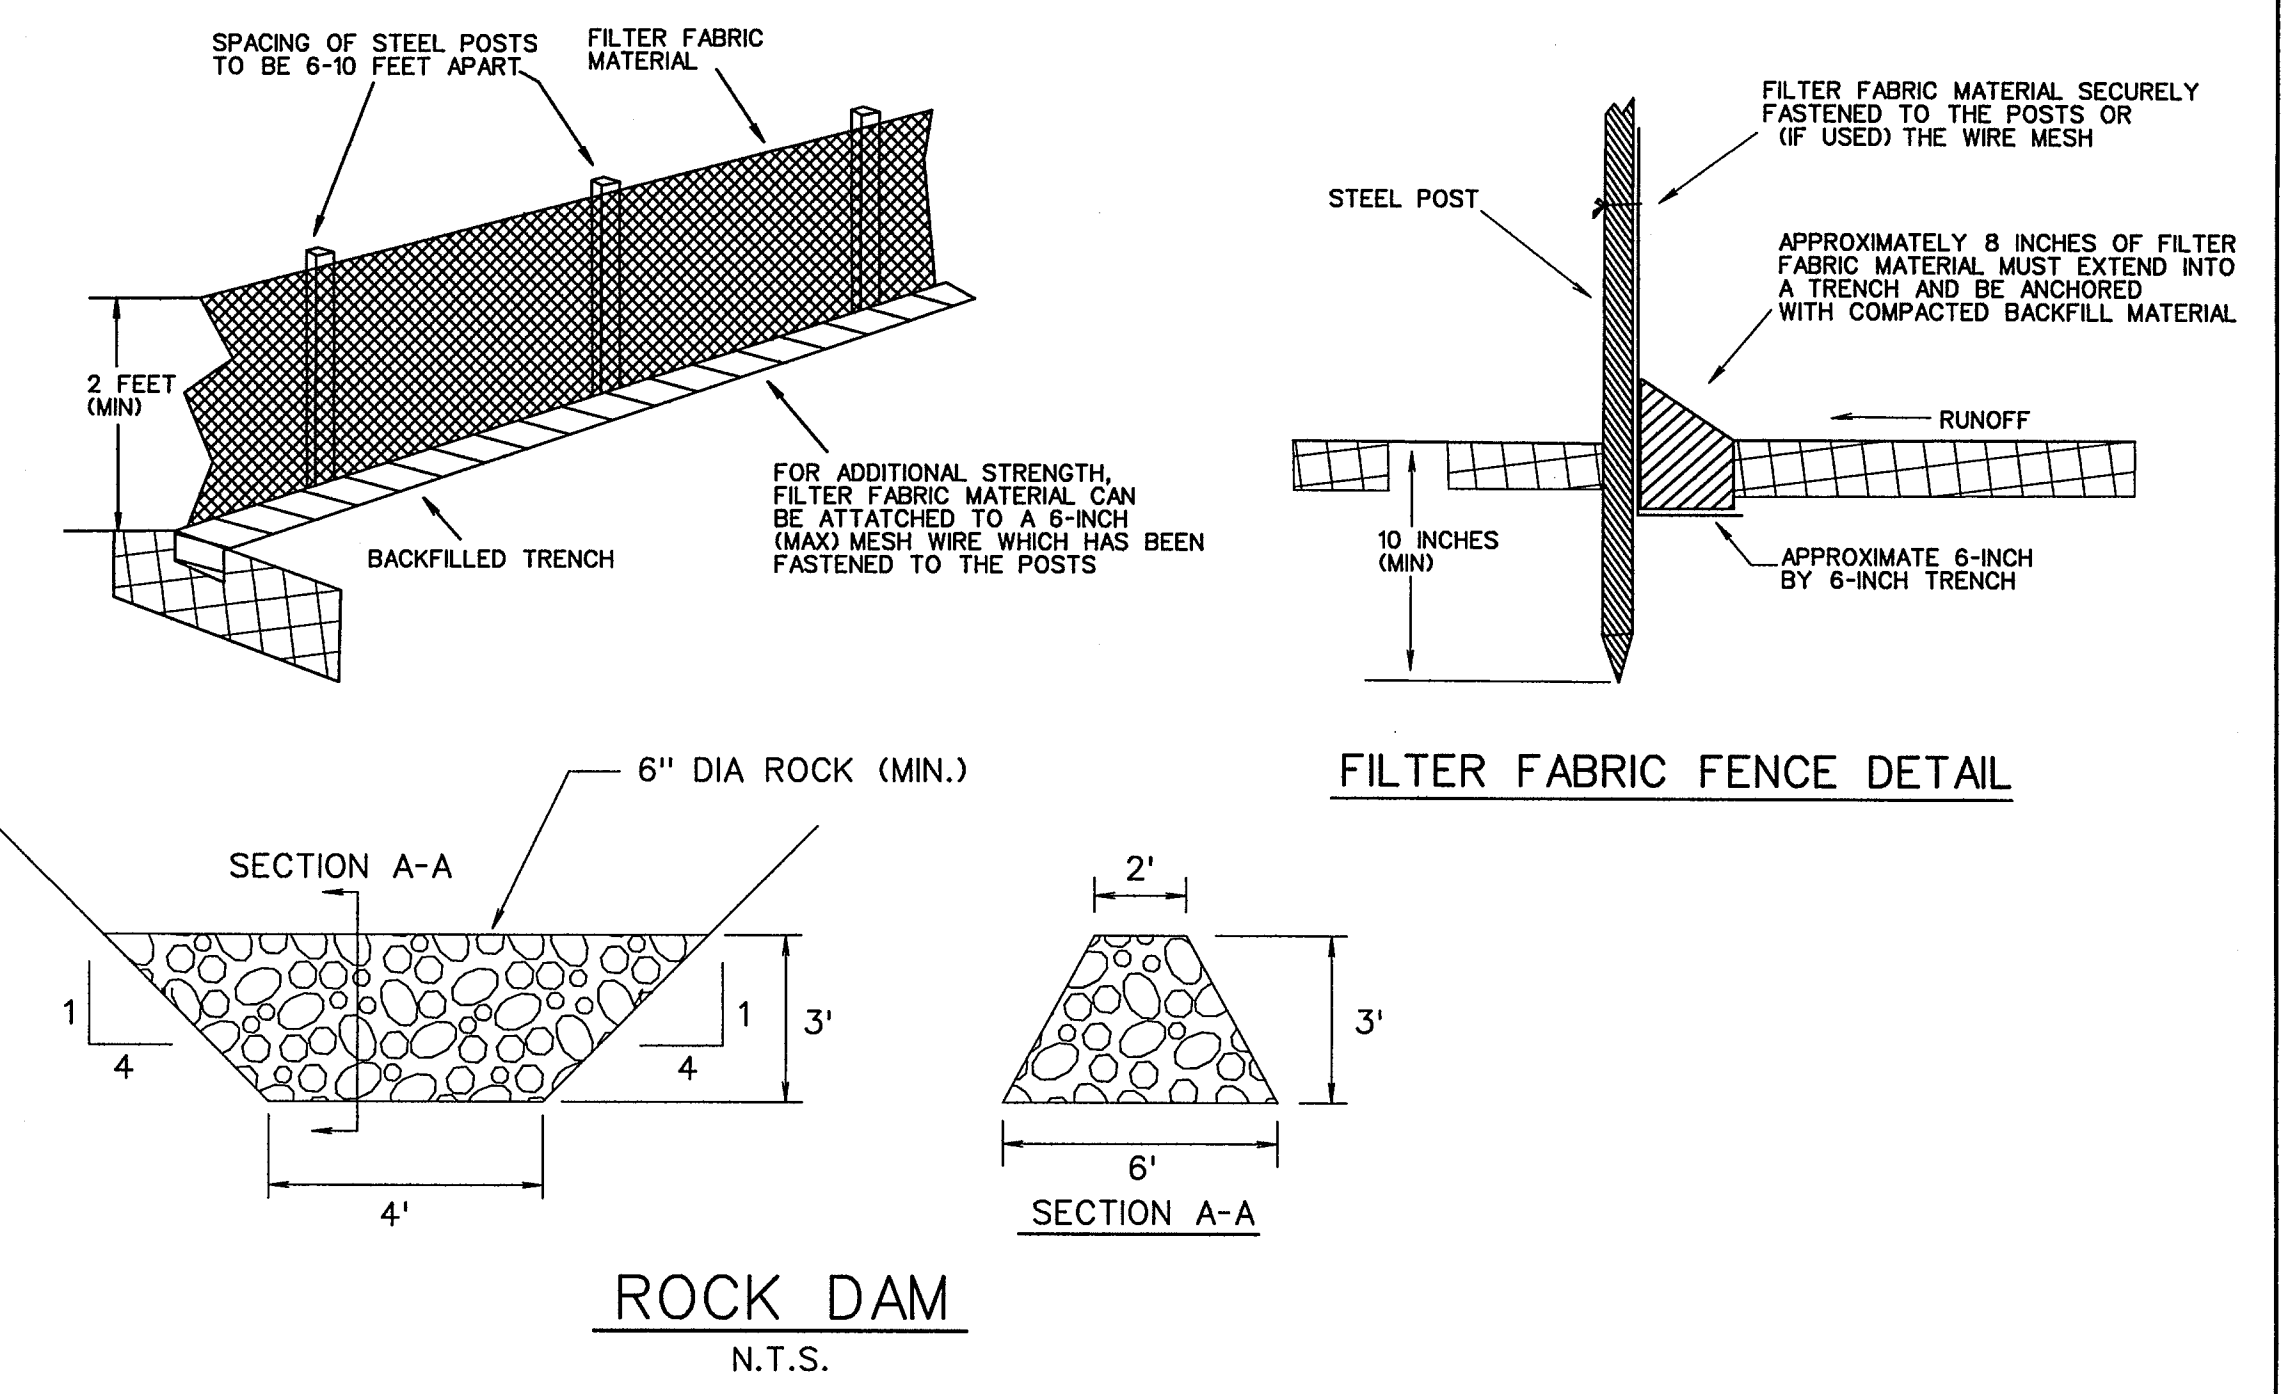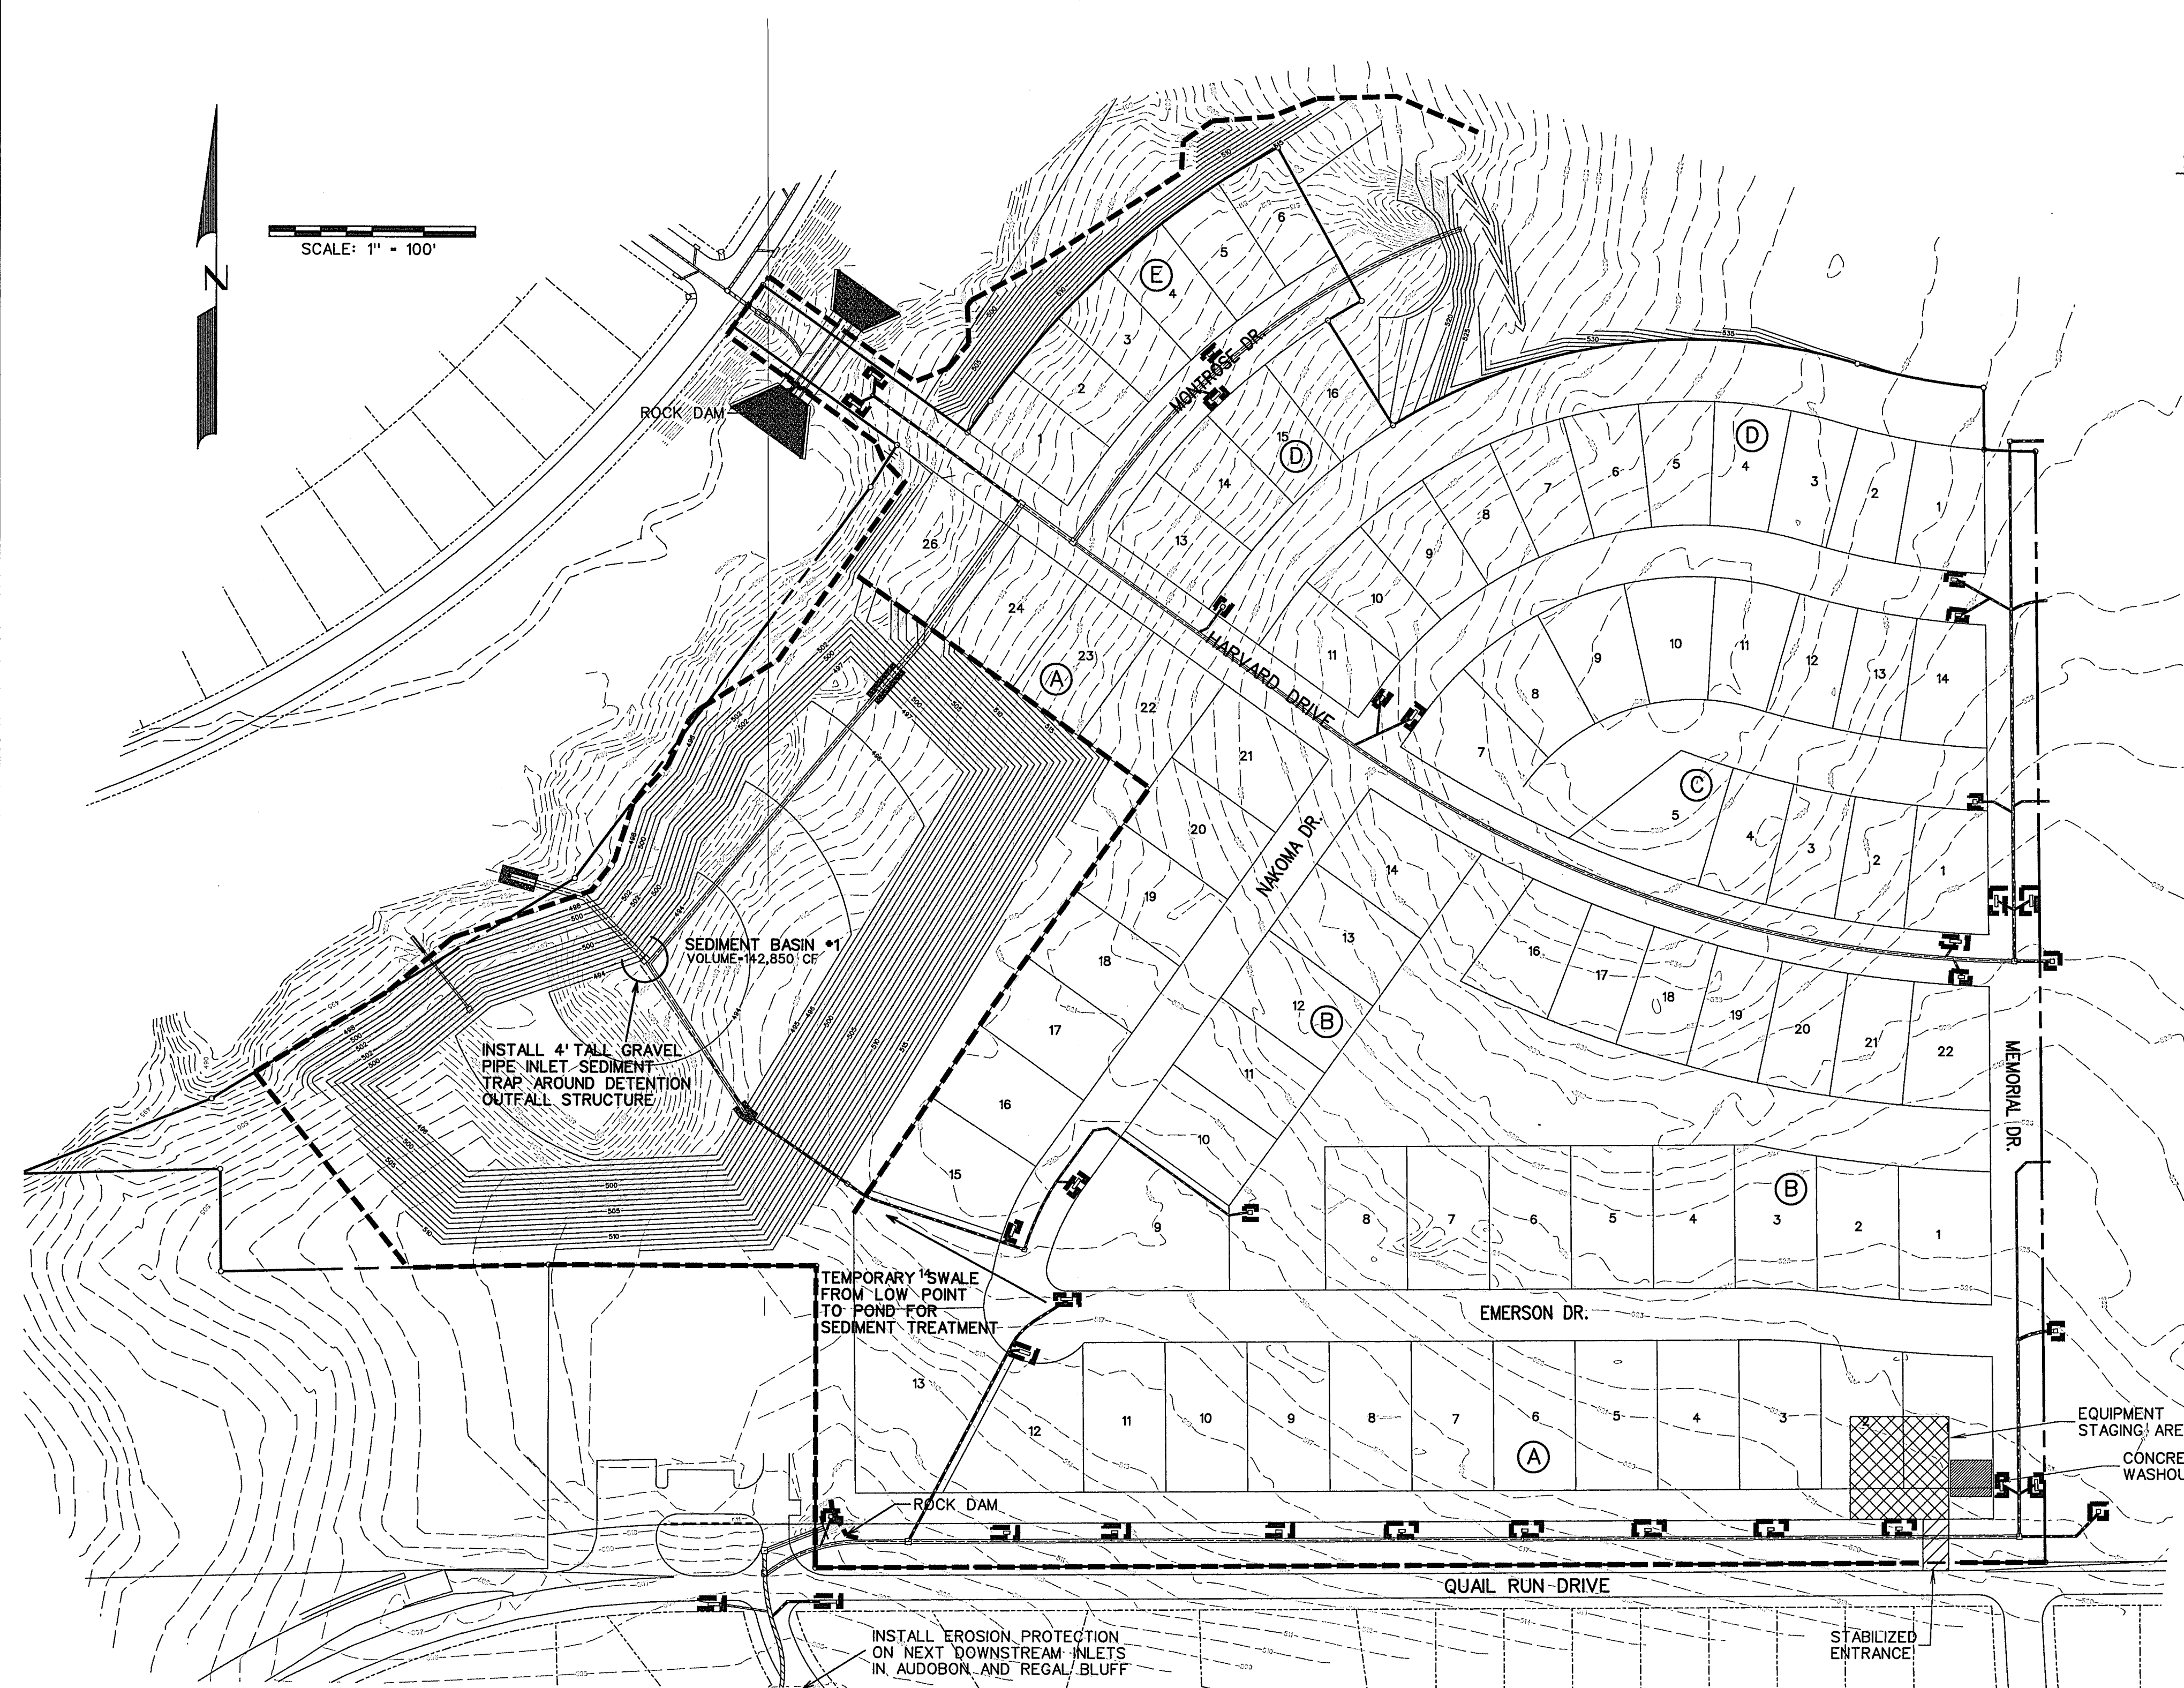

FILTER FABRIC FENCE DETAIL

ROCK DAM
N.T.S.

TOTAL SITE 37.8 AC.
DISTURBED AREA 41.0 AC.

AS-BUILT DECEMBER 2016
INFORMATION PROVIDED BY CONTRACTORS (NOT FIELD VERIFIED)

- LEGEND**
- SILT FENCE (BEFORE CONSTRUCTION)
 - INLET PROTECTION

NOTE:
DETENTION POND SHALL BE INSTALLED PER PLAN (INCLUDING OUTFALL) WITH BOTTOM AND SIDES STABILIZED WITH ANCHORED CURLEX OR SOD PRIOR TO ANY PAVING.

CORWIN ENGINEERING, INC. 200 W. BELMONT, SUITE E ALLEN, TEXAS 75013 (972)396-1200 TBPE FIRM #5951			
EROSION CONTROL PLAN			
DRAWN BY	DESIGNED BY	CHECKED BY	SHEET NO.
JOB NUMBER	DATE	SCALE	29 of 31
15047	MARCH 2016	1"=100'	

SCALE: 1" = 100'



The developer shall arrange for the installation of all pavement striping, regulatory, warning and guide signs, including posts, as shown on the plans or as directed by the City. Street name signs shall be installed at each intersection. Examples of regulatory, warning, information and guide signs are as follows:

- Regulatory signs shall include, but are not limited to, STOP, ALL-WAY, YIELD, KEEP RIGHT and speed limit signs.
- Warning signs shall include, but are not limited to, DEAD END, NO OUTLET, DIVIDED ROAD, DIP, and PAVEMENT ENDS.
- Guide signals shall include, but are not limited to, street name signs, DETOUR, direction arrow and advance arrow.

Regulatory signs should be used only where justified by engineering judgment or study. All signage plans shall be reviewed and approved by the City of Rockwall Engineering Department and be designed in accordance with the principles described in the current TMUTCD.

-A detailed street and regulatory signage plan is to be submitted to the City of Rockwall Engineering Department. All signs shall be shown in the engineering plans for review and approval. The signage plan shall be shown on a separate signage & pavement marking layout sheet or as a part of the plan & profile sheet. The plan shall identify the specific sign designation, size and location for each sign. Sign standards shall also be included in the engineering plans.

-All signage installed shall comply with the current "Texas Manual on Uniform Traffic Control Devices" and the "Standard Highway Sign Designs for Texas." The sign layout drawings shall show the color and dimensions of all sign face legend components including background color, legend color, borders, symbols, letter size and style.

-The developer shall be responsible for furnishing and installing all regulatory signage, warning signage and street name signage along with all necessary sign mounts in accordance with the approved engineering plans. A sample production sign shall be submitted to the Traffic Signs & Pavement Markings Supervisor for review and approval. The sample shall be directed to the City of Rockwall Service Center located at 1600 Airport Road, Rockwall Texas 75087. The sample sign must be submitted at least 10 days prior to the scheduled installation date.

-For a street with a cul-de-sac end, a standard W 14-2a shall be mounted over the street name blade, if the cul-de-sac is not clearly visible from the adjoining roadway, or is located in excess of 400 linear feet from the adjoining roadway.

- Sign posts shall be 2 3/8" O.D. galvanized steel tube sign post with a galvanized finish.
- Sign clamps and brackets shall be high strength aluminum.

Street Name Blades

- Street name sign blades shall be double-sided with rounded corners.
- Street Name Blades shall be nine-inch (9") tall flat aluminum. The blades shall be 0.080 inches thick and be a minimum of 36" long.
- The lettering for the street signs shall be 3M Scotchlite Series 3930 high intensity prismatic material sheeting for street, regulatory and warning signs, and shall be high intensity diamond grade type III prismatic. The street sign background shall be green and the legend shall be white.
- The street sign blade must incorporate the current City of Rockwall logo. The logo shall consist of white 3M Scotchlite Series 3930 high intensity prismatic material (product code 3930).

- Block Numbers are required on all street name blades and shall be located on the top right corner of the street blade.
- The lettering for the street blades shall be composed of a combination of lower-case letters with initial upper-case letters. The Clearview TCAD-1W font shall be used. The lettering shall be composed of initial upper-case letters of at least 6 inches in height and lower case letters of at least 4.5 inches in height. For supplementary lettering to indicate the type of street (such as Street, Avenue or Road) shall be composed of initial upper-case letters at least 3-inches in height and lower-case letters at least 2.25 inches in height. Abbreviations may be used (for example St., Ave., or Rd) except the street name itself. The supplementary lettering shall be located at the lower right corner of the street blade, under the block number.


-The street blade sign shall consist of green 3M Scotchlite Series 3930 high intensity prismatic material background - (product code 3937). The lettering shall consist of white 3M Scotchlite Series 3930 high intensity prismatic material (product code - 3930). The background sheeting shall be white 3M 3990 high intensity prismatic material. The background material shall be applied to the full width and height of the sign blank leaving no metal exposed. The background material shall be one continuous piece of material. Patching of background material is not allowed and any sign with patching material of any type will be rejected by the City.


- Alternative Option:
As an alternative, the foreground color may be green transparent Scotch lite ElectroCut1177 film (E.C. film). Lettering shall be cut out and removed producing a single continuous piece of green transparent film material.

All street and regulatory signage shall be installed, inspected and approved, prior to final acceptance of the project. This inspection typically takes place as part of the engineering department's final walkover. Any sign related issue/issues will be noted on the projects final punch list.


AS-BUILT DECEMBER 2016
INFORMATION PROVIDED
BY CONTRACTORS
(NOT FIELD VERIFIED)

- LEGEND**
- ☼ - STREET LIGHT
 - - STOP SIGN
 - - STREET NAME BLADE
 - - SPEED LIMIT SIGN (30 MPH)



 CORWIN ENGINEERING, INC. 200 W. BELMONT, SUITE E ALLEN, TEXAS 75013 (972)396-1200 TBPE FIRM #5951			
DEVELOPMENT PLANS FOR STONE CREEK PHASE VII ROCKWALL, TEXAS			
SIGN AND LIGHT PLAN			
DRAWN BY	DESIGNED BY	CHECKED BY	SHEET NO.
JOB NUMBER	DATE	SCALE	
15047	MARCH 2016	1"=100'	30 OF 31

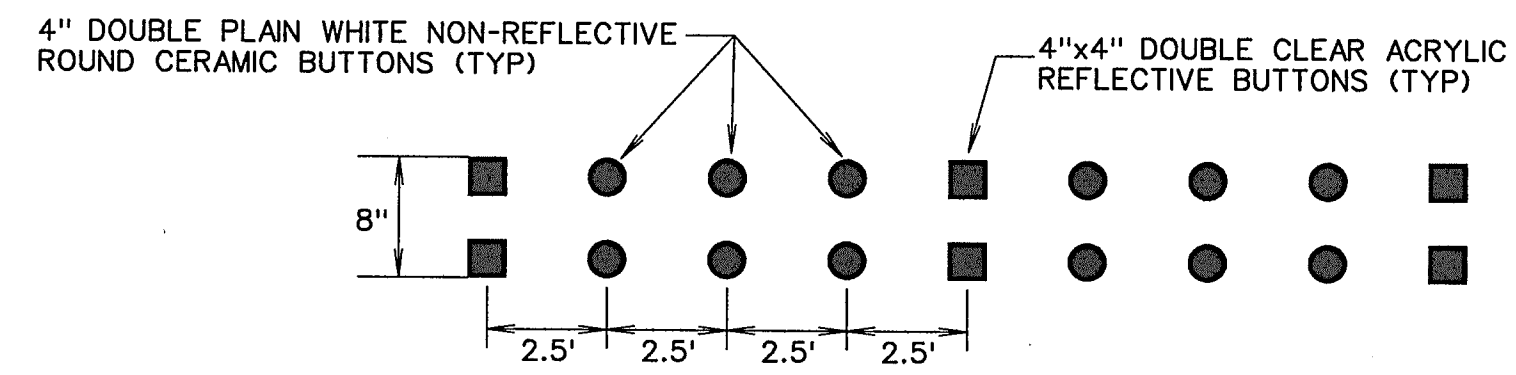

BUTTON TURN BAY LINE MARKING DETAIL
N.T.S

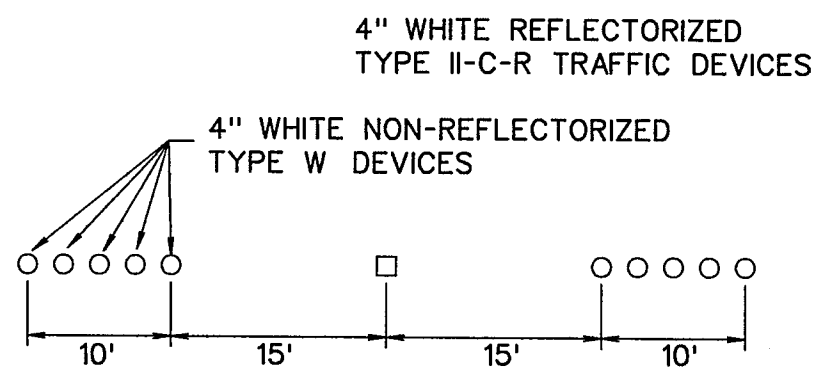

TYPICAL LANE-LINE TRAFFIC BUTTON DETAIL
NTS

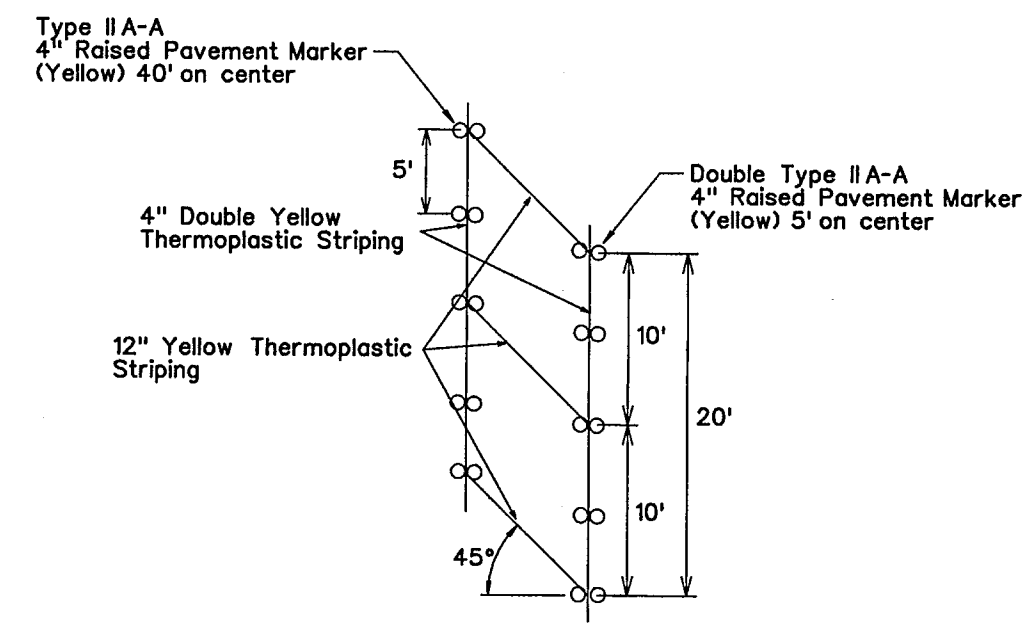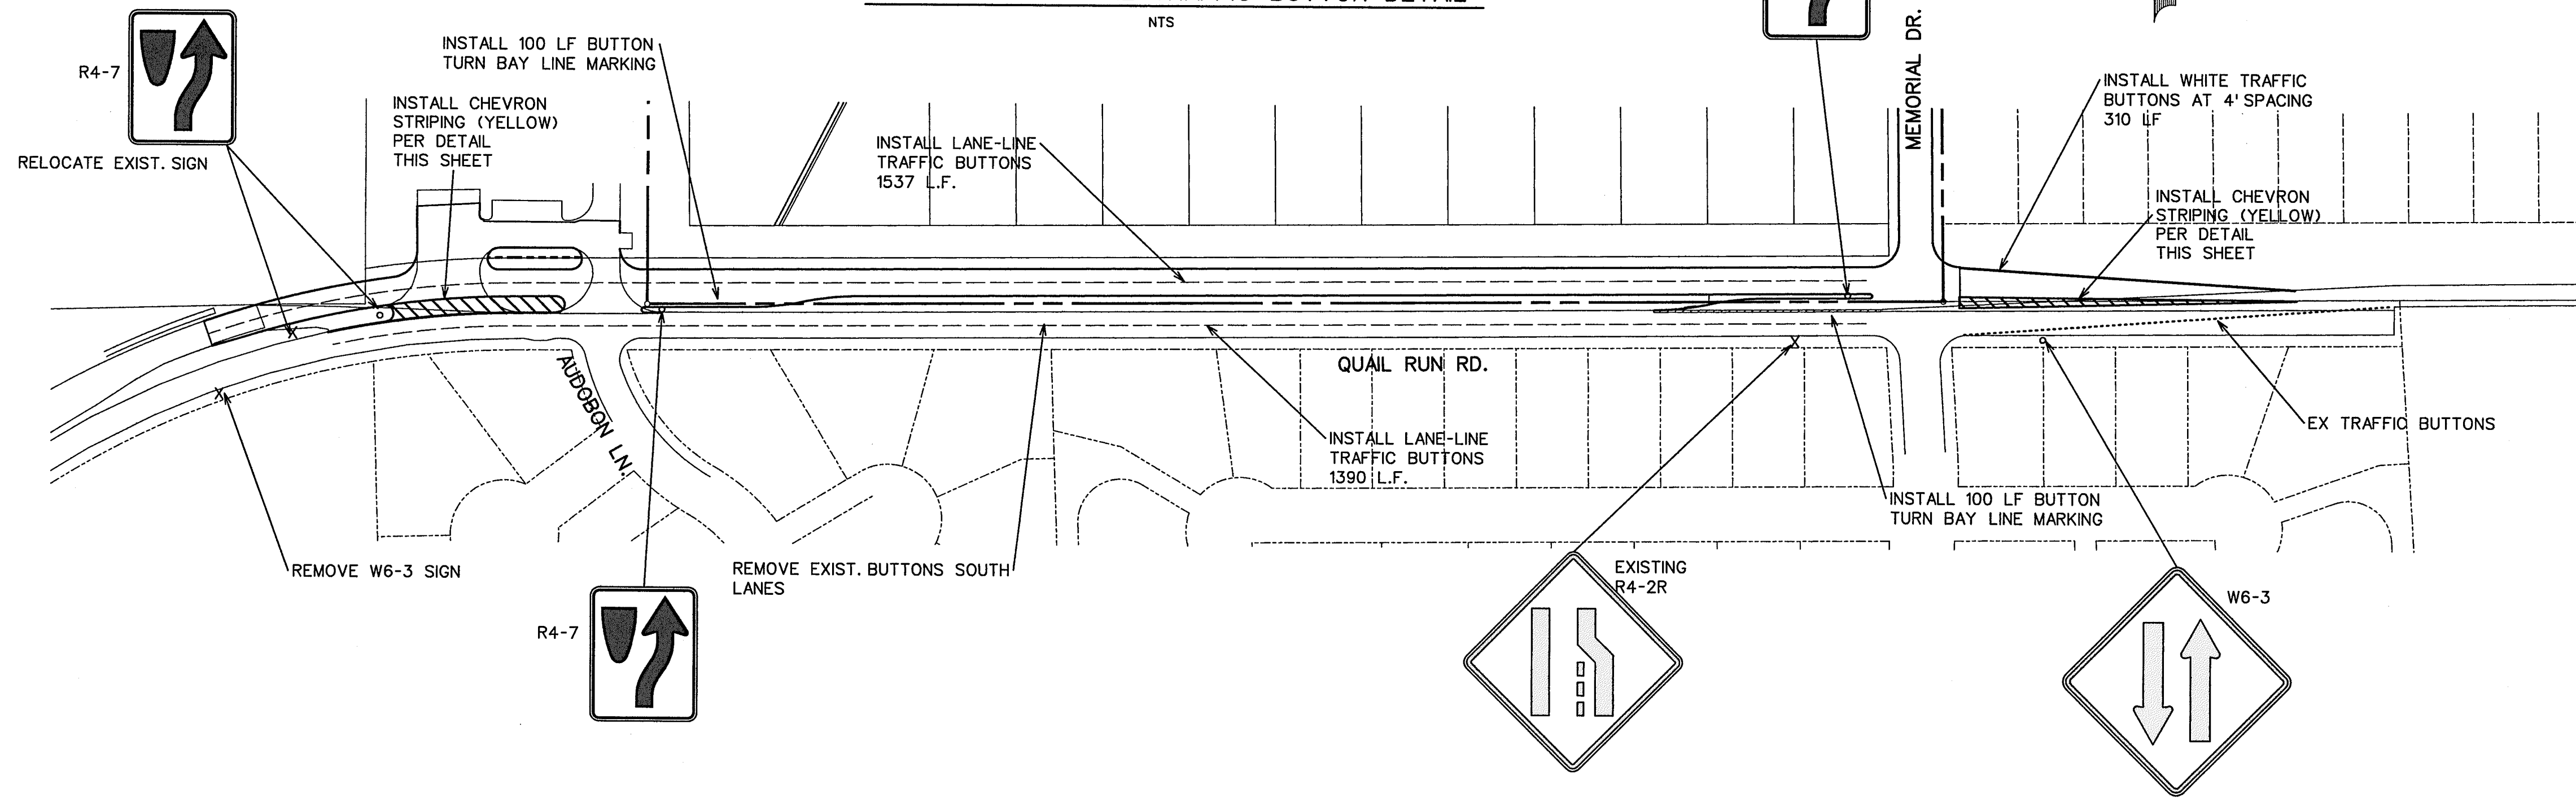

CHEVRON STRIPING DETAIL
NTS

AS-BUILT DECEMBER 2016
INFORMATION PROVIDED
BY CONTRACTORS
(NOT FIELD VERIFIED)

CORWIN ENGINEERING, INC.
200 W. BELMONT, SUITE E
ALLEN, TEXAS 75013 (972)396-1200
TBPE FIRM #5951

DEVELOPMENT PLANS FOR
STONE CREEK
PHASE VII
ROCKWALL, TEXAS

QUAIL RUN TRAFFIC SIGNAGE PLAN

DRAWN BY	DESIGNED BY	CHECKED BY	SHEET NO.
JOB NUMBER	DATE	SCALE	31 OF 31
15047	MARCH 2016	1"=100'	