
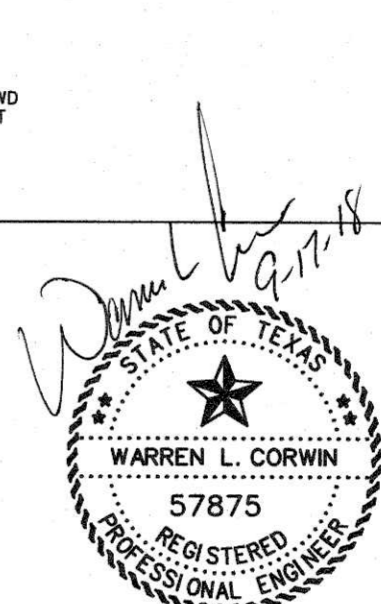
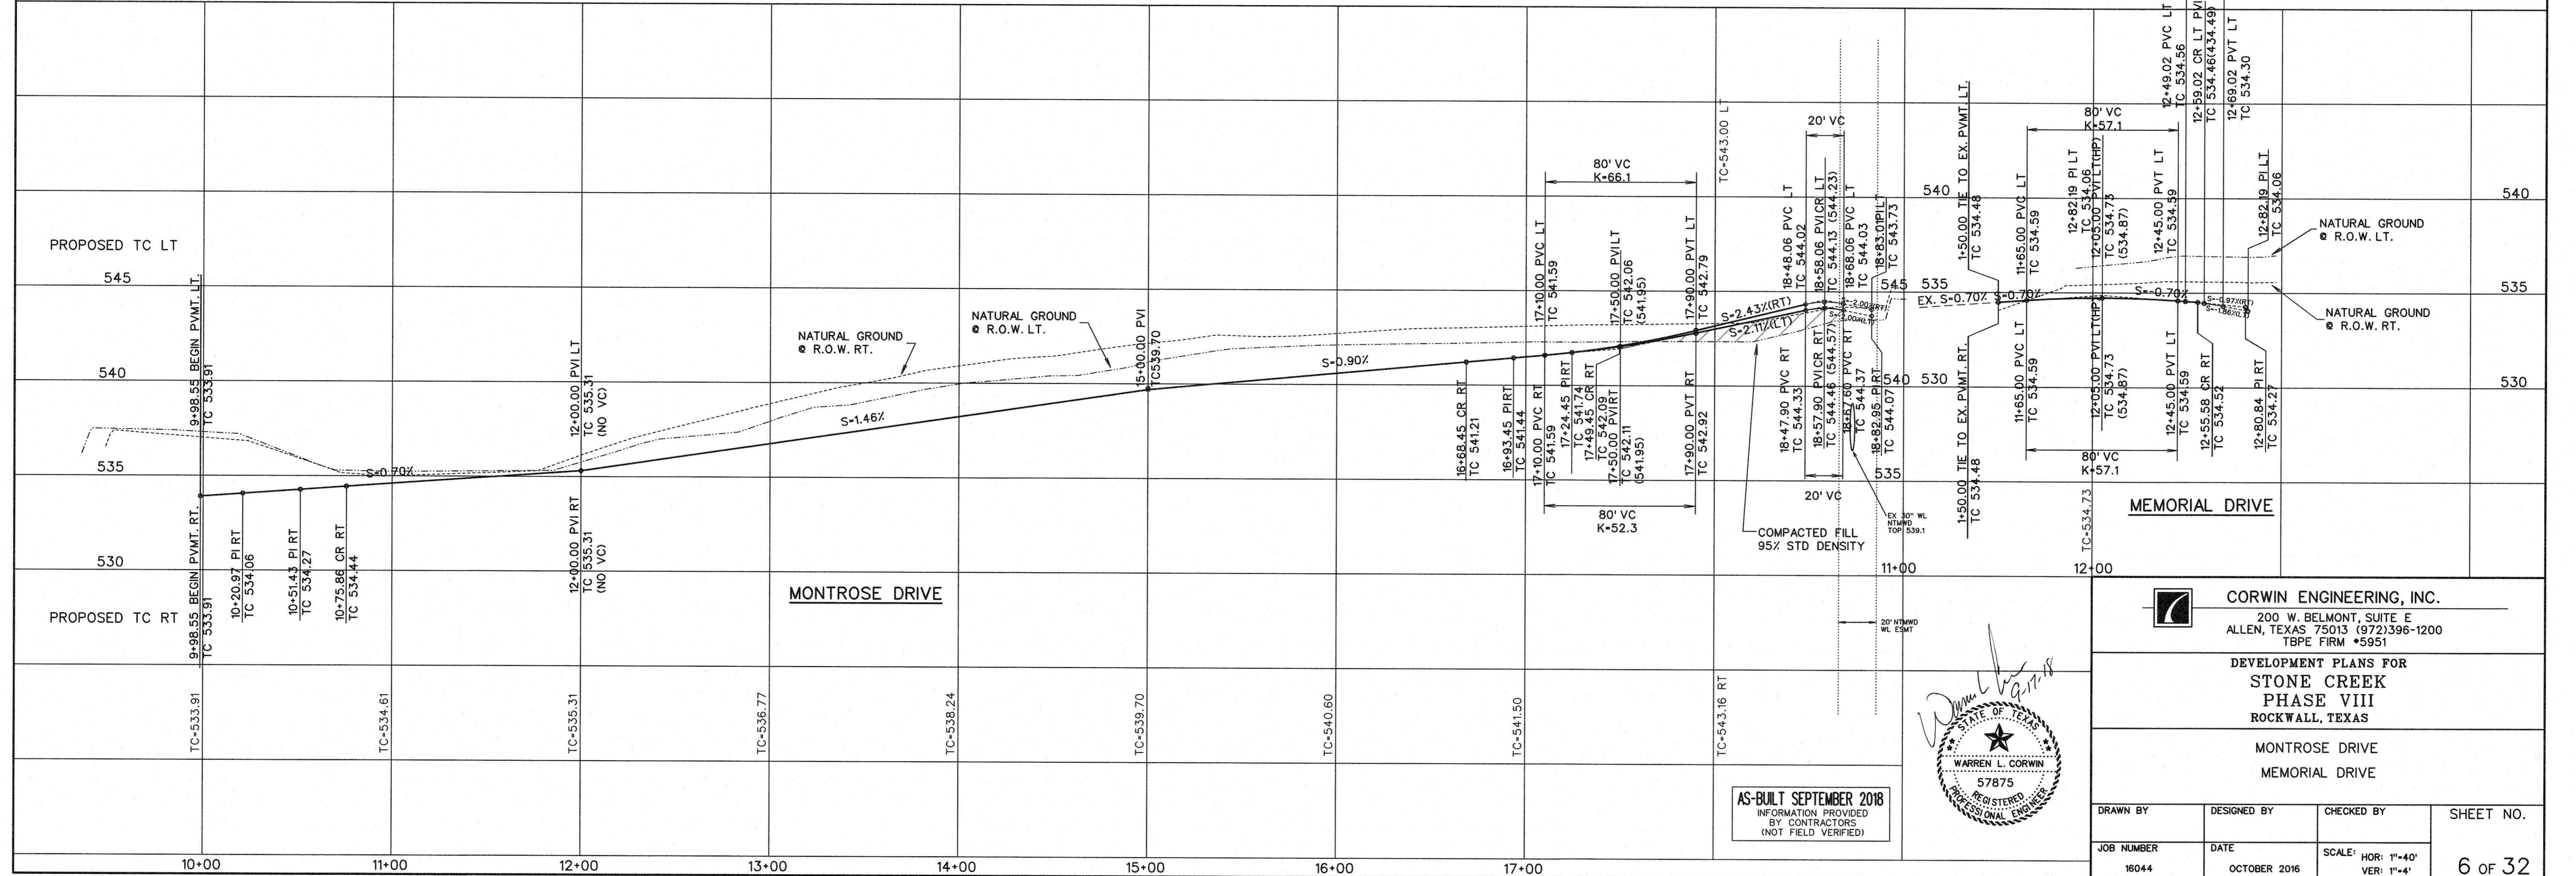


BENCHMARK:
 CITY OF ROCKWALL SURVEY MONUMENT ON AN INLET
 AT THE NORTHWEST CORNER OF FEATHERSTONE DR. AND
 HARVARD DR.
 ELEV. = 525.31

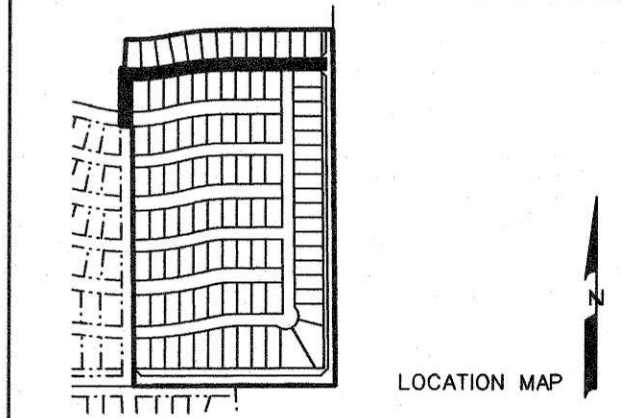

AS-BUILT SEPTEMBER 2018
 INFORMATION PROVIDED
 BY CONTRACTORS
 (NOT FIELD VERIFIED)

CORWIN ENGINEERING, INC.
 200 W. BELMONT, SUITE E
 ALLEN, TEXAS 75013 (972)396-1200
 TBPE FIRM #5951

DEVELOPMENT PLANS FOR
**STONE CREEK
 PHASE VIII**
 ROCKWALL, TEXAS

MONTROSE DRIVE
 MEMORIAL DRIVE

DRAWN BY	DESIGNED BY	CHECKED BY	SHEET NO.
JOB NUMBER	DATE	SCALE: HOR: 1"=40' VER: 1"=4"	6 OF 32
16044	OCTOBER 2016		