


AS-BUILT SEPTEMBER 2018
 INFORMATION PROVIDED
 BY CONTRACTORS
 (NOT FIELD VERIFIED)

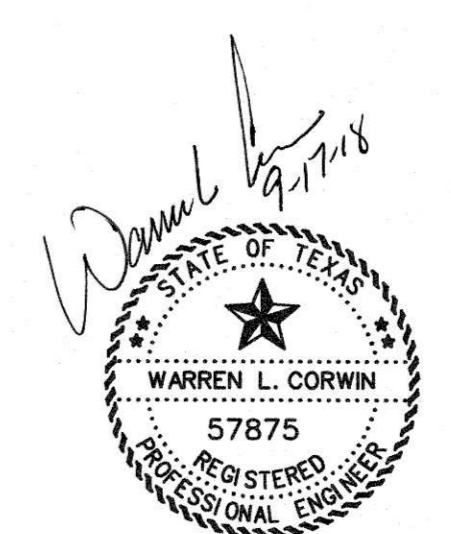

| | | | |
|---|--------------|----------------------------------|-----------|
| <p>CORWIN ENGINEERING, INC. 200 W. BELMONT, SUITE E ALLEN, TEXAS 75013 (972)396-1200 TBPE FIRM #5951</p> | | | |
| <p>DEVELOPMENT PLANS FOR STONE CREEK PHASE VIII ROCKWALL, TEXAS</p> | | | |
| <p>QUAIL RUN ROAD CROSS SECTIONS</p> | | | |
| DRAWN BY | DESIGNED BY | CHECKED BY | SHEET NO. |
| JOB NUMBER | DATE | SCALE: HOR: 1"=40' VER: 1"=4' | 9 of 32 |
| 16044 | OCTOBER 2016 | | |