

10+34.67 LINE 'S-1'
 P.V.G. STA. 3+39.00
 CONST. STD. 4' DIA. M.H.
 T. RIM = 538.27

3+80.00 LINE 'S-1'
 P.V.G. STA. 13+77.53
 CONST. STD. 4' DIA. M.H.
 T. RIM = 529.39


6+74.67 LINE 'S-1'
 CONST. STD. 4' DIA. M.H.
 T. RIM = 532.00

13+30.00 LINE 'S-1'
 P.V.G. STA. 3+39.00
 CONST. STD. 4' DIA. M.H.
 T. RIM = 542.45

3+20.00 LINE 'S-2'
 P.V.G. STA. 14+20.00
 CONST. STD. 4' DIA. M.H.
 T. RIM = 535.75

6+00.00 LINE 'S-2'
 P.V.G. STA. 6+30.00
 CONST. STD. 4' DIA. M.H.
 T. RIM = 538.76

AS-BUILT SEPTEMBER 2018
 INFORMATION PROVIDED
 BY CONTRACTORS
 (NOT FIELD VERIFIED)

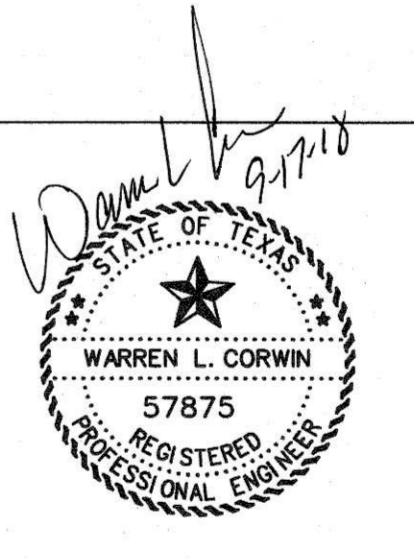

CORWIN ENGINEERING, INC.
 200 W. BELMONT, SUITE E
 ALLEN, TEXAS 75013 (972)396-1200
 TBPE FIRM #5951

DEVELOPMENT PLANS FOR
**STONE CREEK
 PHASE VIII**
 ROCKWALL, TEXAS

SANITARY SEWER PROFILES

DRAWN BY	DESIGNED BY	CHECKED BY	SHEET NO.
JOB NUMBER	DATE	SCALE: HOR: 1"=40' VER: 1"=4'	14 OF 32
16044	OCTOBER 2018		