



SCALE: 1" = 40'

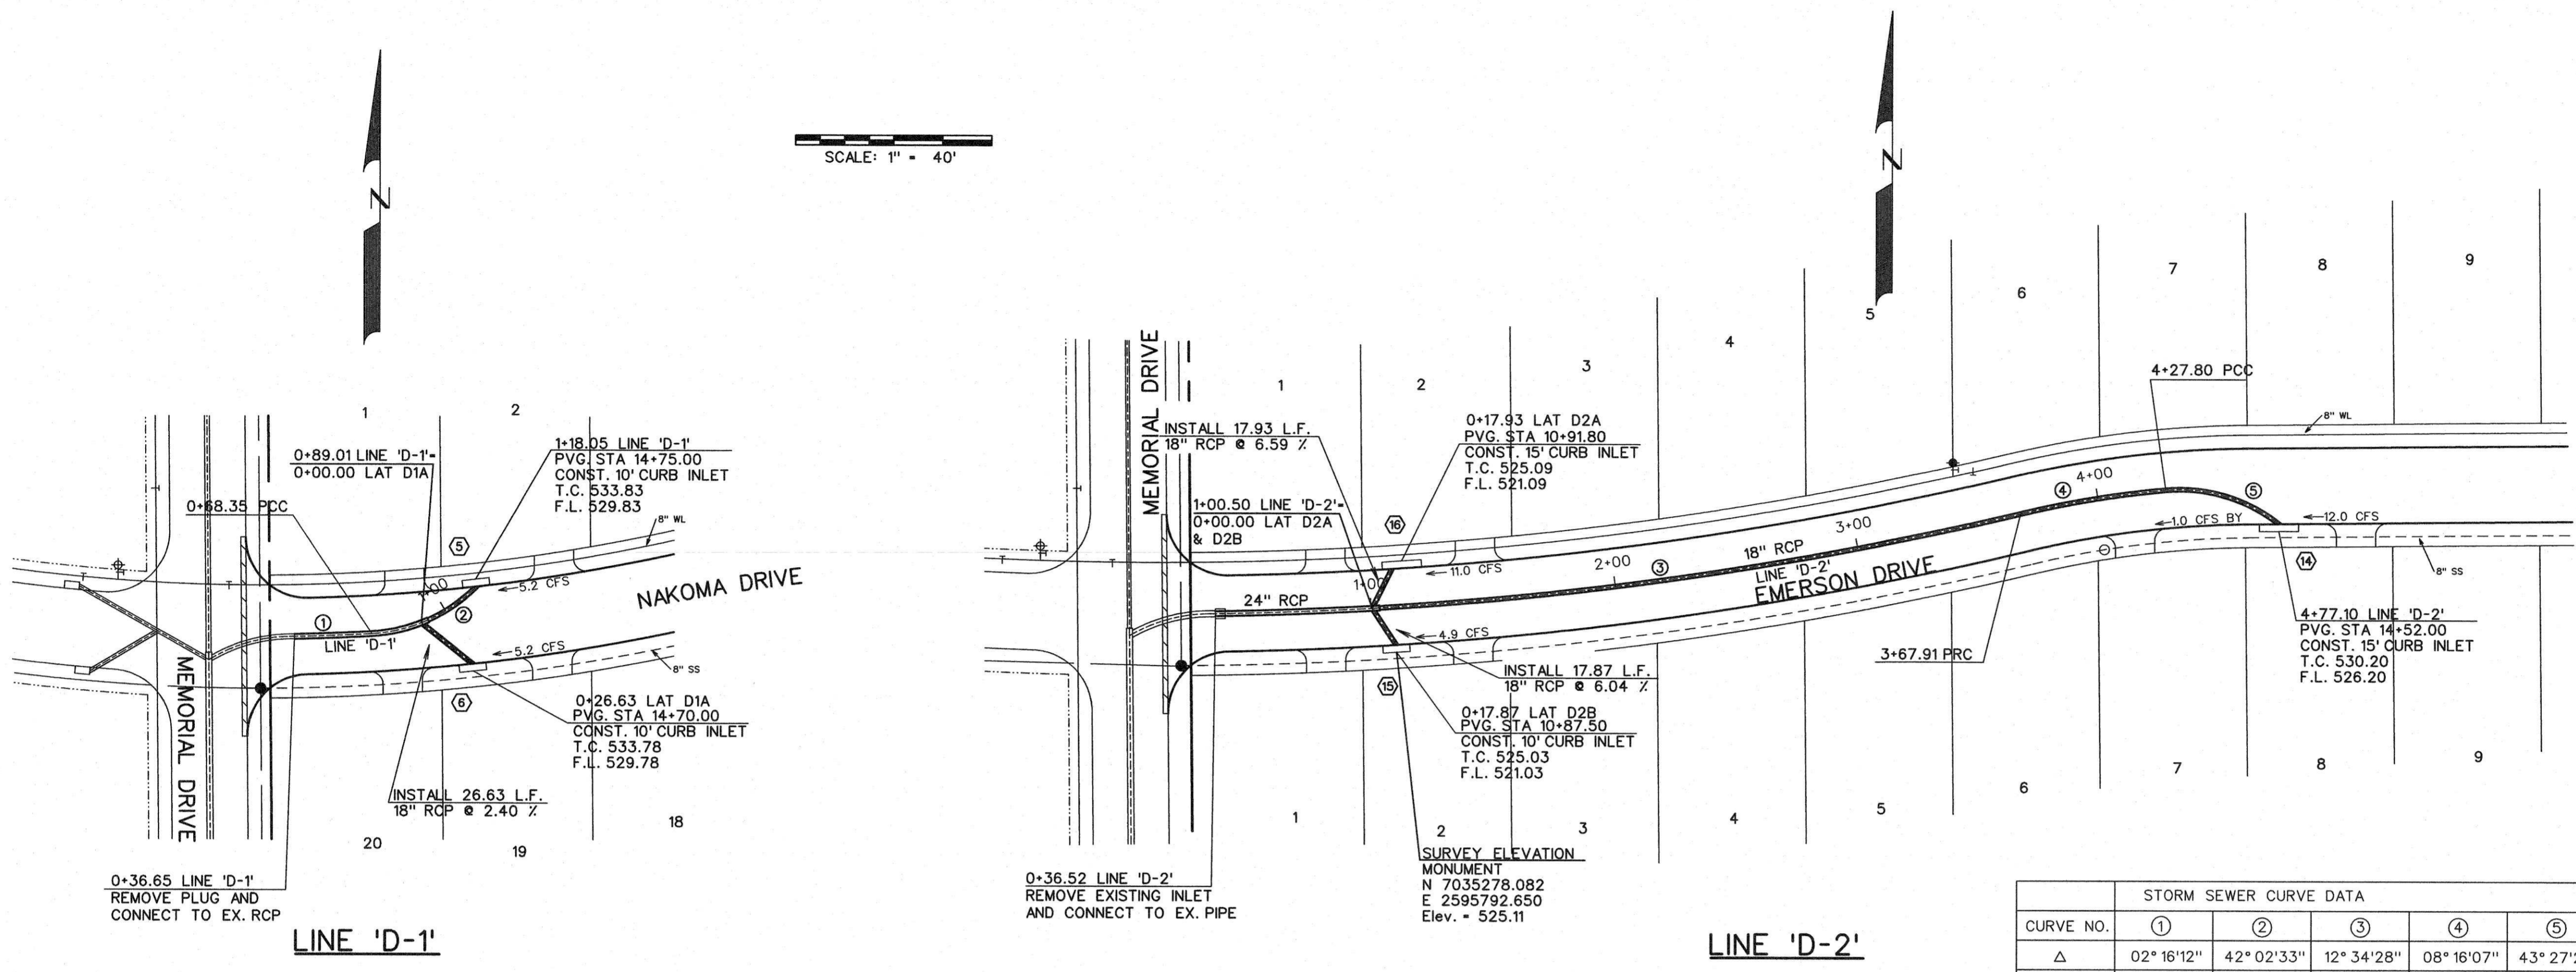

CURVE NO.	STORM SEWER CURVE DATA				
	①	②	③	④	⑤
Δ	02° 16' 12"	42° 02' 33"	12° 34' 28"	08° 16' 07"	43° 27' 28"
R	800.00'	65.00'	1510.00'	415.00'	65.00'
T	15.85'	24.98'	166.37'	30.00'	25.90'
L	31.70'	47.70'	331.39'	59.89'	49.30'

- LEGEND**
- ⓑ - BLOCK LABEL
 - Ⓜ - INLET NUMBER
 - ① - CURVE NUMBER
 - - SANITARY SEWER
 - ⊕ - WATER
 - ══ - PROPOSED STORM SEWER
 - ══ - EXISTING STORM SEWER

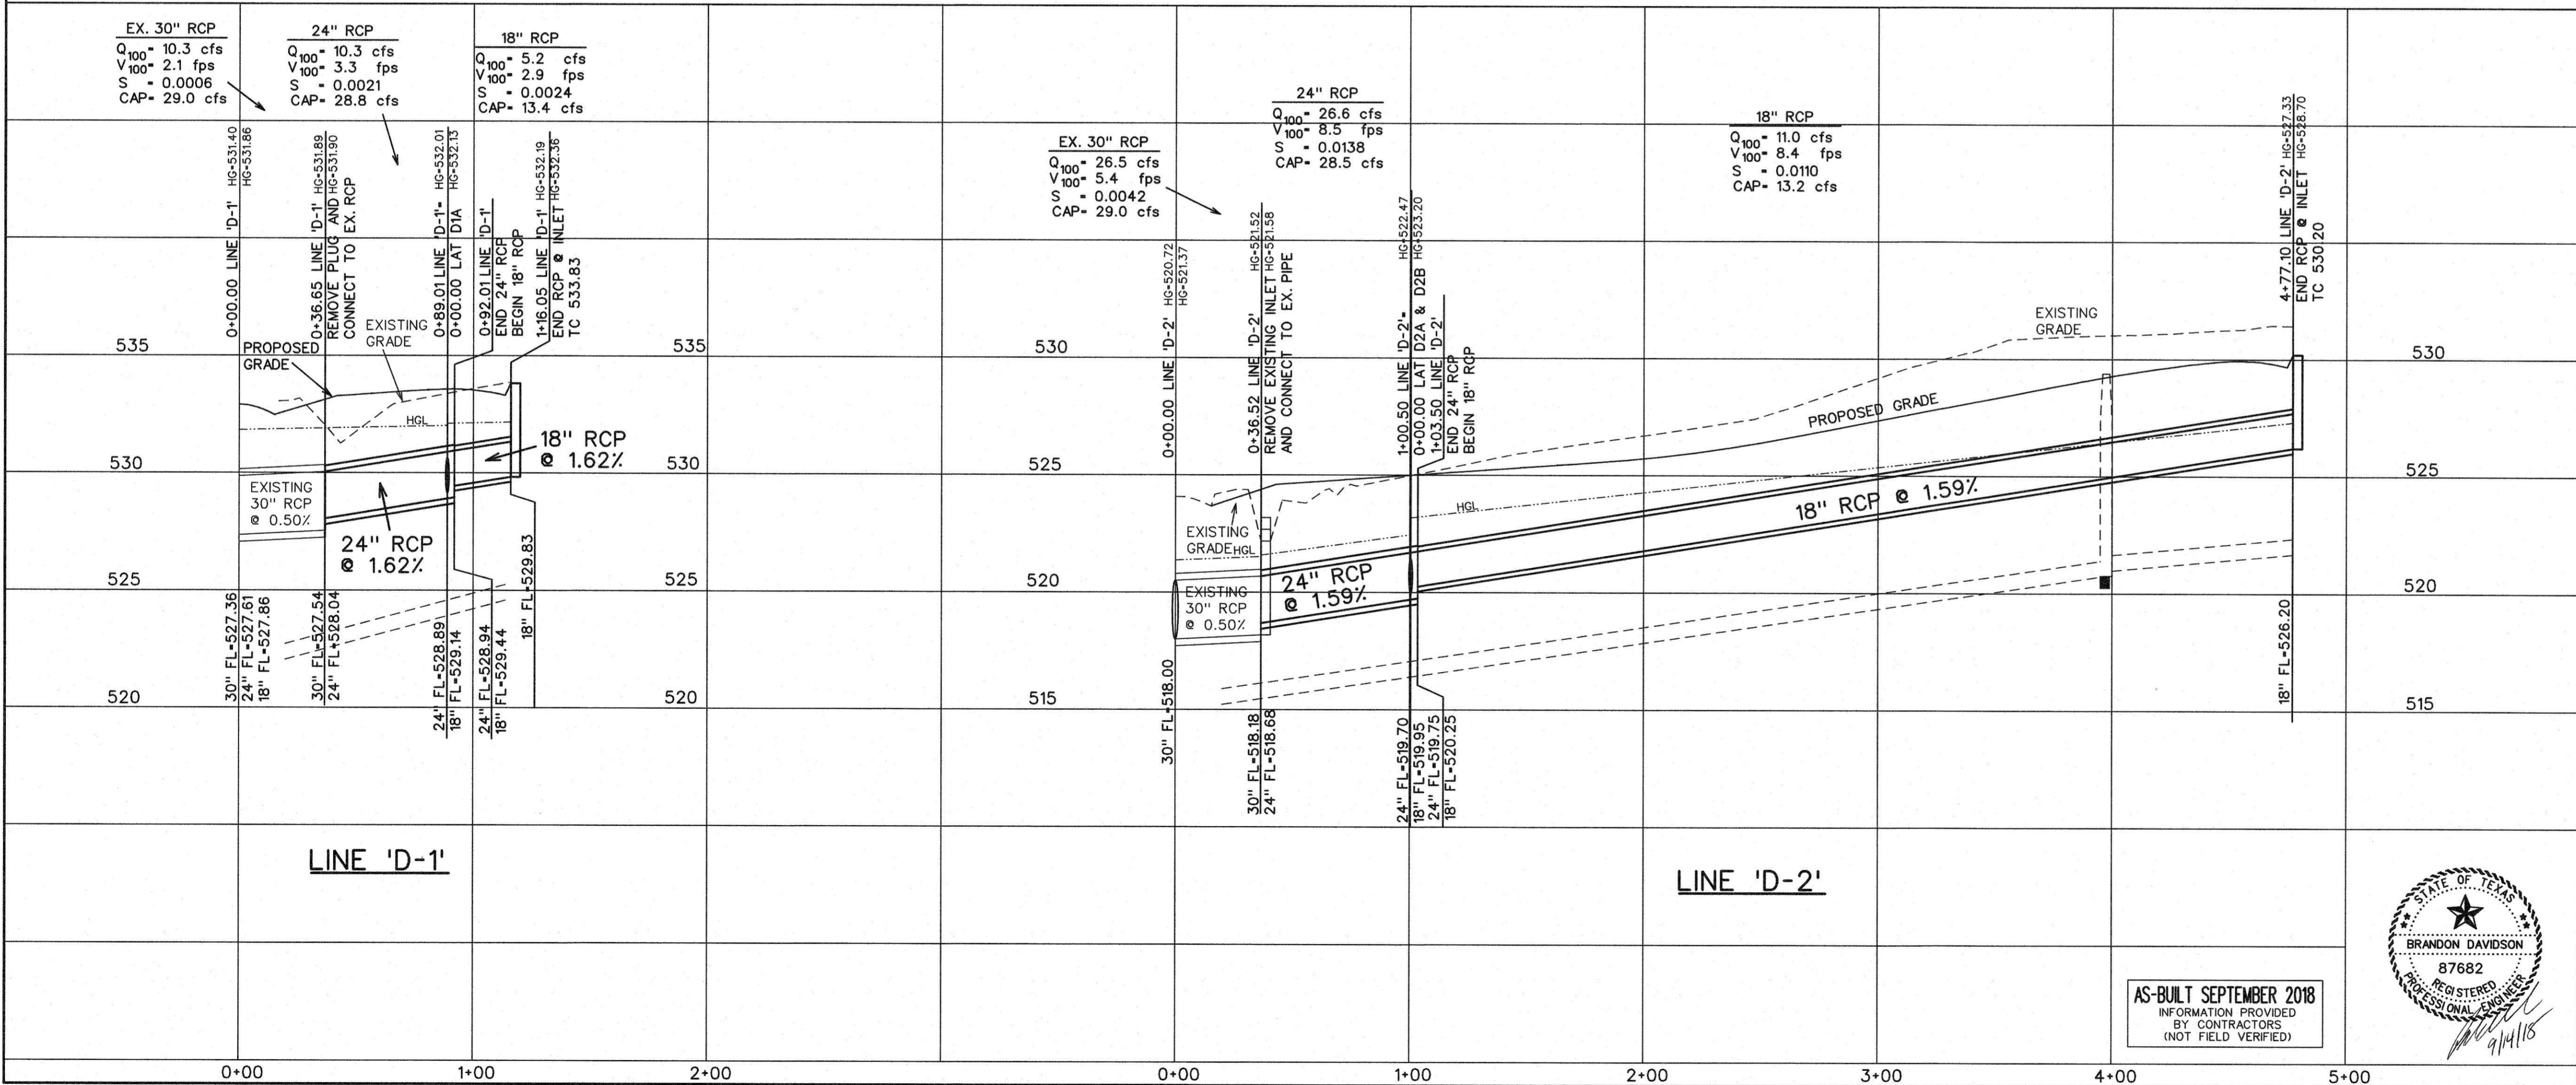

CORWIN ENGINEERING, INC.
 200 W. BELMONT, SUITE E
 ALLEN, TEXAS 75013 (972)396-1200
 TBPE FIRM #5951

DEVELOPMENT PLANS FOR
**STONE CREEK
 PHASE VIII**
 ROCKWALL, TEXAS

STORM SEWER PLAN AND PROFILE
 LINES 'D-1' & 'D-2'

AS-BUILT SEPTEMBER 2018
 INFORMATION PROVIDED
 BY CONTRACTORS
 (NOT FIELD VERIFIED)

STATE OF TEXAS
 REGISTERED
 PROFESSIONAL ENGINEER
 BRANDON DAVIDSON
 87682

DRAWN BY	DESIGNED BY	CHECKED BY	SHEET NO.
JOB NUMBER	DATE	SCALE: HOR: 1"=40' VER: 1"=4'	19 OF 32
18044	OCTOBER 2016		