


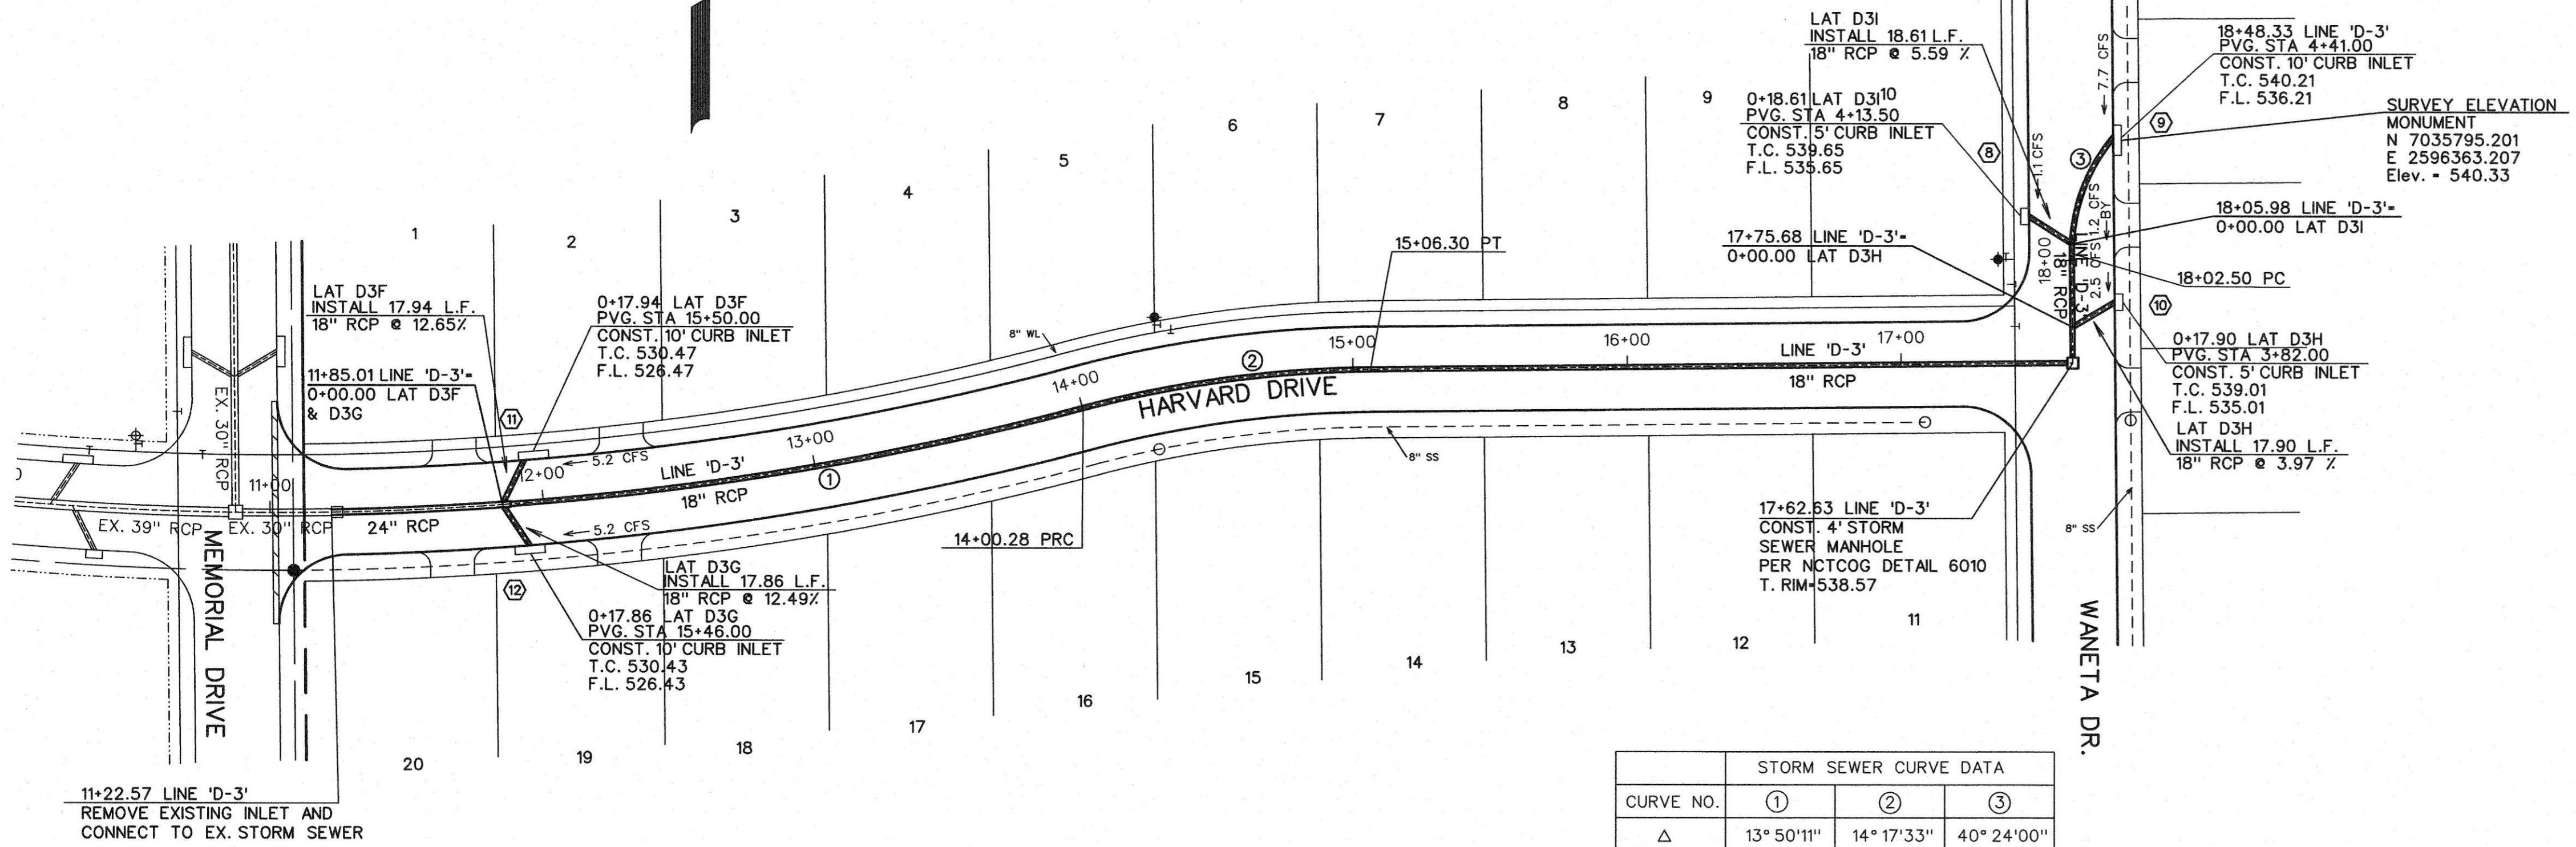


SCALE: 1" = 40'



STORM SEWER CURVE DATA			
CURVE NO.	①	②	③
Δ	13° 50' 11"	14° 17' 33"	40° 24' 00"
R	1150.00'	425.00'	65.00'
T	139.54'	53.28'	23.92'
L	277.71'	106.02'	45.83'

- LEGEND**
- ⓑ - BLOCK LABEL
  - Ⓢ - INLET NUMBER
  - ① - CURVE NUMBER
  - - SANITARY SEWER
  - ⊕ - WATER
  - ▬ - PROPOSED STORM SEWER
  - ▨ - EXISTING STORM SEWER

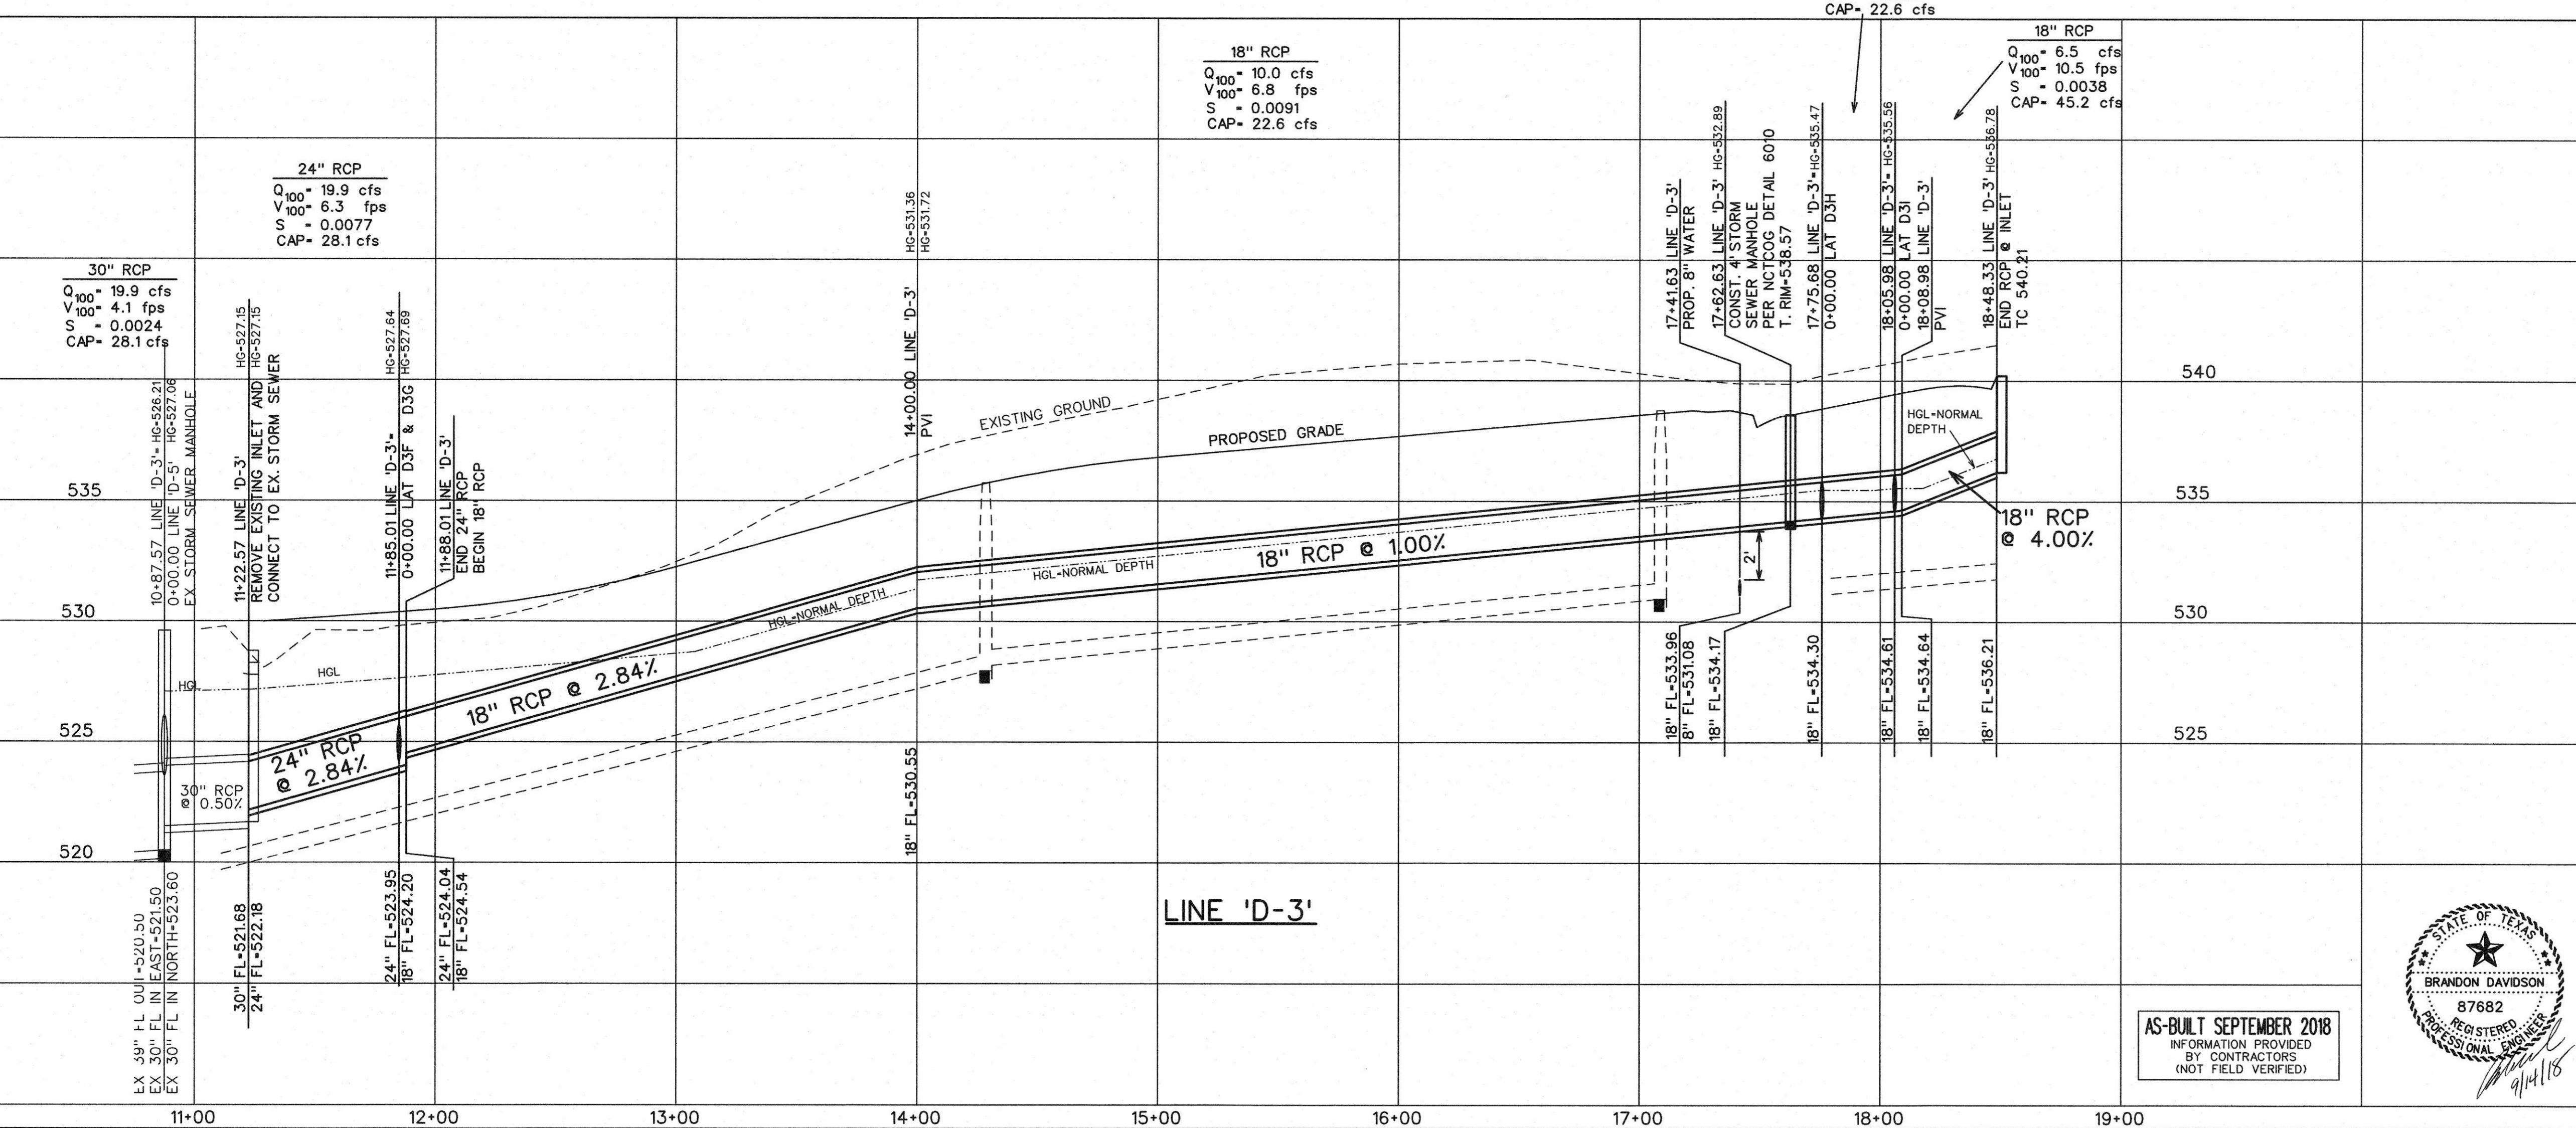

**CORWIN ENGINEERING, INC.**  
 200 W. BELMONT, SUITE E  
 ALLEN, TEXAS 75013 (972)396-1200  
 TBPE FIRM #5951

DEVELOPMENT PLANS FOR  
**STONE CREEK  
 PHASE VIII**  
 ROCKWALL, TEXAS

STORM SEWER PLAN AND PROFILE  
 LINE 'D-3'



AS-BUILT SEPTEMBER 2018  
 INFORMATION PROVIDED  
 BY CONTRACTORS  
 (NOT FIELD VERIFIED)

DRAWN BY	DESIGNED BY	CHECKED BY	SHEET NO.
JOB NUMBER	DATE	SCALE: HOR: 1"=40' VER: 1"=4"	20 of 32
16044	OCTOBER 2016		