


STORM SEWER CURVE DATA	
CURVE NO.	①
Δ	29° 37' 50"
R	65.00'
T	17.19'
L	33.61'

- LEGEND**
- Ⓟ - BLOCK LABEL
  - Ⓜ - INLET NUMBER
  - ① - CURVE NUMBER
  - - SANITARY SEWER
  - +— - WATER
  - +— - PROPOSED STORM SEWER
  - +— - EXISTING STORM SEWER

LINE 'D-7'

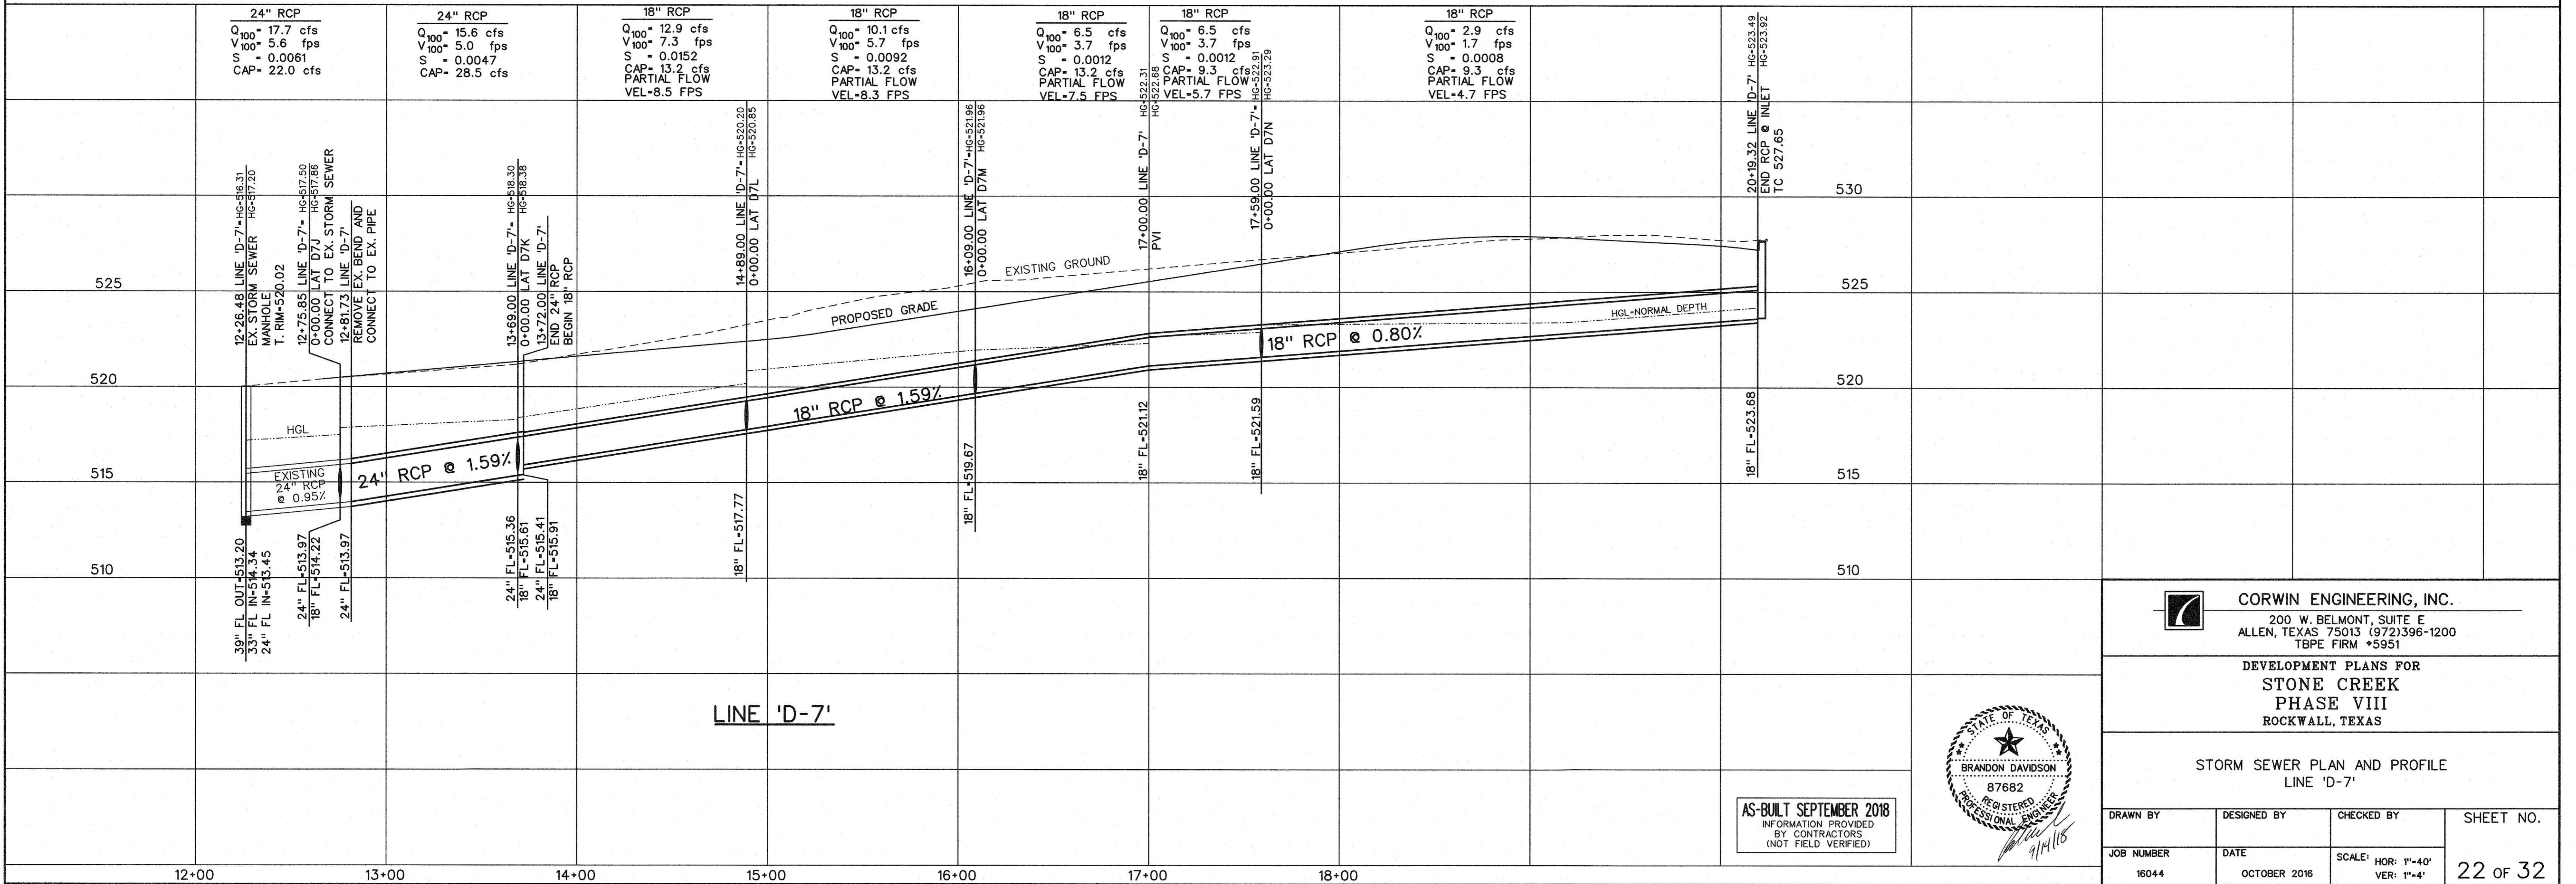

STORM SEWER CURVE DATA	
CURVE NO.	①
Δ	29° 37' 50"
R	65.00'
T	17.19'
L	33.61'

- LEGEND**
- Ⓟ - BLOCK LABEL
  - Ⓜ - INLET NUMBER
  - ① - CURVE NUMBER
  - - SANITARY SEWER
  - +— - WATER
  - +— - PROPOSED STORM SEWER
  - +— - EXISTING STORM SEWER

LINE 'D-7'

**CORWIN ENGINEERING, INC.**  
 200 W. BELMONT, SUITE E  
 ALLEN, TEXAS 75013 (972)396-1200  
 TBPE FIRM #5951

DEVELOPMENT PLANS FOR  
**STONE CREEK  
 PHASE VIII**  
 ROCKWALL, TEXAS



AS-BUILT SEPTEMBER 2018  
 INFORMATION PROVIDED  
 BY CONTRACTORS  
 (NOT FIELD VERIFIED)

STORM SEWER PLAN AND PROFILE  
 LINE 'D-7'

DRAWN BY	DESIGNED BY	CHECKED BY	SHEET NO.
JOB NUMBER	DATE	SCALE: HOR: 1"=40' VER: 1"=4'	22 OF 32
16044	OCTOBER 2016		