



SCALE: 1" = 50'

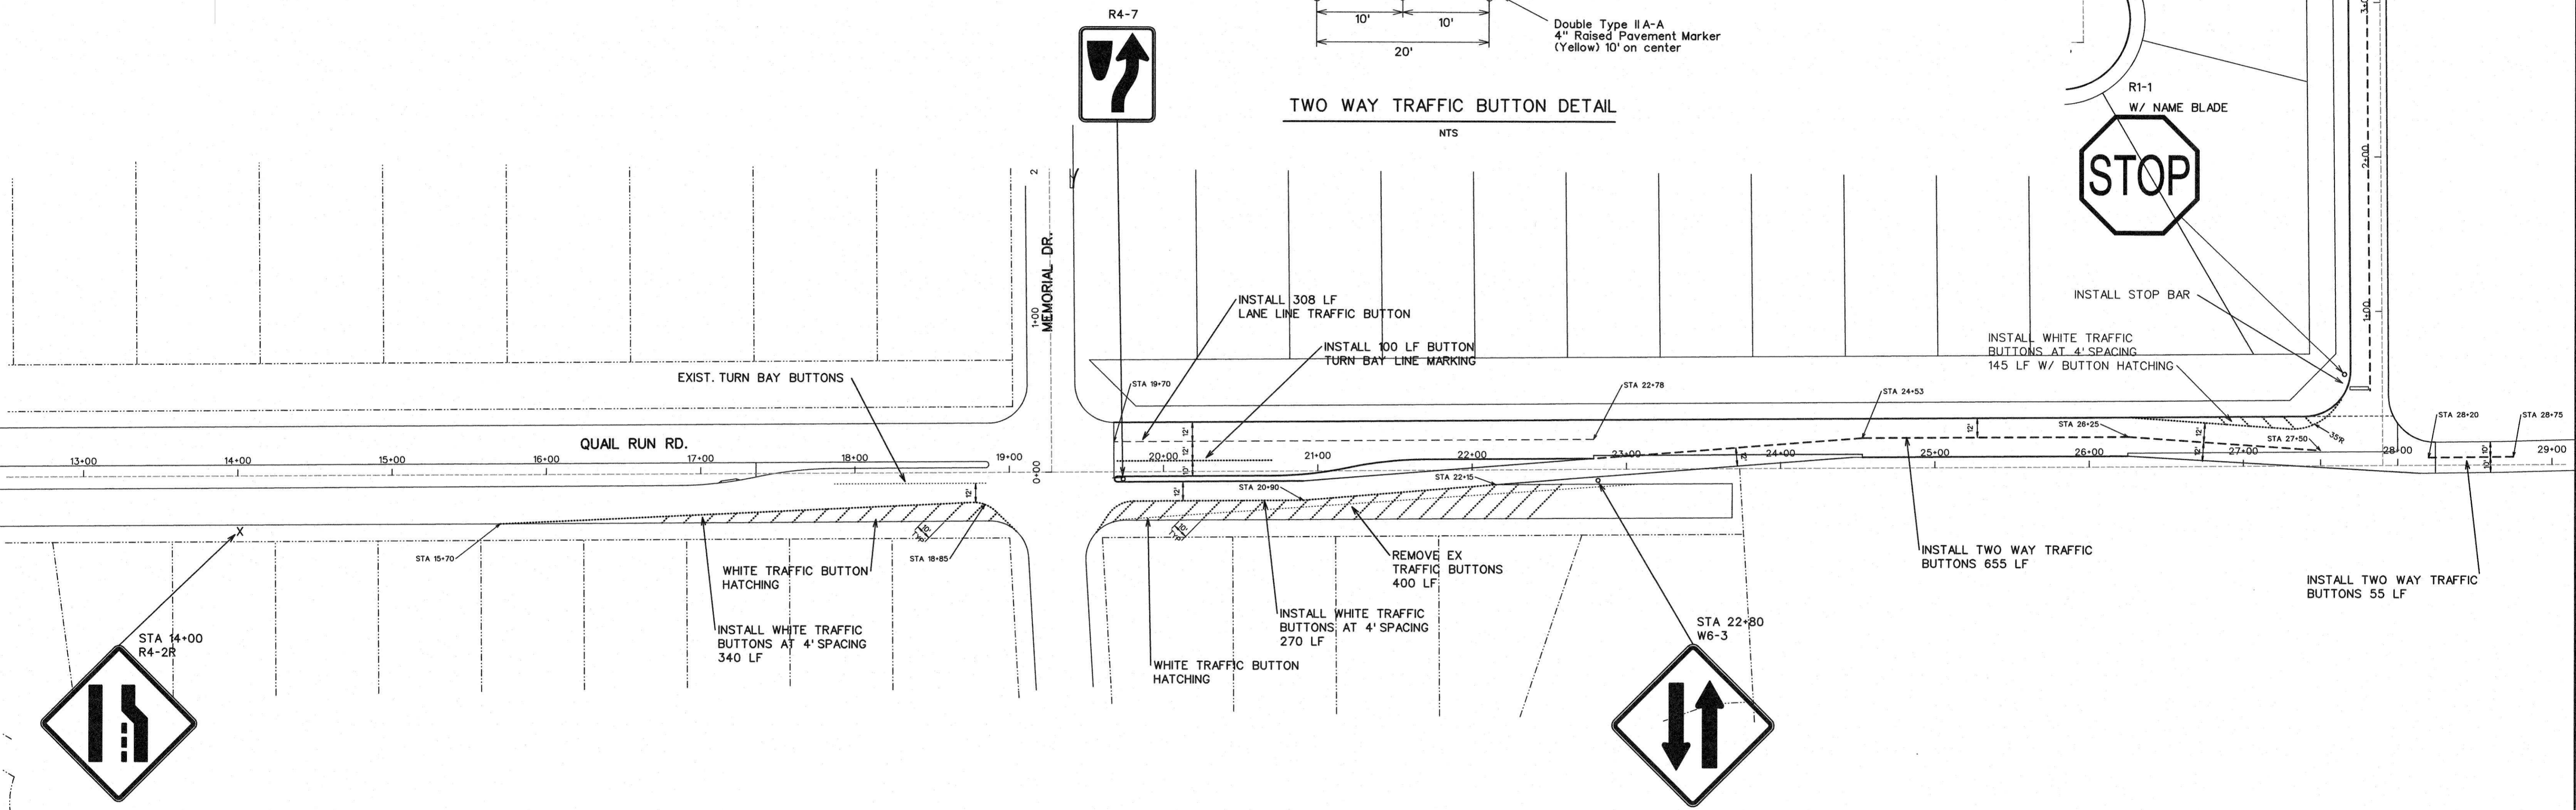

AS-BUILT SEPTEMBER 2018  
INFORMATION PROVIDED BY CONTRACTORS (NOT FIELD VERIFIED)

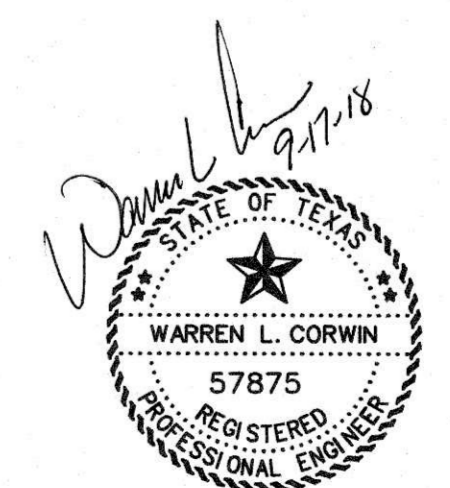

<b>CORWIN ENGINEERING, INC.</b> 200 W. BELMONT, SUITE E ALLEN, TEXAS 75013 (972)396-1200 TBPE FIRM #5951			
DEVELOPMENT PLANS FOR <b>STONE CREEK PHASE VIII</b> ROCKWALL, TEXAS			
<b>QUAIL RUN ROAD TRAFFIC SIGNAGE PLAN</b>			
DRAWN BY	DESIGNED BY	CHECKED BY	SHEET NO.
JOB NUMBER	DATE	SCALE:	28 OF 32
16044	OCTOBER 2016	1"=50'	