

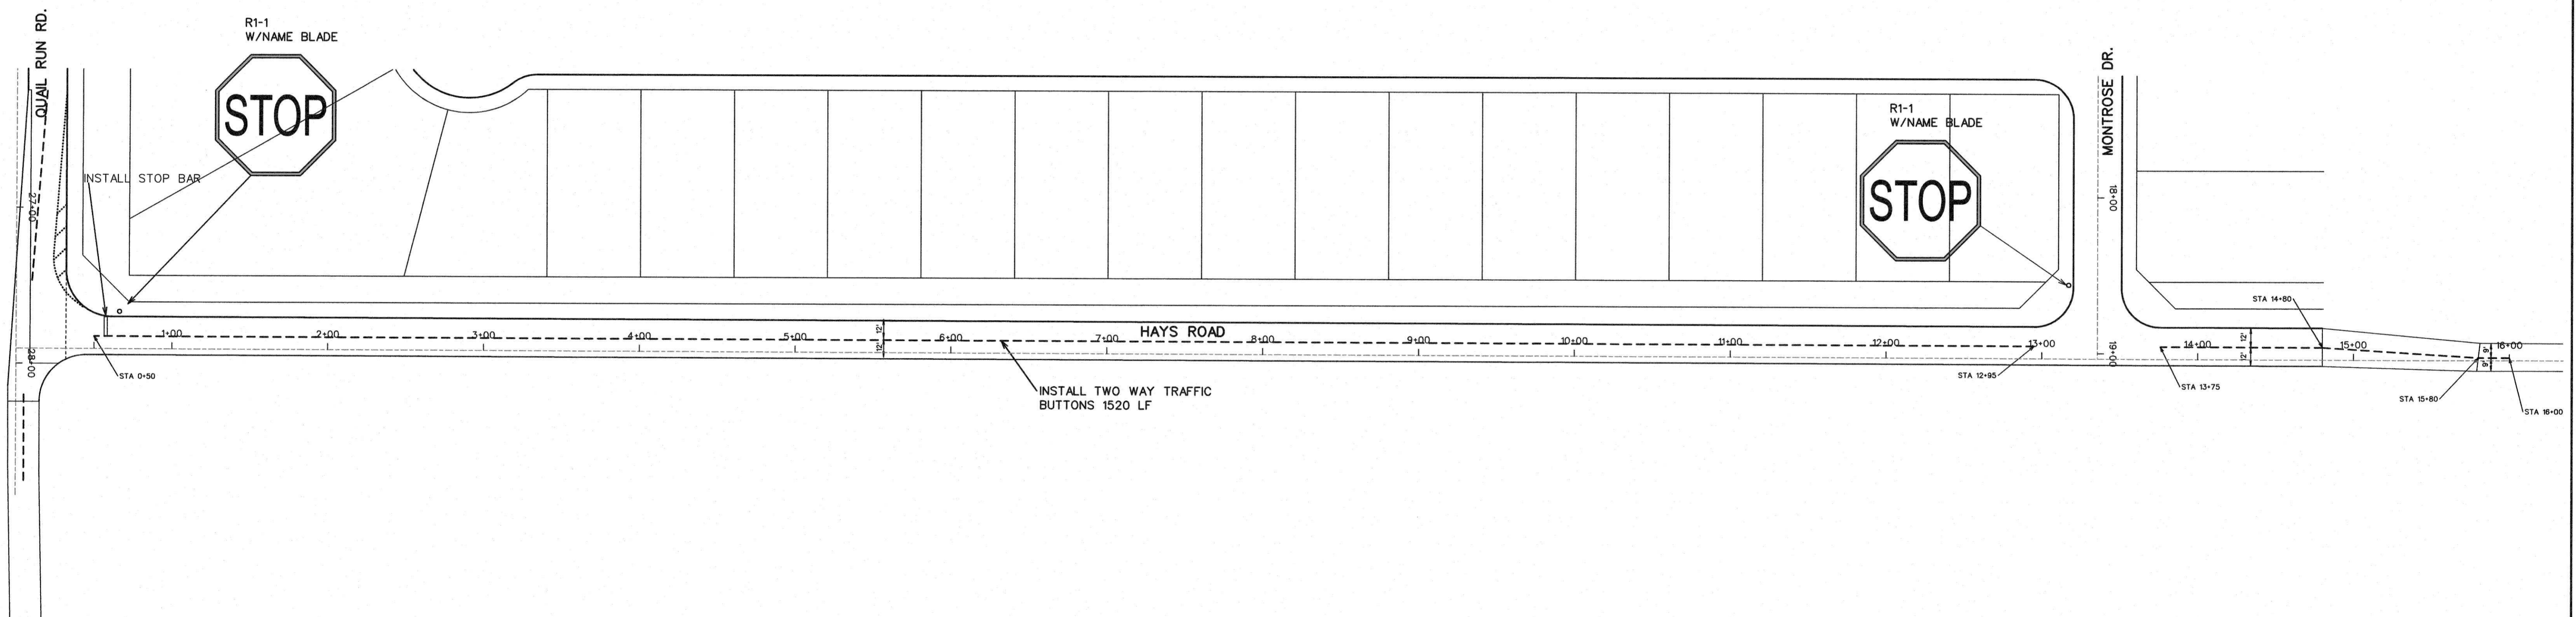


TWO WAY TRAFFIC BUTTON DETAIL

NTS

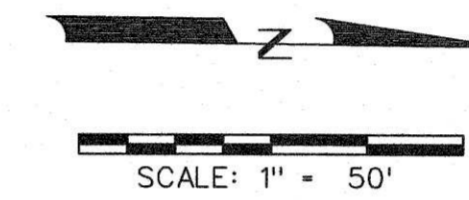

AS-BUILT SEPTEMBER 2018
INFORMATION PROVIDED
BY CONTRACTORS
(NOT FIELD VERIFIED)

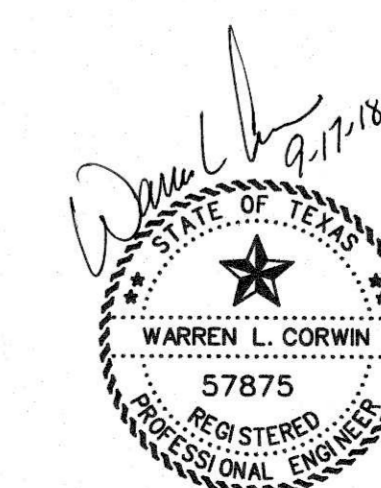

<p>CORWIN ENGINEERING, INC. 200 W. BELMONT, SUITE E ALLEN, TEXAS 75013 (972)396-1200 TBPE FIRM #5951</p>			
<p>DEVELOPMENT PLANS FOR STONE CREEK PHASE VIII ROCKWALL, TEXAS</p>			
<p>HAYS ROAD TRAFFIC SIGNAGE PLAN</p>			
DRAWN BY	DESIGNED BY	CHECKED BY	SHEET NO.
JOB NUMBER	DATE	SCALE:	29 of 32
18044	OCTOBER 2016	1"=50'	