


INTERSECTION DETAIL

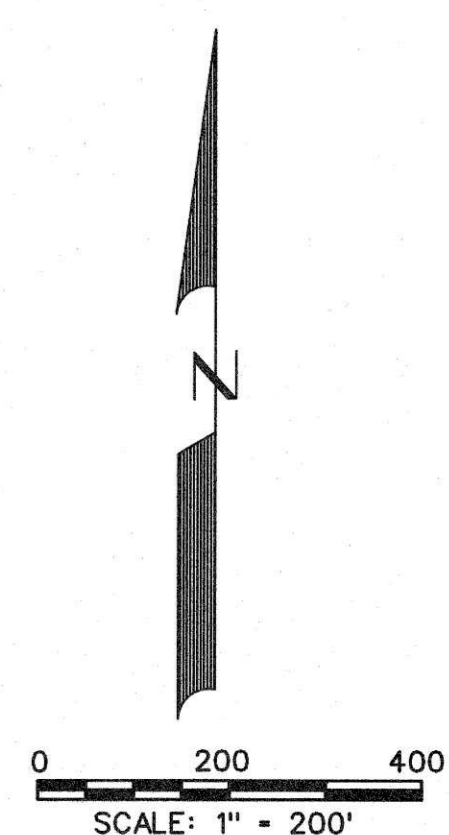


CONTRACTOR RESPONSIBLE FOR NOTIFYING A MINIMUM OF TWO WEEKS IN ADVANCE THE FOLLOWING CITY DEPARTMENTS, PERSONNEL AND ENTITIES OF ROAD CLOSURES OR CHANGES TO PRIOR TO CLOSURE OCCURRING:
 -ENGINEERING CONSTRUCTION INSPECTOR
 -FIRE DEPARTMENT
 -POLICE DEPARTMENT
 -INTERNAL OPERATIONS
 -ROCKWALL ISD
 -UTILITY BILLING
 -POST OFFICE

NOTES:
 1. STONE CREEK PHASE 8 STREETS (MONTROSE NAKOMA HARVARD EMERSON, WANETA AND HAYS) TO BE CONSTRUCTED DURING THIS PHASE.

AS-BUILT SEPTEMBER 2018
 INFORMATION PROVIDED
 BY CONTRACTORS
 (NOT FIELD VERIFIED)

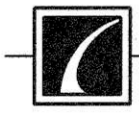

 CORWIN ENGINEERING, INC. 200 W. BELMONT, SUITE E ALLEN, TEXAS 75013 (972)396-1200 TBPE FIRM #5951			
DEVELOPMENT PLANS FOR STONE CREEK PHASE VIII ROCKWALL, TEXAS			
PHASE ONE DETOUR PLAN HAYS ROAD CLOSURE			
DRAWN BY	DESIGNED BY	CHECKED BY	SHEET NO.
JOB NUMBER 16044	DATE OCTOBER 2016	SCALE: 1"=200'	30 OF 32