


INTERSECTION DETAIL

CONTRACTOR RESPONSIBLE FOR NOTIFYING A MINIMUM OF TWO WEEKS IN ADVANCE THE FOLLOWING CITY DEPARTMENTS, PERSONNEL AND ENTITIES OF ROAD CLOSURES OR CHANGES TO PRIOR TO CLOSURE OCCURRING:

- ENGINEERING CONSTRUCTION INSPECTOR
- FIRE DEPARTMENT
- POLICE DEPARTMENT
- INTERNAL OPERATIONS
- ROCKWALL ISD
- UTILITY BILLING
- POST OFFICE

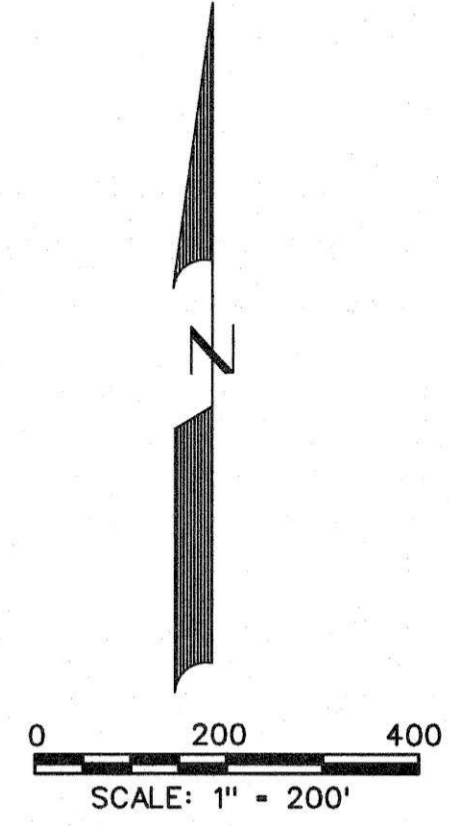

NOTES:

1. QUAIL RUN SHALL NOT BE CLOSED UNTIL HAYS ROAD, MEMORIAL DRIVE, AND MONTROSE DRIVE ARE OPEN FOR TRAFFIC.
2. ALL IMPROVEMENTS ALONG THE DETOUR ROUTE TO BE USED MUST BE FINAL ACCEPTED BY THE CITY OF ROCKWALL BEFORE THE DETOUR ROUTE CAN BE OPENED TO TRAFFIC.

ROAD CLOSED TO THRU TRAFFIC

DETOUR
→
QUAIL RUN

THREE - TYPE III BARRICADES WITH
ROAD CLOSED
DETOUR
←
QUAIL RUN

DETOUR
←
QUAIL RUN

ROAD CLOSED AHEAD

THREE - TYPE III BARRICADES WITH
ROAD CLOSED

DETOUR
←
QUAIL RUN

ROAD CLOSED AHEAD
500 FT

ROAD CLOSED AHEAD
1000 FT

AS-BUILT SEPTEMBER 2018
INFORMATION PROVIDED BY CONTRACTORS (NOT FIELD VERIFIED)



CORWIN ENGINEERING, INC. 200 W. BELMONT, SUITE E ALLEN, TEXAS 75013 (972)396-1200 TBPE FIRM #5951			
DEVELOPMENT PLANS FOR STONE CREEK PHASE VIII ROCKWALL, TEXAS			
PHASE 3 DETOUR PLAN QUAIL RUN CLOSURE			
DRAWN BY	DESIGNED BY	CHECKED BY	SHEET NO.
JOB NUMBER 16044	DATE OCTOBER 2016	SCALE: 1"=200'	32 OF 32