


LEGEND table listing symbols for various features like bollards, power poles, water meters, erosion control types, and property lines.

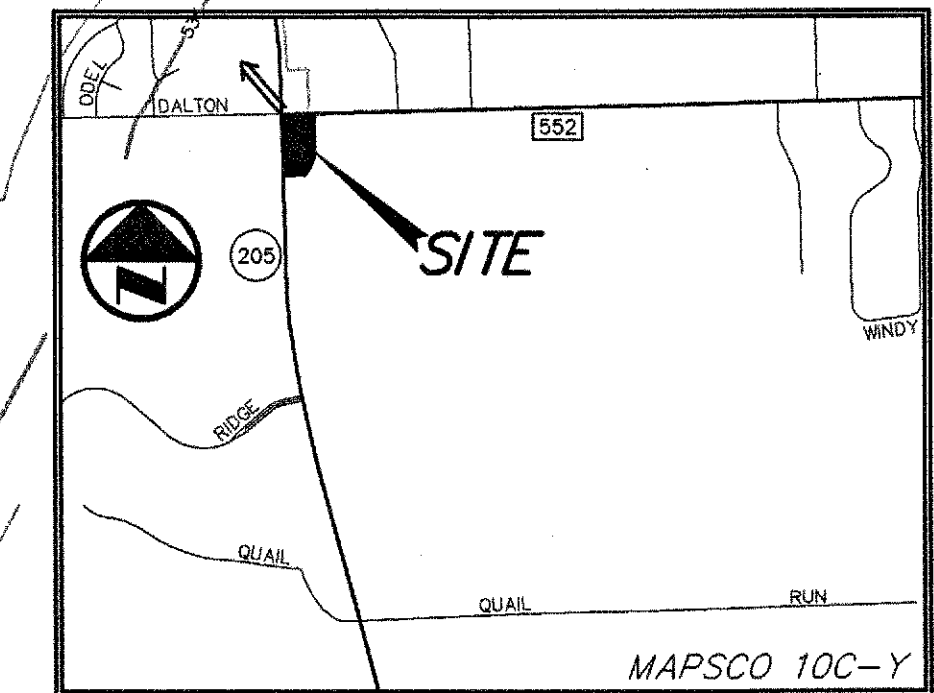


NOTE: OFF-SITE PAVING, GRADING, DRAINAGE, AND EROSION CONTROL IMPROVEMENTS TO BE APPROVED BY ADJACENT PROPERTY OWNER VIA A LETTER OF PERMISSION.

RECORD DRAWINGS: IT WAS THE INTENT THAT THE IMPROVEMENTS SHOWN BE CONSTRUCTED ACCORDING TO THESE PLANS AS APPROVED BY THE CITY...

- CONSTRUCTION ACTIVITIES: 1. REFER TO SHEET C4.02 FOR THE EROSION CONTROL DETAILS AND POLLUTION PREVENTION PLAN NOTES/SPECIFICATIONS/REQUIREMENTS. 2. THE CONTRACTOR SHALL BE RESPONSIBLE FOR MAINTAINING ALL MEASURES OF THIS EROSION CONTROL PLAN (SWPPP) AND COMPLYING WITH ALL FEDERAL, STATE AND LOCAL REQUIREMENTS REGARDING THE SWPPP. 3. THE CONTRACTOR SHALL BE RESPONSIBLE FOR INSTALLING AND MAINTAINING THESE MEASURES INCLUDING WATERING, MOWING AND GENERAL MAINTENANCE UNLESS OTHERWISE RELIEVED OF THESE DUTIES BY THE OWNER.

- EROSIONS CONTROL GENERAL NOTES: 1. REFER TO SHEET C4.02 FOR THE EROSION CONTROL DETAILS AND POLLUTION PREVENTION PLAN NOTES/SPECIFICATIONS/REQUIREMENTS. 2. THE CONTRACTOR SHALL BE RESPONSIBLE FOR MAINTAINING ALL MEASURES OF THIS EROSION CONTROL PLAN (SWPPP) AND COMPLYING WITH ALL FEDERAL, STATE AND LOCAL REQUIREMENTS REGARDING THE SWPPP. 3. THE CONTRACTOR SHALL BE RESPONSIBLE FOR INSTALLING AND MAINTAINING THESE MEASURES INCLUDING WATERING, MOWING AND GENERAL MAINTENANCE UNLESS OTHERWISE RELIEVED OF THESE DUTIES BY THE OWNER.

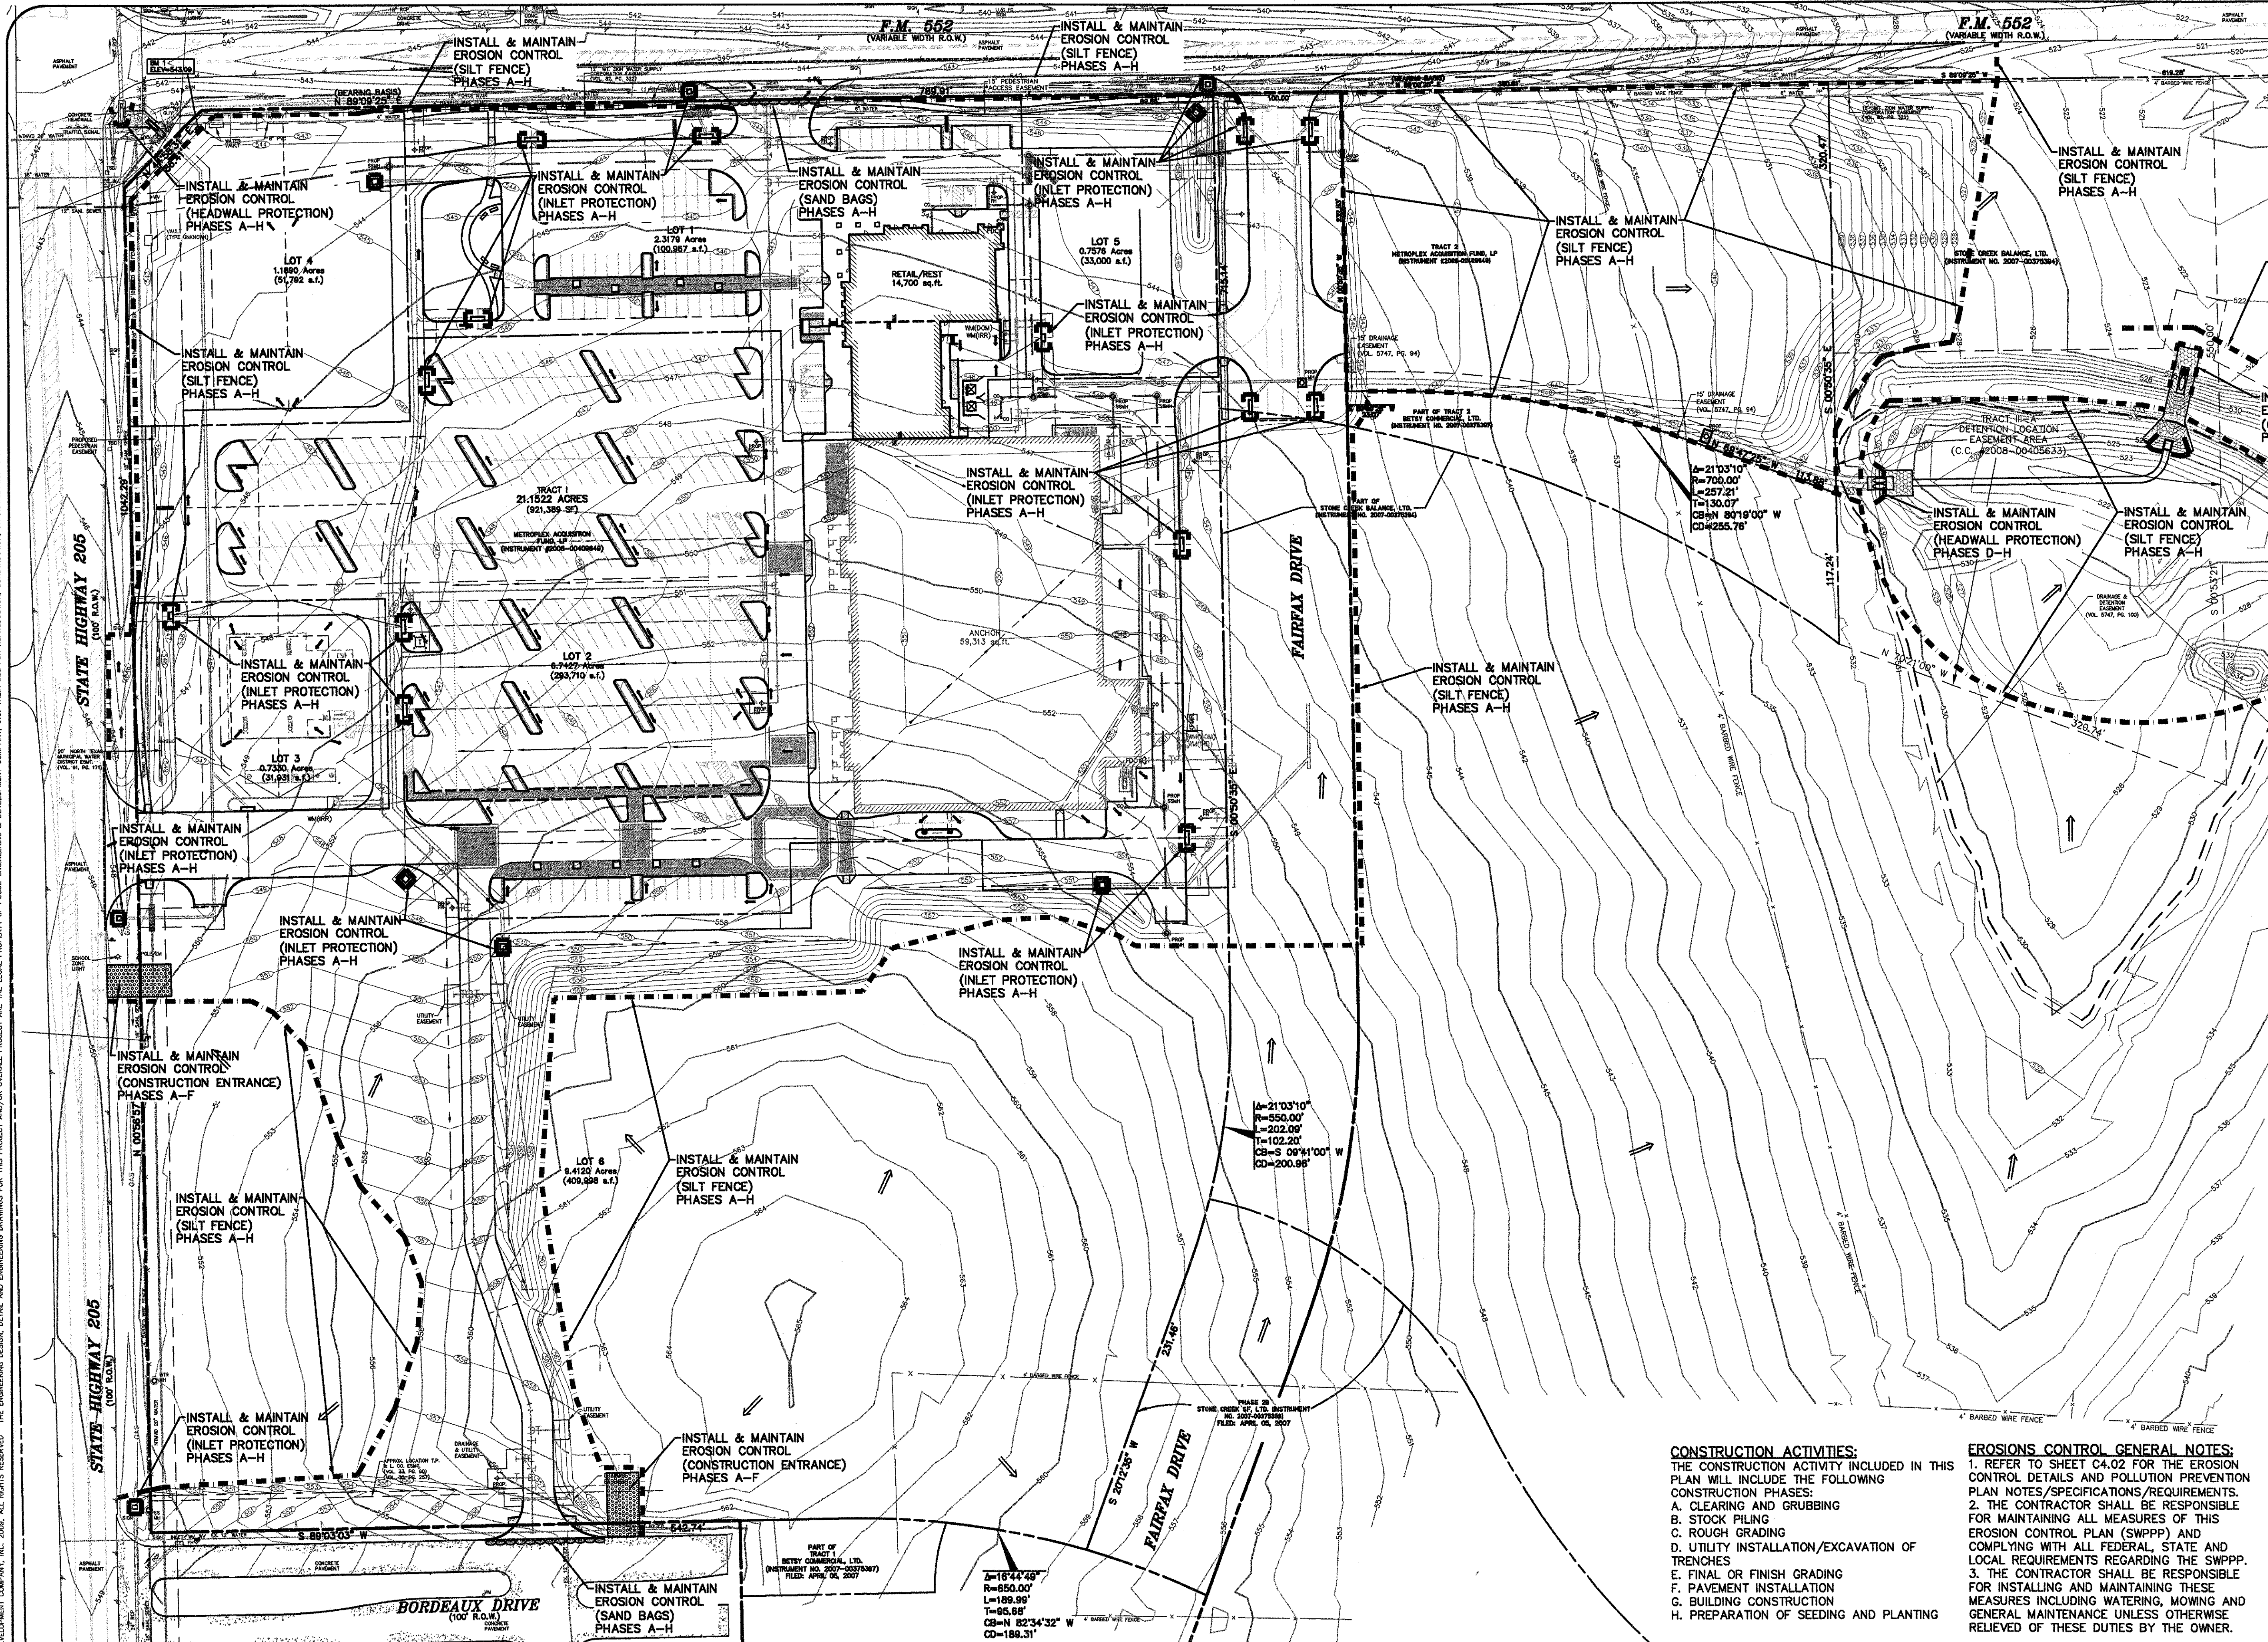


Revision table with columns for NO., DATE, REVISION / DESCRIPTION, and NOTES.

OWNER: METROPLEX ACQUISITION FUND, LP, 8214 WESTCHESTER, SUITE 850, DALLAS, TEXAS 75225. MR. GREY STOGNER (214) 343-4477 PHONE, (214) 340-2029 FAX.

DEVELOPER: CRESTVIEW REAL ESTATE, L.L.C., 8214 WESTCHESTER, SUITE 850, DALLAS, TEXAS 75225. MR. GREY STOGNER (214) 343-4477 PHONE, (214) 340-2029 FAX.

THE SEAL APPEARING ON THIS DOCUMENT WAS AUTHORIZED BY BRANDON E. COX, P.E. 101037 ON 05-21-09. ALTERATION OF A SEALED DOCUMENT WITHOUT PROPER NOTIFICATION TO THE RESPONSIBLE ENGINEER IS AN OFFENSE UNDER THE TEXAS ENGINEERING PRACTICE ACT.

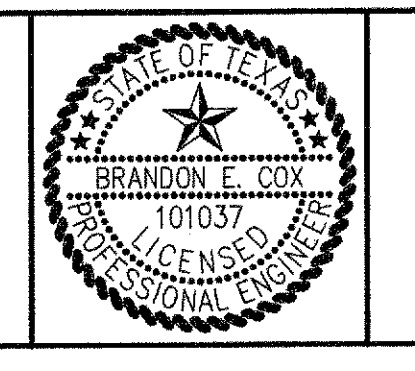

POGUE ENGINEERING & DEVELOPMENT COMPANY, INC. 1512 GRAY CENTRAL DRIVE, SUITE 100, MCKINNEY, TEXAS 75069. (214) 544-8880 PHONE, (214) 544-8882 FAX, www.PogueEngineering.com

EROSION CONTROL SITE PLAN (SWPPP) STONE CREEK RETAIL BLOCK A, LOTS 1-6, STONE CREEK RETAIL ADDITION W.T. DEWESE SURVEY, ABSTRACT NO. 71 CITY OF ROCKWALL, TEXAS

SHEET NO. C4.01