



SILT FENCE GENERAL NOTES:


- STEEL POSTS WHICH SUPPORT THE SILT FENCE SHALL BE INSTALLED ON A SLIGHT ANGLE TOWARD THE ANTICIPATED RUNOFF SOURCE. POST MUST BE EMBEDDED A MINIMUM OF ONE FOOT.
- THE TOE OF THE SILT FENCE SHALL BE TRENCHED IN WITH A SPIKE OR MECHANICAL TRENCHER, SO THAT THE DOWN SLOPE FACE OF THE TRENCH IS FLAT AND PERPENDICULAR TO THE LINE OF FLOW. WHERE FENCE CANNOT BE TRENCHED IN (ELEVATION), HEIGHT FABRIC FLAP WITH ROCK ON UPHILL SIDE TO PREVENT FLOW FROM SEEDING UNDER FENCE.
- THE TRENCH MUST BE A MINIMUM OF 6 INCHES DEEP AND 8 INCHES WIDE TO ALLOW FOR THE SILT FENCE FABRIC TO BE LAD IN THE GROUND AND BACK FILLED WITH COMPACTED MATERIAL. SILT FENCE SHOULD BE SECURELY FASTENED TO EACH STEEL SUPPORT POST OR TO WOVEN WIRE, WHICH IN TURN IS ATTACHED TO THE STEEL FENCE POST. THERE SHALL BE A 3 FOOT OVERLAP, SECURELY FASTENED ENDS OF FABRIC MEET.
- SILT FENCE SHALL BE MADE EVERY TWO WEEKS AND AFTER EACH 1/2" RAINFALL. REPAIR OR REPLACEMENT SHALL BE MADE PROMPTLY AS NEEDED.
- SILT FENCE SHALL BE REMOVED WHEN THE SITE IS COMPLETELY STABILIZED SO AS NOT TO BLOCK OR IMPED STORM FLOW OR DRAINAGE.
- ACCUMULATED SILT SHALL BE REMOVED WHEN IT REACHES A DEPTH OF HALF THE HEIGHT OF THE FENCE. THE SILT SHALL BE DISPOSED OF AT AN APPROVED SITE AND IN SUCH A MANNER AS TO NOT CONTRIBUTE TO ADDITIONAL SILTING.

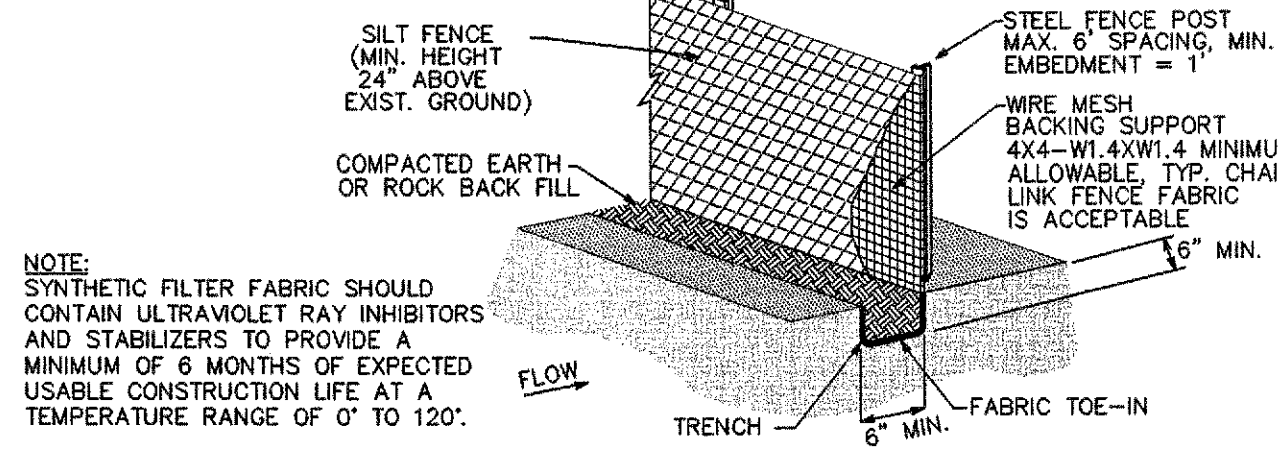


01 C4.02 SILT FENCE
NOT TO SCALE

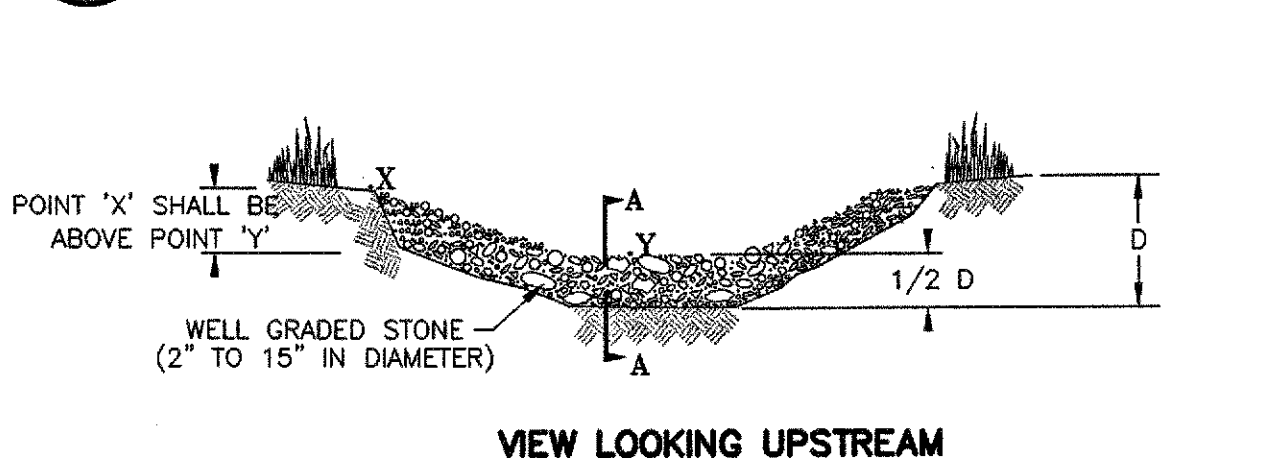


03 C4.02 ROCK CHECK DAM
NOT TO SCALE

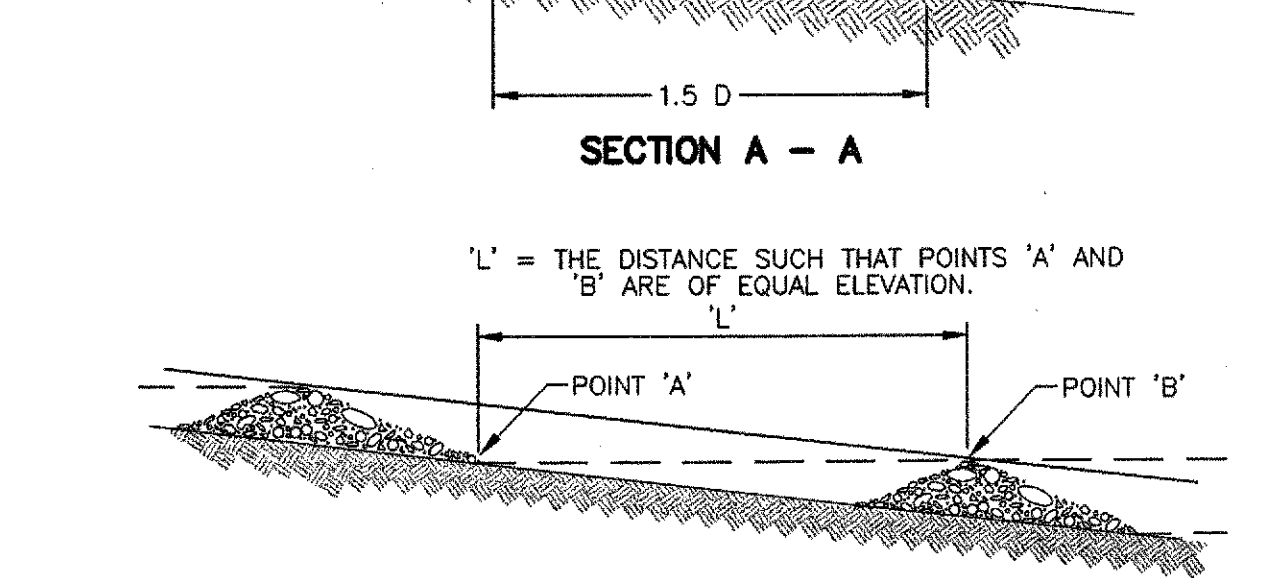


04 C4.02 PIPE INLET PROTECTION
NOT TO SCALE

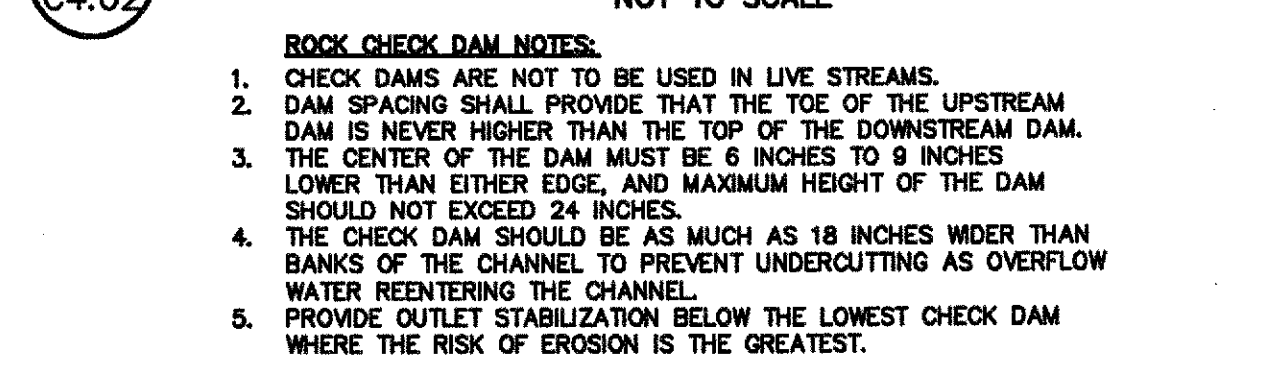


05 C4.02 CURB INLET PROTECTION
NOT TO SCALE

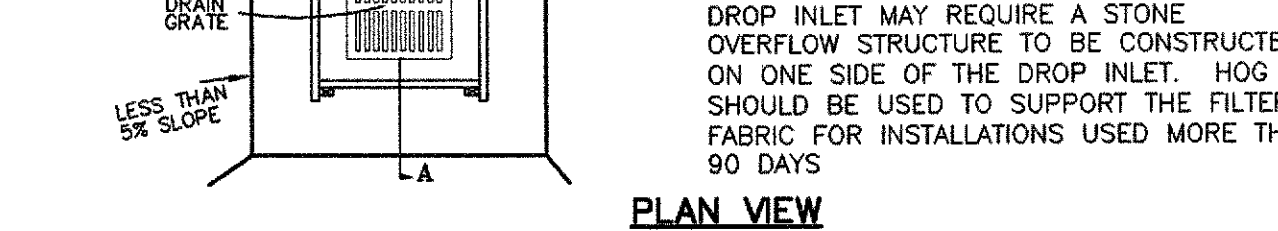


06 C4.02 DROP INLET PROTECTION
NOT TO SCALE

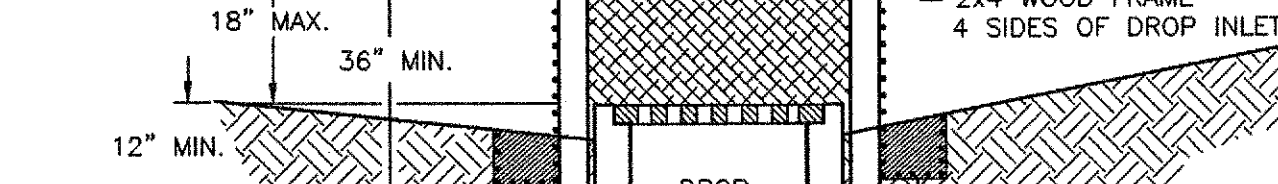


08 C4.02 EROSION CONTROL MATTING
NOT TO SCALE

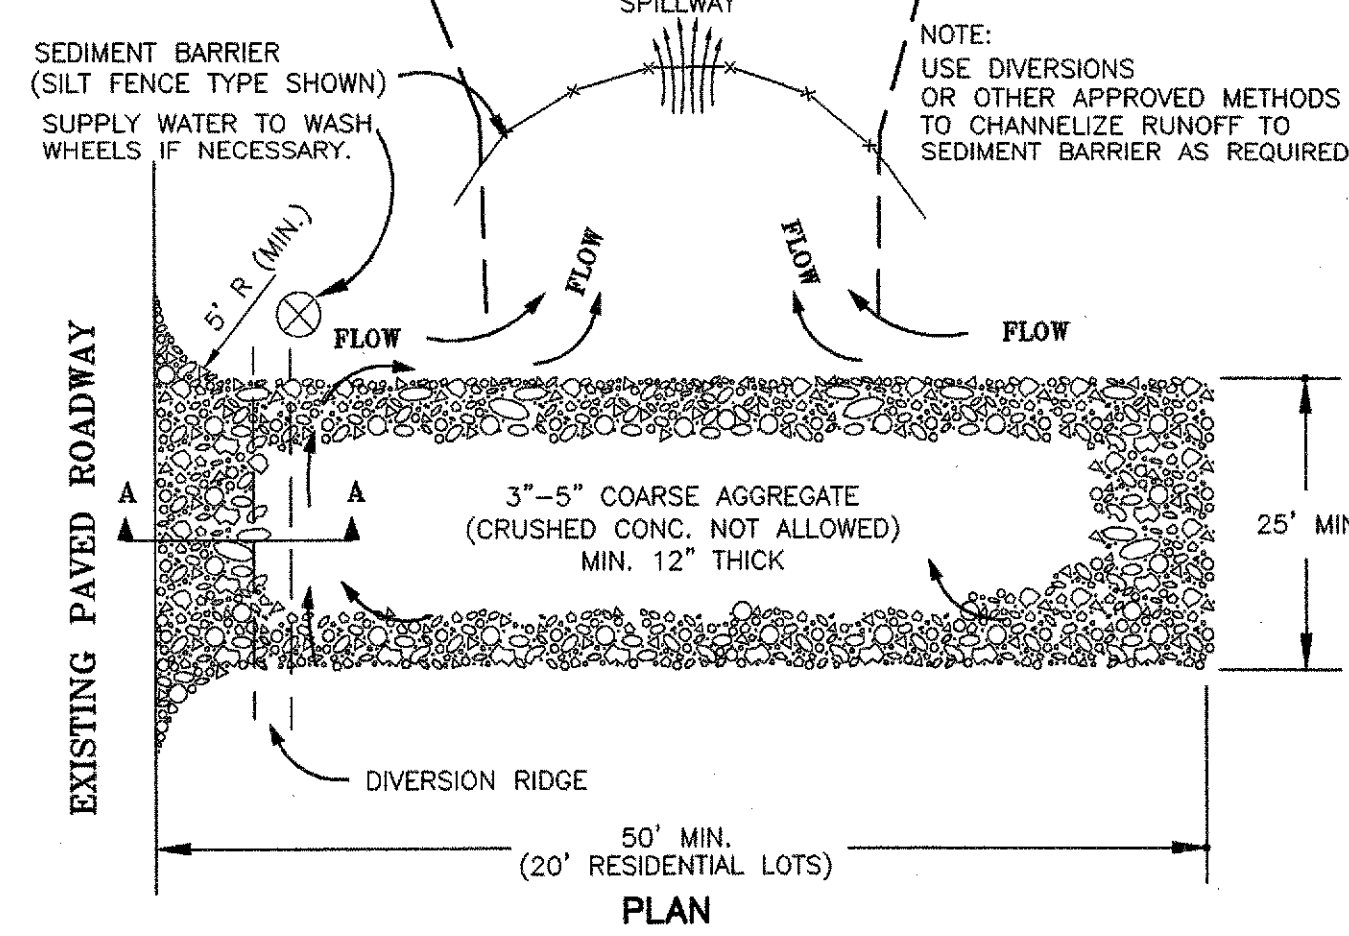


02 C4.02 CONSTRUCTION ENTRANCE
NOT TO SCALE

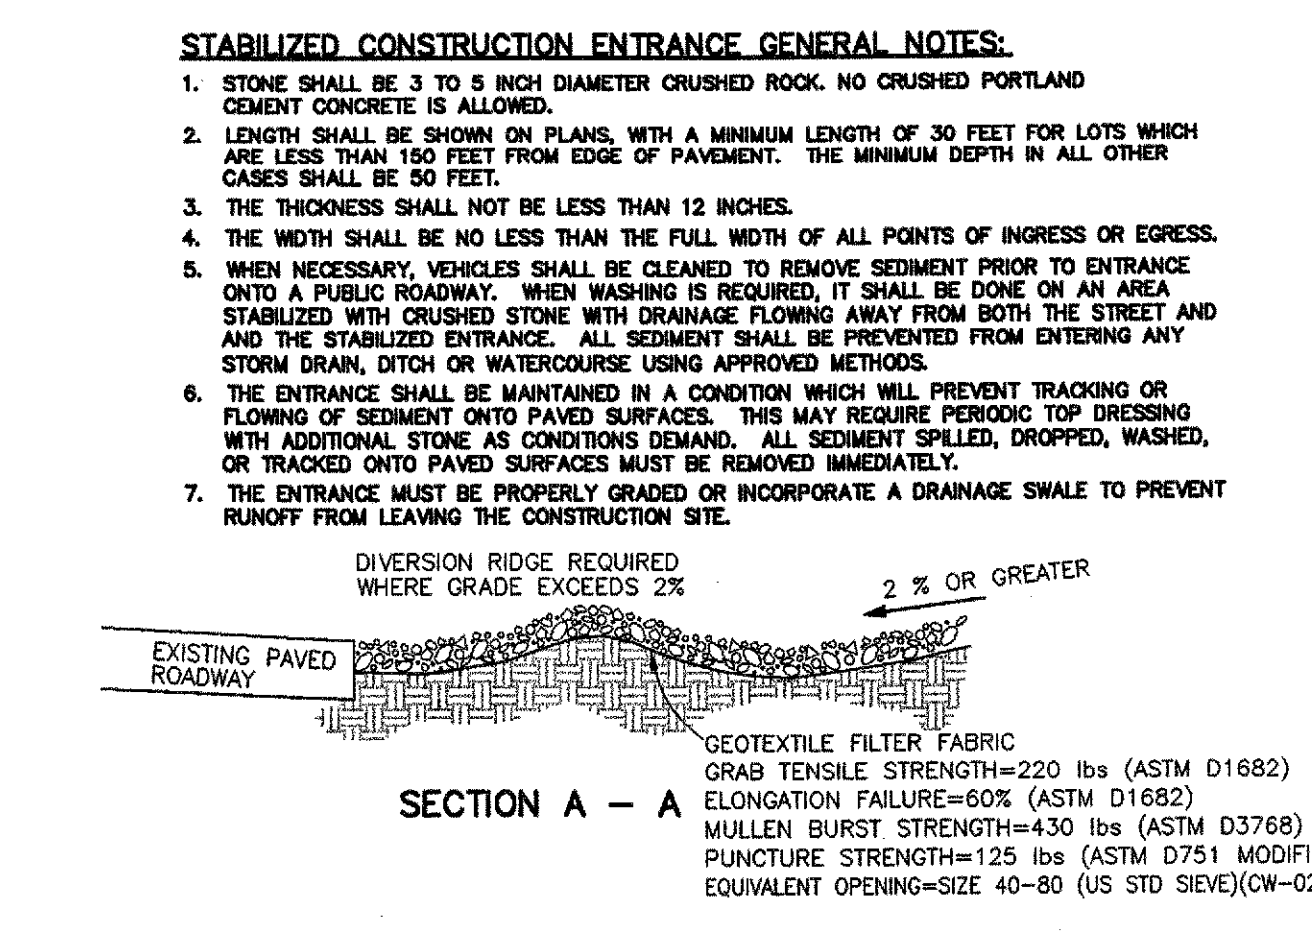

03 C4.02 ROCK CHECK DAM
NOT TO SCALE

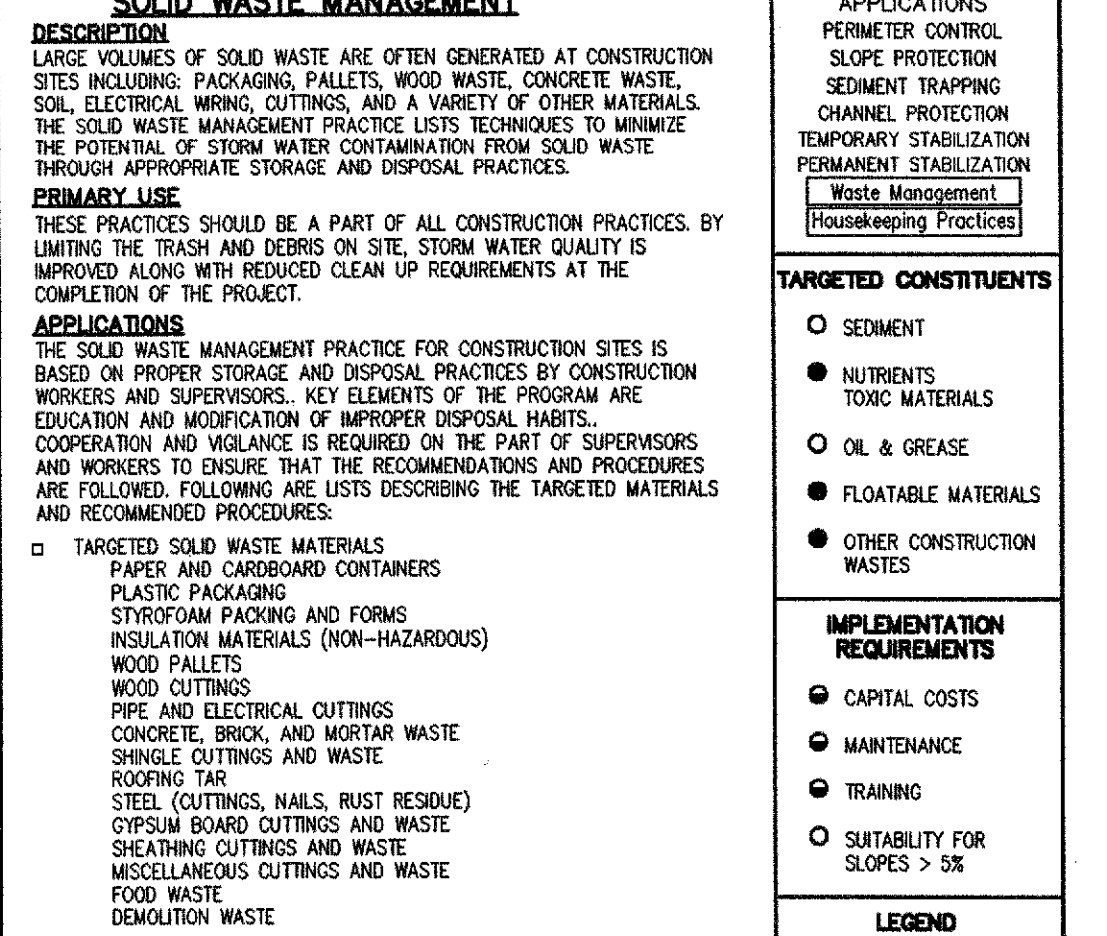


04 C4.02 PIPE INLET PROTECTION
NOT TO SCALE

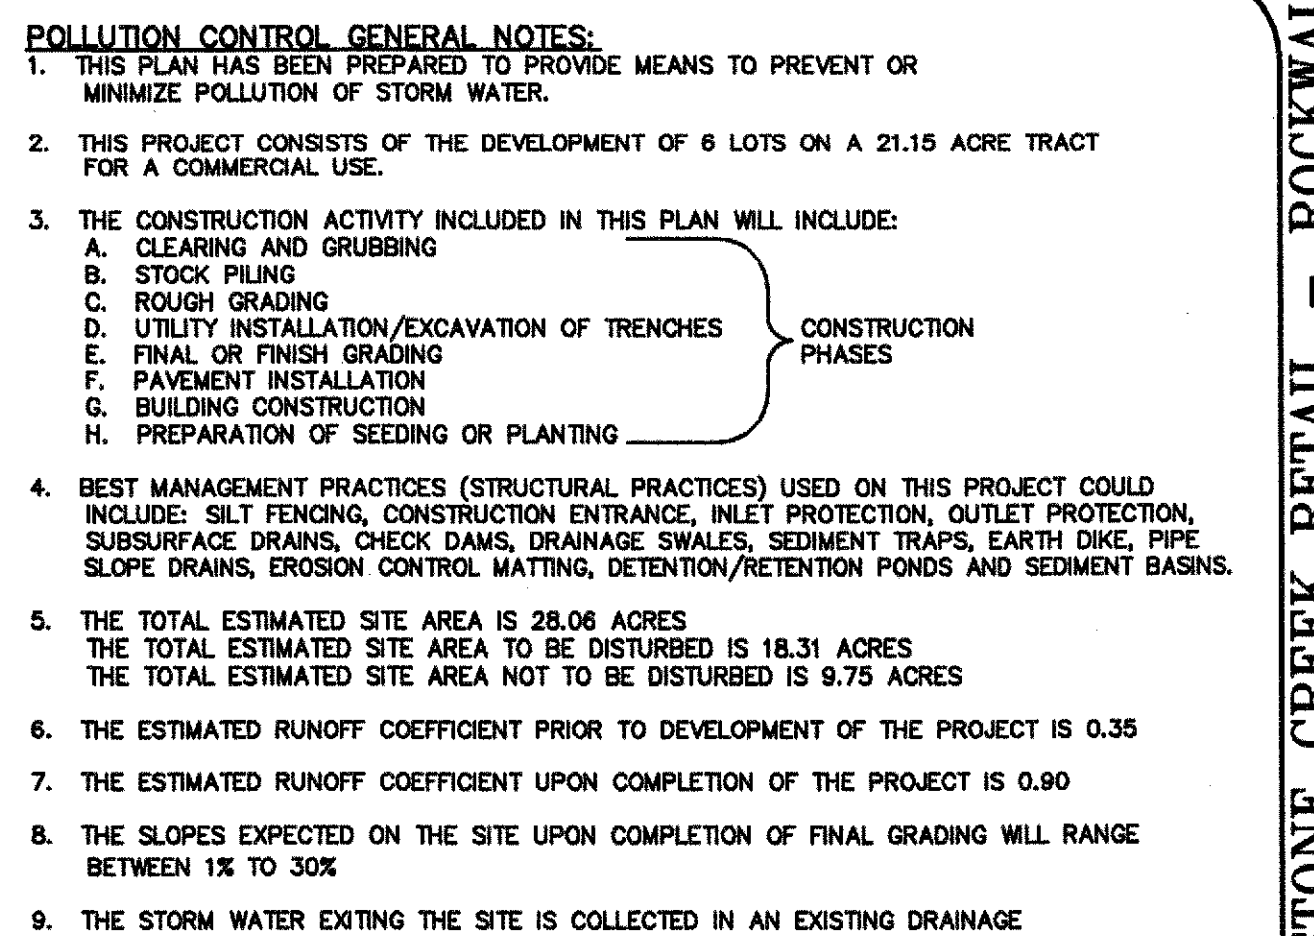


05 C4.02 CURB INLET PROTECTION
NOT TO SCALE




06 C4.02 DROP INLET PROTECTION
NOT TO SCALE

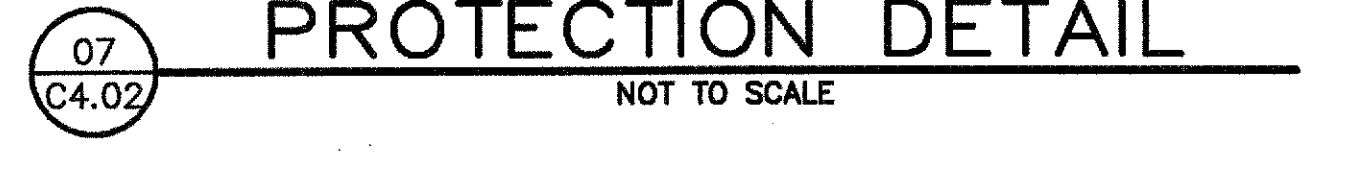


08 C4.02 EROSION CONTROL MATTING
NOT TO SCALE

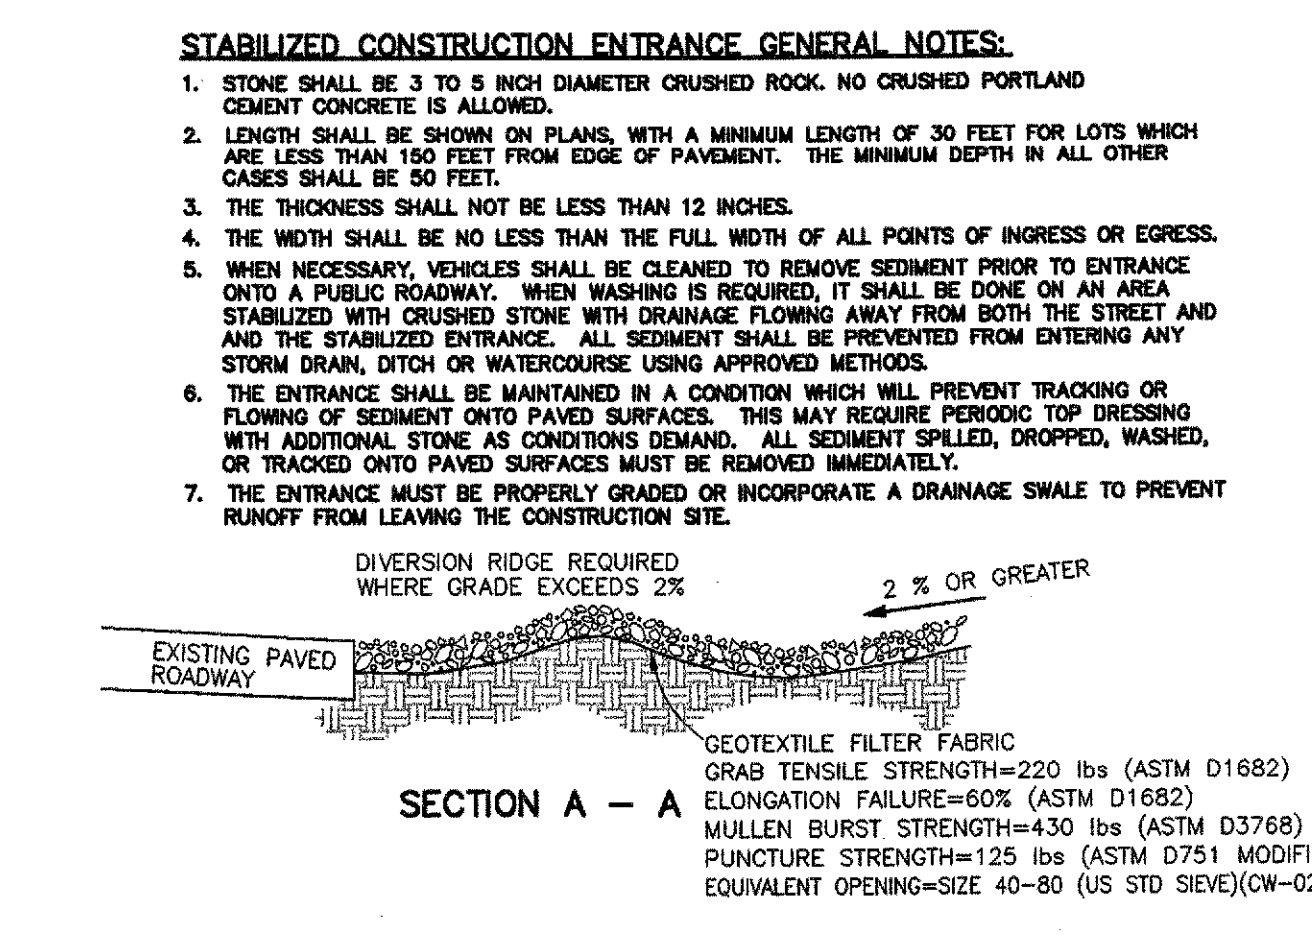

02 C4.02 CONSTRUCTION ENTRANCE
NOT TO SCALE

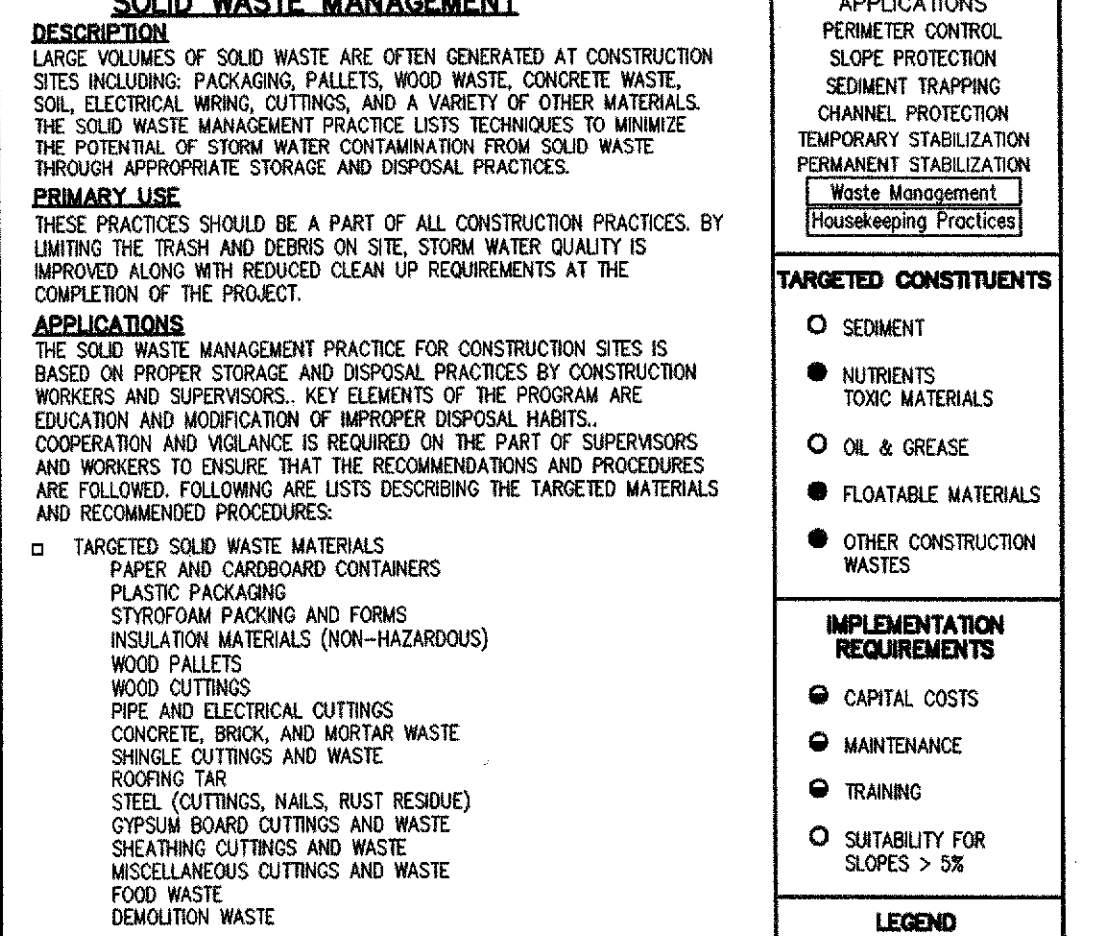

03 C4.02 ROCK CHECK DAM
NOT TO SCALE

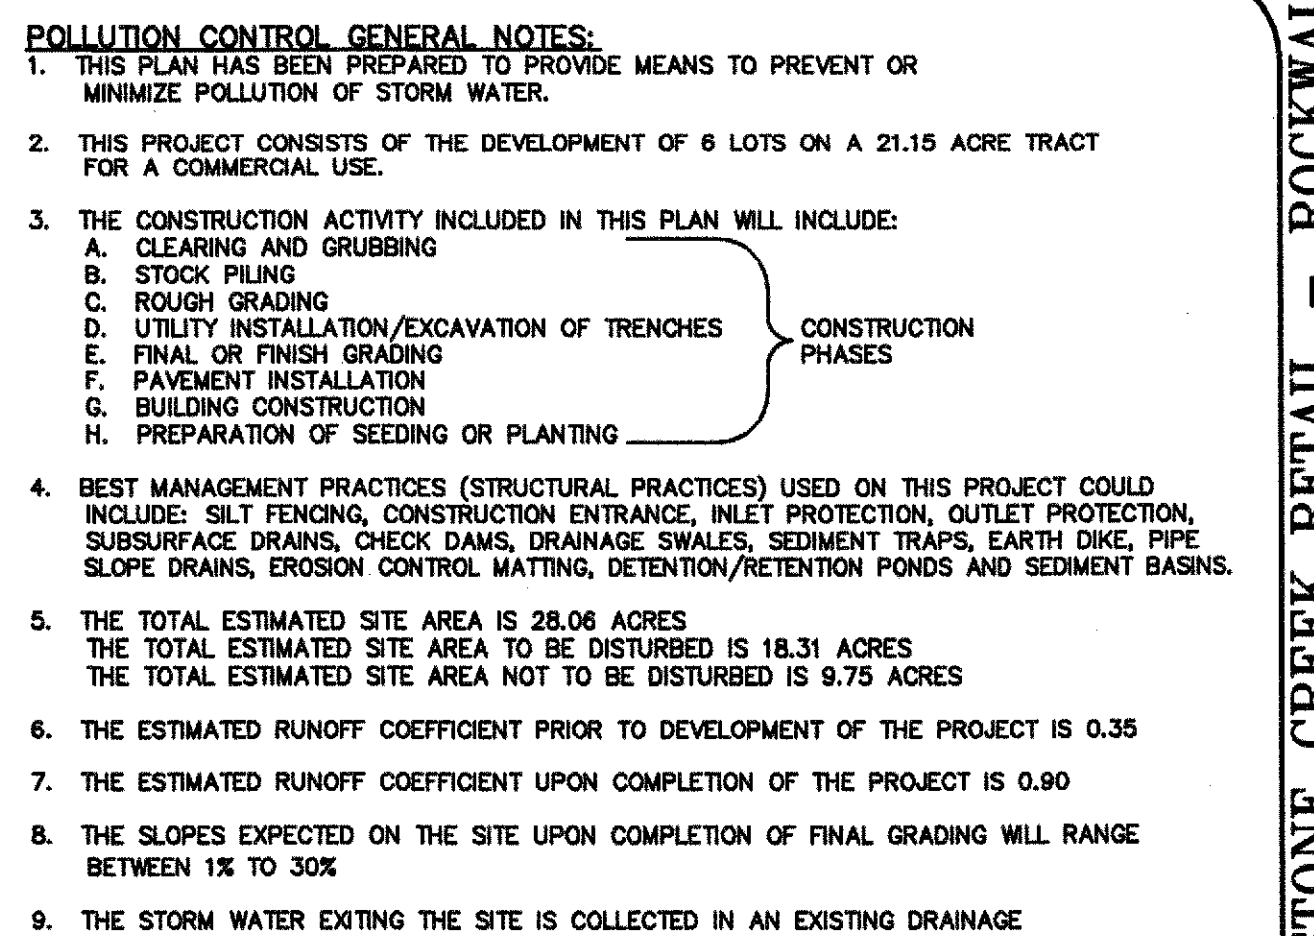


04 C4.02 PIPE INLET PROTECTION
NOT TO SCALE


NO.	DATE	REVISION / DESCRIPTION
04-15-10	RECORD DRAWINGS	
02-24-10	ADDED RIGHT TURN LANE ON S.H. 205	
07-17-09	SANITARY SEWER & ADA ROUTE REVISIONS	
06-19-09	TxDOT COMMENTS	

DESIGN	DRAWN	DATE	SCALE	NOTES
BEC	WTW	05-21-09	AS SHOWN	


OWNER	DEVELOPER
METROPLEX ACQUISITION FUND, LP 8214 WESTCHESTER, SUITE 850 DALLAS, TEXAS 75225 MR. GREY STOGNER (214) 343-4477 PHONE (214) 340-2029 FAX	CRESTVIEW REAL ESTATE, L.L.C. 8214 WESTCHESTER, SUITE 850 DALLAS, TEXAS 75225 MR. GREY STOGNER (214) 343-4477 PHONE (214) 340-2029 FAX

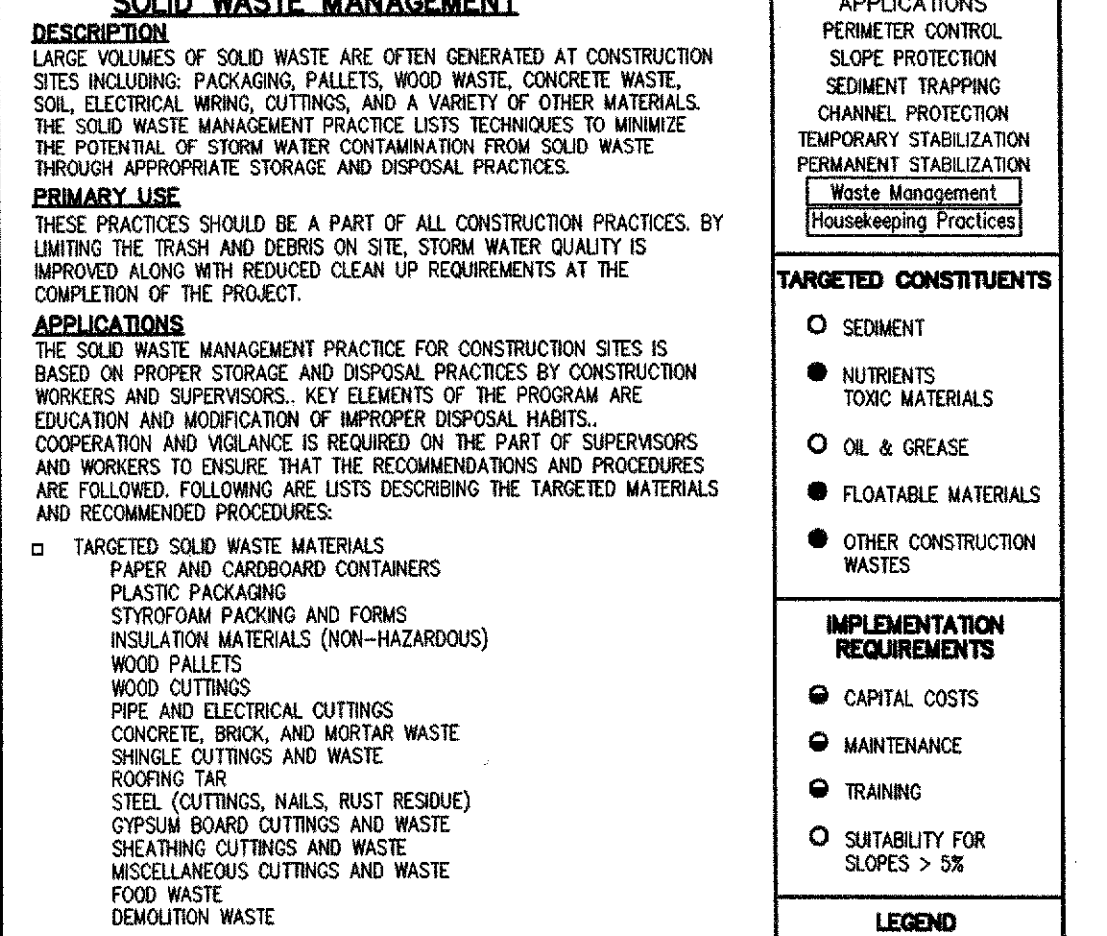


02 C4.02 CONSTRUCTION ENTRANCE
NOT TO SCALE

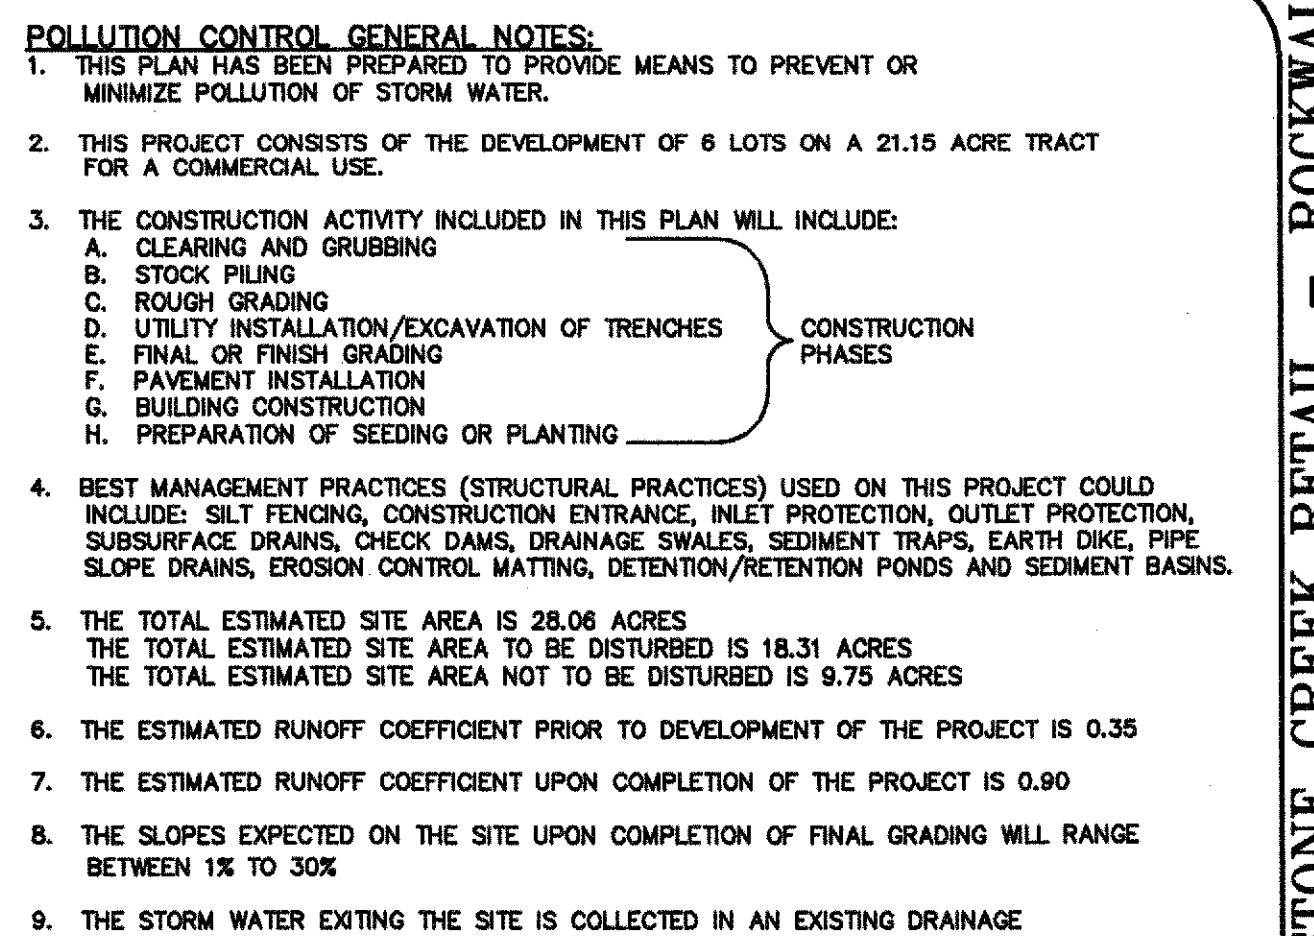


03 C4.02 ROCK CHECK DAM
NOT TO SCALE

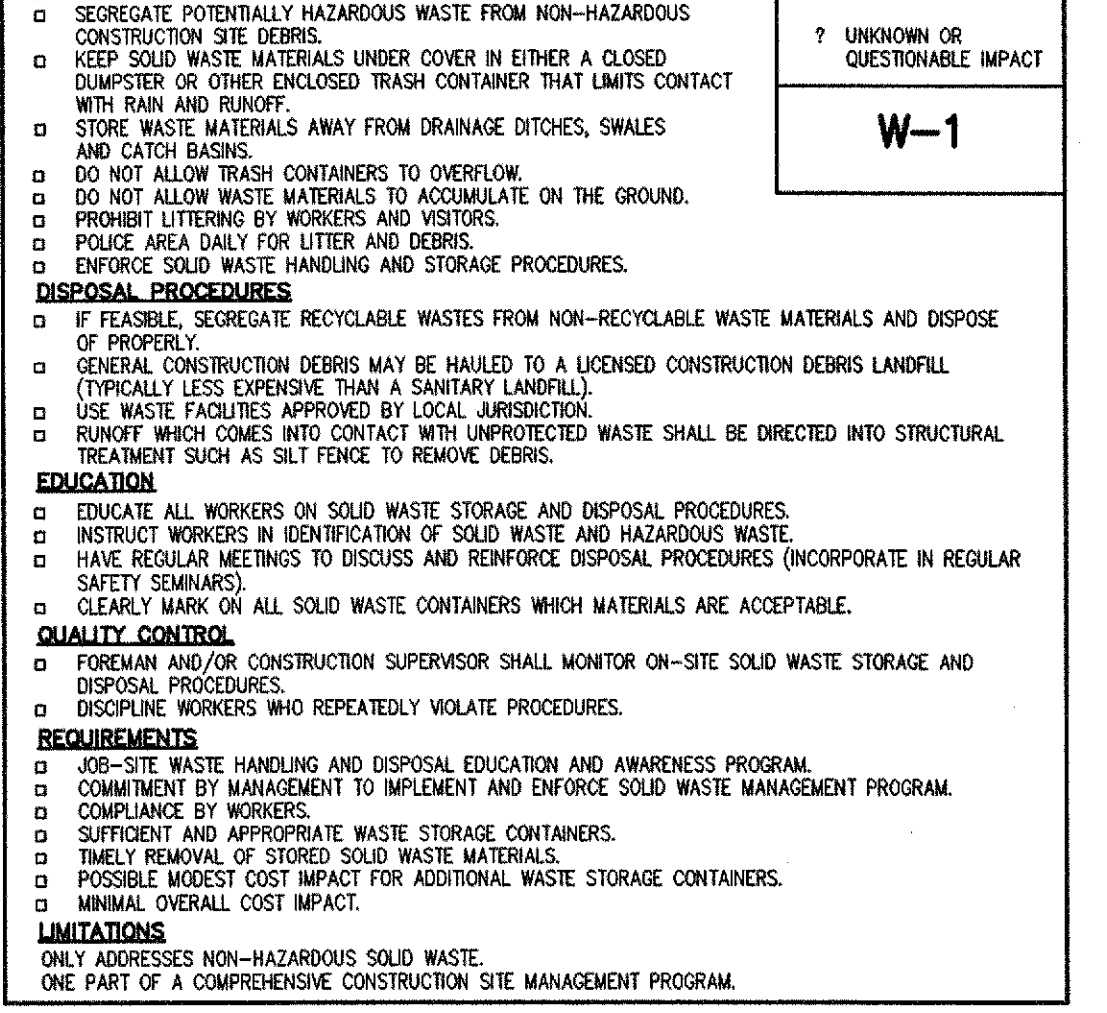


04 C4.02 PIPE INLET PROTECTION
NOT TO SCALE

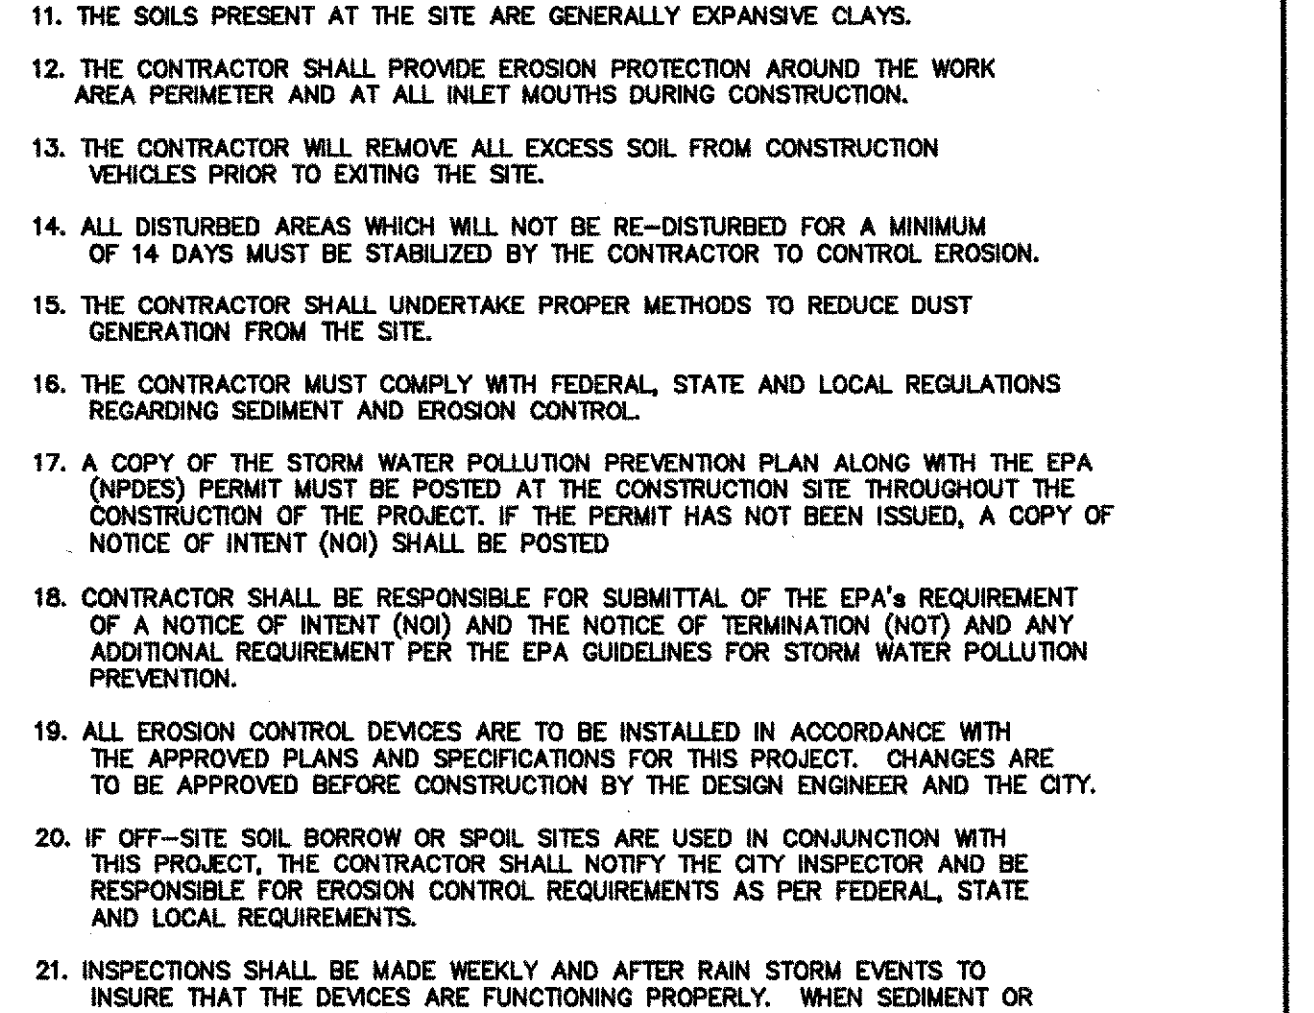


05 C4.02 CURB INLET PROTECTION
NOT TO SCALE

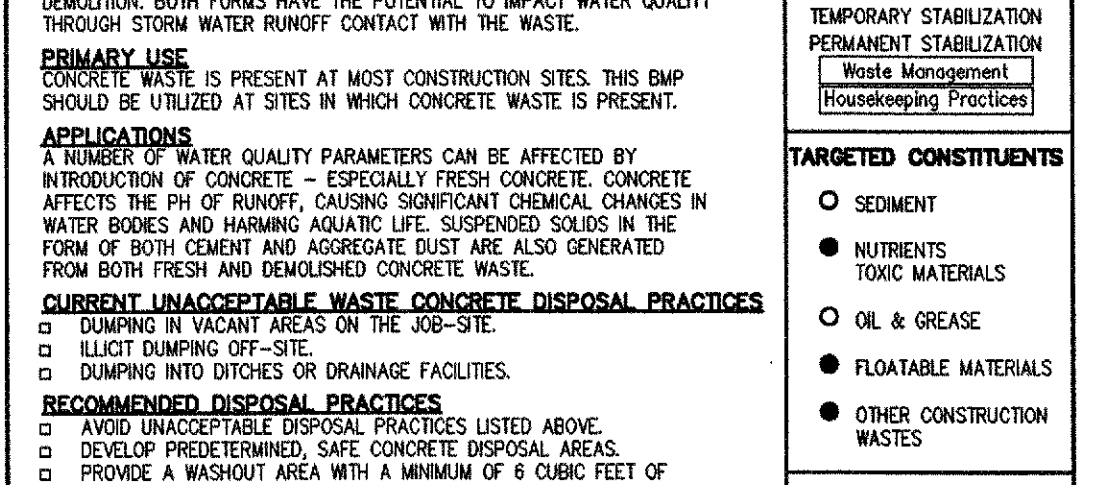


06 C4.02 DROP INLET PROTECTION
NOT TO SCALE

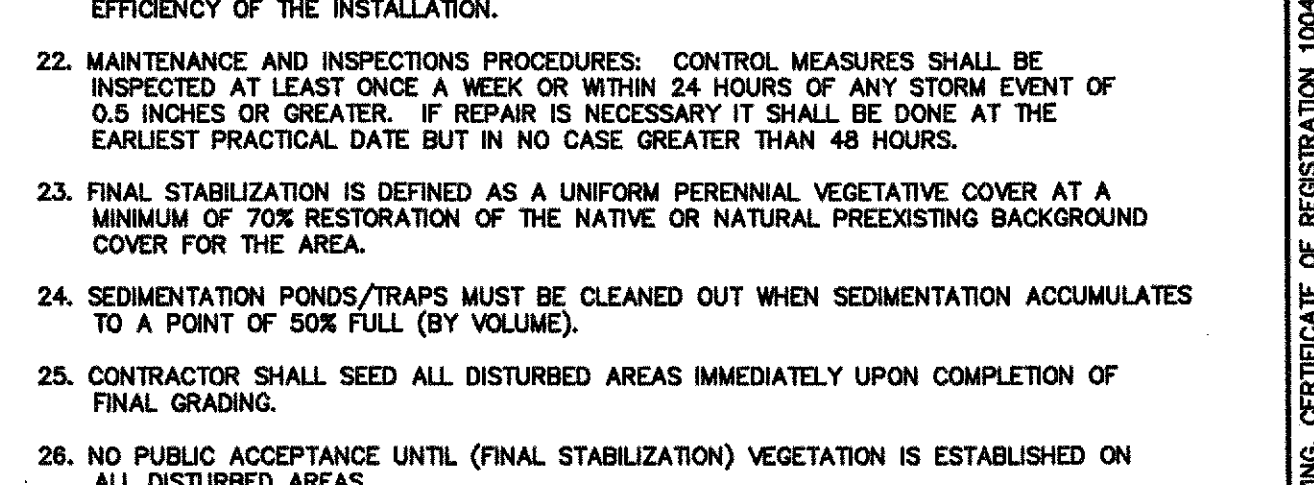


08 C4.02 EROSION CONTROL MATTING
NOT TO SCALE

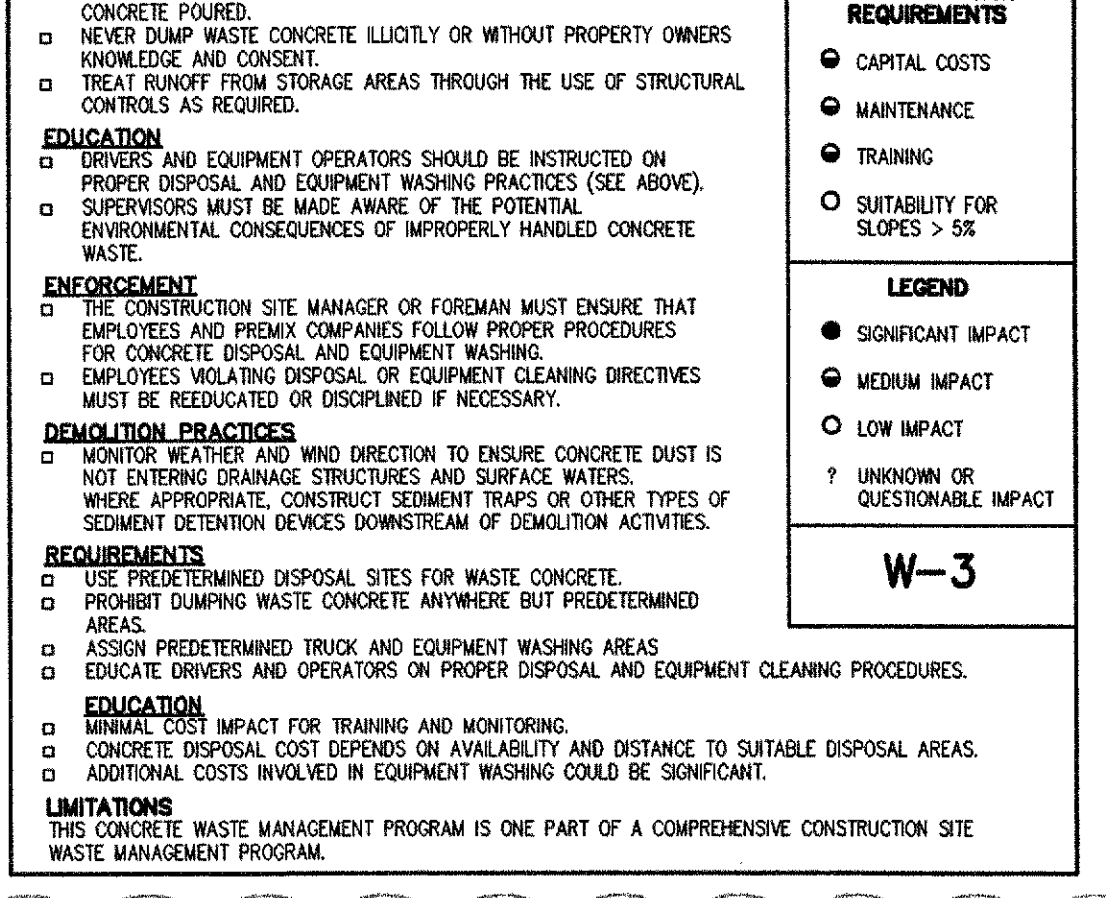


02 C4.02 CONSTRUCTION ENTRANCE
NOT TO SCALE

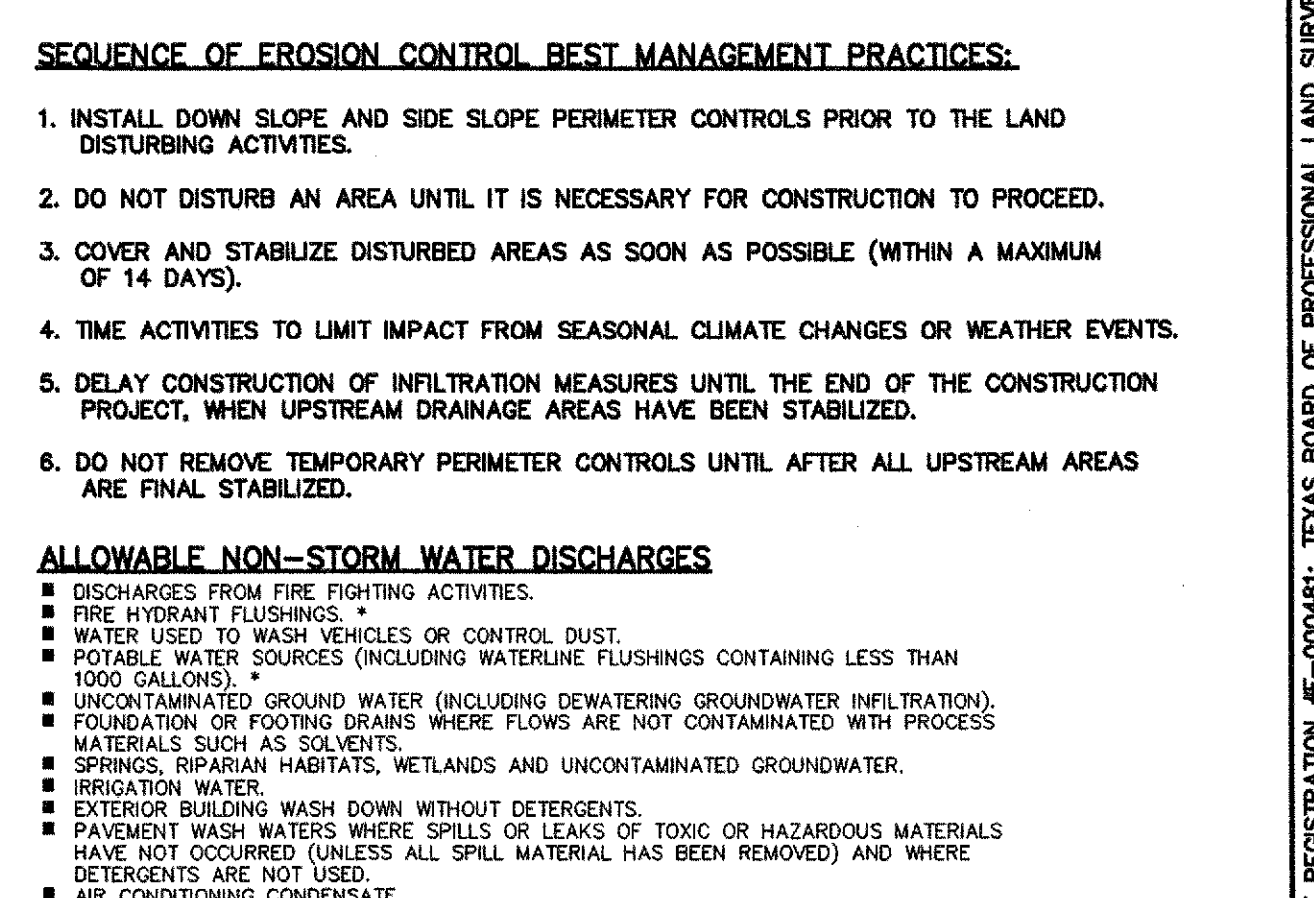


03 C4.02 ROCK CHECK DAM
NOT TO SCALE

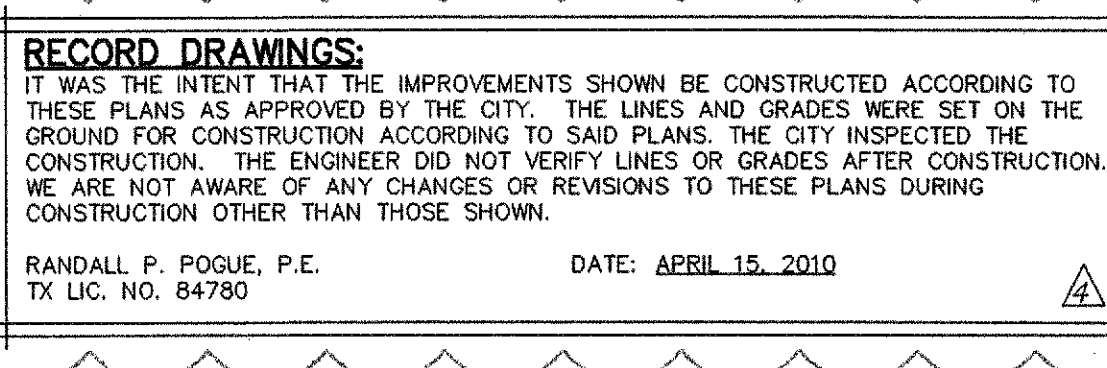


04 C4.02 PIPE INLET PROTECTION
NOT TO SCALE

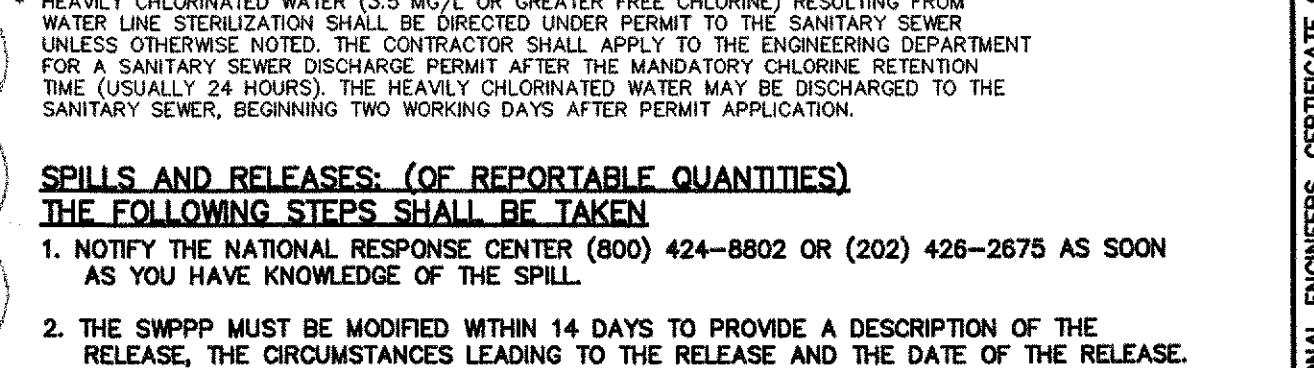


05 C4.02 CURB INLET PROTECTION
NOT TO SCALE

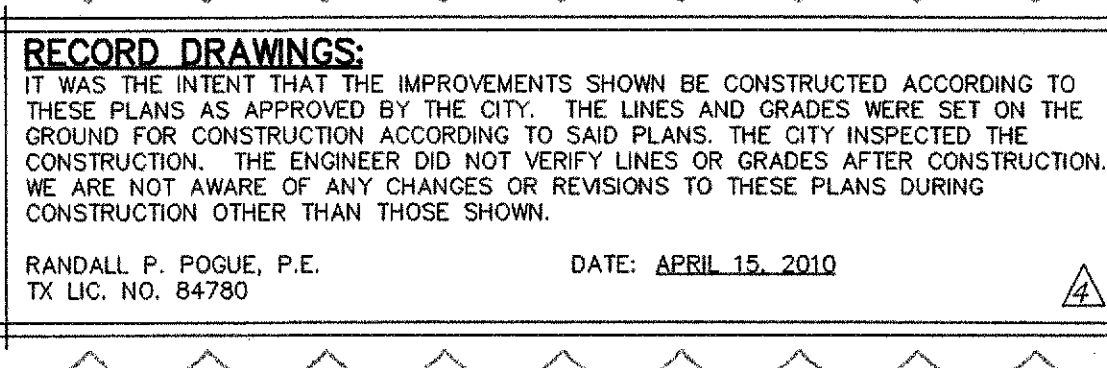


06 C4.02 DROP INLET PROTECTION
NOT TO SCALE

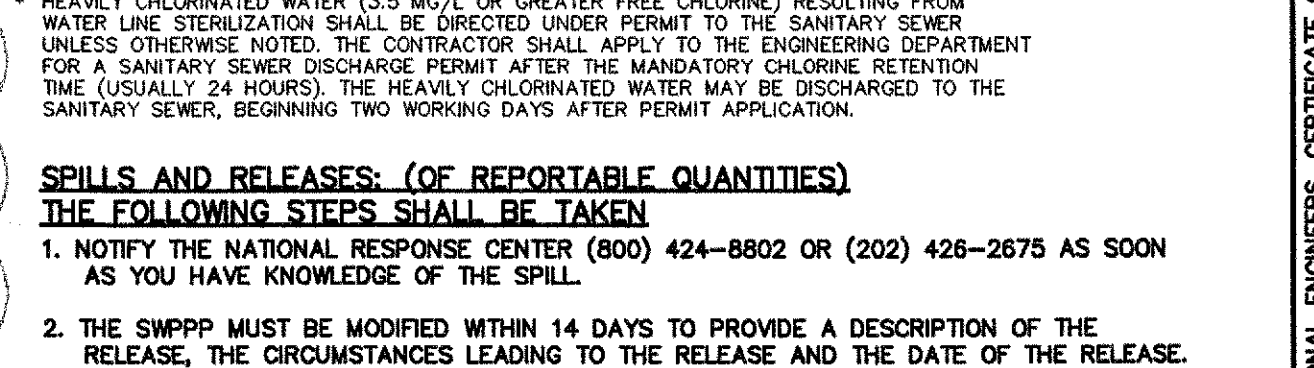


08 C4.02 EROSION CONTROL MATTING
NOT TO SCALE

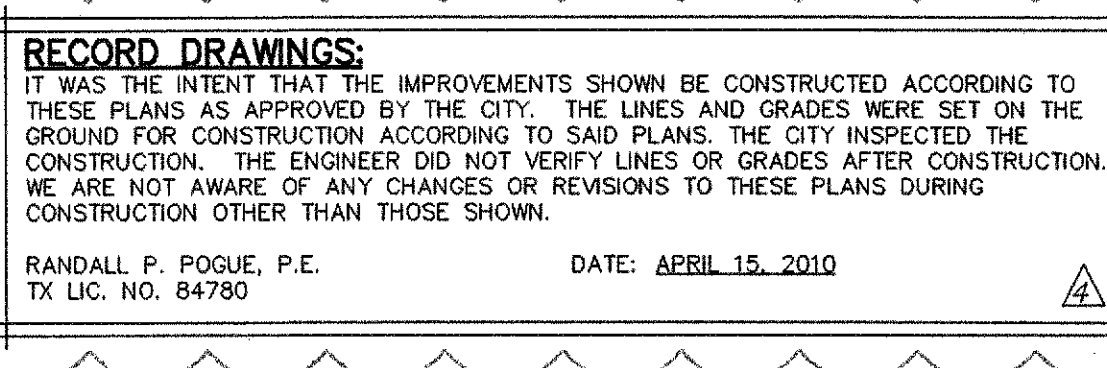


02 C4.02 CONSTRUCTION ENTRANCE
NOT TO SCALE

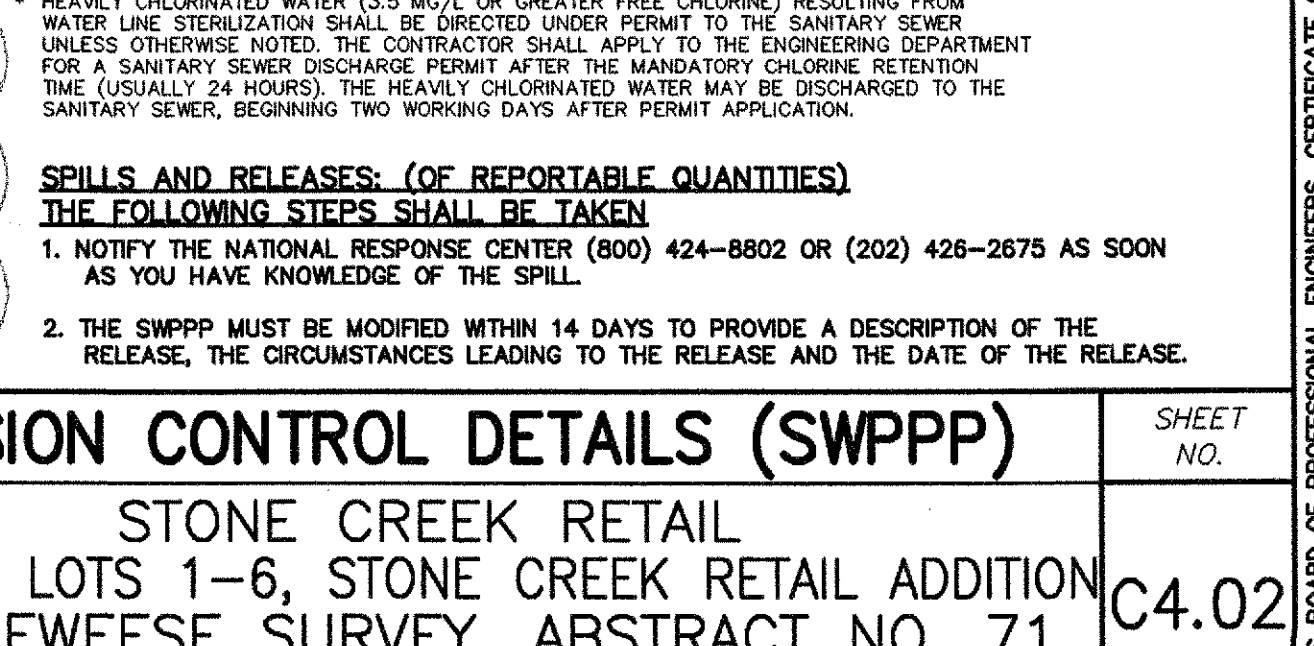


03 C4.02 ROCK CHECK DAM
NOT TO SCALE

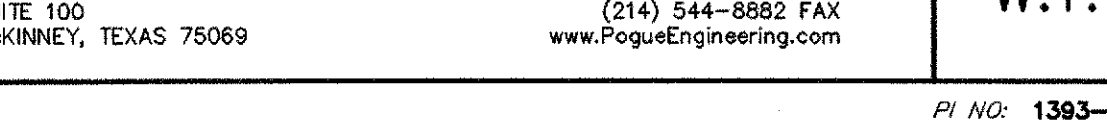


04 C4.02 PIPE INLET PROTECTION
NOT TO SCALE

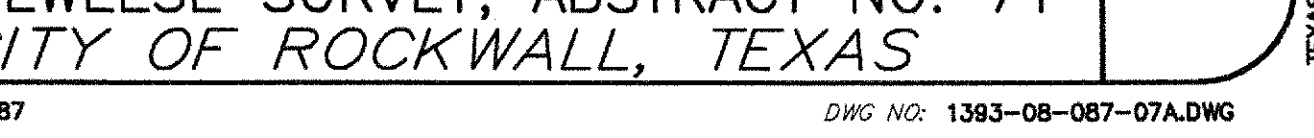


05 C4.02 CURB INLET PROTECTION
NOT TO SCALE

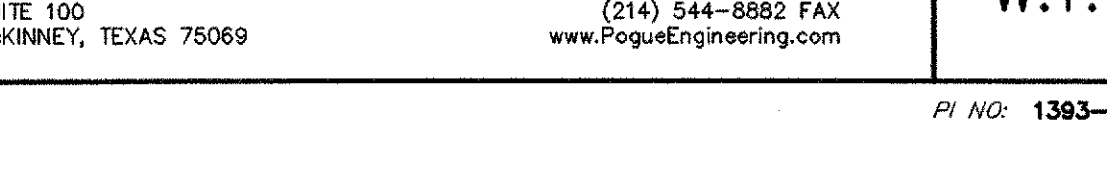


06 C4.02 DROP INLET PROTECTION
NOT TO SCALE

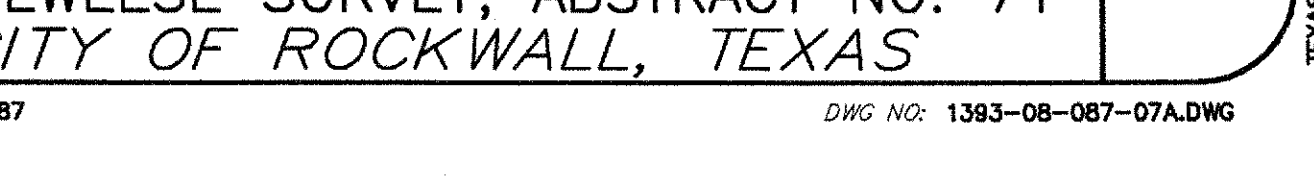


08 C4.02 EROSION CONTROL MATTING
NOT TO SCALE

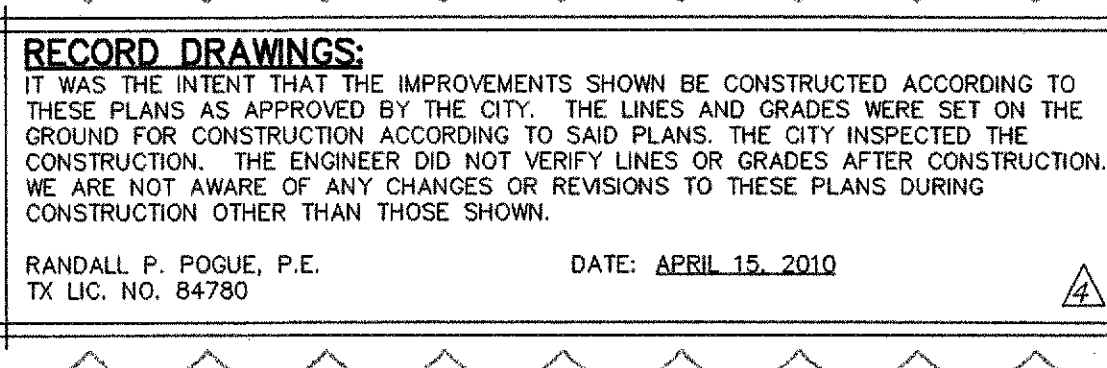


02 C4.02 CONSTRUCTION ENTRANCE
NOT TO SCALE

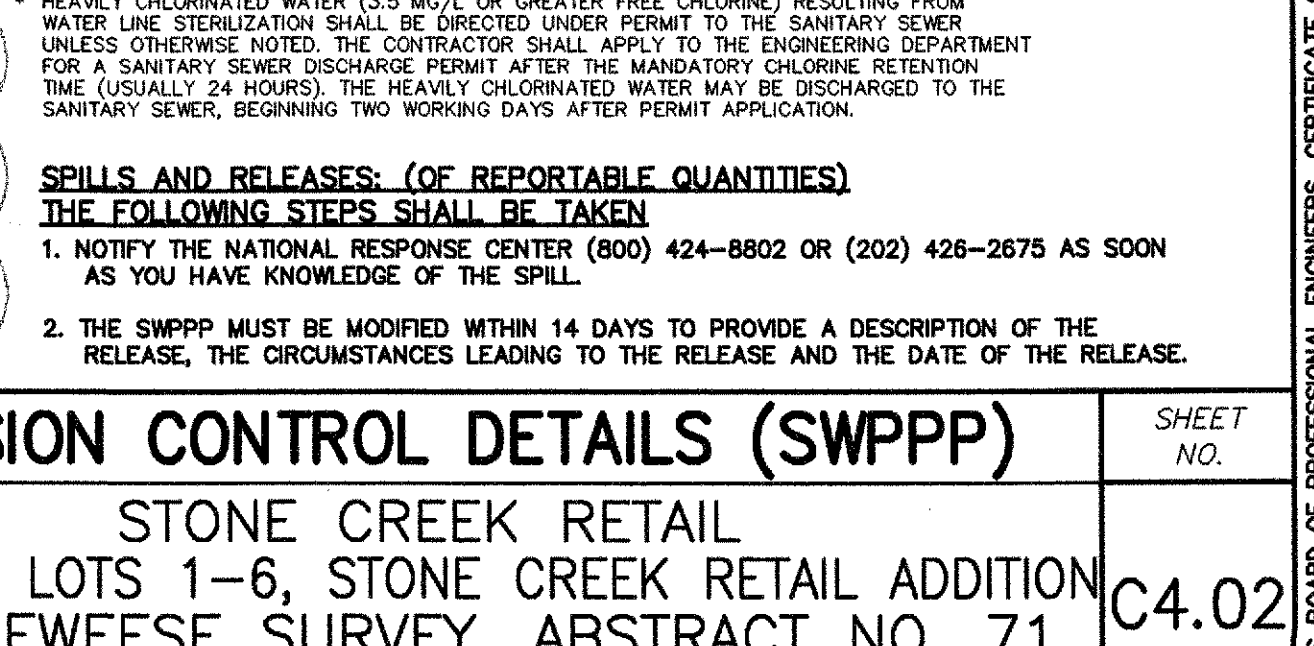

03 C4.02 ROCK CHECK DAM
NOT TO SCALE

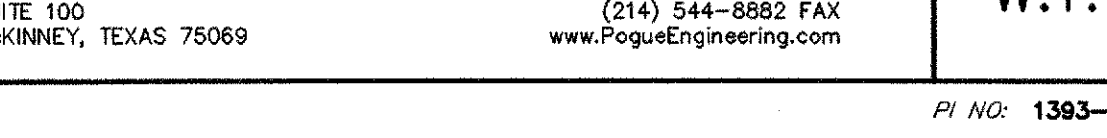

04 C4.02 PIPE INLET PROTECTION
NOT TO SCALE

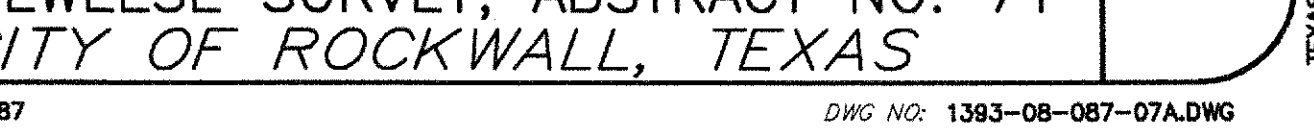

05 C4.02 CURB INLET PROTECTION
NOT TO SCALE

