


SCALE
1"=40' H
1"=5' V

NOTE:
ALL STORM PIPE
TO BE RCP

BENCHMARK LIST:
BENCHMARK #1
SQUARE CUT SET AT SOUTHWEST CORNER OF WATER
VAULT LOCATED AT THE SOUTHEAST CORNER OF
THE INTERSECTION OF THE EAST RIGHT-OF-WAY
LINE OF SH 205 AND THE SOUTH RIGHT-OF-WAY
LINE OF FM 552
ELEVATION = 543.09
BENCHMARK #2
CITY OF ROCKWALL MONUMENT (R010) FOUND.
ELEVATION = 524.788

RECORD DRAWINGS:
IT WAS THE INTENT THAT THE IMPROVEMENTS
SHOWN BE CONSTRUCTED ACCORDING TO THESE
PLANS AS APPROVED BY THE CITY. THE LINES
AND GRADES WERE SET ON THE GROUND FOR
CONSTRUCTION ACCORDING TO SAID PLANS. THE
CITY INSPECTED THE CONSTRUCTION. THE
ENGINEER DID NOT VERIFY LINES OR GRADES AFTER
CONSTRUCTION. WE ARE NOT AWARE OF ANY
CHANGES OR REVISIONS TO THESE PLANS DURING
CONSTRUCTION OTHER THAN THOSE SHOWN.
RANDALL P. POGUE, P.E. DATE: APRIL 15, 2010
TX LIC. NO. 84780

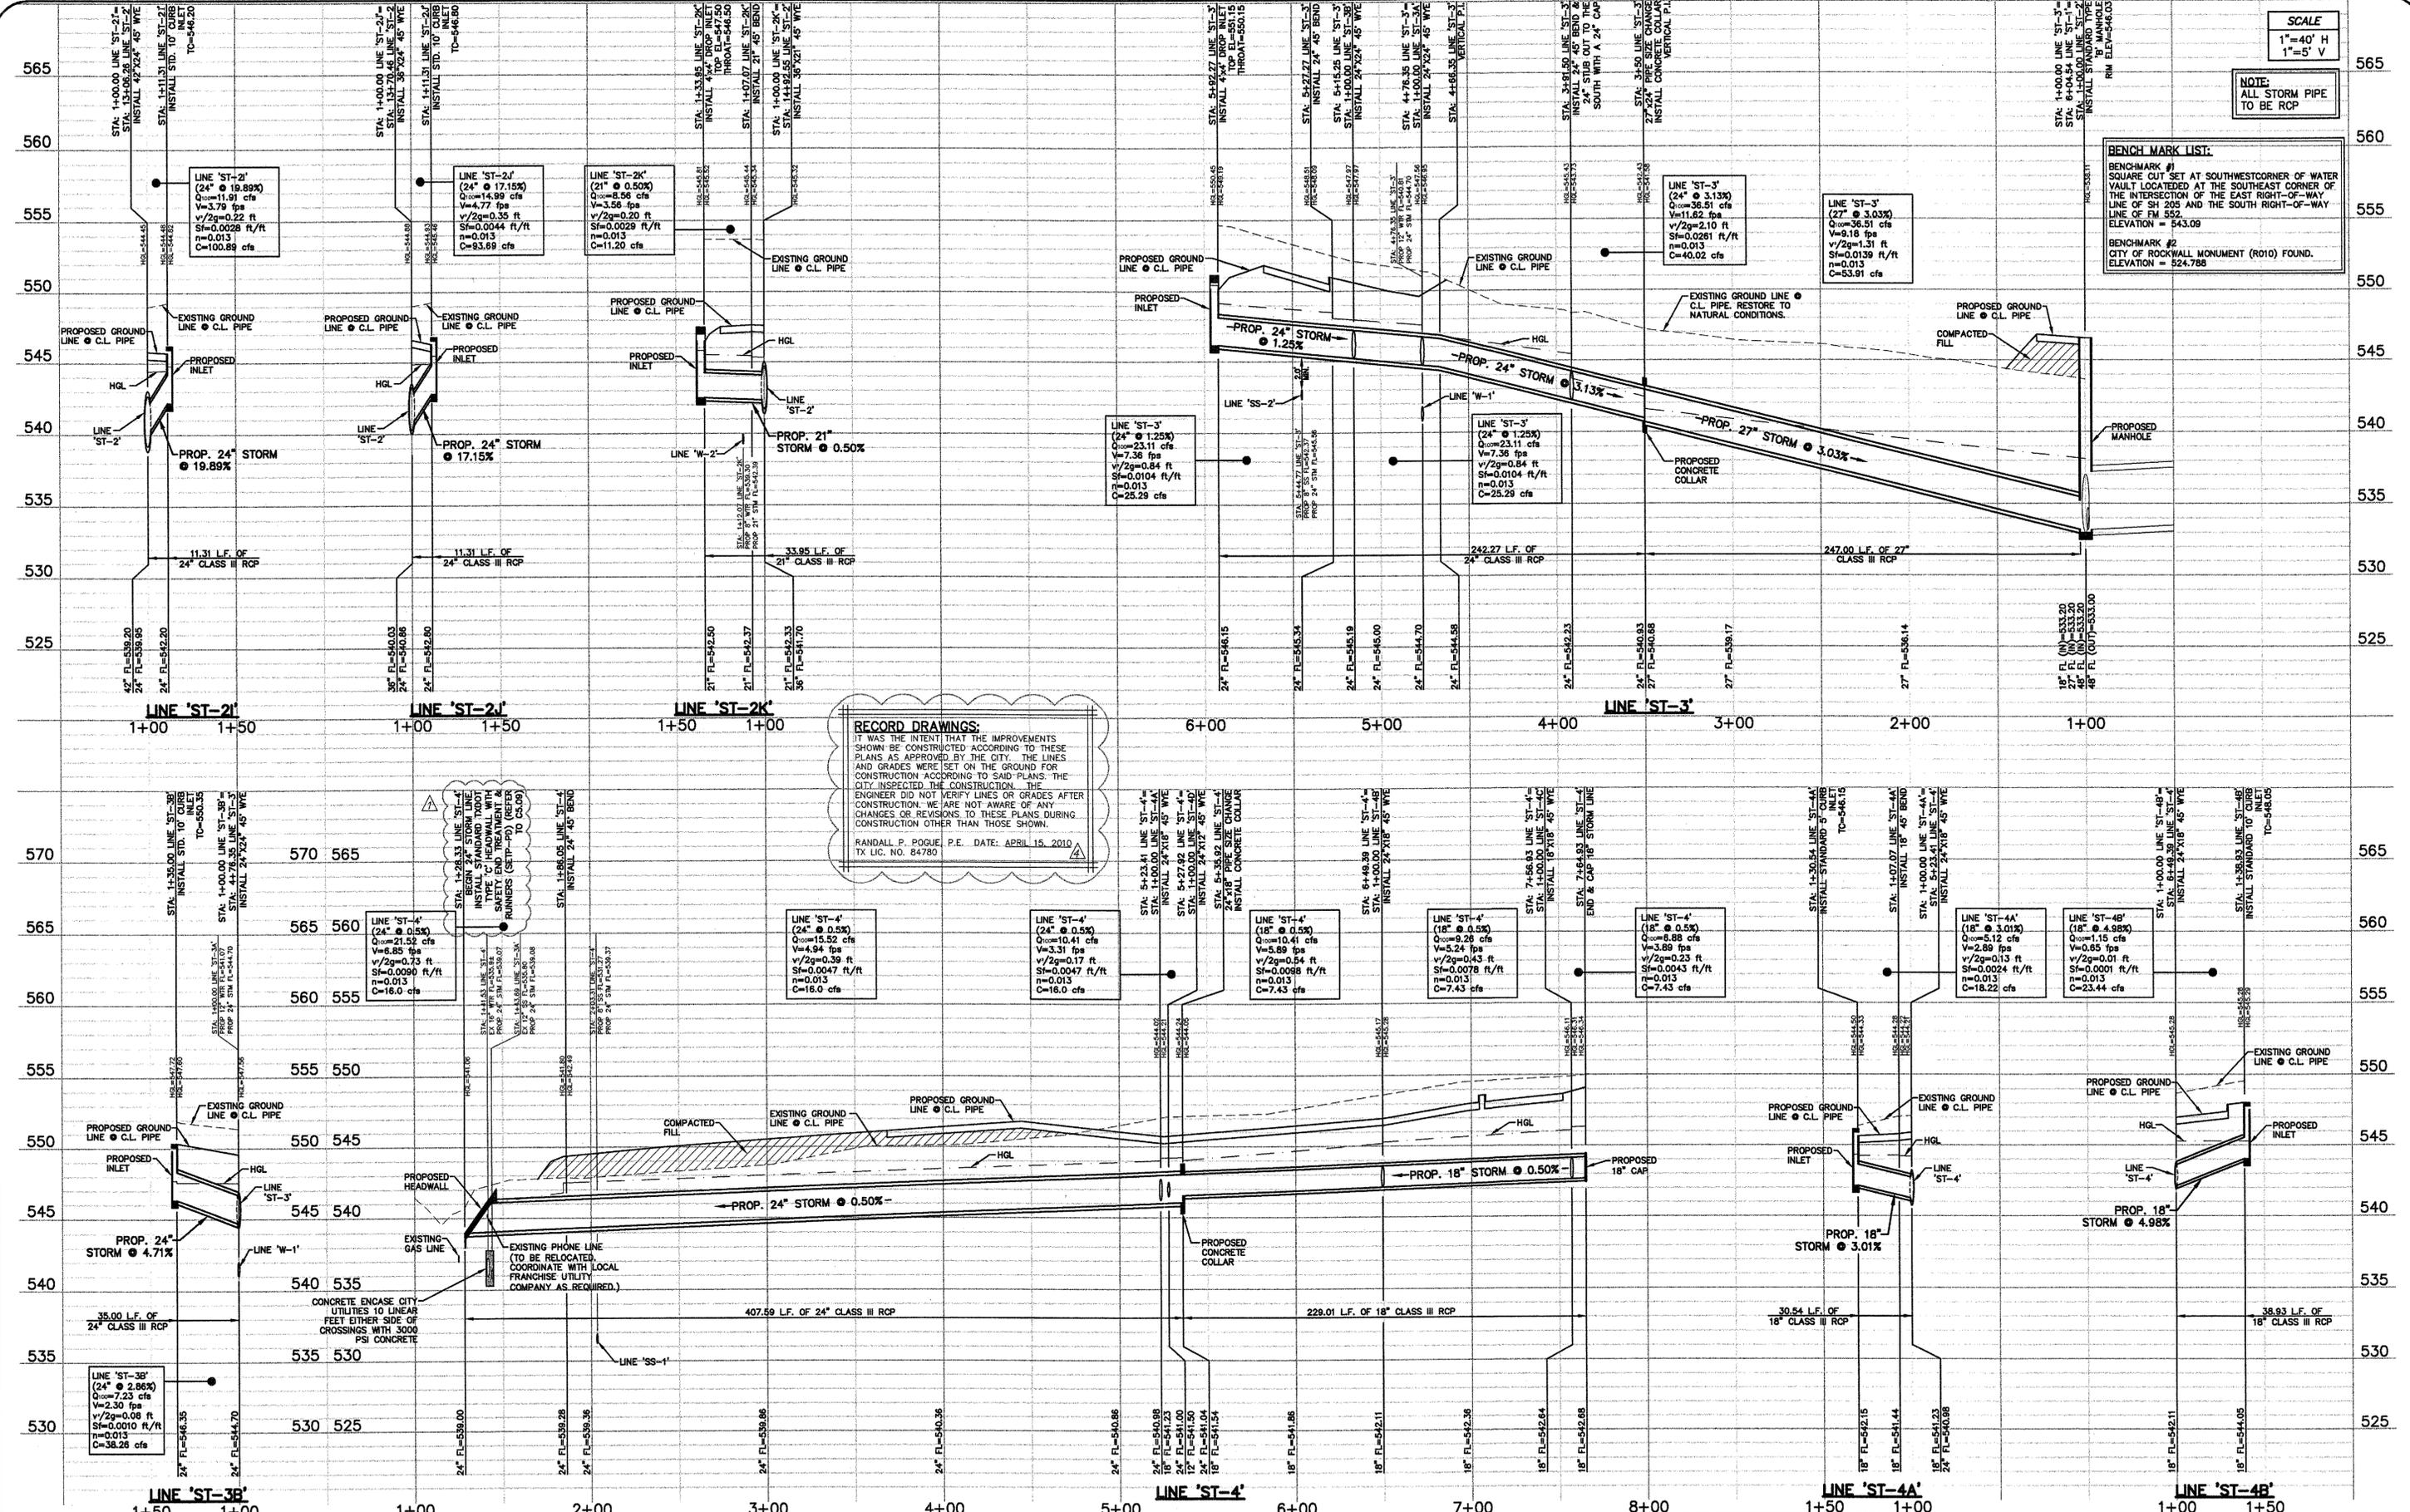

NO.	DATE	REVISION / DESCRIPTION
04-15-10		RECORD DRAWINGS
02-24-10		ADDED RIGHT TURN LANE ON S.H. 205
07-17-09		SANITARY SEWER & ADA ROUTE REVISIONS
06-19-09		TXDOT COMMENTS


DESIGN	DRAWN	DATE	SCALE	NOTES
BEC	WTW	05-21-09	AS SHOWN	-

OWNER
METROPLEX ACQUISITION FUND, LP
8214 WESTCHESTER, SUITE 850
DALLAS, TEXAS 75225
MR. GREY STOGNER
(214) 343-4477 PHONE
(214) 340-2029 FAX

DEVELOPER
CRESTVIEW REAL ESTATE, L.L.C.
8214 WESTCHESTER, SUITE 850
DALLAS, TEXAS 75225
MR. GREY STOGNER
(214) 343-4477 PHONE
(214) 340-2029 FAX

THE SEAL APPEARING ON THIS DOCUMENT WAS
AUTHORIZED BY BRANDON E. COX, P.E. 10/27/07 ON
05-21-09 ALTERATION OF A SEALED DOCUMENT
WITHOUT PROPER NOTIFICATION TO THE RESPONSIBLE
ENGINEER IS AN OFFENSE UNDER THE TEXAS
ENGINEERING PRACTICE ACT.

Brandon E. Cox 05-21-09

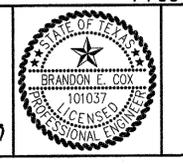

POGUE
ENGINEERING & DEVELOPMENT COMPANY, INC.
1512 BRAY CENTRAL DRIVE
SUITE 100
MCKINNEY, TEXAS 75069
(214) 544-8880 PHONE
(214) 544-8882 FAX
www.PogueEngineering.com

STORM SEWER PROFILES (3 of 4)
STONE CREEK RETAIL
BLOCK A, LOTS 1-6, STONE CREEK RETAIL ADDITION
W.T. DEWESE SURVEY, ABSTRACT NO. 71
CITY OF ROCKWALL, TEXAS

SHEET NO.
C5.06