


WILLIAMS 04/29/2010 - 4:07PM  
 N: W0851300-13991393-08-087-DWG\DWG\1393-08-087-07A.DWG  
 © POGUE ENGINEERING & DEVELOPMENT COMPANY, INC. 2009. ALL RIGHTS RESERVED. THE ENGINEERING DESIGN, DETAIL AND ENGINEERING DRAWINGS FOR THIS PROJECT AND/OR OVERALL PROJECT ARE THE LEGAL PROPERTY OF POGUE ENGINEERING & DEVELOPMENT COMPANY, INC. THEIR USE FOR REPRODUCTION, CONSTRUCTION, OR DISTRIBUTION IS PROHIBITED UNLESS AUTHORIZED IN WRITING BY POGUE ENGINEERING & DEVELOPMENT COMPANY, INC.

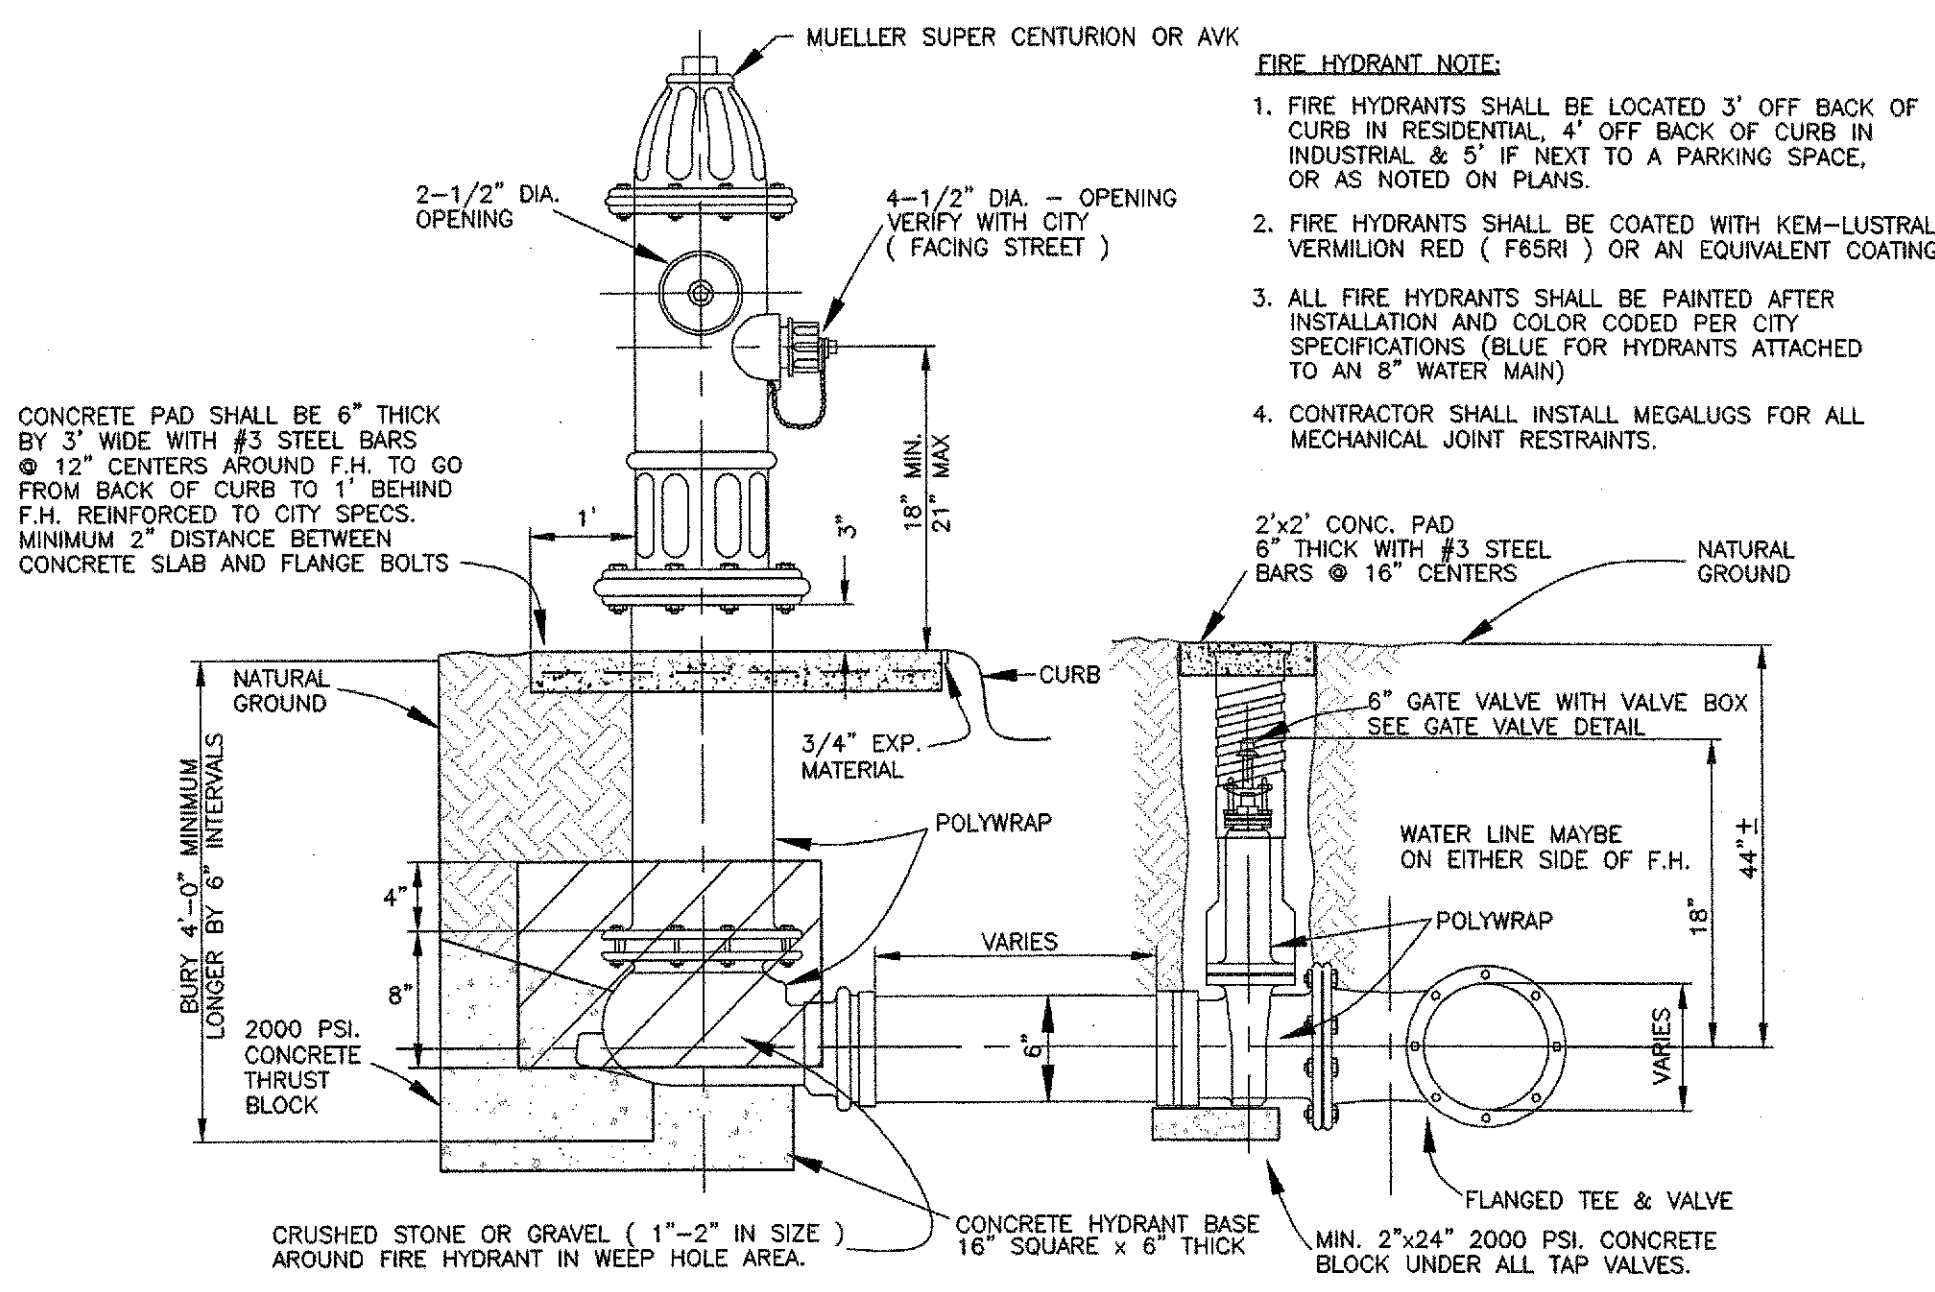

- FIRE HYDRANT NOTE:**
1. FIRE HYDRANTS SHALL BE LOCATED 3' OFF BACK OF CURB IN RESIDENTIAL, 4' OFF BACK OF CURB IN INDUSTRIAL & 5' IF NEXT TO A PARKING SPACE, OR AS NOTED ON PLANS.
  2. FIRE HYDRANTS SHALL BE COATED WITH KEM-LUSTRAL VERMILION RED ( FB5R1 ) OR AN EQUIVALENT COATING.
  3. ALL FIRE HYDRANTS SHALL BE PAINTED AFTER INSTALLATION AND COLOR CODED PER CITY SPECIFICATIONS (BLUE FOR HYDRANTS ATTACHED TO AN 8" WATER MAIN)
  4. CONTRACTOR SHALL INSTALL MEGALUGS FOR ALL MECHANICAL JOINT RESTRAINTS.

01  
C6.03

**STANDARD FIRE HYDRANT DETAIL**

NOT TO SCALE

**NOTE:**  
 FOR ALL OTHER WATER & SANITARY SEWER DETAILS, USE CITY OF ROCKWALL AND NCTCOG 3RD EDITION DETAILS.

**RECORD DRAWINGS:**  
 IT WAS THE INTENT THAT THE IMPROVEMENTS SHOWN BE CONSTRUCTED ACCORDING TO THESE PLANS AS APPROVED BY THE CITY. THE LINES AND GRADES WERE SET ON THE GROUND FOR CONSTRUCTION ACCORDING TO SAID PLANS. THE CITY INSPECTED THE CONSTRUCTION. THE ENGINEER DID NOT VERIFY LINES OR GRADES AFTER CONSTRUCTION. WE ARE NOT AWARE OF ANY CHANGES OR REVISIONS TO THESE PLANS DURING CONSTRUCTION OTHER THAN THOSE SHOWN.

RANDALL P. POGUE, P.E. DATE: APRIL 15, 2010  
 TX LIC. NO. 84780


DESIGN NO.	DATE	REVISION / DESCRIPTION	NOTES	
04-15-10		RECORD DRAWINGS		
02-24-10		ADDED RIGHT TURN LANE ON S.H. 205		
07-17-09		SANITARY SEWER & ADA ROUTE REVISIONS		
06-19-09		TXDOT COMMENTS		
DESIGN	DRAWN	DATE	SCALE	NOTES
BEC	WTW	05-21-09	AS SHOWN	

**OWNER**  
 METROPLEX ACQUISITION FUND, LP  
 8214 WESTCHESTER, SUITE 850  
 DALLAS, TEXAS 75225  
 MR. GREY STOGNER  
 (214) 343-4477 PHONE  
 (214) 340-2029 FAX

**DEVELOPER**  
 CRESTVIEW REAL ESTATE, L.L.C.  
 8214 WESTCHESTER, SUITE 850  
 DALLAS, TEXAS 75225  
 MR. GREY STOGNER  
 (214) 343-4477 PHONE  
 (214) 340-2029 FAX

THE SEAL APPEARING ON THIS DOCUMENT WAS AUTHORIZED BY BRANDON E. COX, P.E. 101037 ON 05-21-09. ALTERATION OF A SEALED DOCUMENT WITHOUT PROPER NOTIFICATION TO THE RESPONSIBLE ENGINEER IS AN OFFENSE UNDER THE TEXAS ENGINEERING PRACTICE ACT.

*Brandon E. Cox* 05-21-09

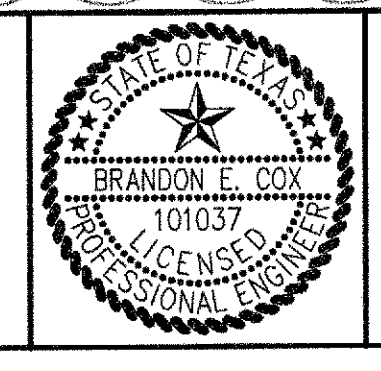

**POGUE**  
 ENGINEERING & DEVELOPMENT COMPANY, INC.

1512 BRAY CENTRAL DRIVE  
 SUITE 100  
 MCKINNEY, TEXAS 75069

(214) 544-8880 PHONE  
 (214) 544-8882 FAX  
 www.PogueEngineering.com

**WATER & SANITARY SEWER DETAILS**

STONE CREEK RETAIL  
 BLOCK A, LOTS 1-6, STONE CREEK RETAIL ADDITION  
 W.T. DEWEESE SURVEY, ABSTRACT NO. 71  
 CITY OF ROCKWALL, TEXAS

SHEET NO.  
**C6.05**

STONE CREEK RETAIL - ROCKWALL  
 TEXAS BOARD OF PROFESSIONAL ENGINEERS, CERTIFICATE OF REGISTRATION # 00481; TEXAS BOARD OF PROFESSIONAL LAND SURVEYING, CERTIFICATE OF REGISTRATION 100421-00