



AS BUILT PLANS

NOTE: THE INTENT OF THE OWNER AND ENGINEER WAS TO CONSTRUCT THE IMPROVEMENTS ACCORDING TO THESE PLANS AS APPROVED BY THE CITY OF ROCKWALL. THE GRADES WERE SET ON THE GROUND FOR CONSTRUCTION ACCORDING TO SAID PLANS. THE CITY OF ROCKWALL INSPECTED THE CONSTRUCTION. WE ARE NOT AWARE OF ANY CHANGES OR REVISIONS TO THESE PLANS DURING CONSTRUCTION, EXCEPT AS SHOWN.

JULY 10, 1981

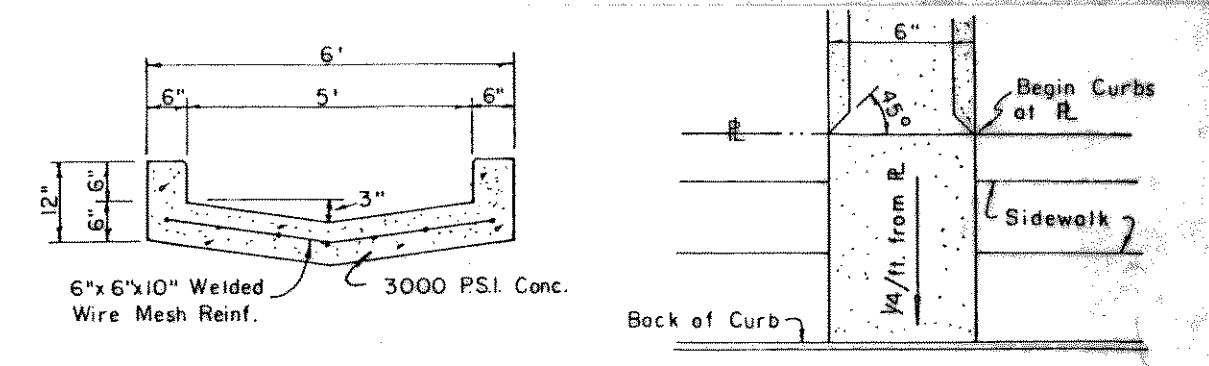

CONCRETE FLUME DETAIL

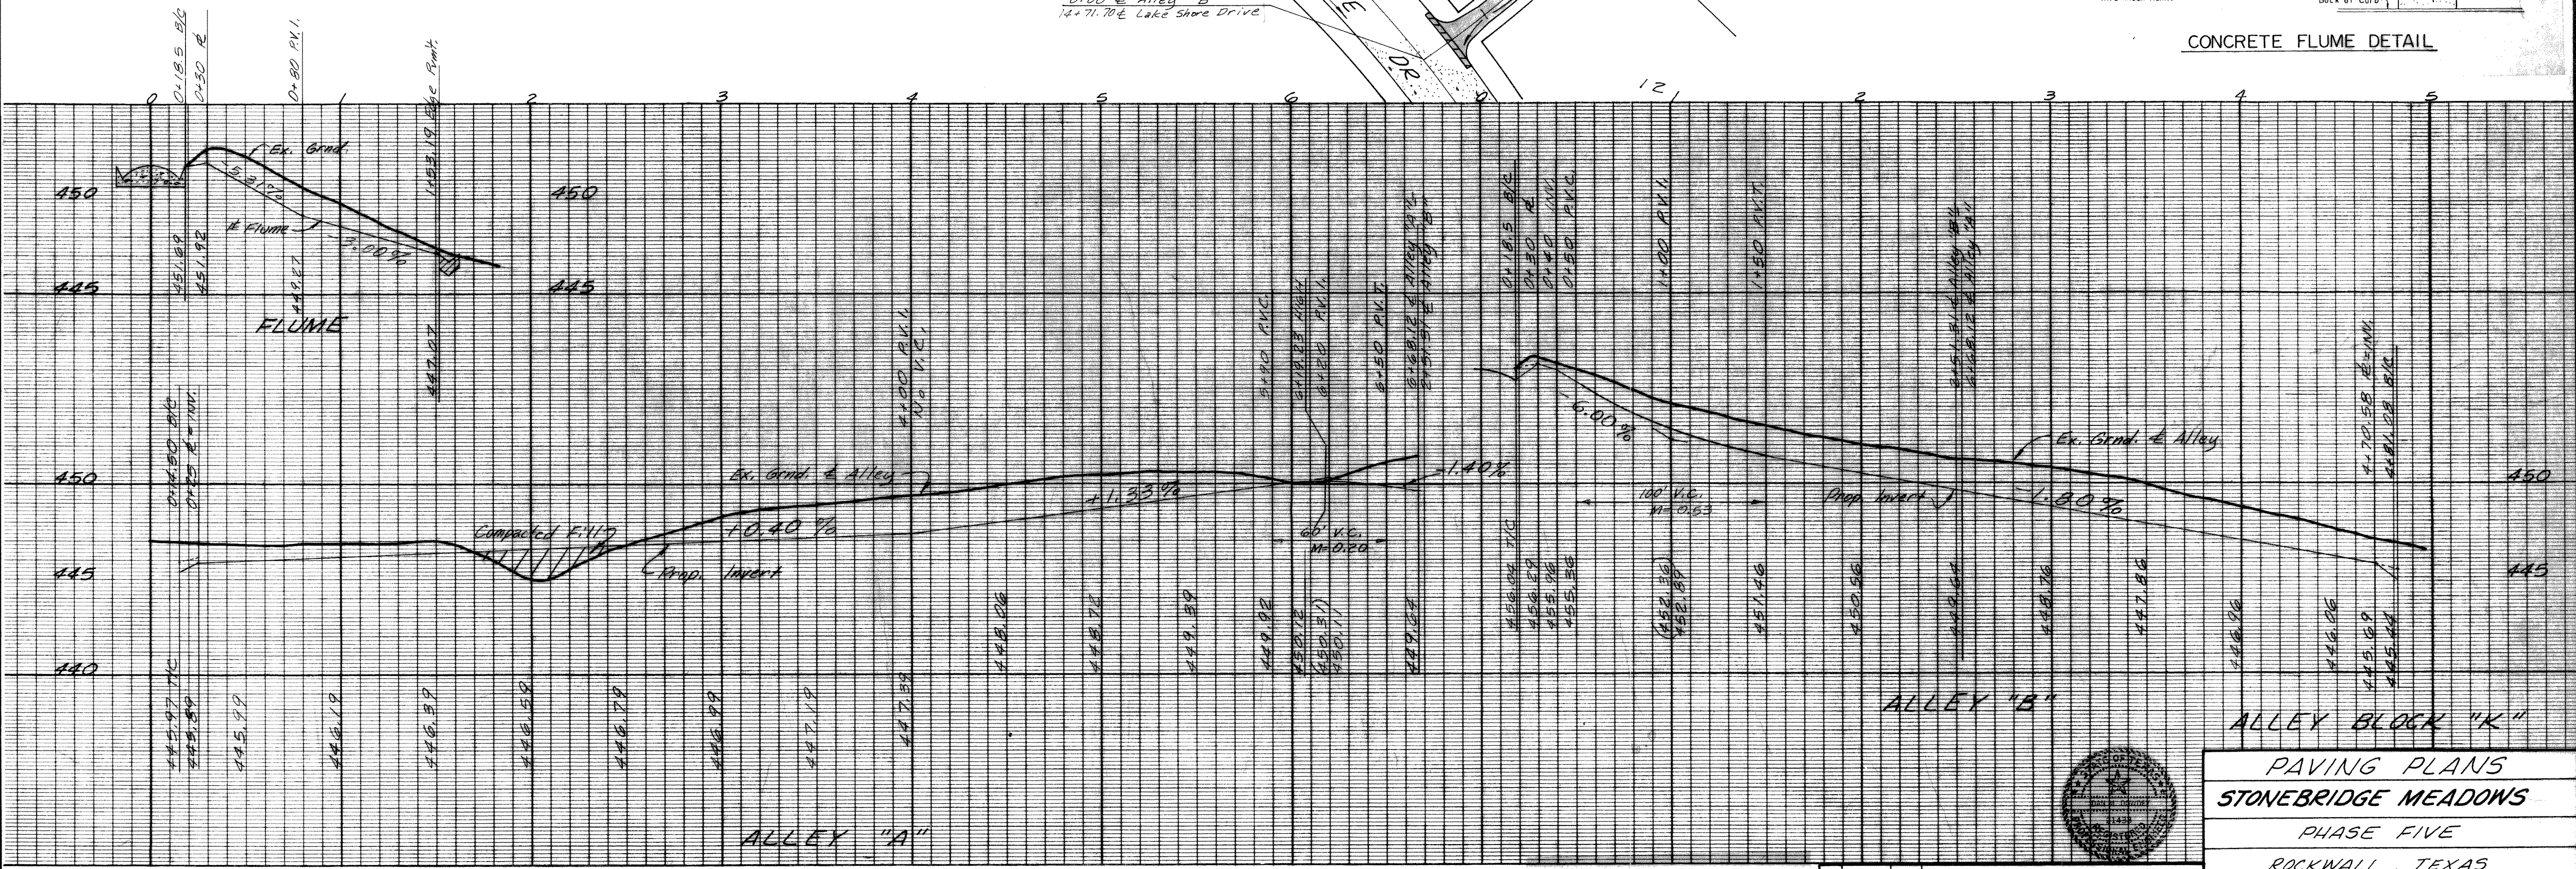

BENCH MARK:
TOP OF SOUTH FLANGE BOLT
OF FIRE HYDRANT ON EAST
SIDE OF LAKE SHORE DRIVE,
200' NORTH OF THE NORTH
PROPERTY LINE OF STONE-
BRIDGE MEADOWS I.
ELEV. 454.36

NO.	DATE	BY	REVISION
1	10-17-80	RE	Lowered Flume

THREADGILL - DOWDEY and ASSOCIATES
 CONSULTING ENGINEERS DALLAS, TEXAS
 DESIGN DRAWN CHECKED DATE SCALE JOB SHEET
 J.G.B. R.E. D.M.D. 9-80 1/2"=1'-0" 507-E 5/10