


OFF-SITE DRAINAGE AREAS
SCALE: 1" = 400'

AREA	ACRES	C	I ₅	Q ₅
A.	5.9	0.5	6.6	19.5
B.	0.8	0.5	6.6	2.6
C.	5.4	0.5	6.6	17.8
D.	2.8	0.5	6.6	9.2
E.	4.0	0.5	6.6	13.2
F.	0.8	0.5	6.6	2.6
G.	16.9	0.5	6.6	55.8
H.	7.0	0.5	6.6	23.1
I.	2.5	0.5	6.6	8.3
J.	1.8	0.5	6.6	5.9
K.	4.3	0.5	6.6	14.2

ON-SITE DRAINAGE AREAS

SCALE: 1" = 100'

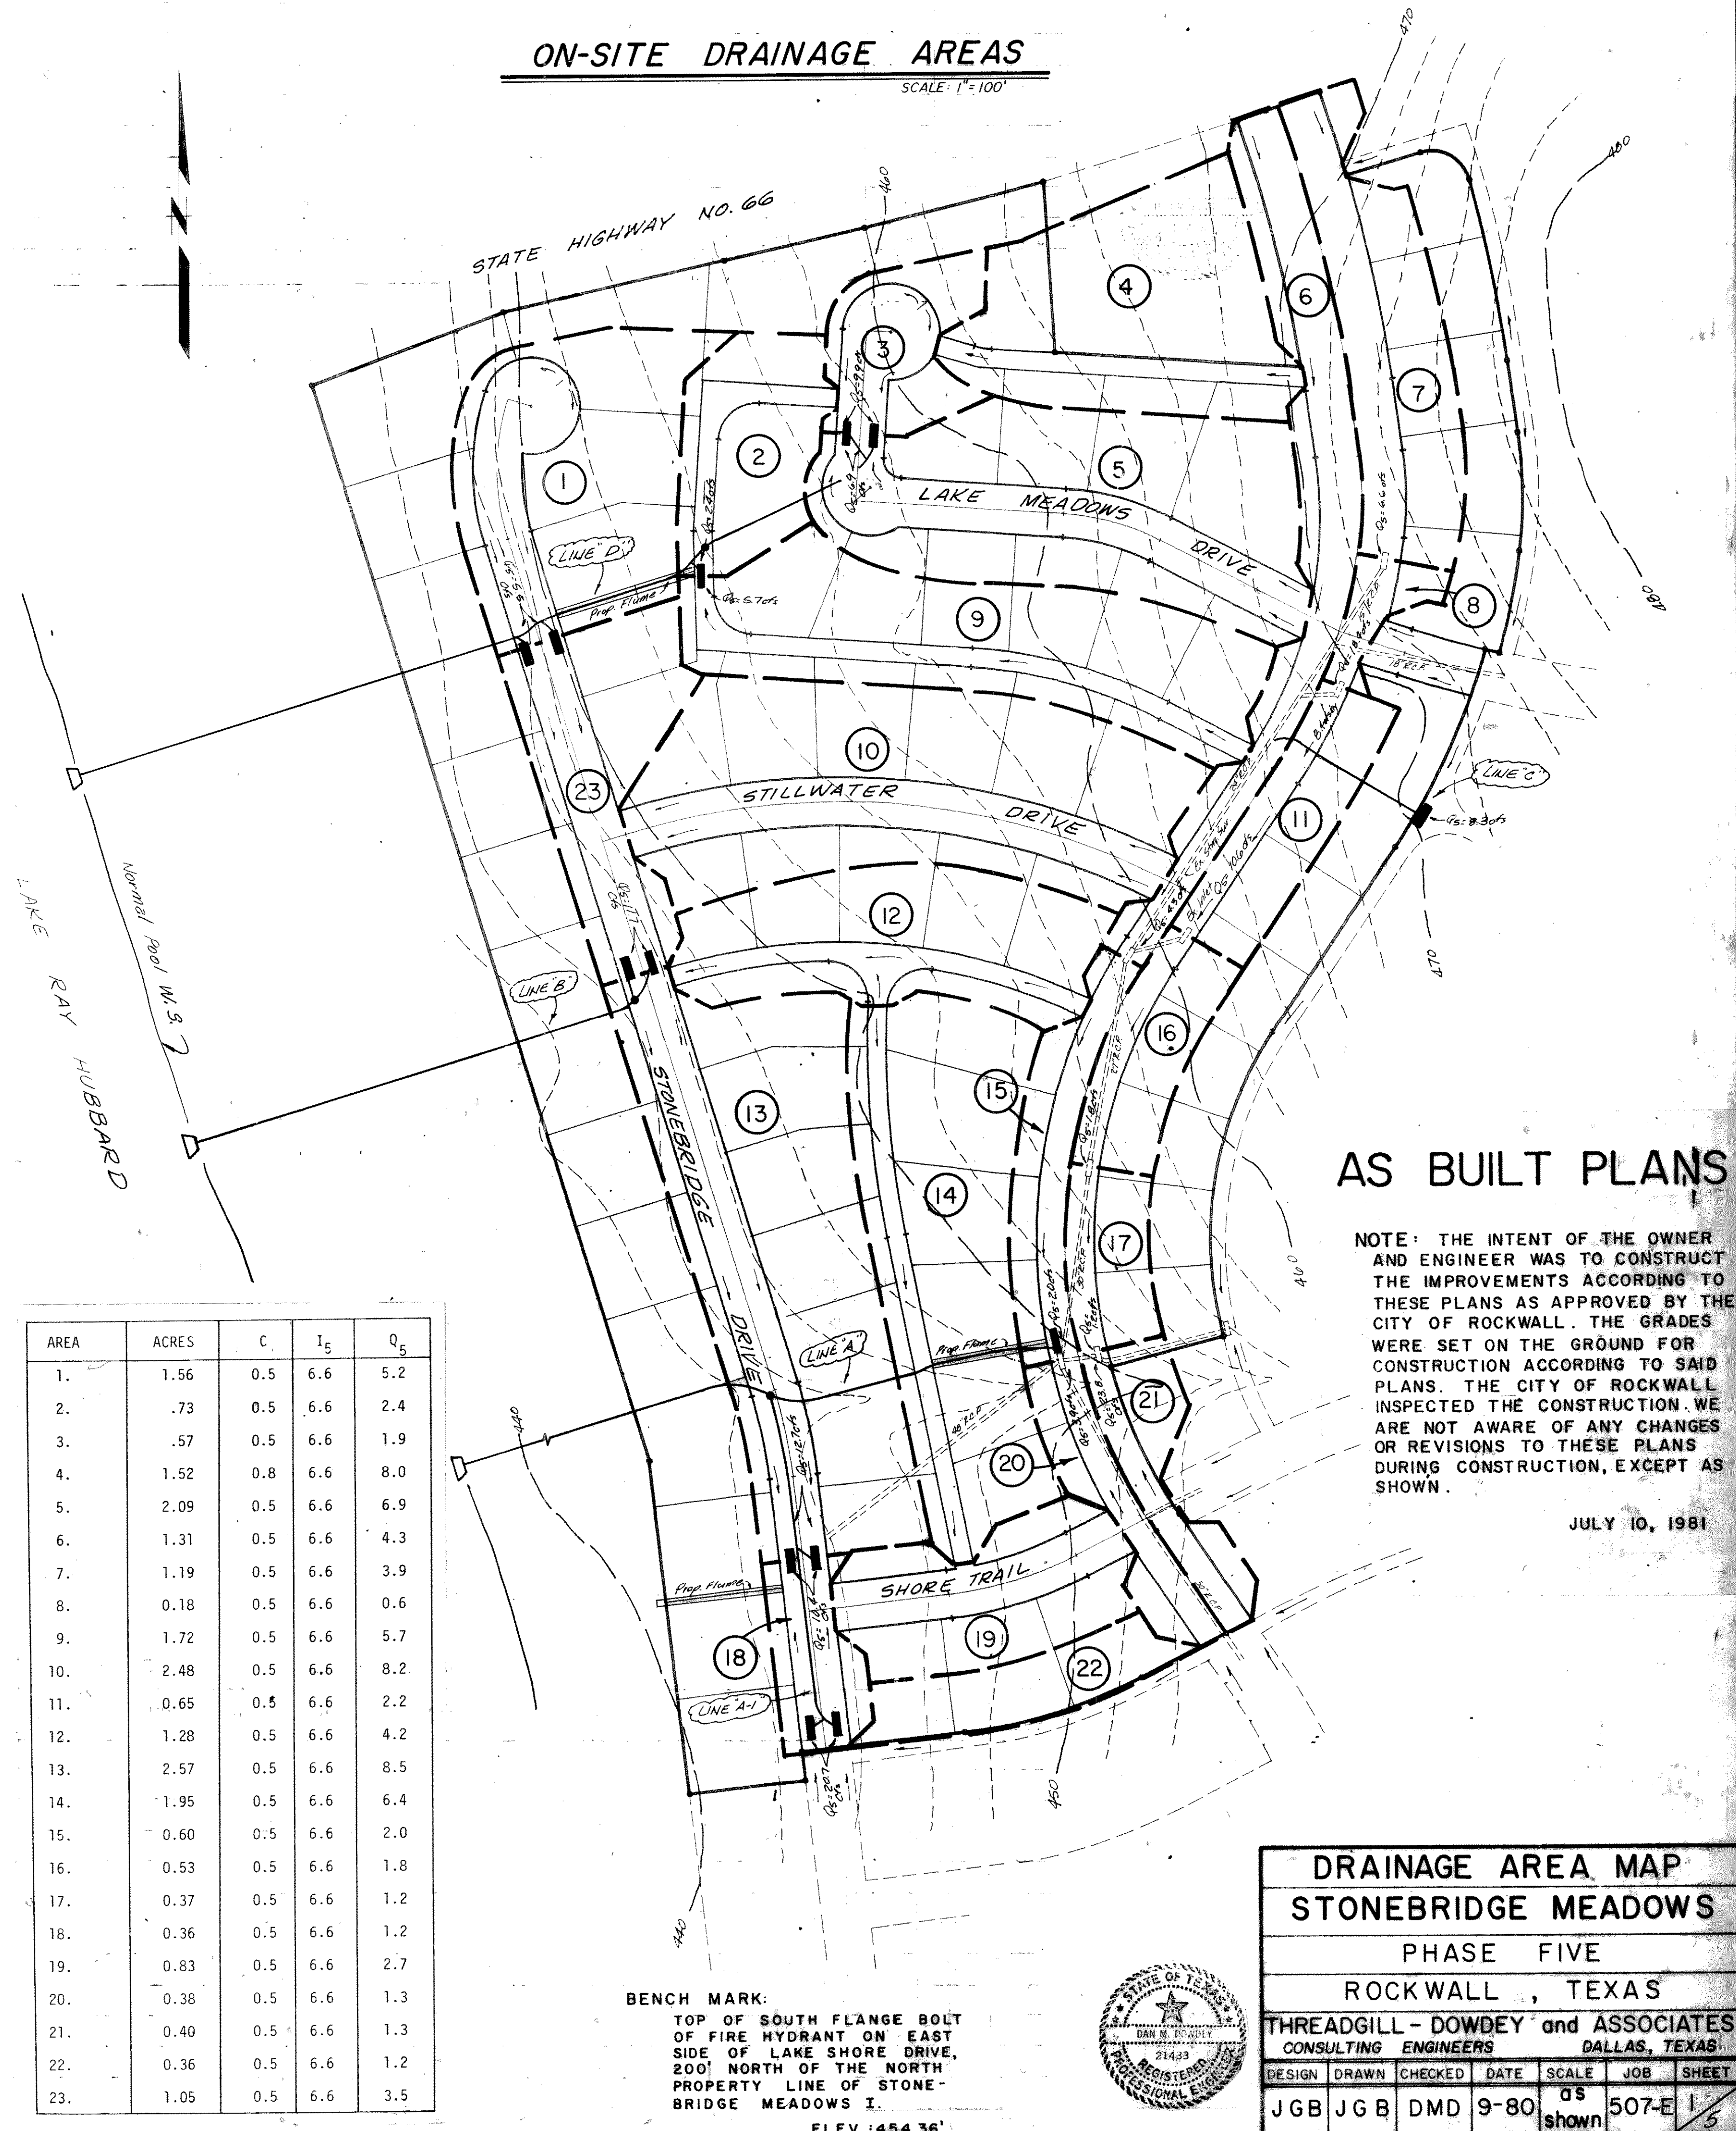


AS BUILT PLANS

NOTE: THE INTENT OF THE OWNER AND ENGINEER WAS TO CONSTRUCT THE IMPROVEMENTS ACCORDING TO THESE PLANS AS APPROVED BY THE CITY OF ROCKWALL. THE GRADES WERE SET ON THE GROUND FOR CONSTRUCTION ACCORDING TO SAID PLANS. THE CITY OF ROCKWALL INSPECTED THE CONSTRUCTION. WE ARE NOT AWARE OF ANY CHANGES OR REVISIONS TO THESE PLANS DURING CONSTRUCTION, EXCEPT AS SHOWN.

JULY 10, 1981

AREA	ACRES	C	I ₅	Q ₅
1.	1.56	0.5	6.6	5.2
2.	.73	0.5	6.6	2.4
3.	.57	0.5	6.6	1.9
4.	1.52	0.8	6.6	8.0
5.	2.09	0.5	6.6	6.9
6.	1.31	0.5	6.6	4.3
7.	1.19	0.5	6.6	3.9
8.	0.18	0.5	6.6	0.6
9.	1.72	0.5	6.6	5.7
10.	2.48	0.5	6.6	8.2
11.	0.65	0.5	6.6	2.2
12.	1.28	0.5	6.6	4.2
13.	2.57	0.5	6.6	8.5
14.	1.95	0.5	6.6	6.4
15.	0.60	0.5	6.6	2.0
16.	0.53	0.5	6.6	1.8
17.	0.37	0.5	6.6	1.2
18.	0.36	0.5	6.6	1.2
19.	0.83	0.5	6.6	2.7
20.	0.38	0.5	6.6	1.3
21.	0.40	0.5	6.6	1.3
22.	0.36	0.5	6.6	1.2
23.	1.05	0.5	6.6	3.5

BENCH MARK:
TOP OF SOUTH FLANGE BOLT OF FIRE HYDRANT ON EAST SIDE OF LAKE SHORE DRIVE, 200' NORTH OF THE NORTH PROPERTY LINE OF STONEBRIDGE MEADOWS I.
ELEV.: 454.36'

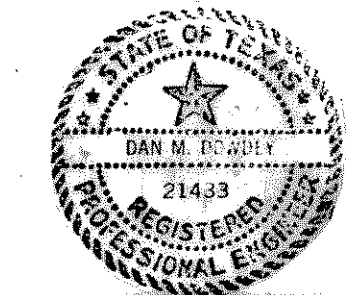

DRAINAGE AREA MAP							
STONEBRIDGE MEADOWS							
PHASE FIVE							
ROCKWALL, TEXAS							
THREADGILL - DOWDEY and ASSOCIATES							
CONSULTING ENGINEERS DALLAS, TEXAS							
DESIGN	DRAWN	CHECKED	DATE	SCALE	JOB	SHEET	
JGB	JGB	DMD	9-80	as shown	507-E	1/5	