



LAKE RAY HUBBARD

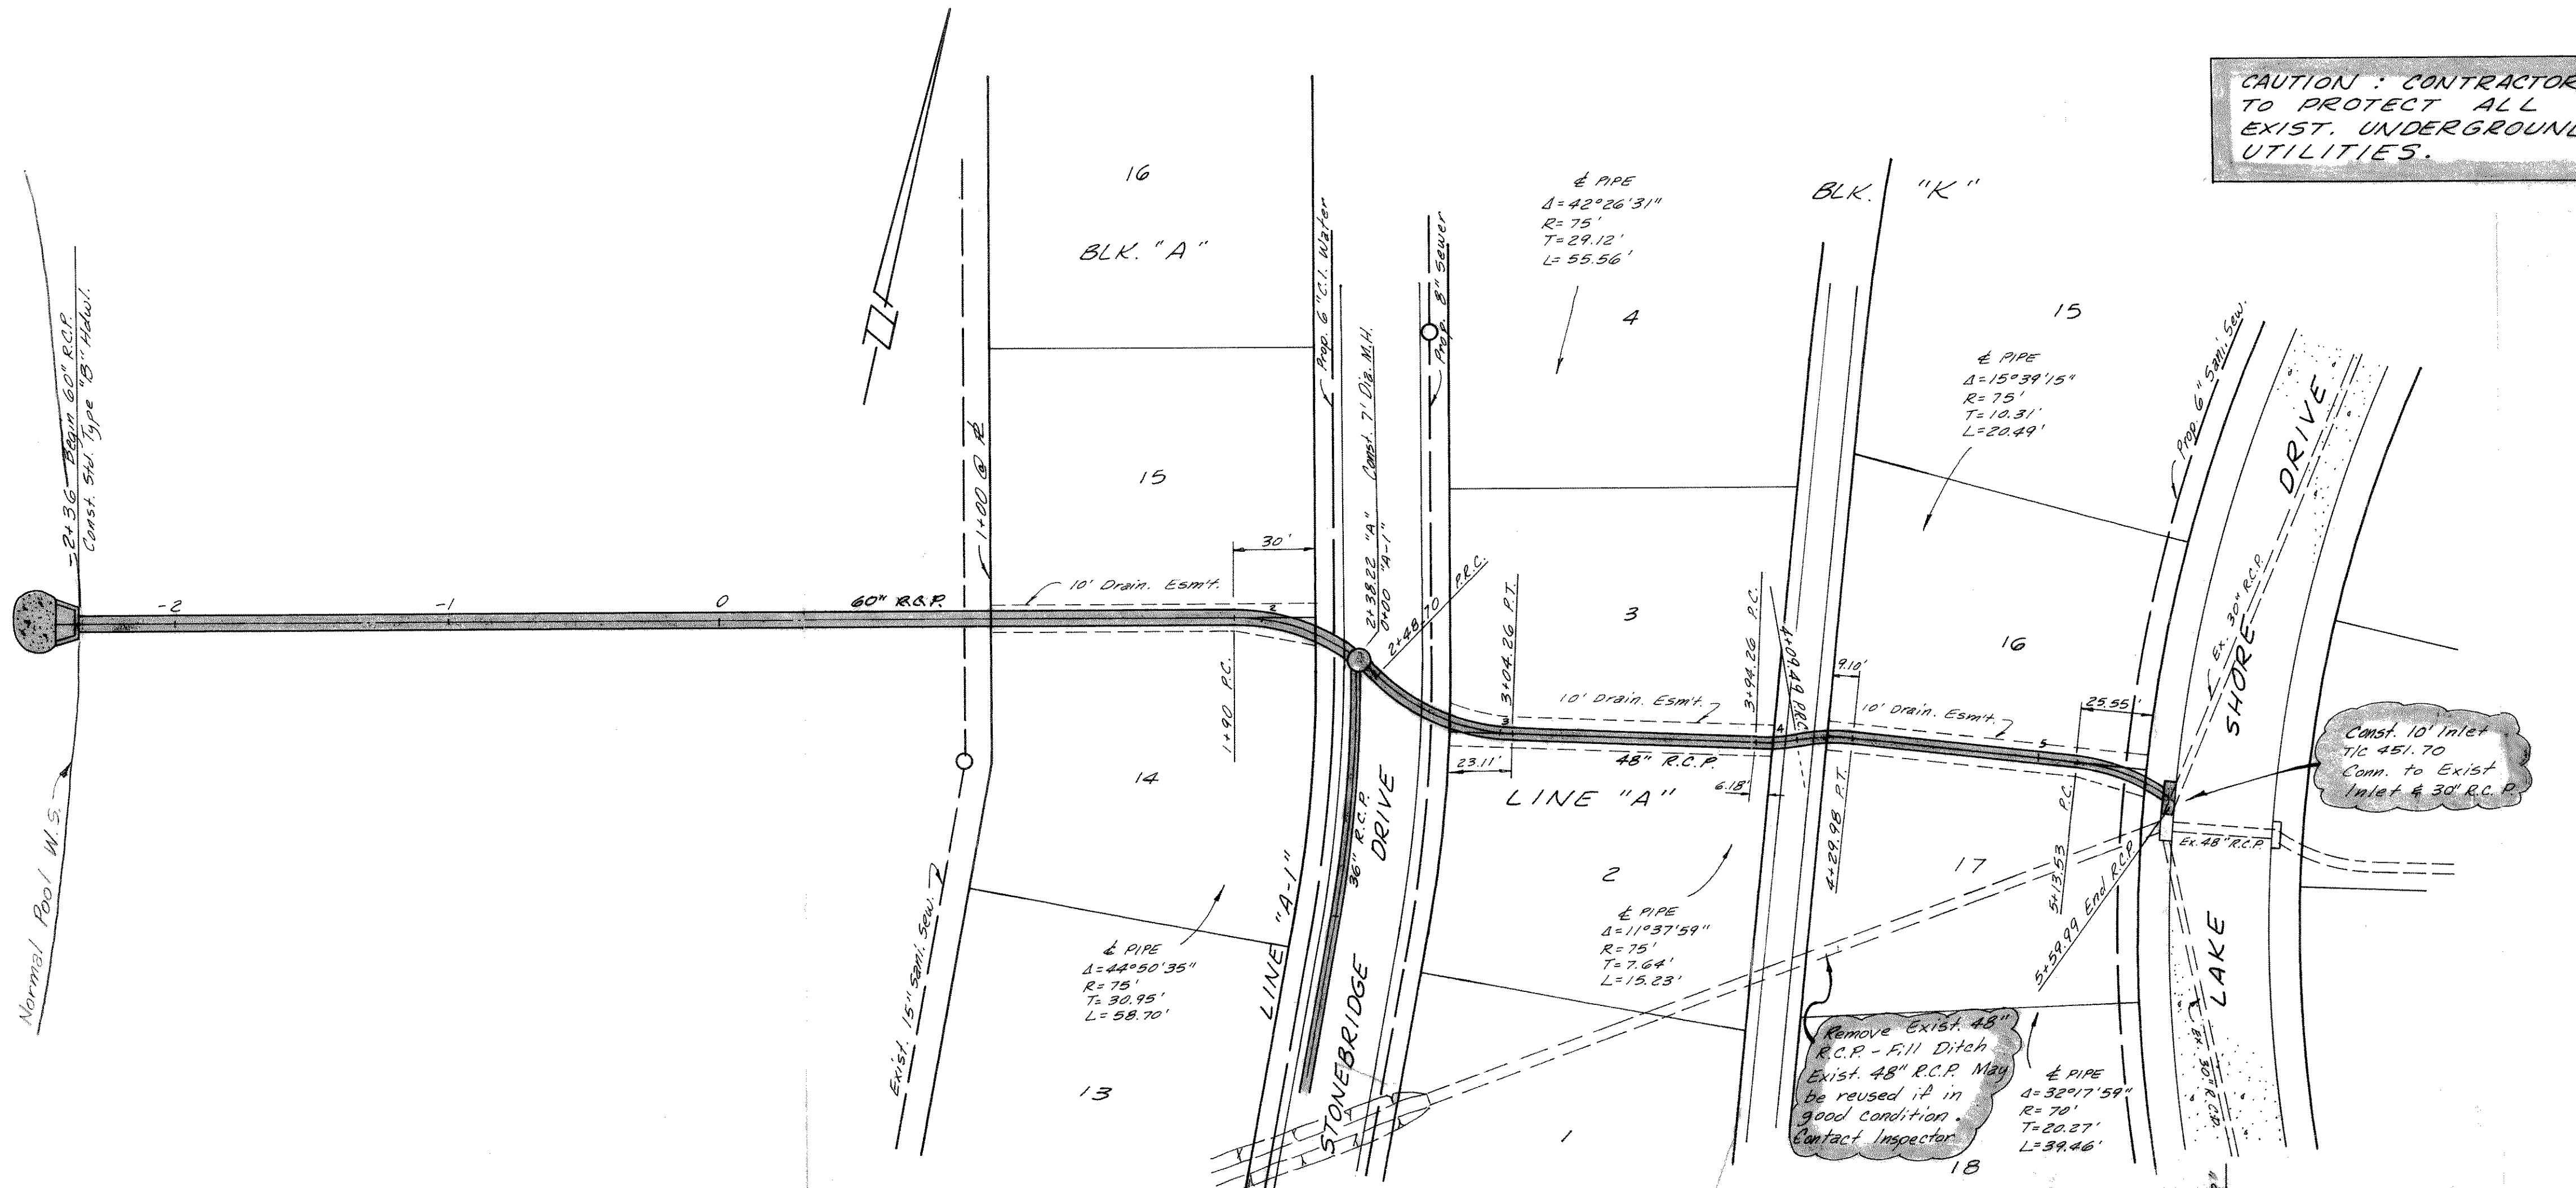

AS BUILT PLANS

NOTE: THE INTENT OF THE OWNER AND ENGINEER WAS TO CONSTRUCT THE IMPROVEMENTS ACCORDING TO THESE PLANS AS APPROVED BY THE CITY OF ROCKWALL. THE GRADES WERE SET ON THE GROUND FOR CONSTRUCTION ACCORDING TO SAID PLANS. THE CITY OF ROCKWALL INSPECTED THE CONSTRUCTION. WE ARE NOT AWARE OF ANY CHANGES OR REVISIONS TO THESE PLANS DURING CONSTRUCTION, EXCEPT AS SHOWN.

JULY 10, 1981

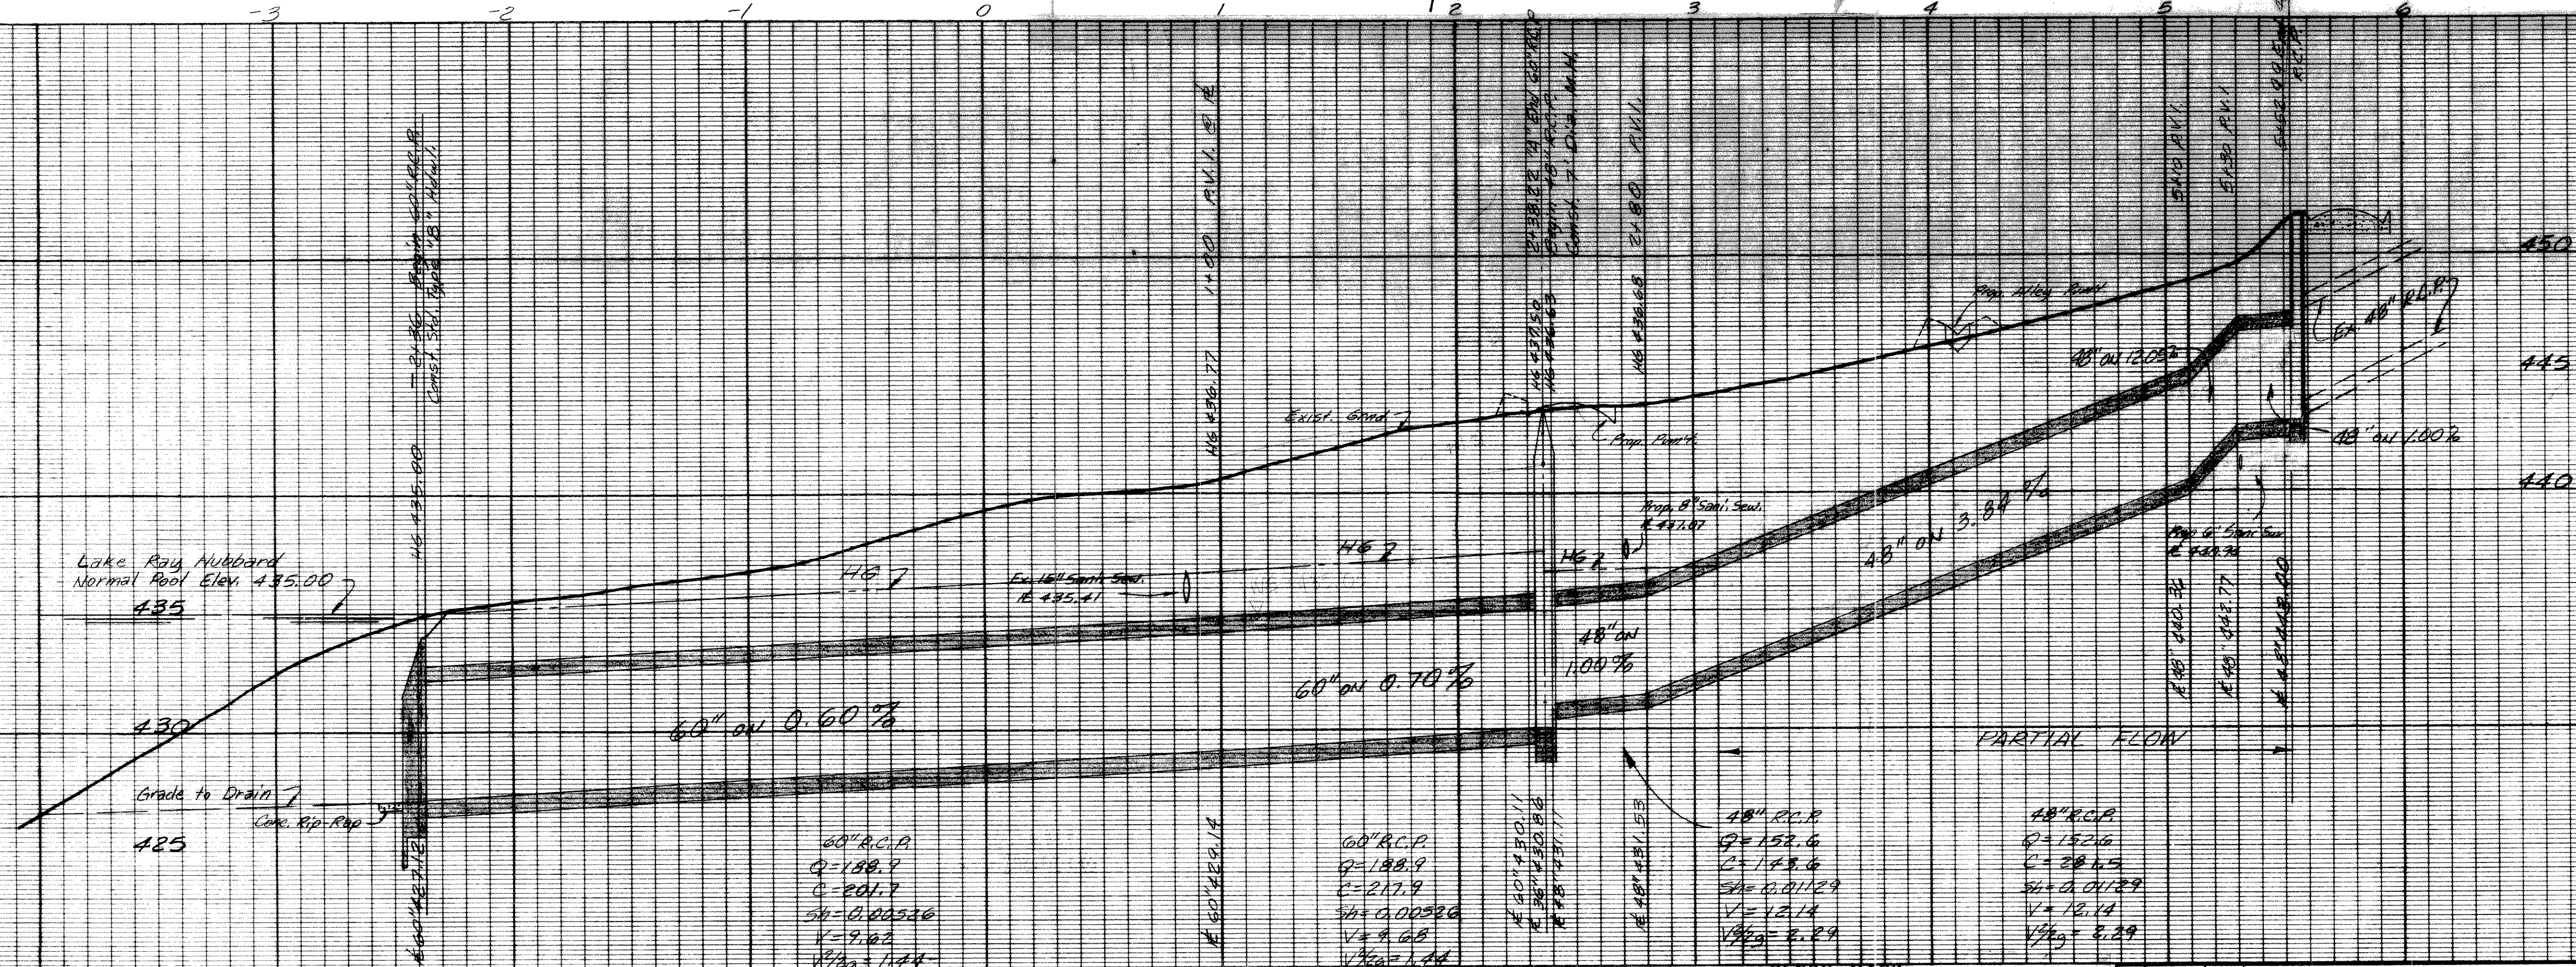

LINE "A"  
 STORM SEWER PLANS  
 STONEBRIDGE MEADOWS  
 PHASE FIVE  
 ROCKWALL, TEXAS

THREADGILL - DOWDEY and ASSOCIATES						
CONSULTING ENGINEERS DALLAS, TEXAS						
DESIGN	DRAWN	CHECKED	DATE	SCALE	JOB	SHEET
J.G.B.	R.E.	D.M.D.	10-80	1"=40'	507-E	2/5

NO.	DATE	BY	REVISION
2	2-24-81	JOB	Rev. Grade Sta 5+10 to 5+52.99
1	10-17-80	R.E.	Added M.H., lengthen Pipe, Revised Profile

