
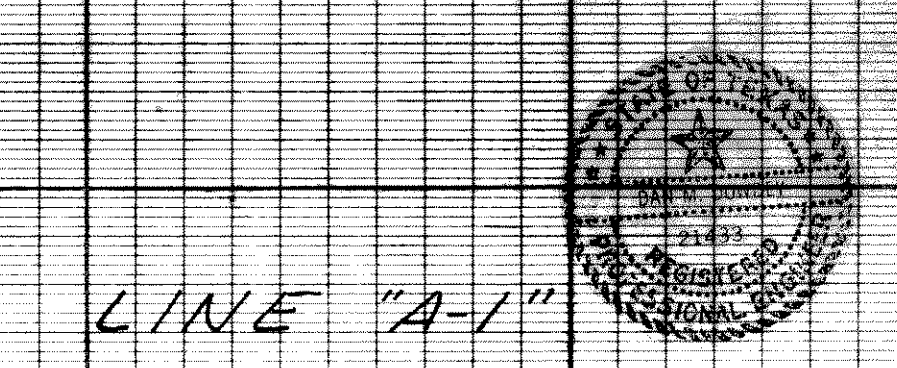


AS BUILT PLANS

NOTE: THE INTENT OF THE OWNER AND ENGINEER WAS TO CONSTRUCT THE IMPROVEMENTS ACCORDING TO THESE PLANS AS APPROVED BY THE CITY OF ROCKWALL. THE GRADES WERE SET ON THE GROUND FOR CONSTRUCTION ACCORDING TO SAID PLANS. THE CITY OF ROCKWALL INSPECTED THE CONSTRUCTION. WE ARE NOT AWARE OF ANY CHANGES OR REVISIONS TO THESE PLANS DURING CONSTRUCTION, EXCEPT AS SHOWN.

JULY 10, 1981

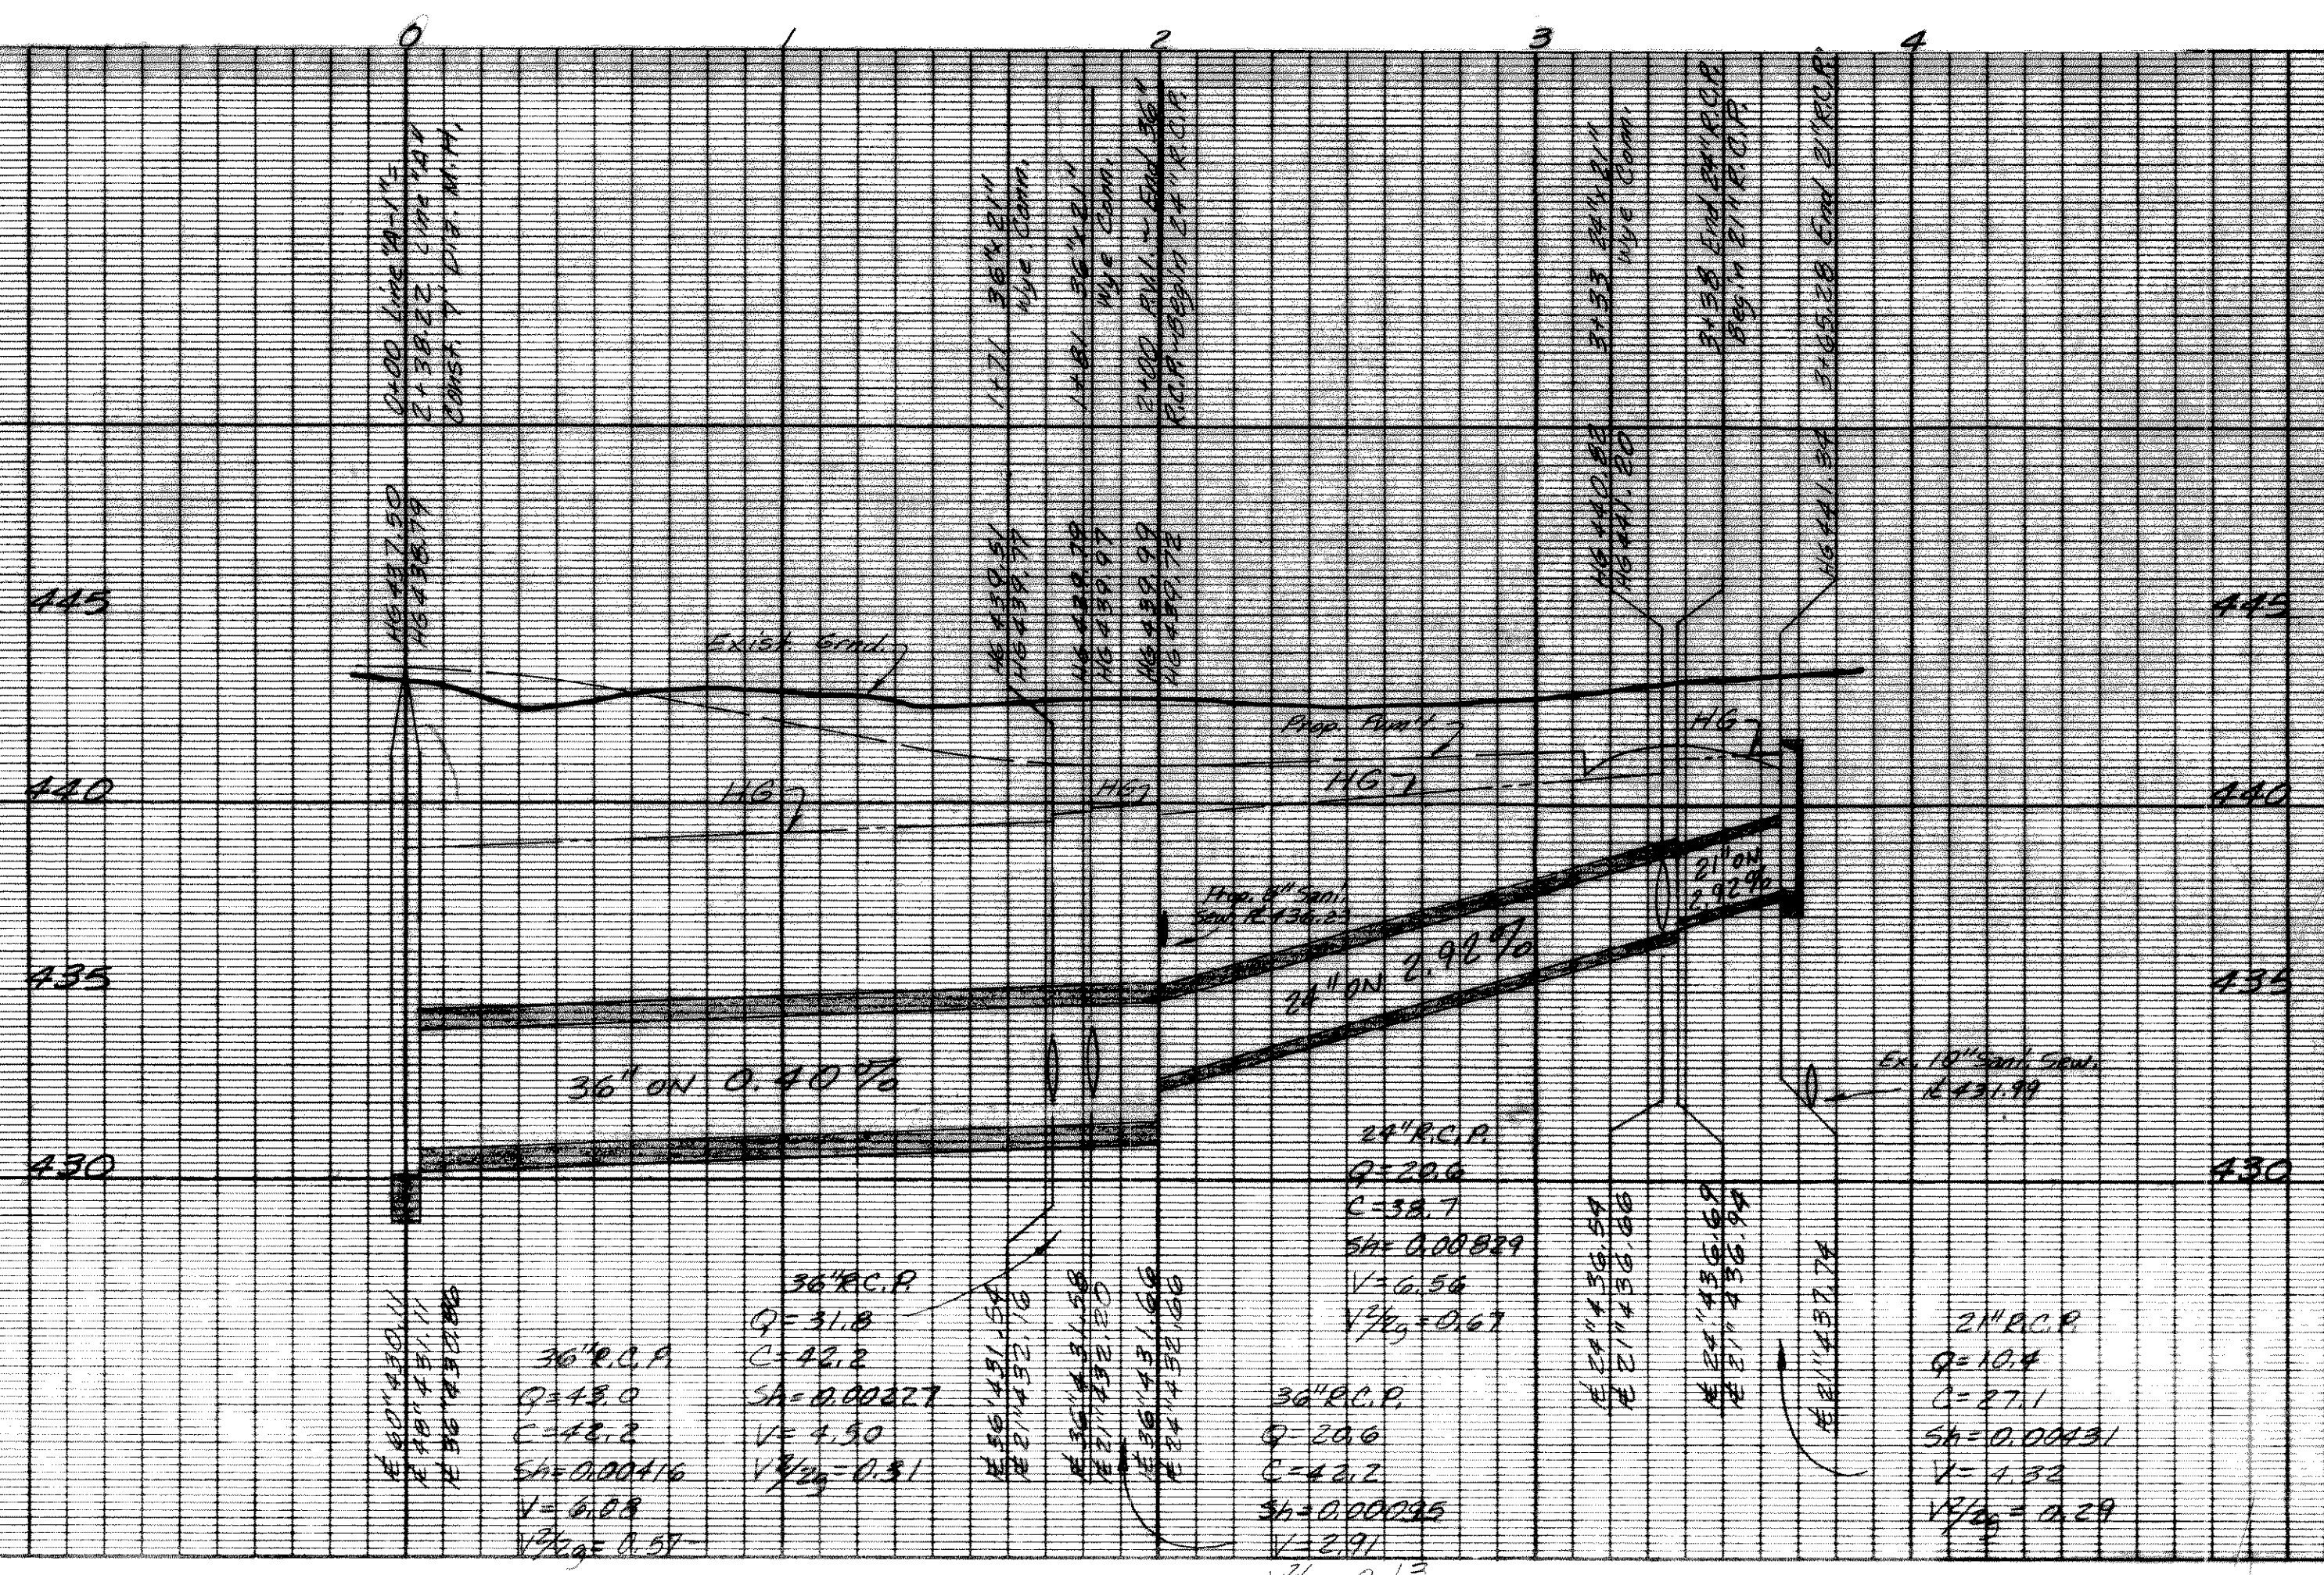

LINE "A-1"
STORM SEWER PLANS
STONEBRIDGE MEADOWS
 PHASE FIVE
 ROCKWALL, TEXAS

THREADGILL - DOWDEY and ASSOCIATES CONSULTING ENGINEERS DALLAS, TEXAS	
DESIGN	J.G.B.
DRAWN	R.E.
CHECKED	D.M.D.
DATE	10-80
SCALE	1"=40' H 1/2"=4' V
JOB	507-E
SHEET	3/5

BENCH MARK:
 TOP OF SOUTH FLANGE BOLT
 OF FIRE HYDRANT ON EAST
 SIDE OF LAKE SHORE DRIVE,
 200' NORTH OF THE NORTH
 PROPERTY LINE OF STONE-
 BRIDGE MEADOWS I.
 ELEV. 454.36

NO.	DATE	BY	REVISION
1	10-17-80	R.E.	Added M.H. - Revised Profile