


LAKE RAY HUBBARD


Normal Pool N.S.
 2.57' Beg. 27" R.C.P.
 Const. Std. Type B' Haul.

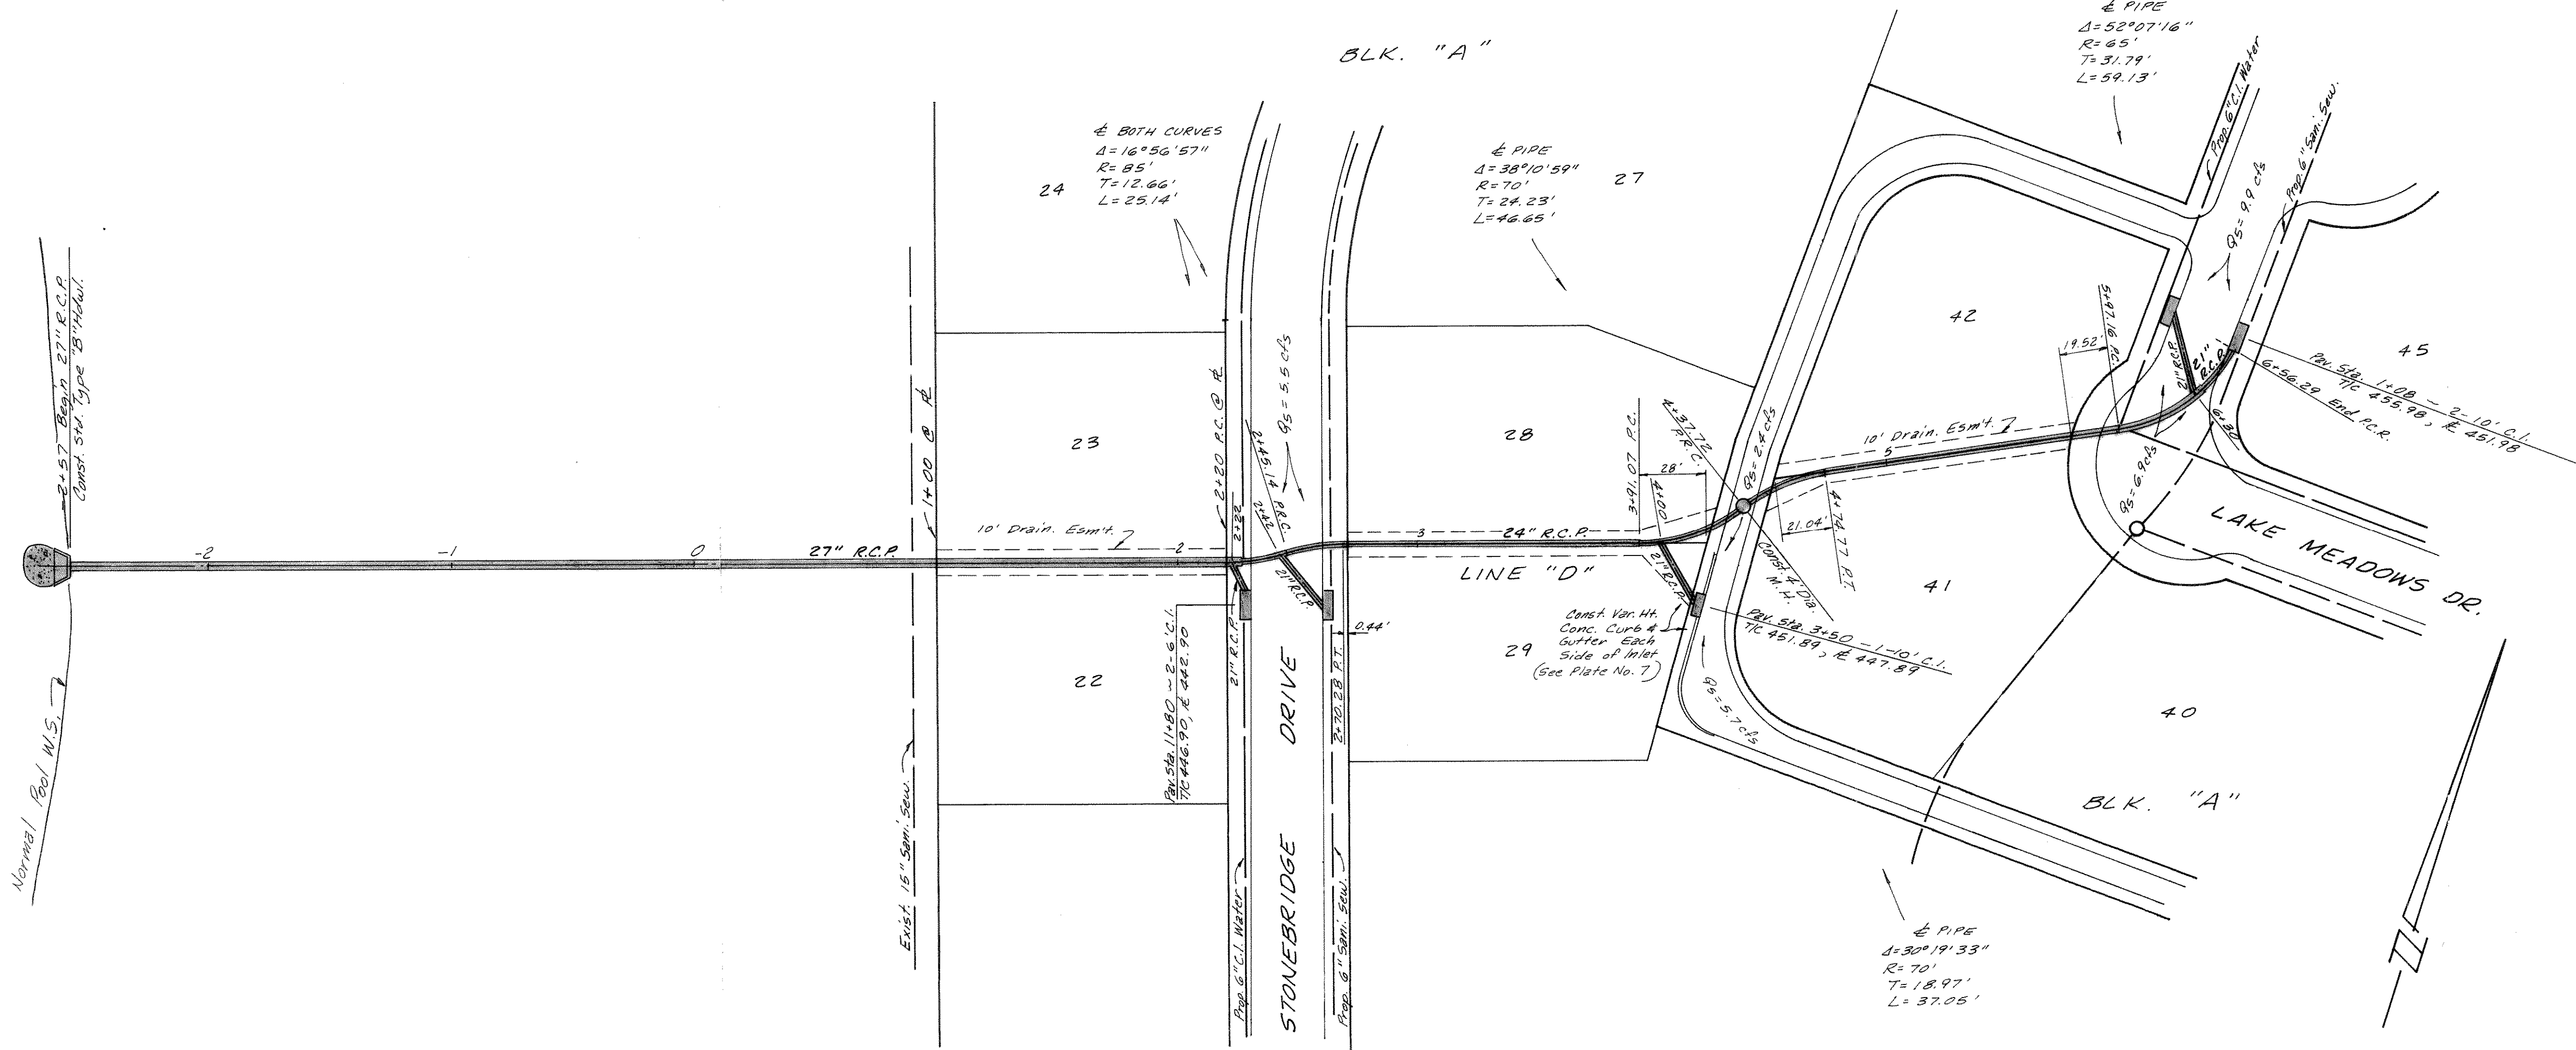

AS BUILT PLANS

NOTE: THE INTENT OF THE OWNER AND ENGINEER WAS TO CONSTRUCT THE IMPROVEMENTS ACCORDING TO THESE PLANS AS APPROVED BY THE CITY OF ROCKWALL. THE GRADES WERE SET ON THE GROUND FOR CONSTRUCTION ACCORDING TO SAID PLANS. THE CITY OF ROCKWALL INSPECTED THE CONSTRUCTION. WE ARE NOT AWARE OF ANY CHANGES OR REVISIONS TO THESE PLANS DURING CONSTRUCTION, EXCEPT AS SHOWN.

JULY 10, 1981

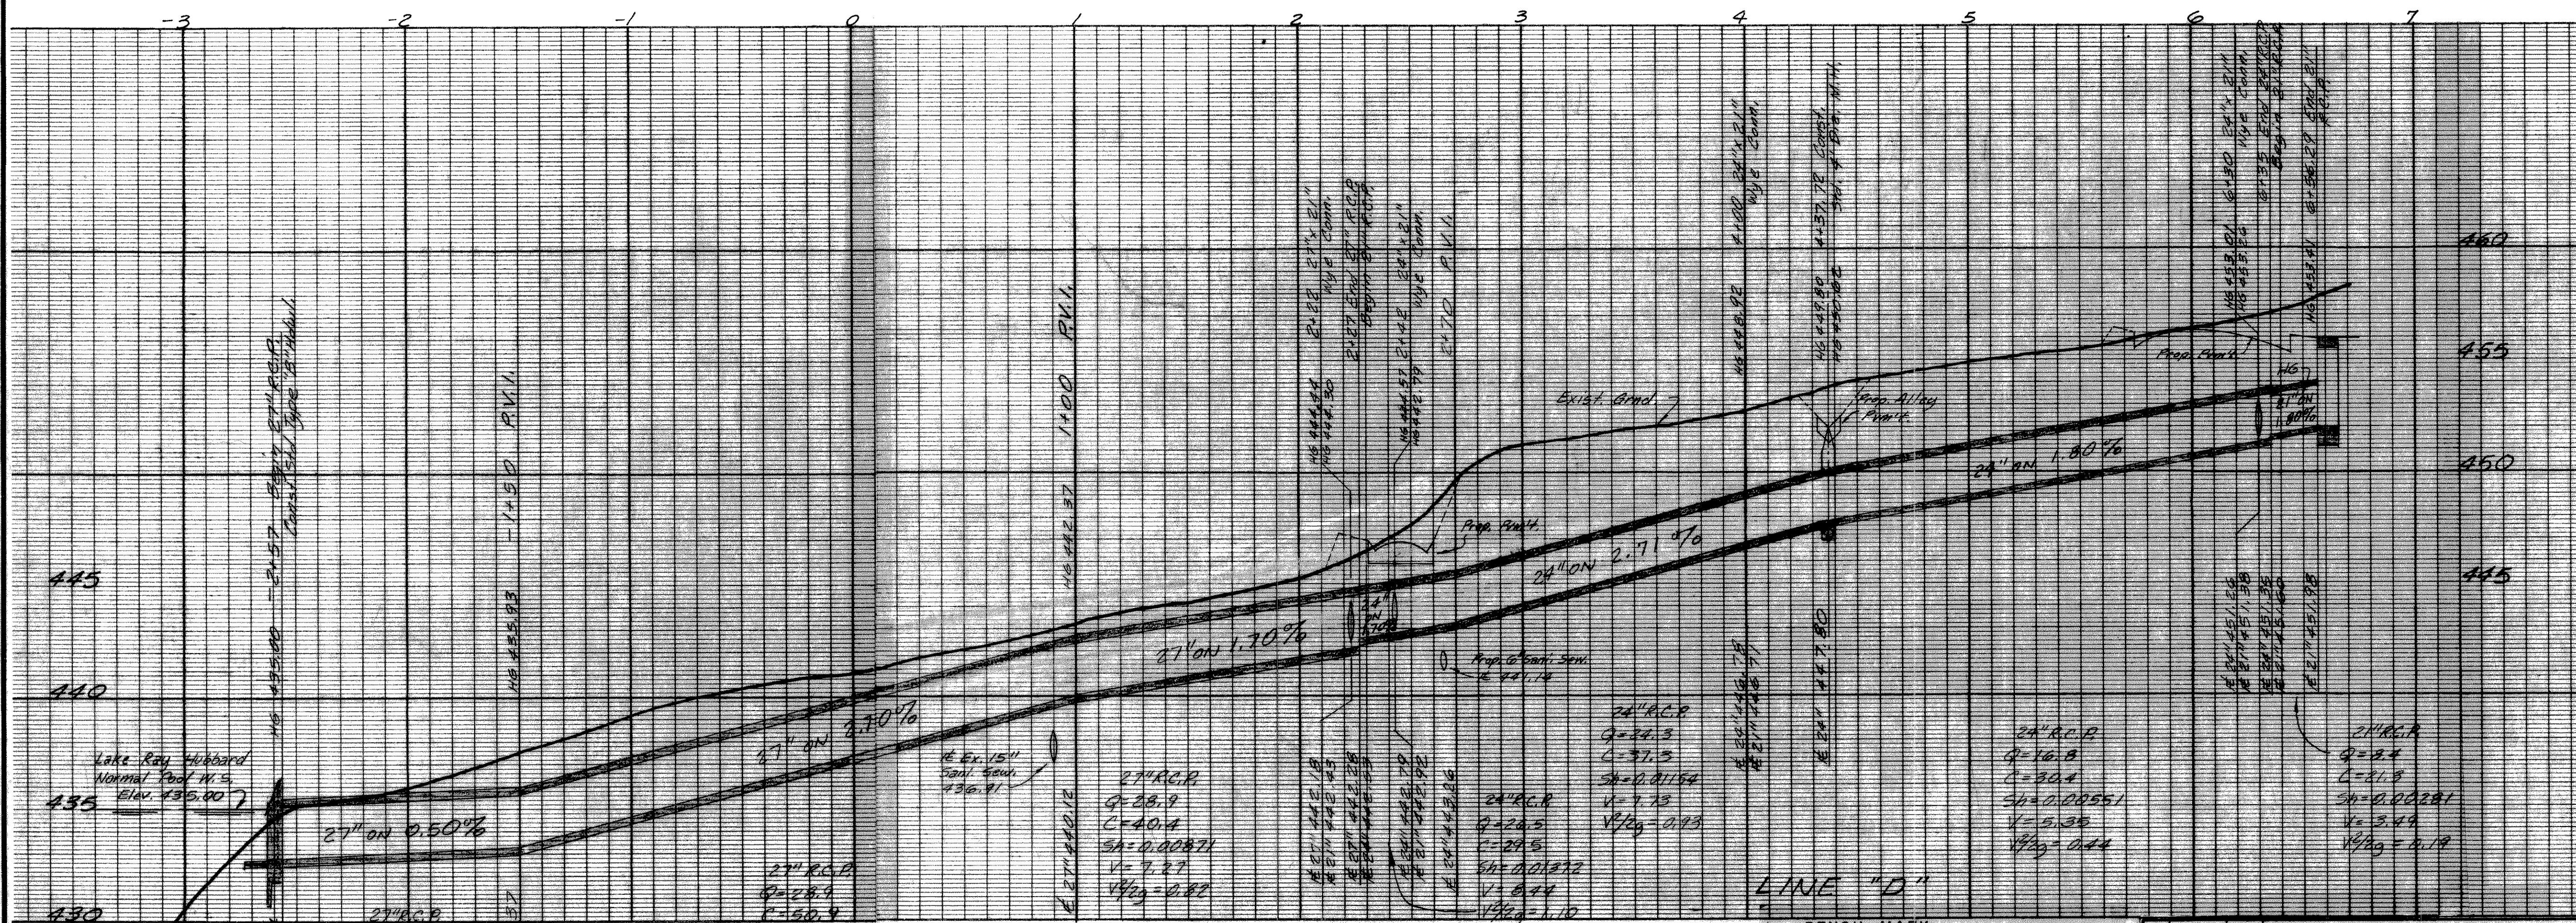

LINE "D"
 STORM SEWER PLANS
 STONEBRIDGE MEADOWS
 PHASE FIVE
 ROCKWALL, TEXAS

DESIGN		DRAWN		CHECKED		DATE		SCALE		JOB		SHEET	
J.G.B.	R.E.	D.M.D.	10-80	1/4"=1'-0"	507-E	5	5						

BENCH MARK:
 TOP OF SOUTH FLANGE BOLT OF FIRE HYDRANT ON EAST SIDE OF LAKE SHORE DRIVE, 200' NORTH OF THE NORTH PROPERTY LINE OF STONEBRIDGE MEADOWS I.
 ELEV. 454.36'

