


AS BUILT PLANS

NOTE: THE INTENT OF THE OWNER AND ENGINEER WAS TO CONSTRUCT THE IMPROVEMENTS ACCORDING TO THESE PLANS AS APPROVED BY THE CITY OF ROCKWALL. THE GRADES WERE SET ON THE GROUND FOR CONSTRUCTION ACCORDING TO SAID PLANS. THE CITY OF ROCKWALL INSPECTED THE CONSTRUCTION. WE ARE NOT AWARE OF ANY CHANGES OR REVISIONS TO THESE PLANS DURING CONSTRUCTION, EXCEPT AS SHOWN.

JULY 10, 1981

BENCH MARK:
 TOP OF SOUTH FLANGE OF
 FIRE HYDRANT ON EAST
 SIDE OF LAKE SHORE DRIVE,
 200' NORTH OF THE NORTH
 PROPERTY LINE OF STONE-
 BRIDGE MEADOWS I.
 ELEV. 454.36'

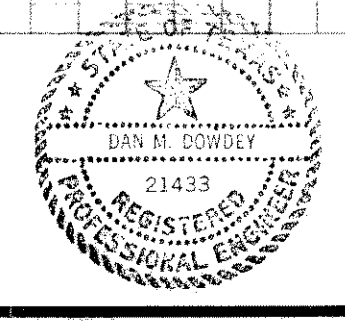

SANITARY SEWER PROFILES						
STONEBRIDGE MEADOWS						
PHASE FIVE						
ROCKWALL, TEXAS						
THREADGILL-DOWDEY and ASSOCIATES						
CONSULTING ENGINEERS DALLAS, TEXAS						
DESIGN	DRAWN	CHECKED	DATE	SCALE	JOB	SHEET
JGB	JGB	DMD	9-80	1"=100' 1/4"=4'V	507-E	2

NO. 1269 - PROFILE PLATE A
 CLEARPRINT PAPER CO.
 MADE IN U.S.A.

2-34-81 Rev. Line "E"
 10-15-80 Rev. Sta. Lines "A" & "C"