


ESTIMATES		
Material	Quantity	Unit
Concrete Paving	3608	S.Y.
Saw Cut & Remove	22	S.Y.
Sand Bedding	202	cu. Yd.

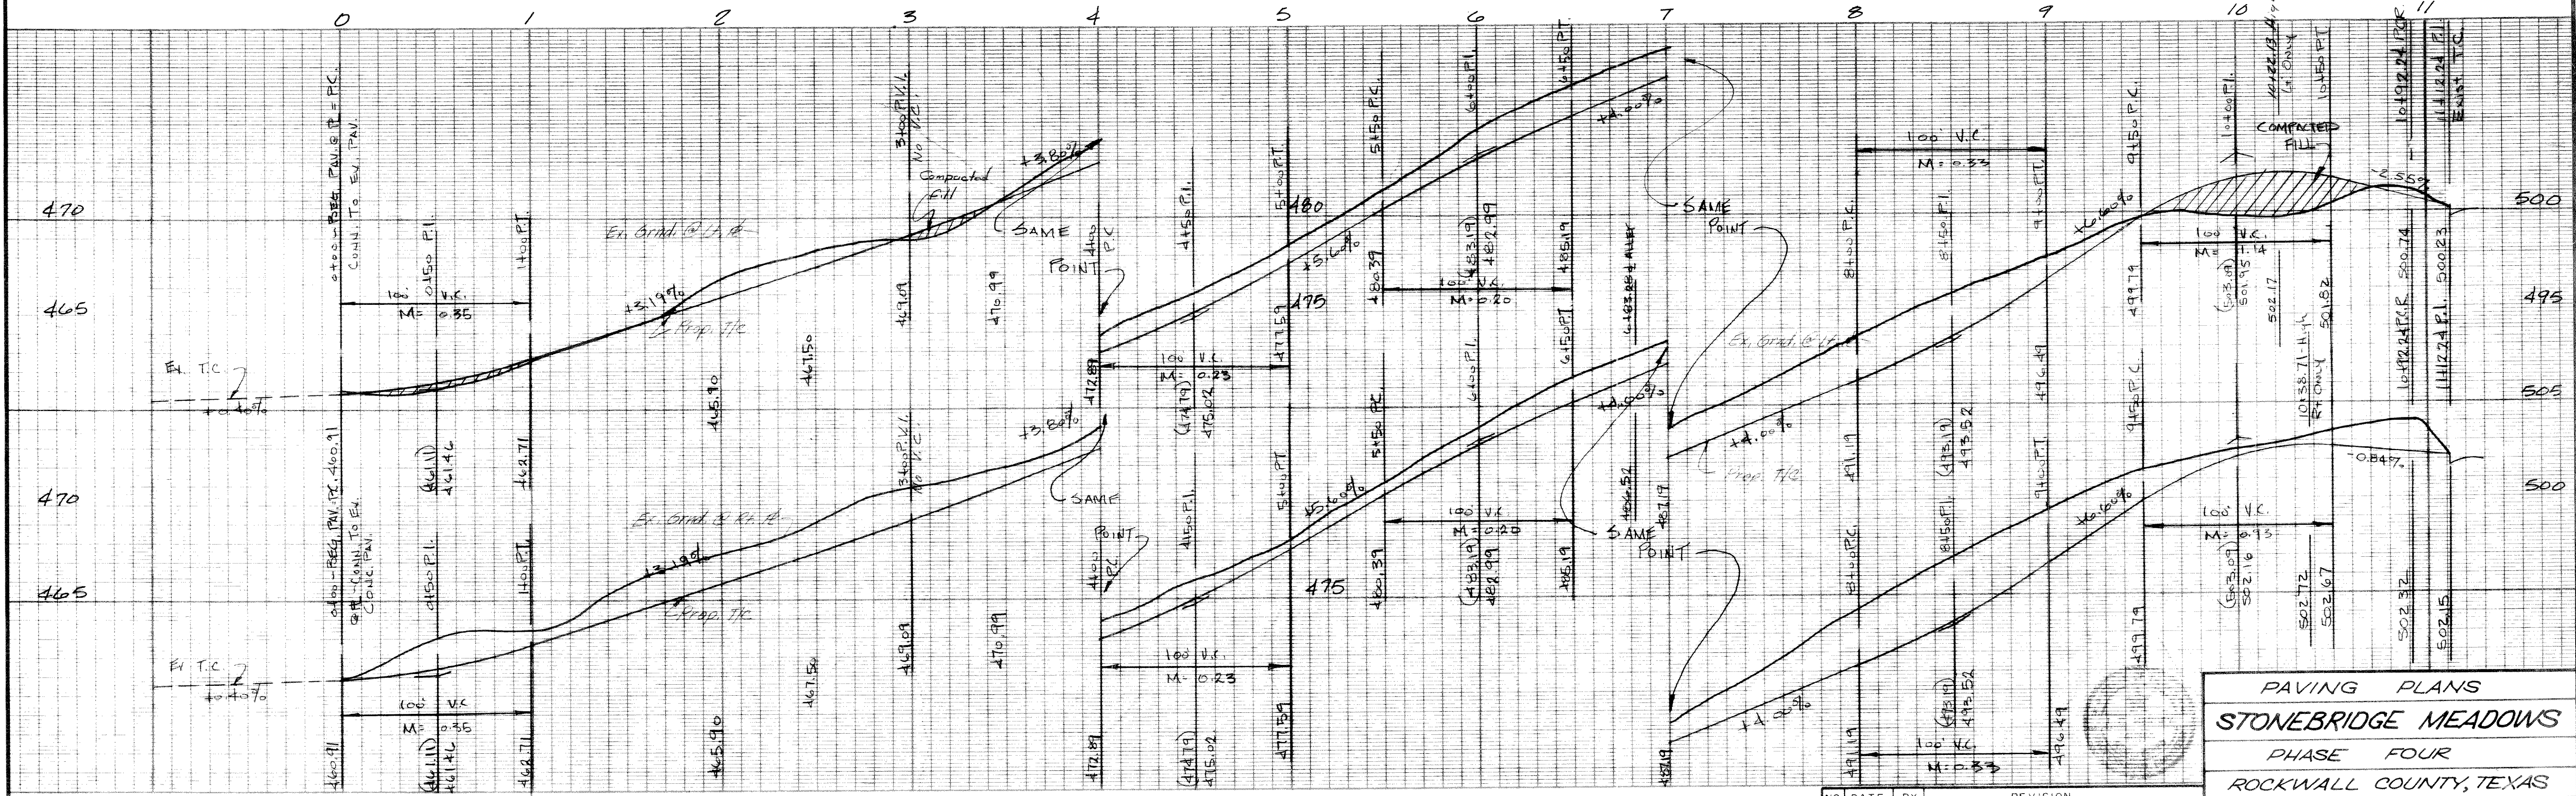

BENCH MARK: Top South Flange Bolt F.H. - East Side of Lake Shore Dr. (200'± North of North Property Line of Stonebridge #1) Elev. 454.36'

NO.	DATE	BY	REVISION
1	12-27-78	JHS	Lowered paving, 3+50 - 11+12.24

PAVING PLANS
STONEBRIDGE MEADOWS
 PHASE FOUR
 ROCKWALL COUNTY, TEXAS

THREADGILL - DOWDEY and ASSOCIATES
 CONSULTING ENGINEERS DALLAS, TEXAS

DESIGN	DRAWN	CHECKED	DATE	SCALE	JOB	SHEET
JCH	HTM	JGB	10-78	1"=40'	506E	1/5