


ESTIMATES		
Material	Quantity	Unit
Concrete Paving	14.05	S.Y.
Saw Cut & Remove Curb	32	S.Y.

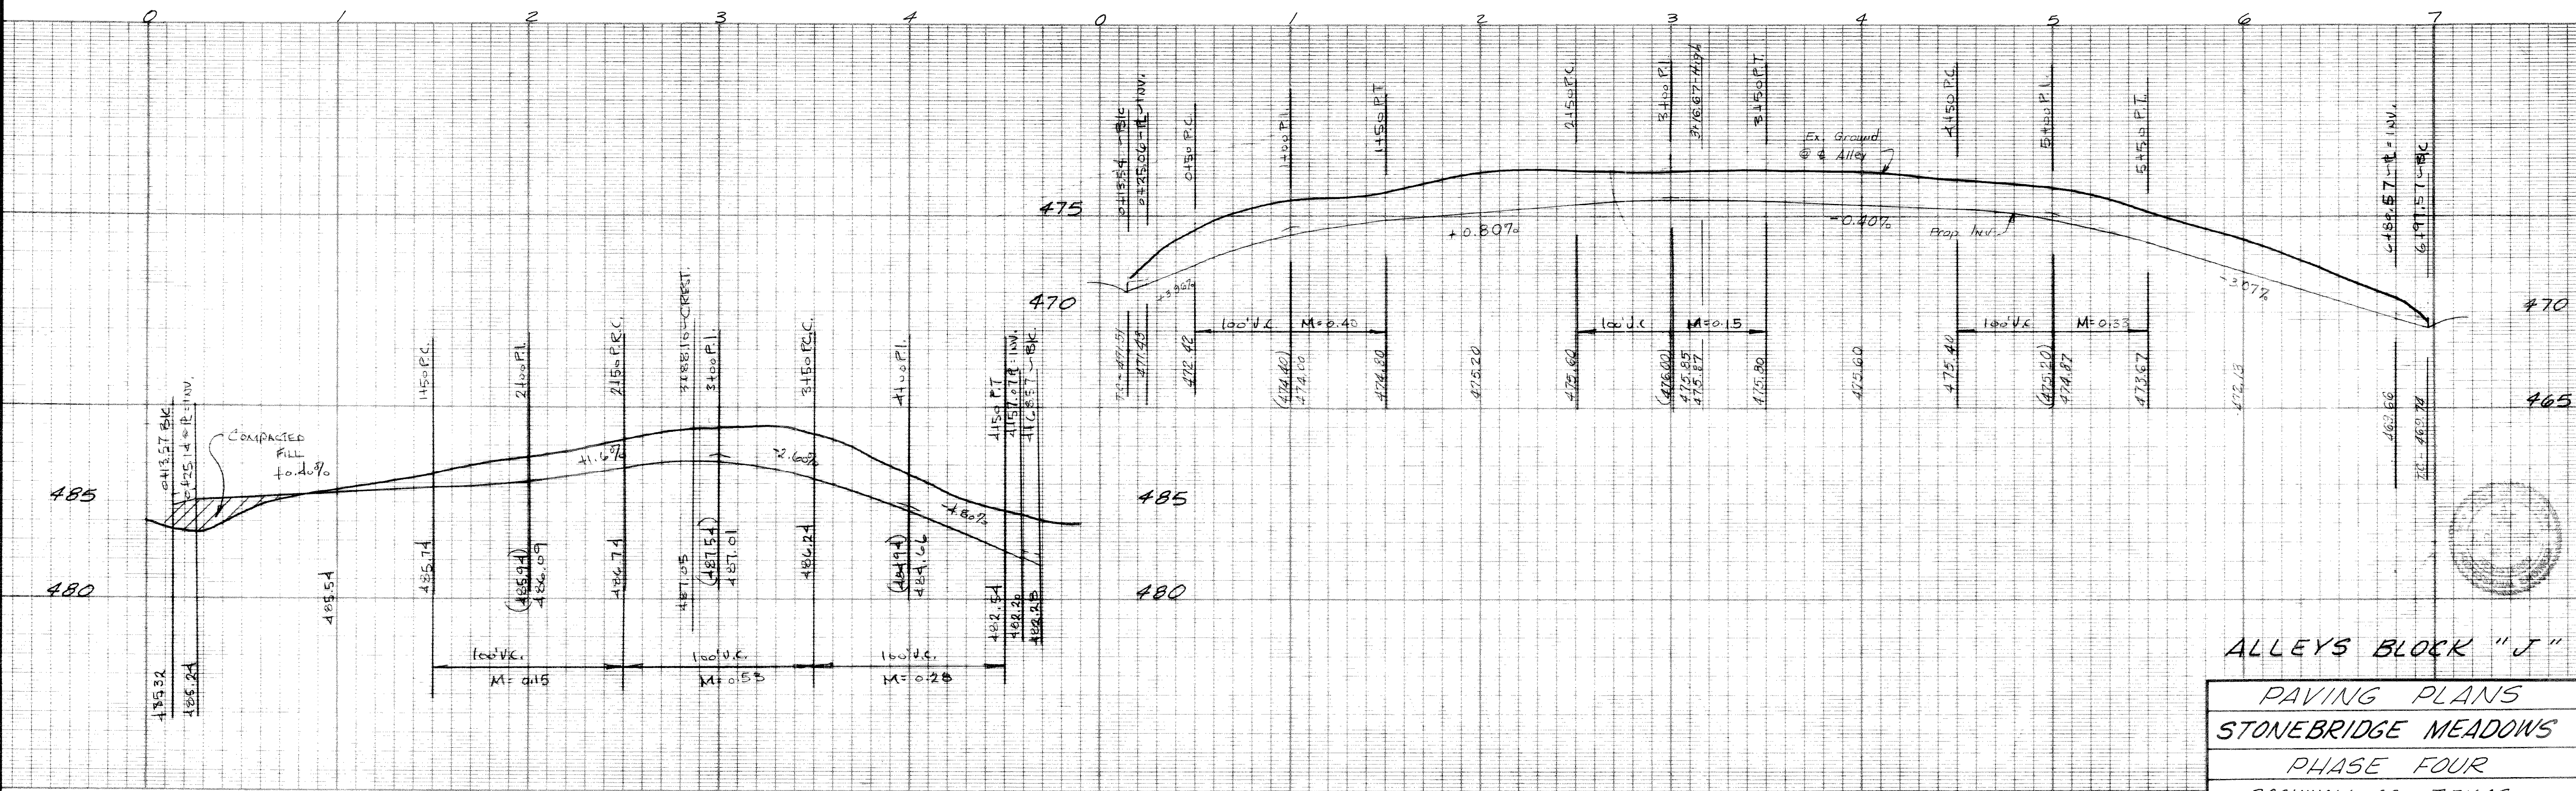

ALLEYS BLOCK "J"
 PAVING PLANS
 STONEBRIDGE MEADOWS
 PHASE FOUR
 ROCKWALL CO., TEXAS

THREADGILL - DOWDEY and ASSOCIATES						
CONSULTING ENGINEERS DALLAS, TEXAS						
DESIGN	DRAWN	CHECKED	DATE	SCALE	JOB	SHEET
J.G.B.	R.E.	J.C.H.	9-78	1"=40'H 1/4"=4'	506-E	5/5

BENCH MARK: Top South Flange Bolt F.H.-East Side of Lake Shore Dr.
 (200'+ North of North Property Line of Stonebridge #1)
 Elev. 454.36

