


ESTIMATES		
Material	Quantity	Unit
36" R.C.P.	382	L.F.
21" R.C.P.	138	L.F.
10' C. Inlet	1	EA.
Type 'B' Hdw.	1	EA.

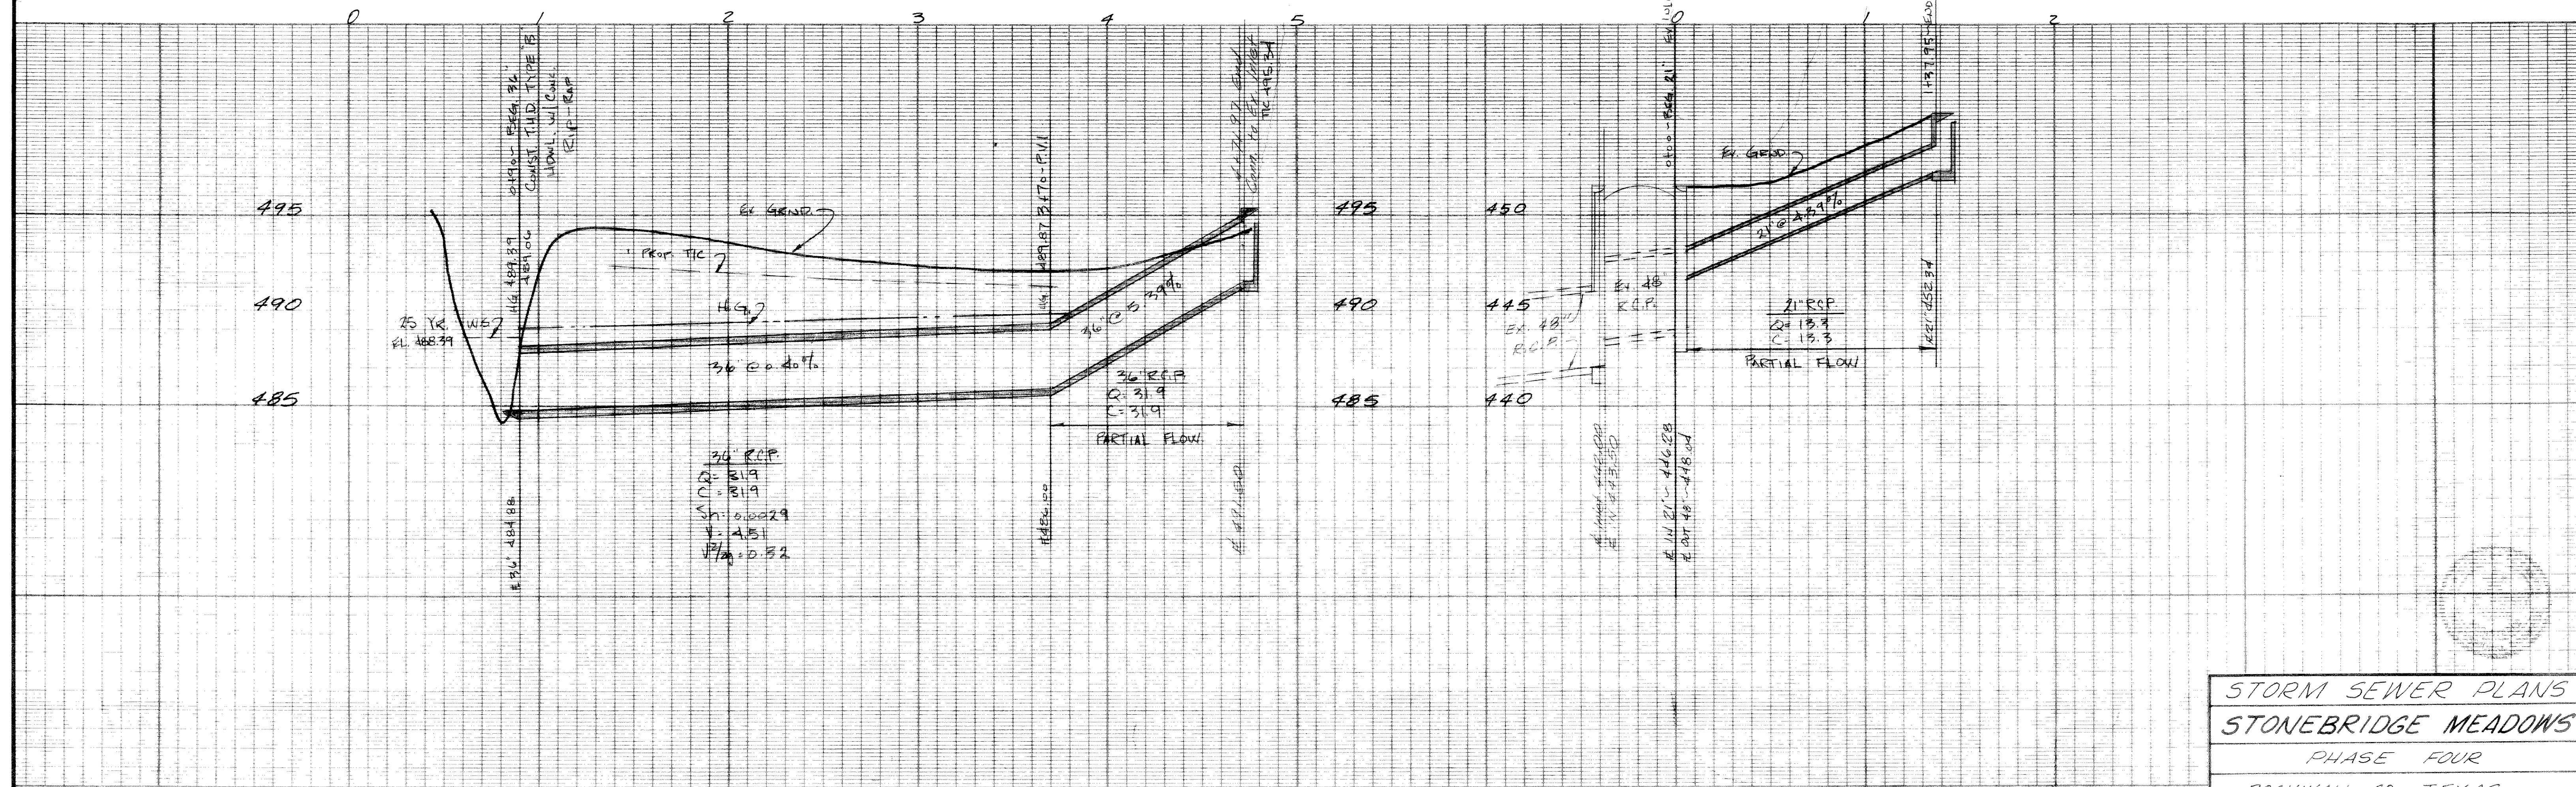

BENCH MARK: Top South Flange Bolt F.H. - East Side of Lake Shore Dr.
 (200' +/- North of North Property Line of Stonebridge
 #1) Elev. 454.36'

NO	DATE	BY	REVISION

STORM SEWER PLANS
 STONEBRIDGE MEADOWS
 PHASE FOUR
 ROCKWALL CO., TEXAS

THREADGILL - DOWDEY and ASSOCIATES
 CONSULTING ENGINEERS DALLAS, TEXAS

DESIGN	DRAWN	CHECKED	DATE	SCALE	JOB	SHEET
J.G.B.	R.E.	J.C.H.	9-78	1"=40' 1/4"=1'	506-E	3/4