


BY	DATE	CHECKED	DESCRIPTION OF REVISION
JHS	10-26-78	JCH	Delete part Line 'A'; Lengthen Line 'B'; add services @ creek to exist line
JHS	12-27-78	JGB	Lowered Line 'A' 0+00-7+23.15; Lowered Line 'B' 0+00-7+82.10
JHS	2-13-79	JGB	Revised grades - Line 'B' - 7+82.10 to 13+15

NO. 1269 - PROFILE PLATE A
 CLEARPRINT PAPER CO.
 MADE IN U.S.A.

BENCH MARK: Top South Flange Bolt F.H. - East Side of Lake Shore Dr. (200' + North of North Property Line of Stonebridge #1) Elev. 454.36'

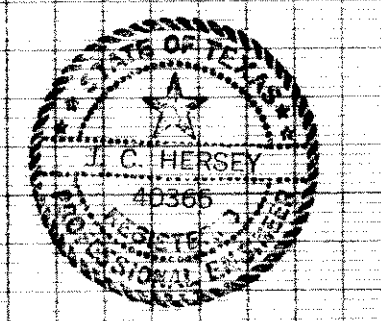

SANITARY SEWER PROFILES
STONEBRIDGE MEADOWS
 PHASE IV
 TOWN OF ROCKWALL, TEXAS

THREADGILL - DOWDEY and ASSOCIATES
 CONSULTING ENGINEERS DALLAS, TEXAS

DESIGN	DRAWN	CHECKED	DATE	SCALE	JOB	SHEET
J.G.B.	J.H.S.	J.C.H.	10-78	1" = 100'	506-E	2/2