


ESTIMATES		
Material	Quantity	Unit
Concrete Pavement	2542	Sq. Yd.
Sand Bedding	141	Cu. Yd.

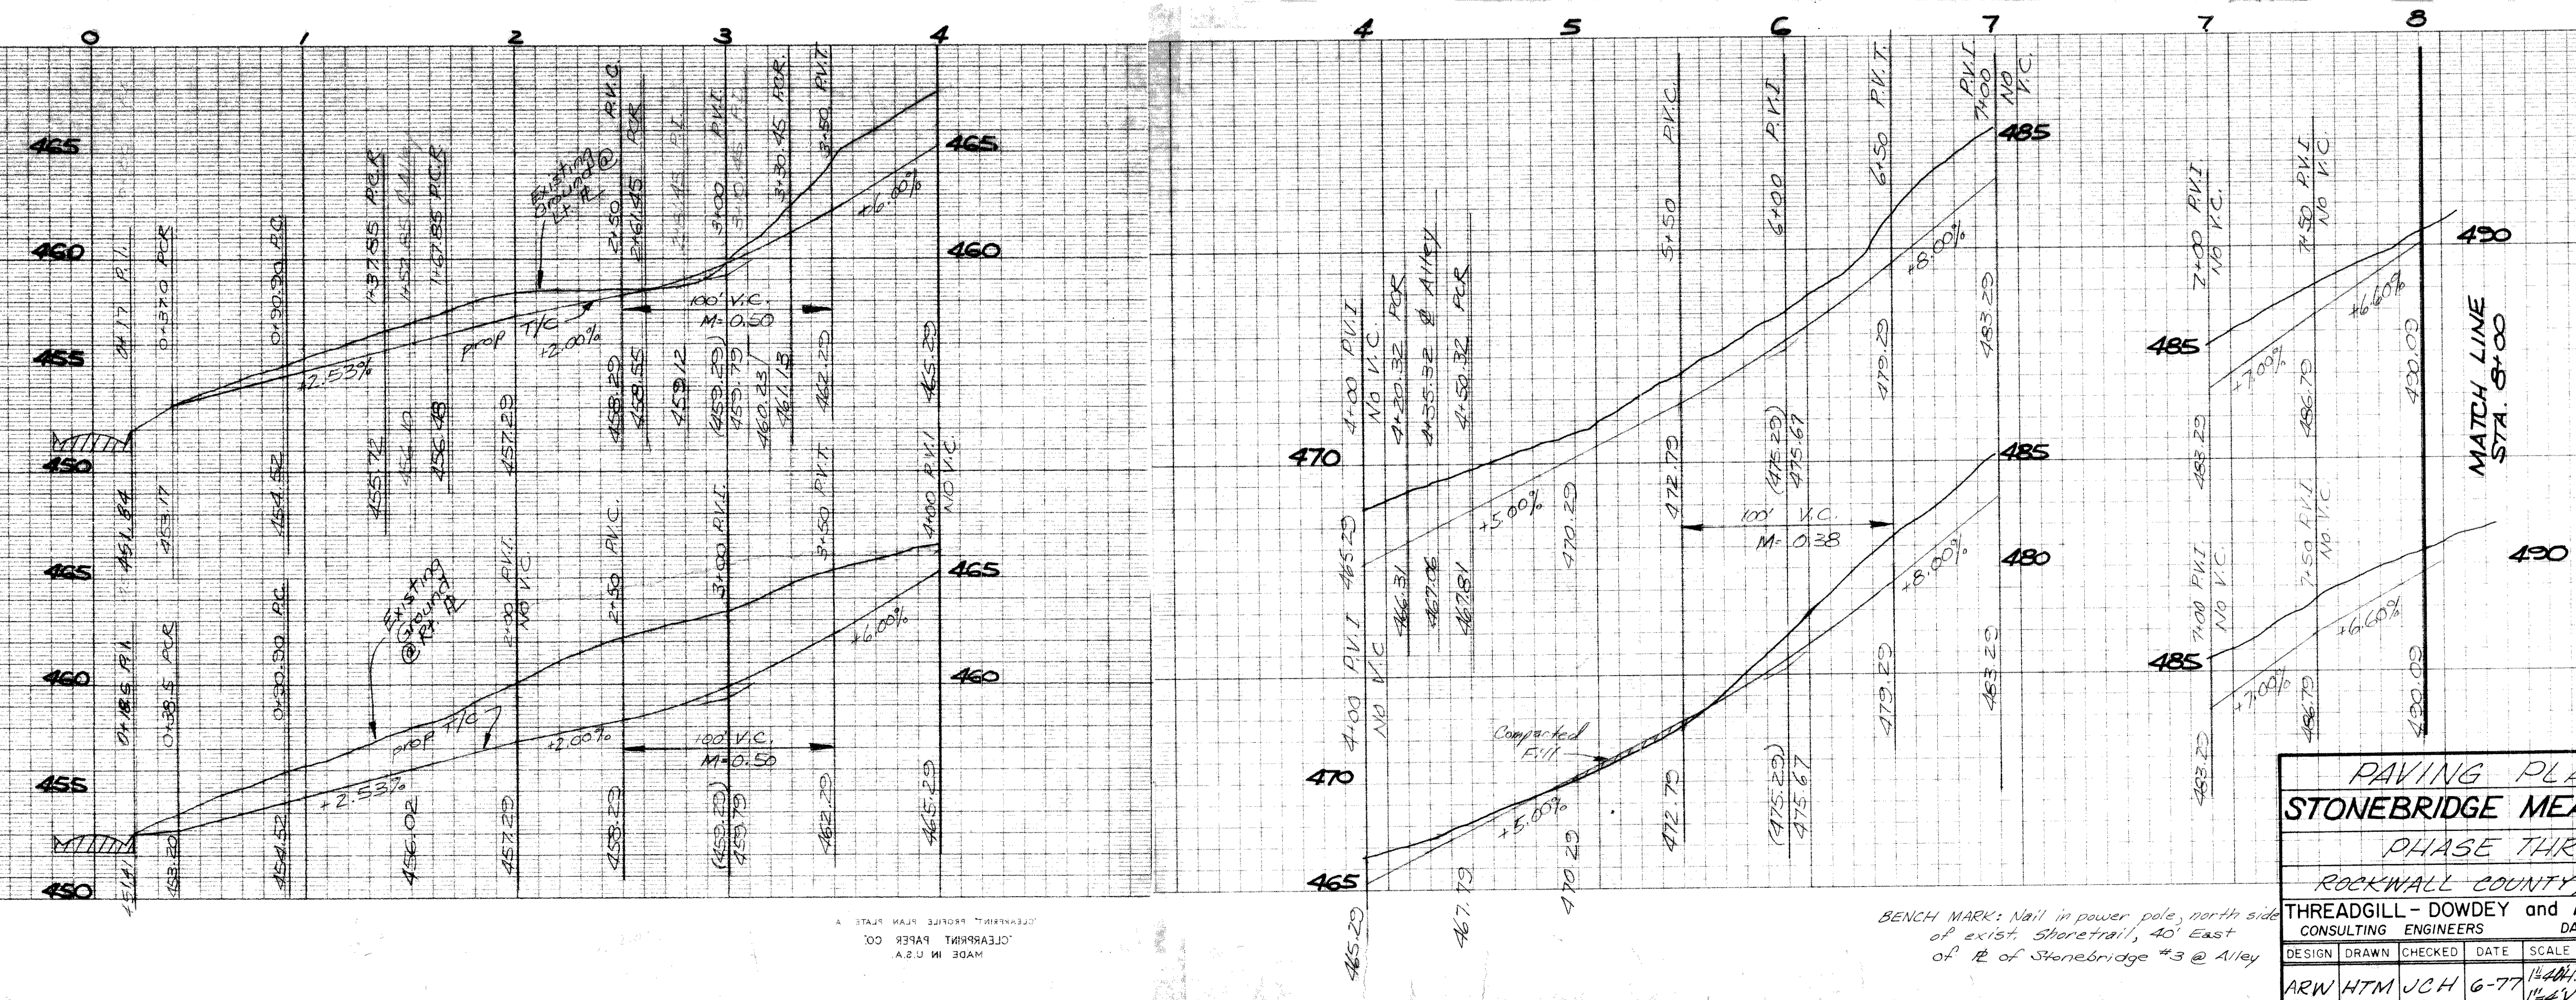

PAVING PLANS
STONEBRIDGE MEADOWS
 PHASE THREE
 ROCKWALL COUNTY, TEXAS
THREADGILL - DOWDEY and ASSOCIATES
 CONSULTING ENGINEERS
 DALLAS, TEXAS

DESIGN	DRAWN	CHECKED	DATE	SCALE	JOB	SHEET
ARW	HTM	JCH	6-77	1/4" = 1'-0"	47E	1/3

PLATE No. 2

BENCH MARK: Nail in power pole, north side of exist. Shoretrail, 40' East of E of Stonebridge #3 @ Alley

MADE IN U.S.A.
 CLEARPRINT PAPER CO.
 CLEARPRINT PROFILE PAPER

MADE IN U.S.A.
 CLEARPRINT PAPER CO.
 CLEARPRINT PROFILE PAPER